




CORRIDOR 301 41

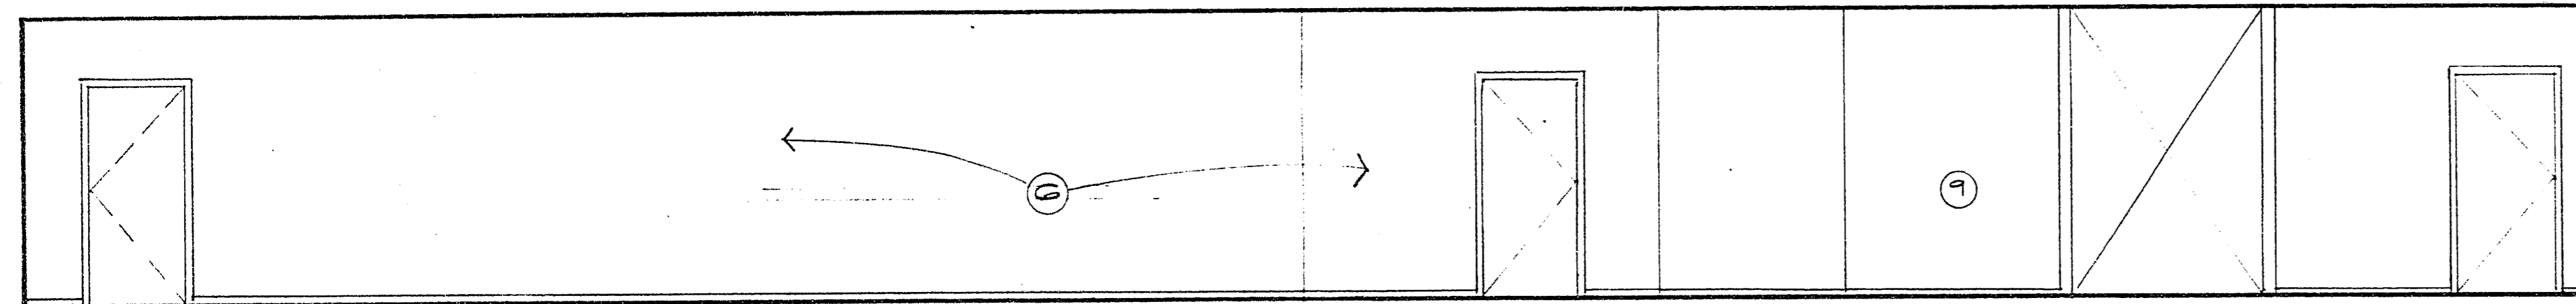


CORRIDOR 301 42

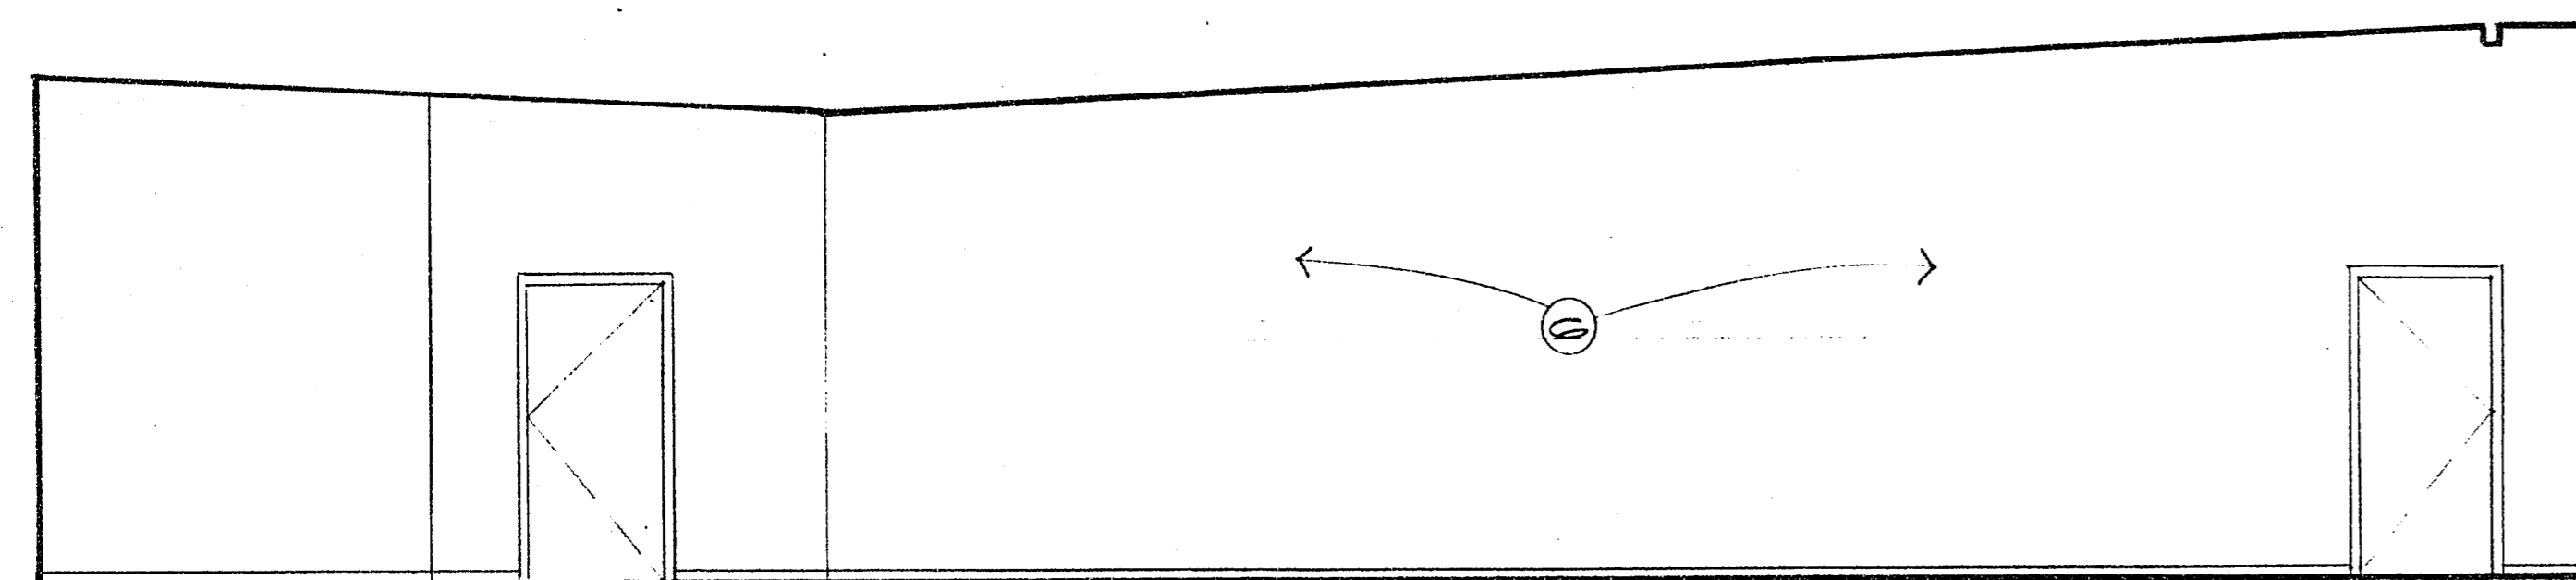


STORAGE 302 43

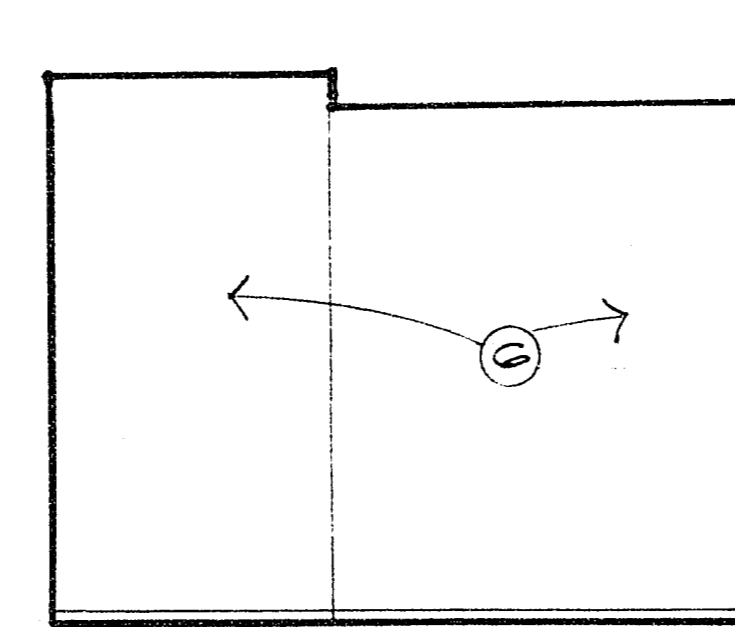


STORAGE 302 44

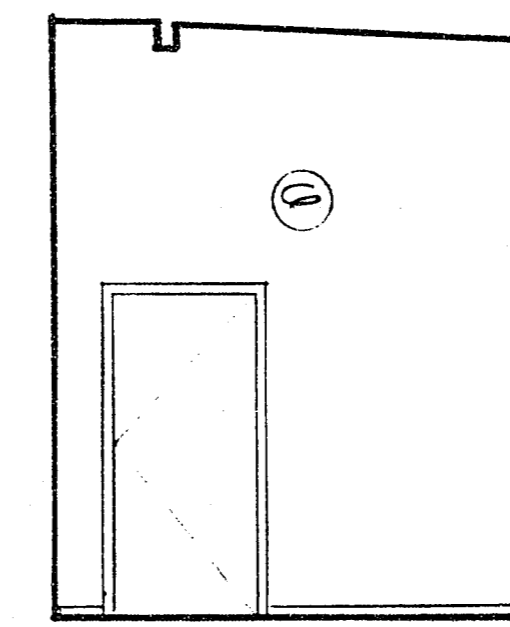


STORAGE 305 45

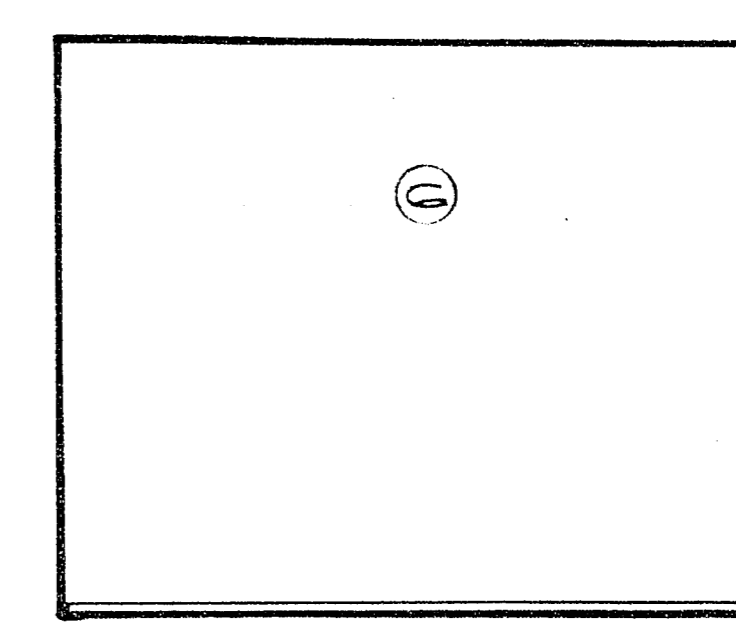


STORAGE 305 46

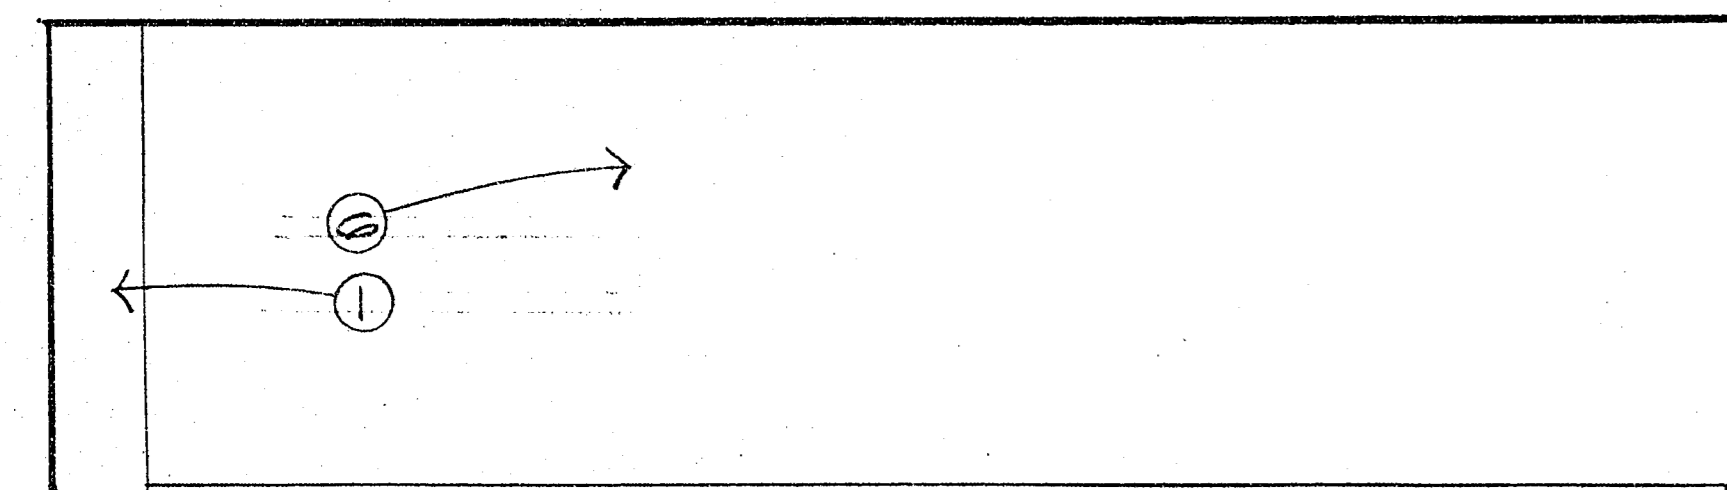


CLASSROOM 307 47

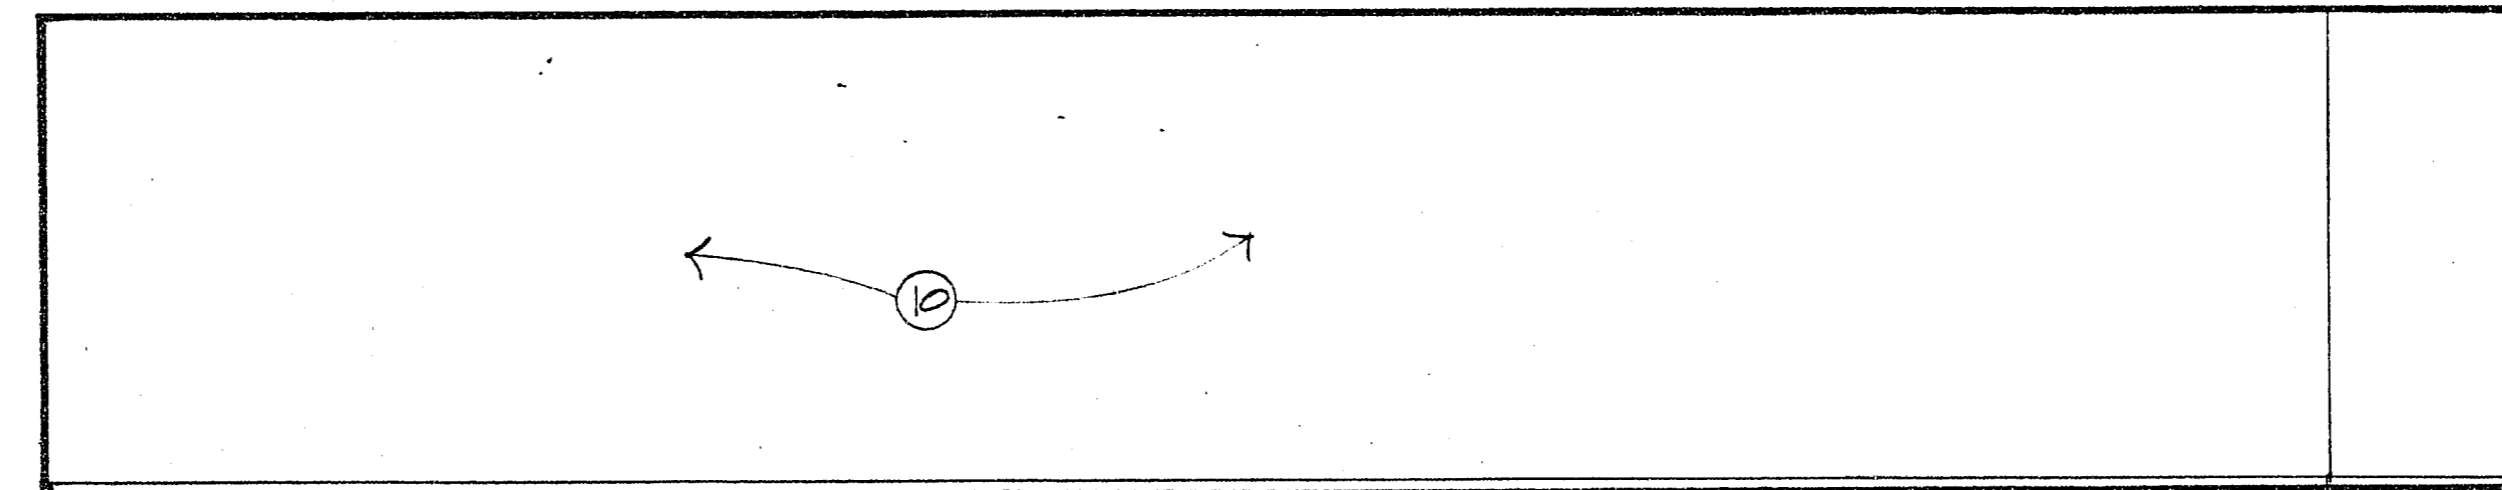


CLASSROOM 307 48

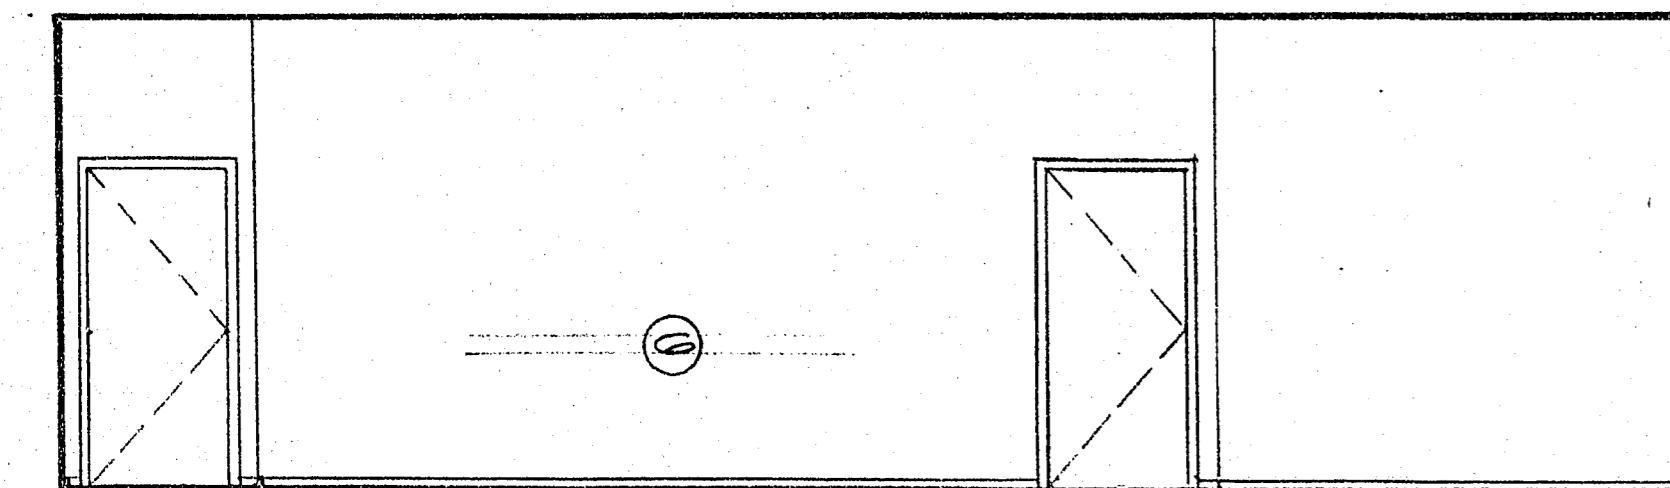

CLASSROOM 307 49

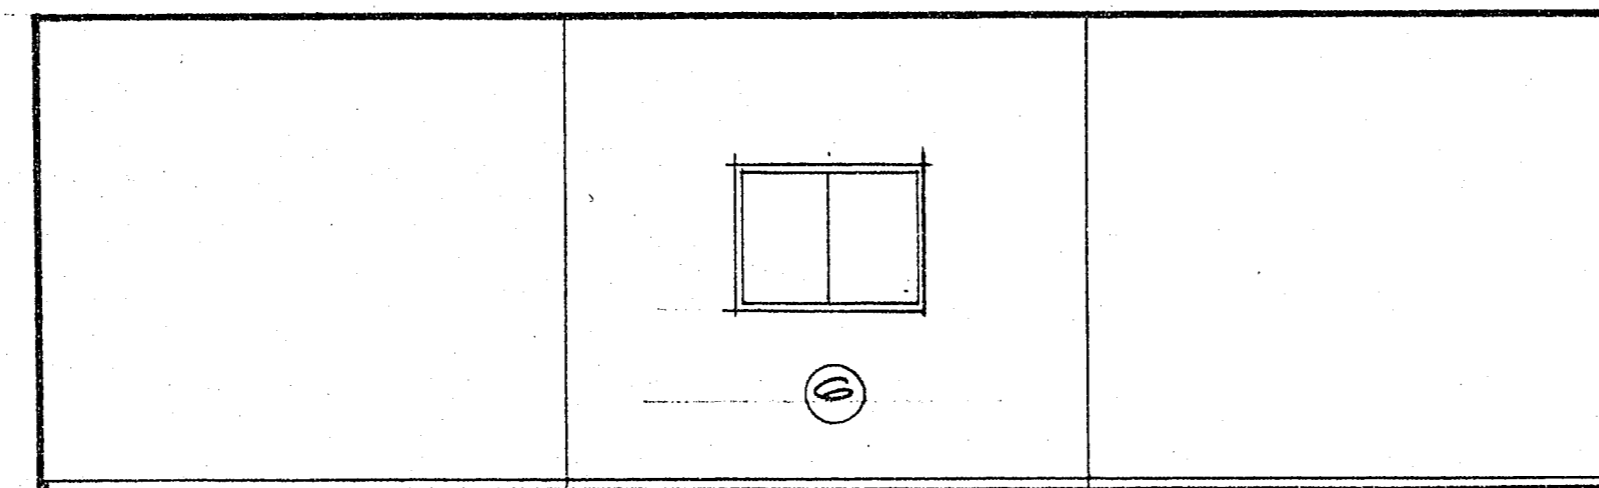

CLASSROOM 308 50

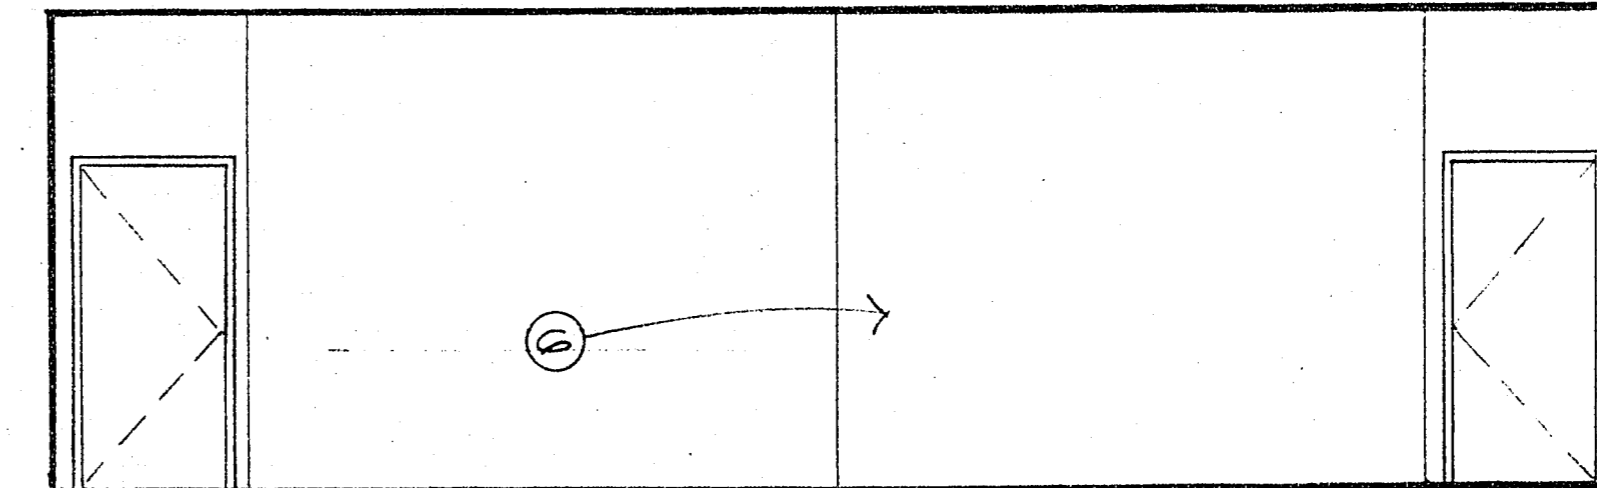

CLASSROOM 308 51

NOTES

SCALE: 1/4" = 1'-0" UNLESS OTHERWISE NOTED  
 FOR INTERIOR ELEVATION NOTES SEE  
 FINISH SCHEDULE SHEET, A-9

AS BUILT - OCT 1972

DATE: MARCH 78  
 DRAWN: S. DE.  
 CHECKED: T.D.  
 JOB NO. 77-53

THOMAS A. DOBRUSKY  
 ARCHITECT AIA  
 141 MARYLAND PARKWAY LAS VEGAS, NEVADA 89107 (702) 385-2342

CULTURAL SERVICES COMPLEX  
 REED WHIFFLE LAS VEGAS, NEVADA

SHEET  
**A-12**  
 OF  
 23  
 FILE NUMBER  
 2-26

G-418

513-A13