




CLASSROOM 309 52

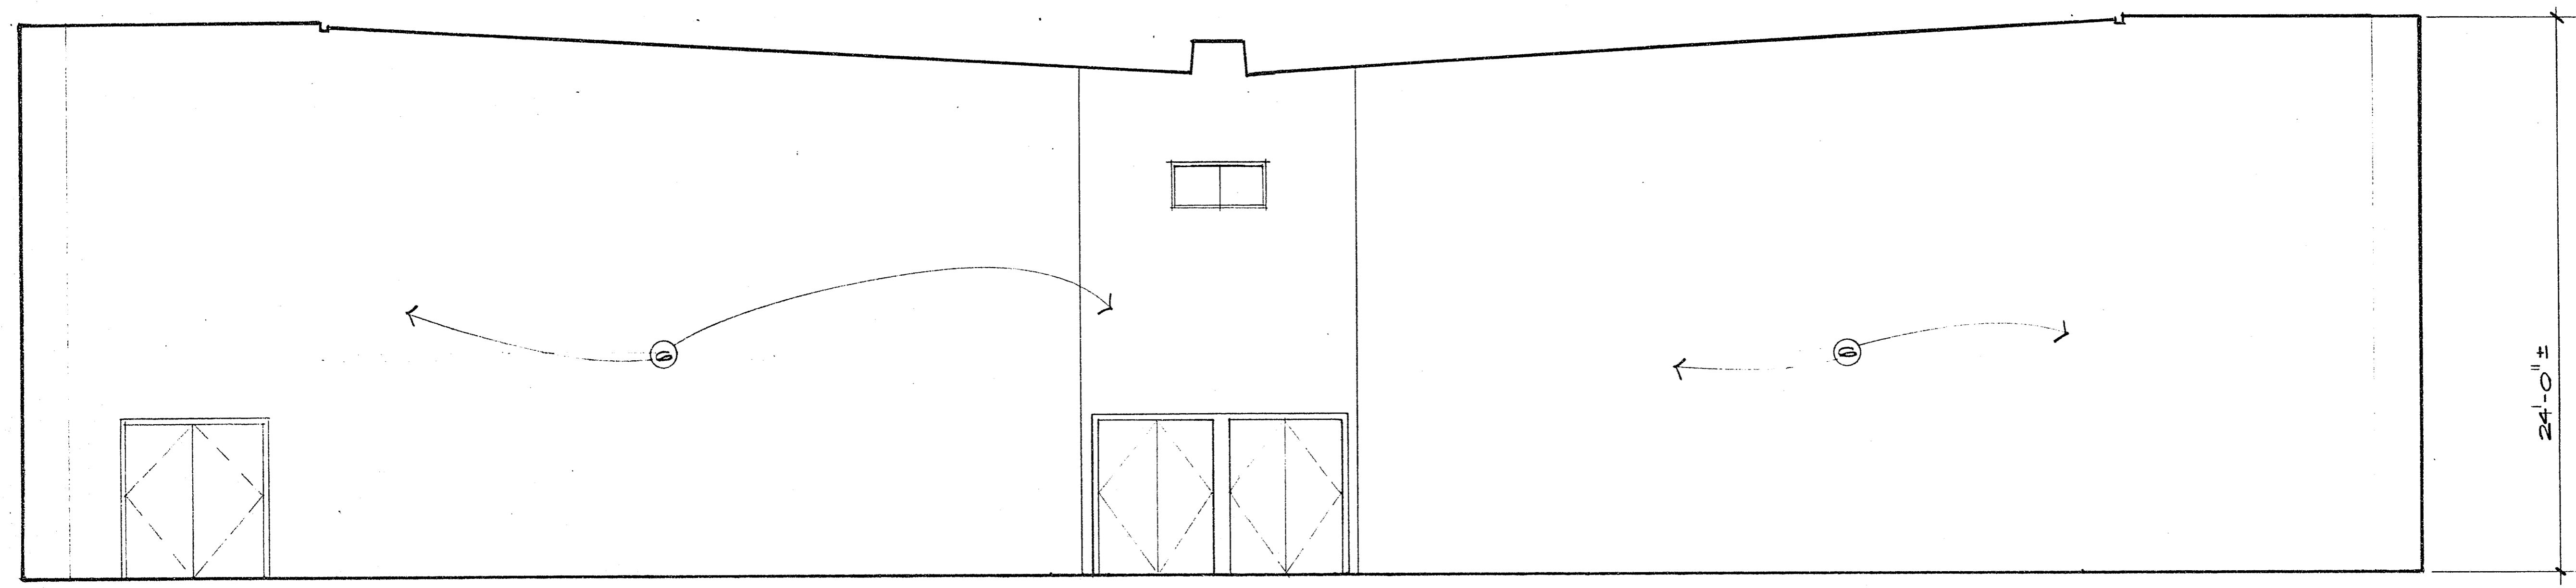

THEATER 229 53

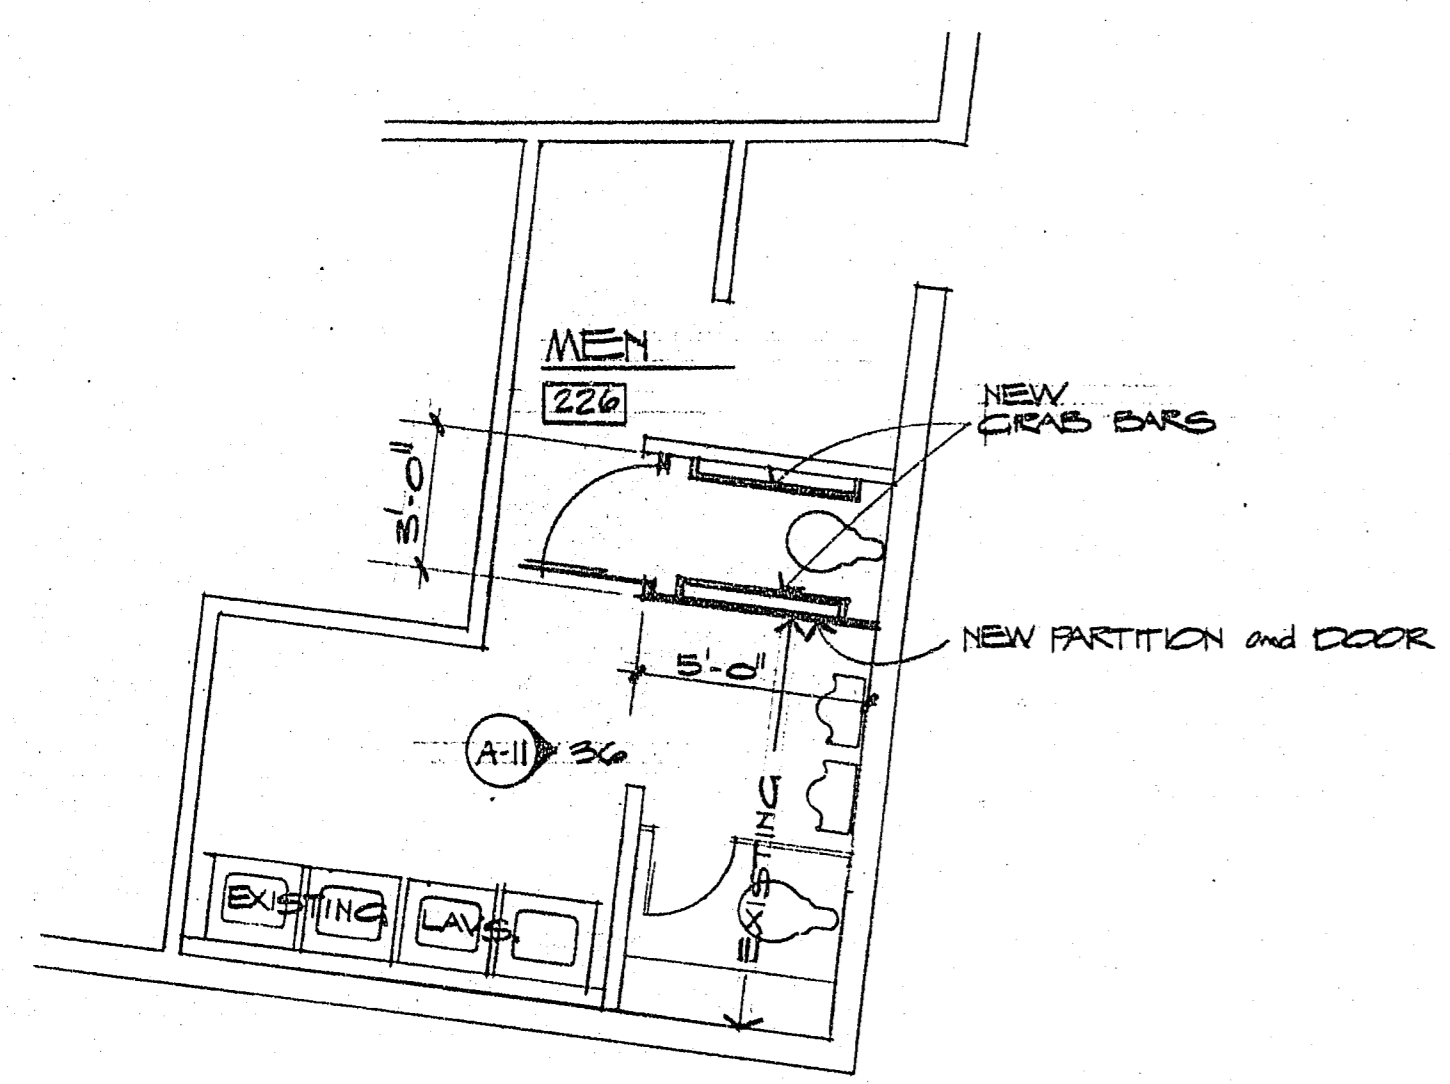

MEN 226  
SCALE: 1/4" = 1'-0"

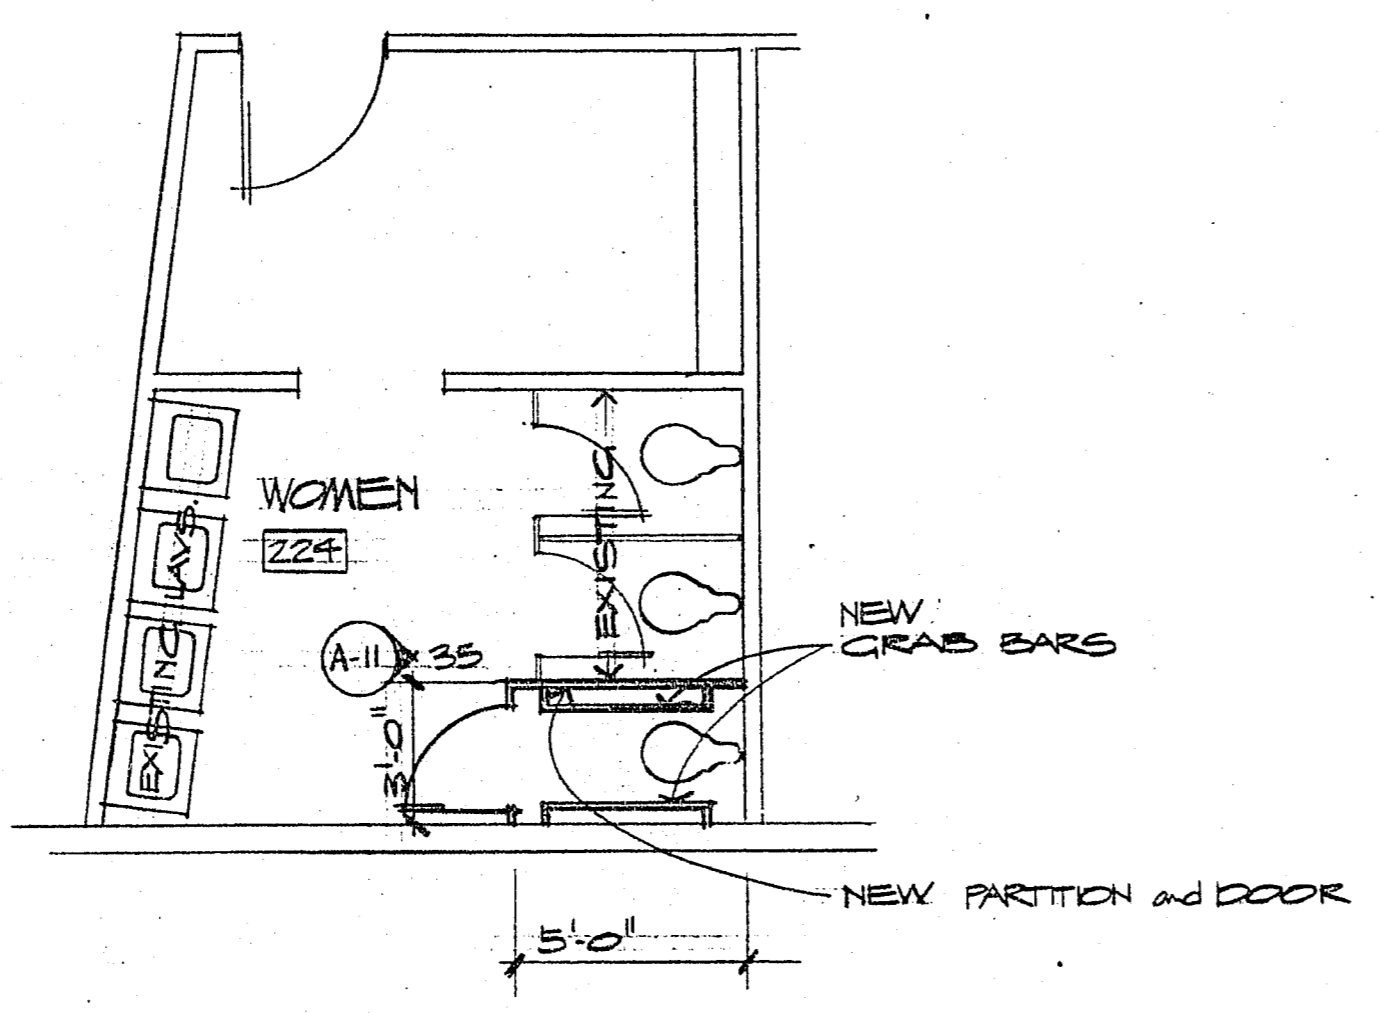

WOMEN 224  
SCALE: 1/4" = 1'-0"

NOTES

SCALE: 1/4" = 1'-0" UNLESS OTHERWISE NOTED  
FOR INTERIOR ELEVATION NOTES SEE  
FINISH SCHEDULE SHEET A-9

513-468

AS BUILT OCT 1979

DATE MARCH 78  
DRAWN C. DB  
CHECKED T.D.  
JOB NO. 77-35

THOMAS A. DOBRUSKY  
ARCHITECT AIA  
217 MARYLAND PARKWAY LAS VEGAS, NEVADA 89101 (702) 385-5266

CULTURAL SERVICES COMPLEX  
REED WHIPPLE • LAS VEGAS, NEVADA

SHEET  
**A-13**

FILE NUMBER  
2-26

6-50