

GENERAL NOTES

COORDINATE DEMOLITION WITH WORK SHOWN ELSEWHERE IN THE CONTRACT DOCUMENTS.


SEE MECHANICAL AND ELECTRICAL DRAWINGS FOR DEMOLITION REQUIRED. PATCH ADJACENT SURFACES AS REQ'D AFTER DEMOLITION.

CONTRACTOR SHALL BE RESPONSIBLE FOR FIELD VERIFICATION OF ALL CONDITIONS PRIOR TO BIDDING.

NO EXTRAS WILL BE ALLOWED FOR DEMOLITION REQUIRED IN EXCESS OF WHAT IS INDICATED ON THIS DRAWING IF THE EXTENT OF NEW WORK REQUIRED IS SHOWN ELSEWHERE.

AS BUILT DRAWINGS MAY BE INSPECTED BY THE CONTRACTOR. COORDINATE WITH THE CITY OF LAS VEGAS DEPARTMENT OF DESIGN AND DEVELOPMENT.

REMOVE LAM. PLASTIC AS REQUIRED ON CABINETS TO ACCOMMODATE NEW CONSTRUCTION.

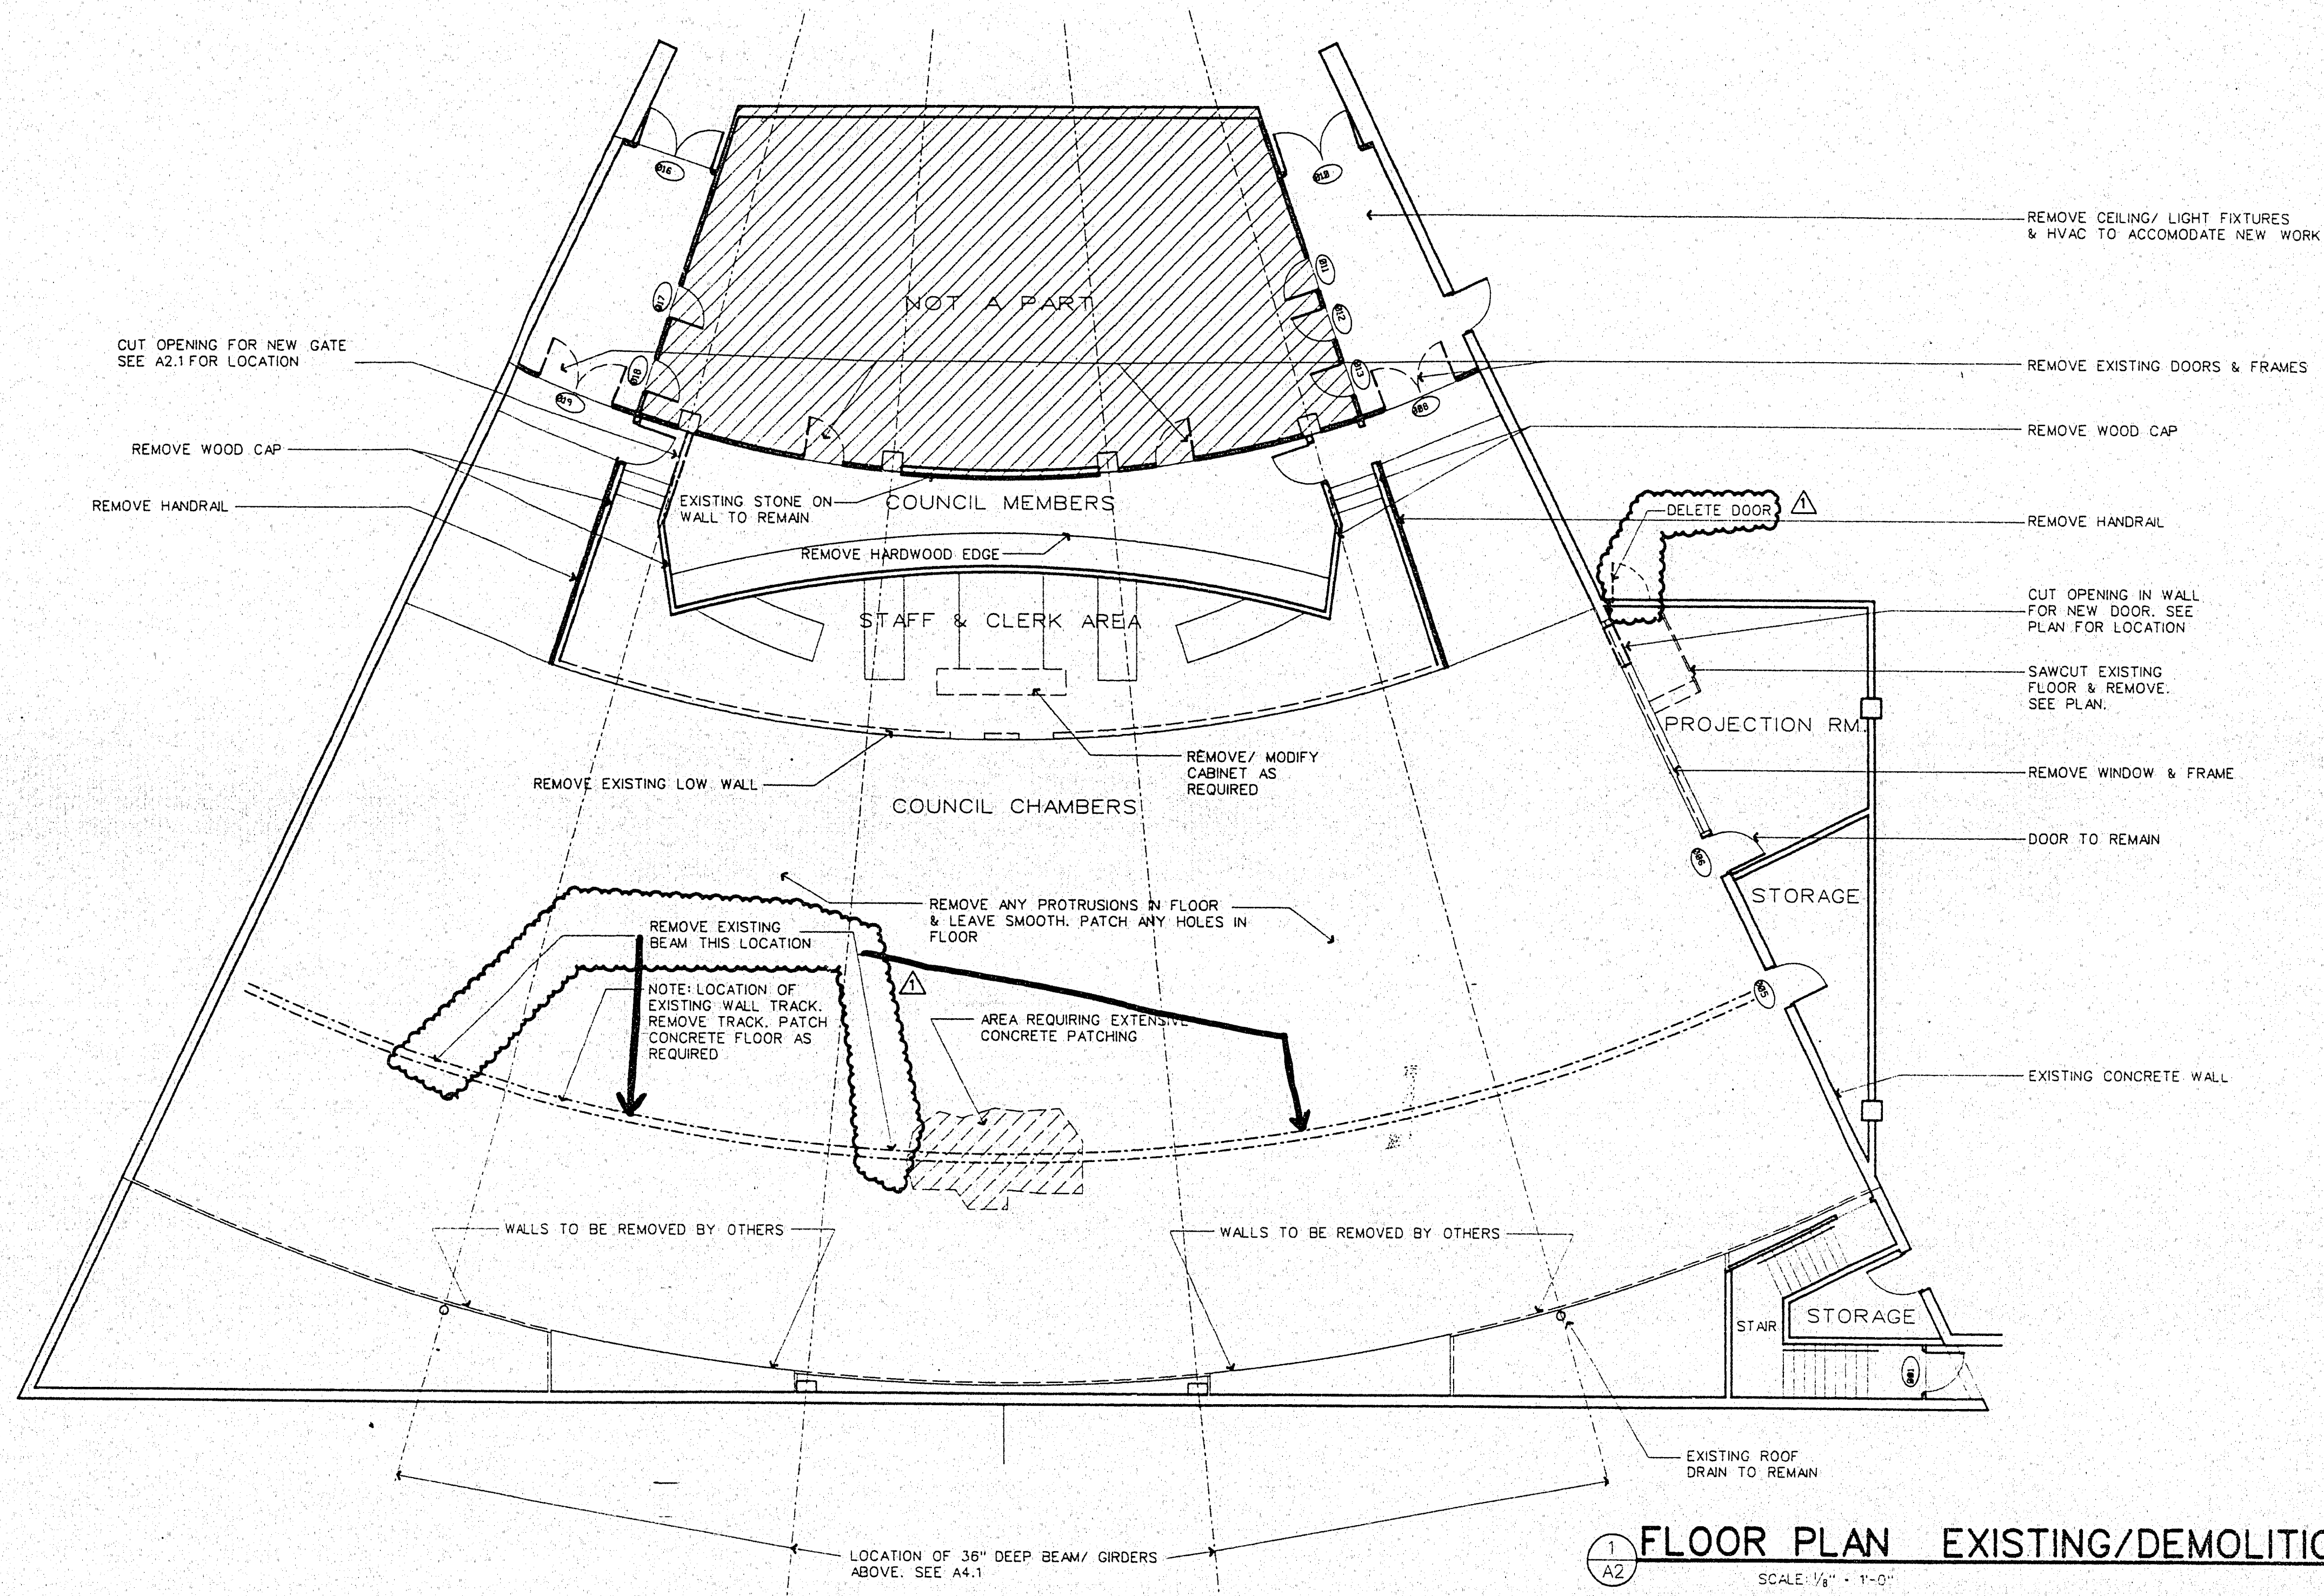


FLOOR PLAN EXISTING/DEMOLITION
SCALE: 1/8" = 1'-0"

CONGDON ASSOCIATES
architecture ♦ planning ♦ interiors
3311 south jones boulevard, suite 212a
las vegas, nevada, 89102 702-362-3999

REVISIONS: Δ 02/19/91
THESE REVISIONS AND PREVIOUS ARE THE PROPERTY OF THE ARCHITECT AND MAY NOT BE REPRODUCED OR DISTRIBUTED FOR OTHER PURPOSES WITHOUT THE WRITTEN CONSENT OF CONGDON ASSOCIATES. AS INSTRUMENTS OF SERVICE, THESE DRAWINGS ARE NOT VALID UNLESS THEY ARE SIGNED, SEALED AND DATED BY THE ARCHITECT.

DRAWING TITLE: FLOOR PLAN (existing/demolition)
PROJECT: CITY COUNCIL CHAMBERS renovation

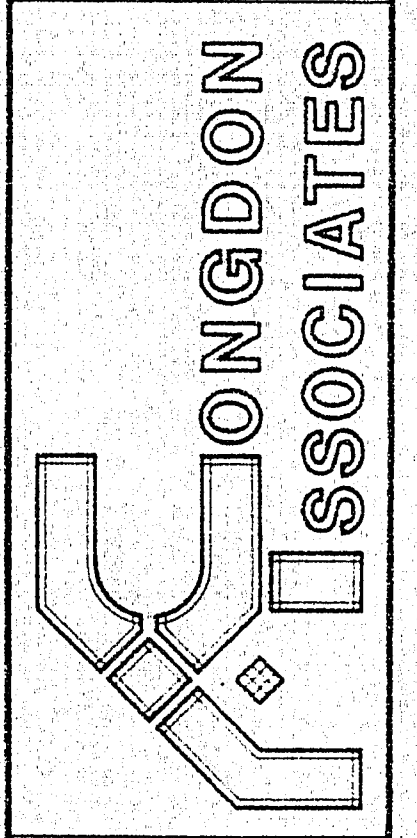

PROJECT: 9019
DATE: JAN. 21, 1991

DRAWING NO.: A1.0
3 of 19
521-218

PROJECT RECORD 8/29/91