
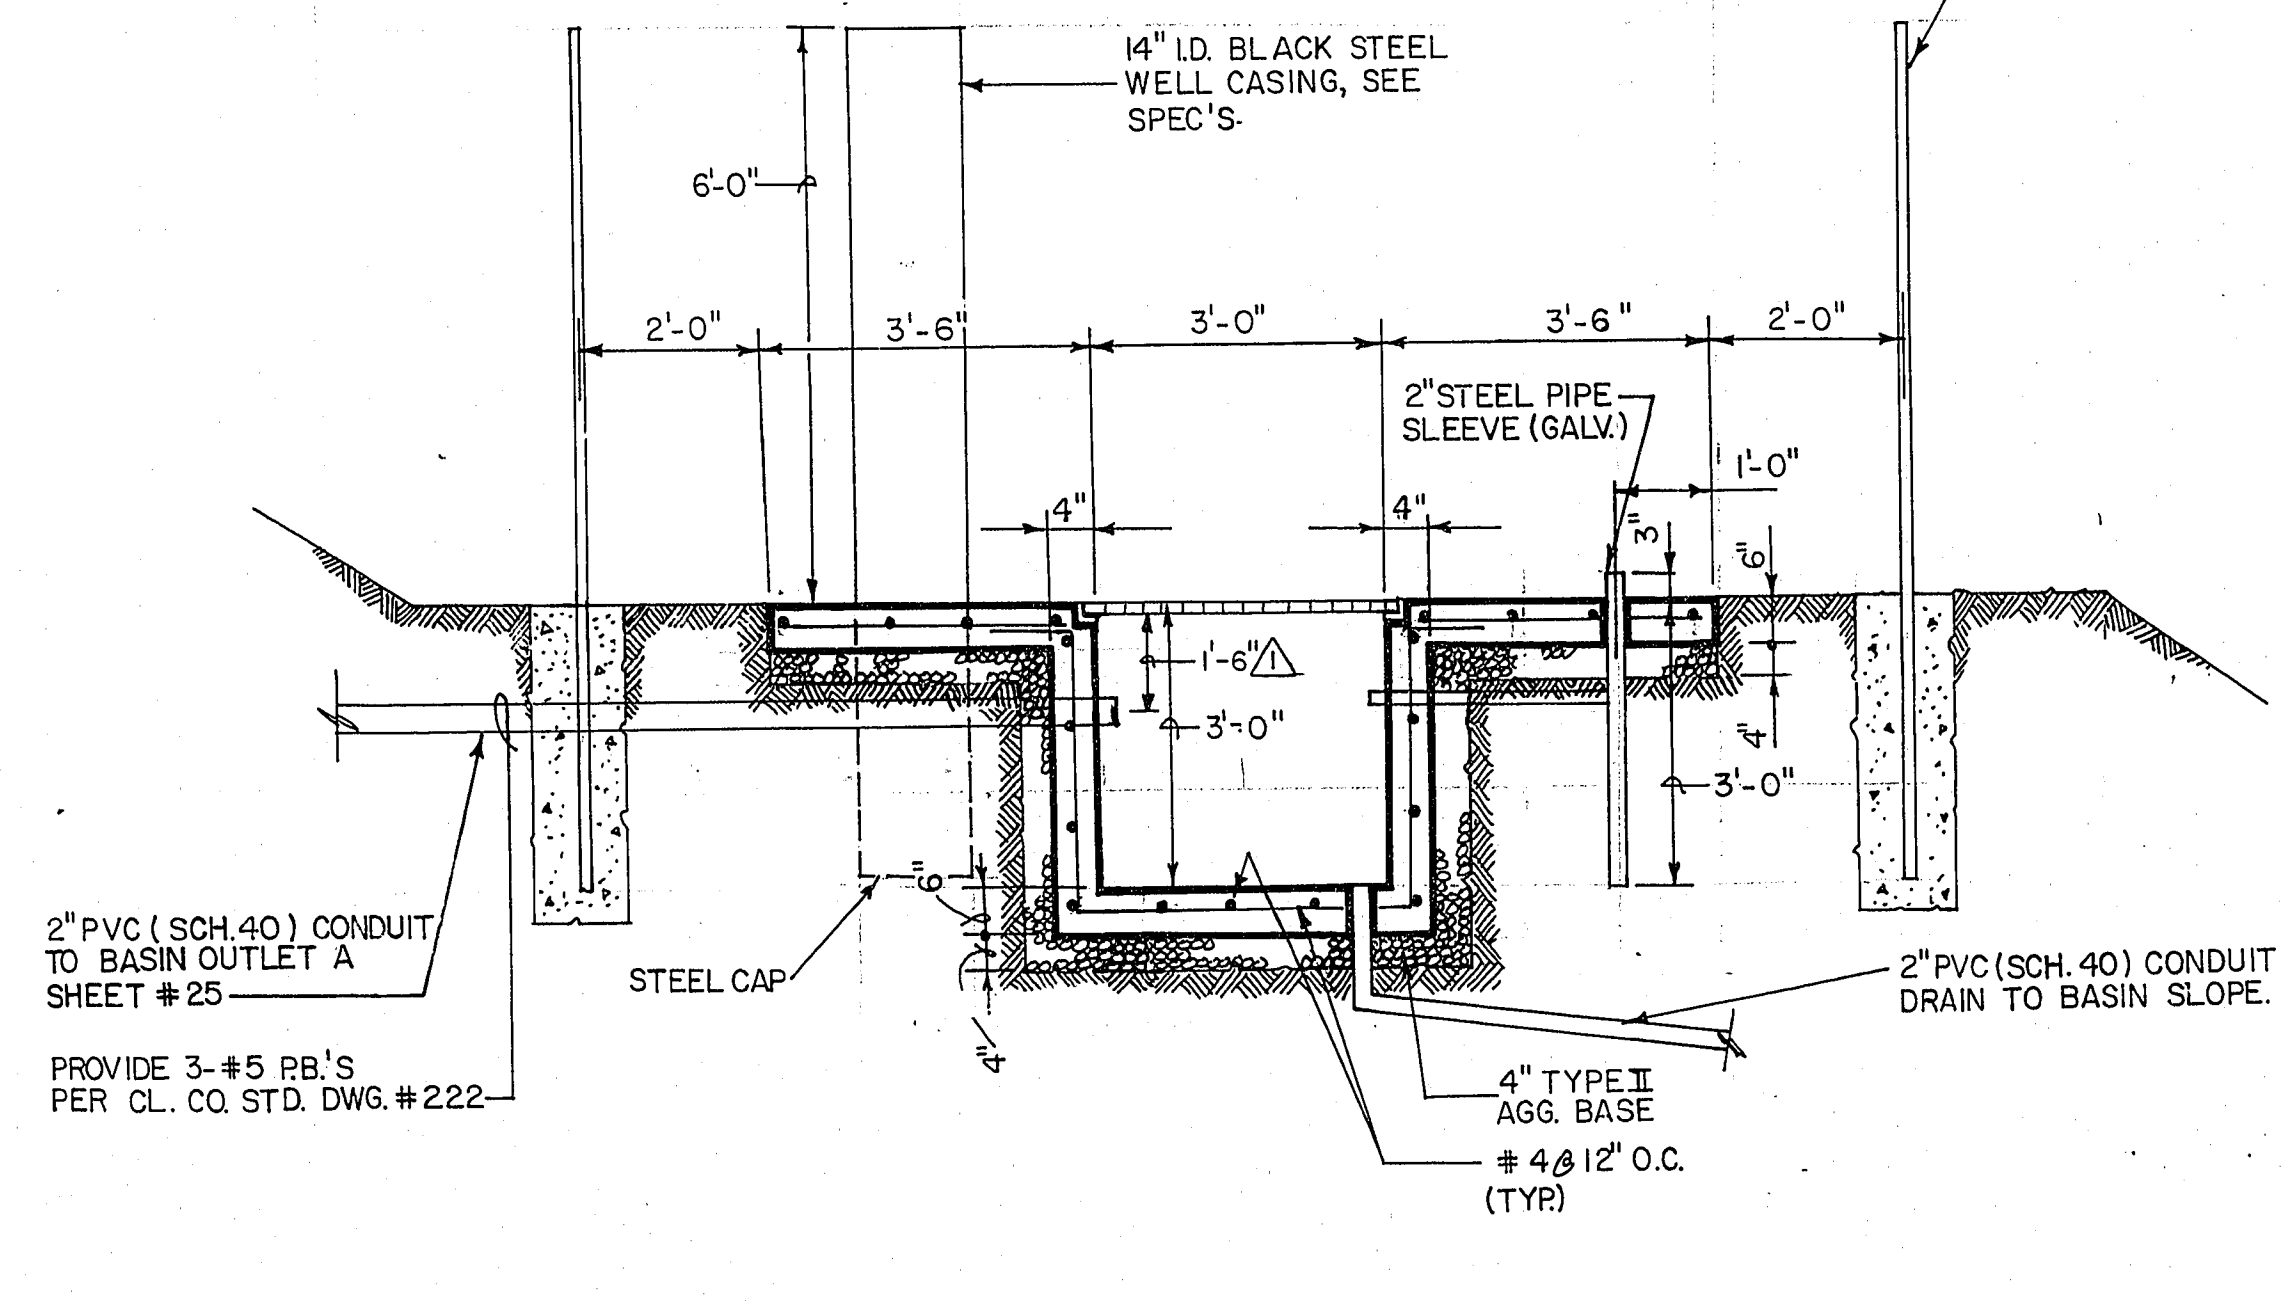


WEATHER STATION PAD
1/2"=1'-0"

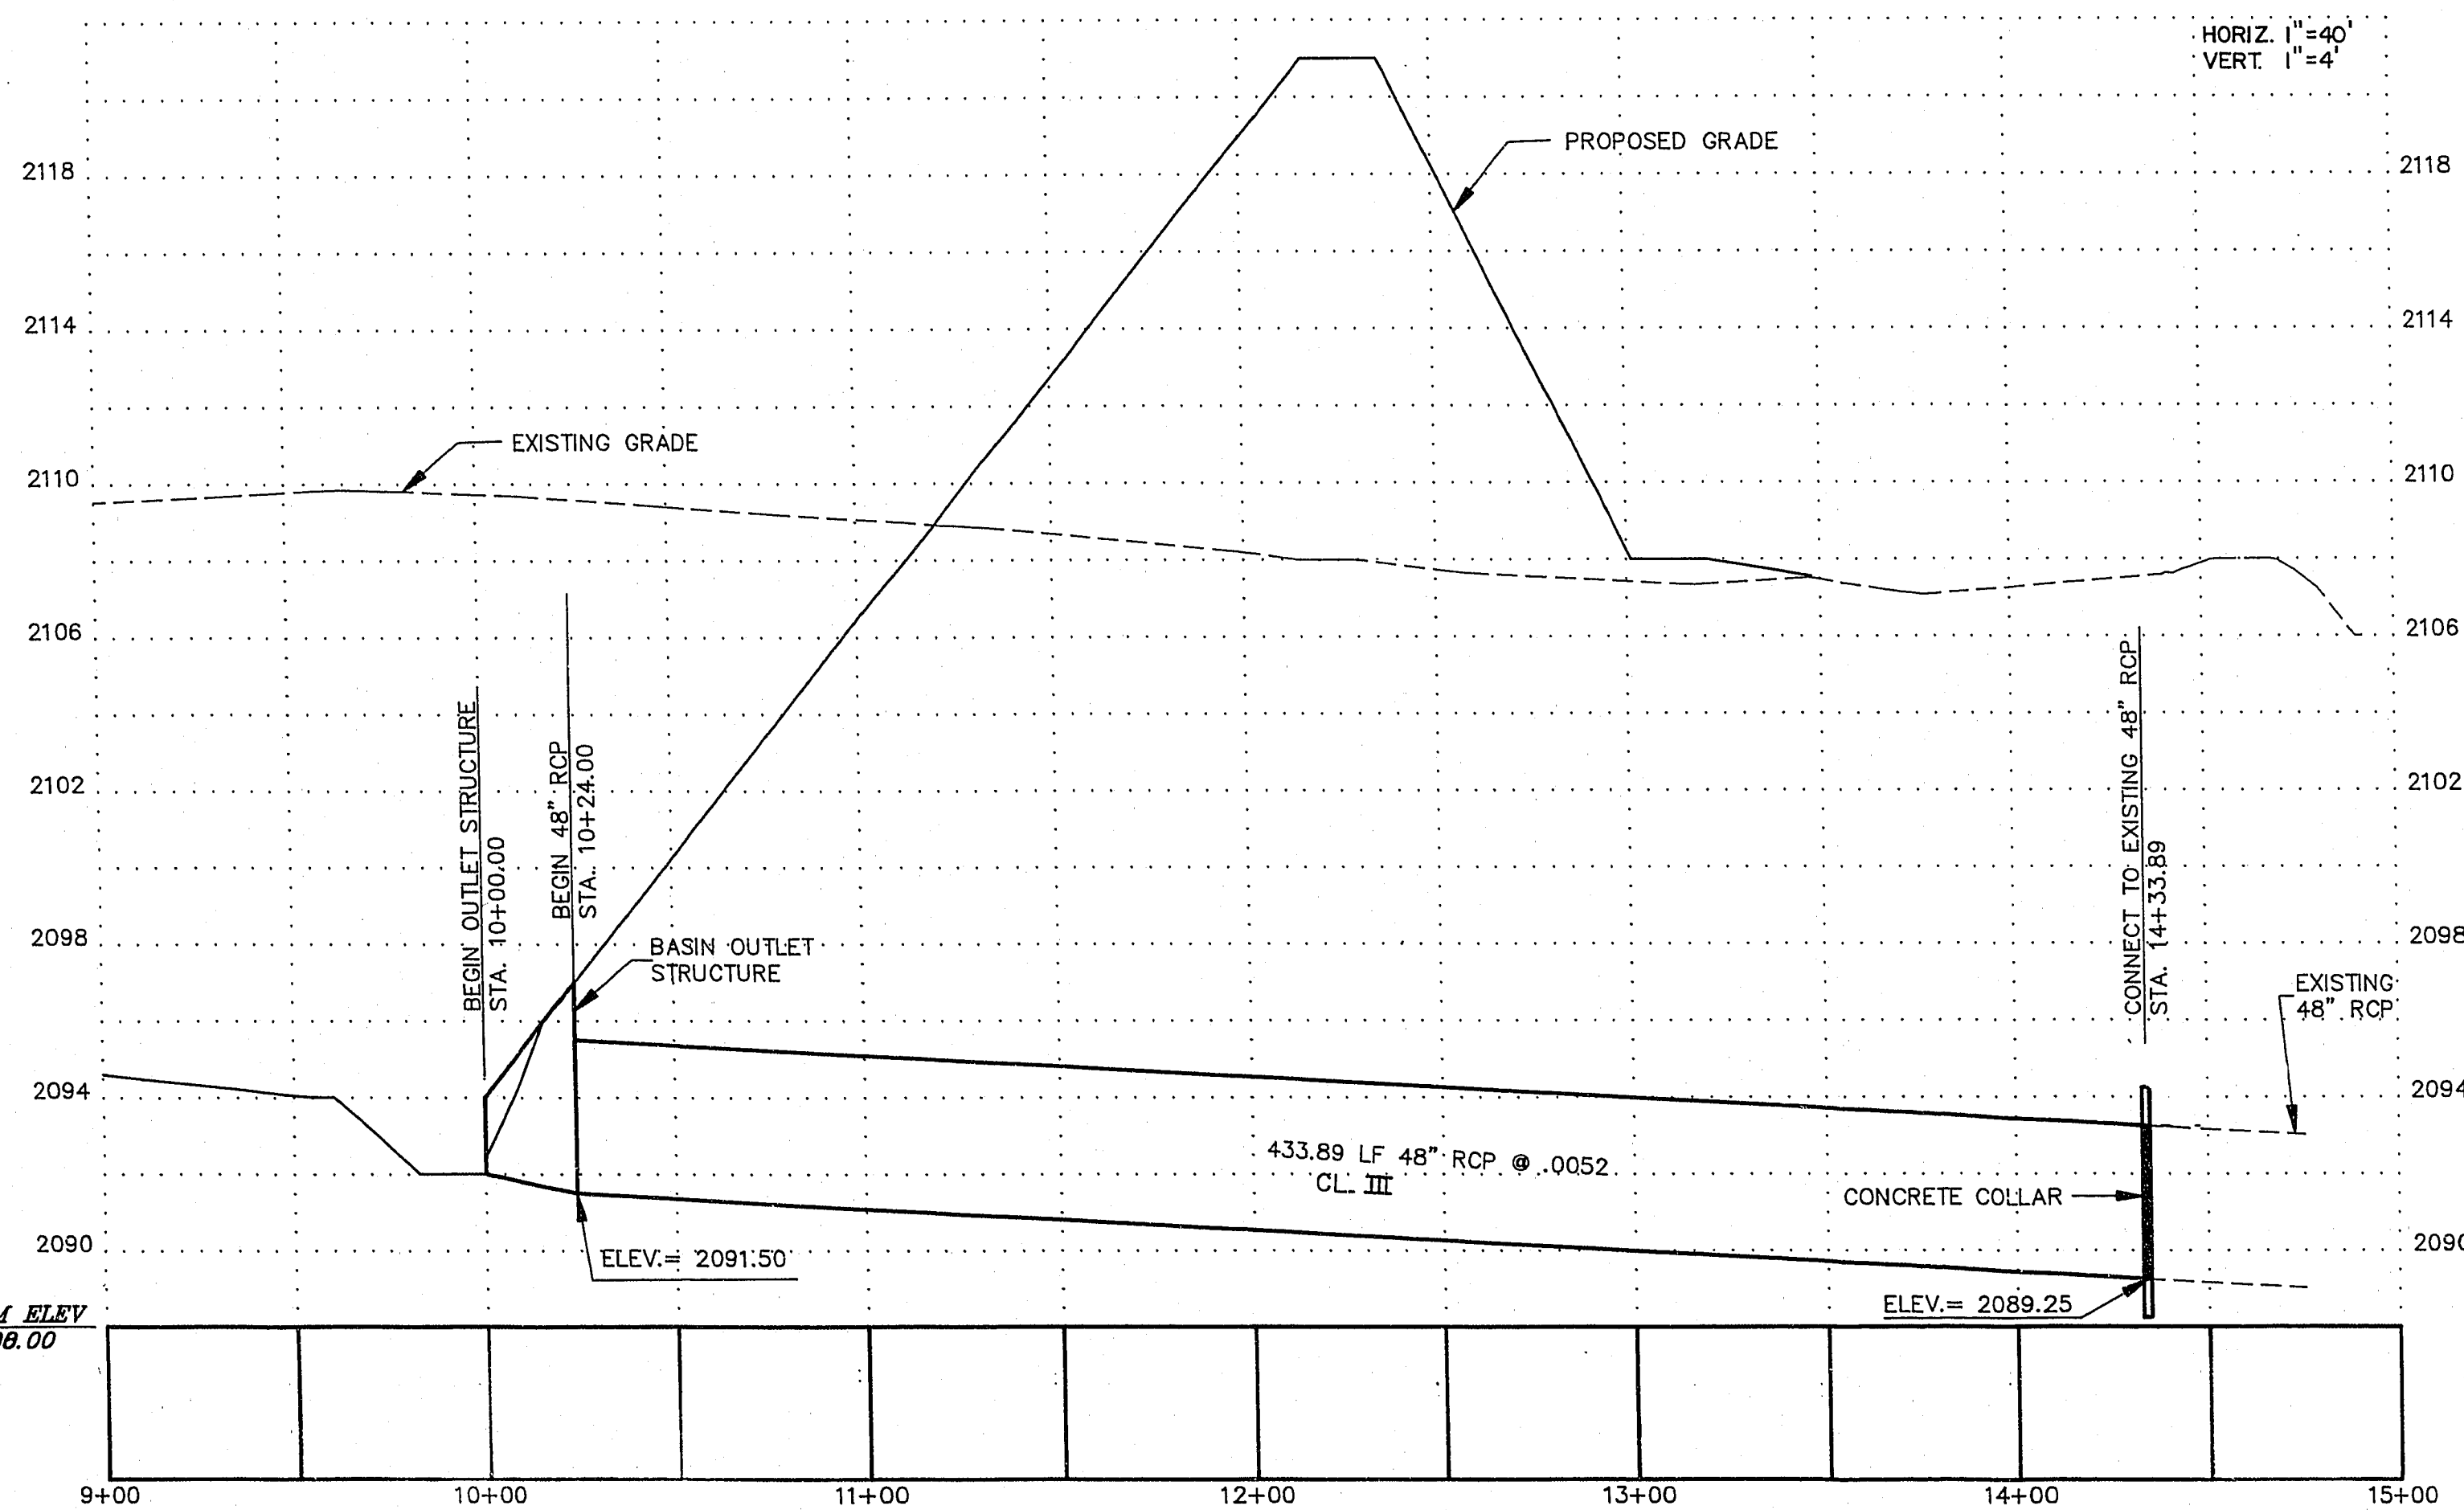

SECTION
1/2"=1'-0"

NO. 10-8-92	BY	ASBUILT	REVISION
NO. 8-17-91	DATE	KG/DB	DIM. TO PIPE C
NO. 1-17-91	DATE	BY	BY

CITY OF LAS VEGAS
CLARK COUNTY, NEVADA

CONSULTING ENGINEERS • PLANNERS • LAND SURVEYORS
2727 SOUTH RAINBOW BOULEVARD
LAS VEGAS, NEVADA 89102-5148 PHONE (702) 873-7550 FAX (702) 362-2597

vtn nevada

TITLE
PLAN & PROFILE
STORM DRAIN OUTLET PIPE

PROJECT
CAREY / LAKE MEAD
DETENTION BASIN



NO. 3996
BY **MAS/BKP/WJR**
DATE **JUNE 5, 1991**
SCALE AS SHOWN
SHEET **20** OF 31 SHEETS