


NO.	REVISIONS	DATE

DEPARTMENT OF PUBLIC WORKS
 ARCHITECTURAL SERVICES
 DESIGN BY: _____ DRAWN BY: _____
 DATE: 10-95 SCALE: _____

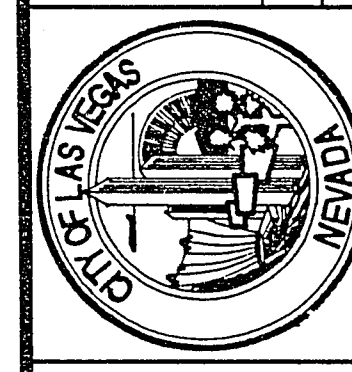

PROJECT:
 CITY HALL RENOVATION
 SIXTH FLOOR

SHEET:
 FIRE SPRINKLER AS-BUILT
 PIPING PLAN

DRAWING NO. 20
 521-237
 FILE NAME: CPM-2020