


CURVE DATA


NO.	Δ	R	L	T
1	43°09'47"	151.69'	114.27'	60'
2	85°20'19"	65.09'	96.95'	60'

ANGEL PARK DETENTION BASIN

NOTE:
1. FOR THE ANGEL PARK DETENTION BASIN
(NORTH BASIN) GRADING SEE SHEET 31
2. NO. 5 PULL BOX PER CLARK COUNTY
STD. DWG. NO. 222

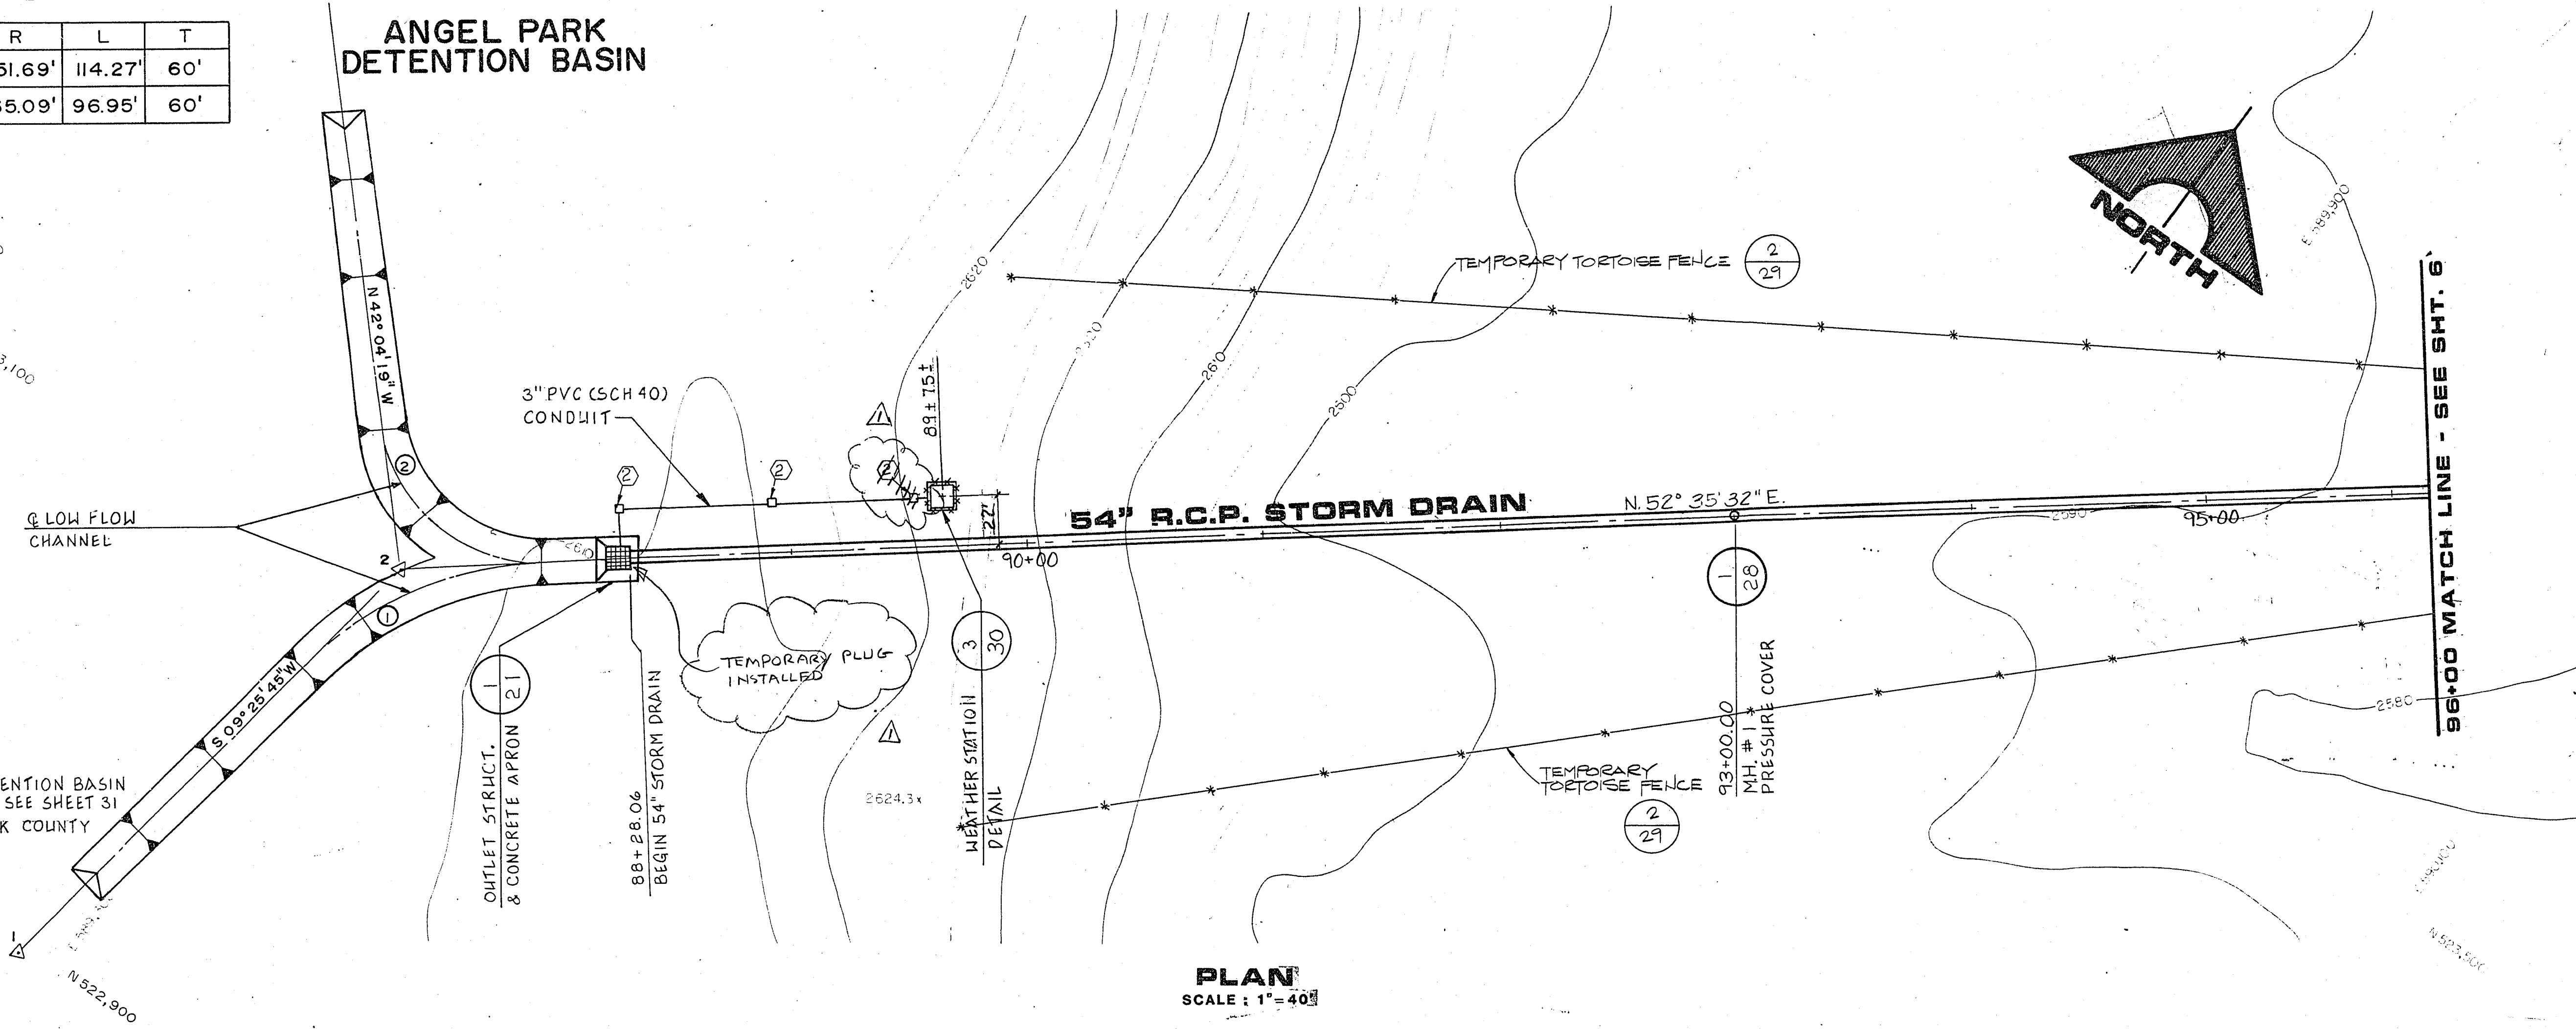

PLAN
SCALE: 1"=40'

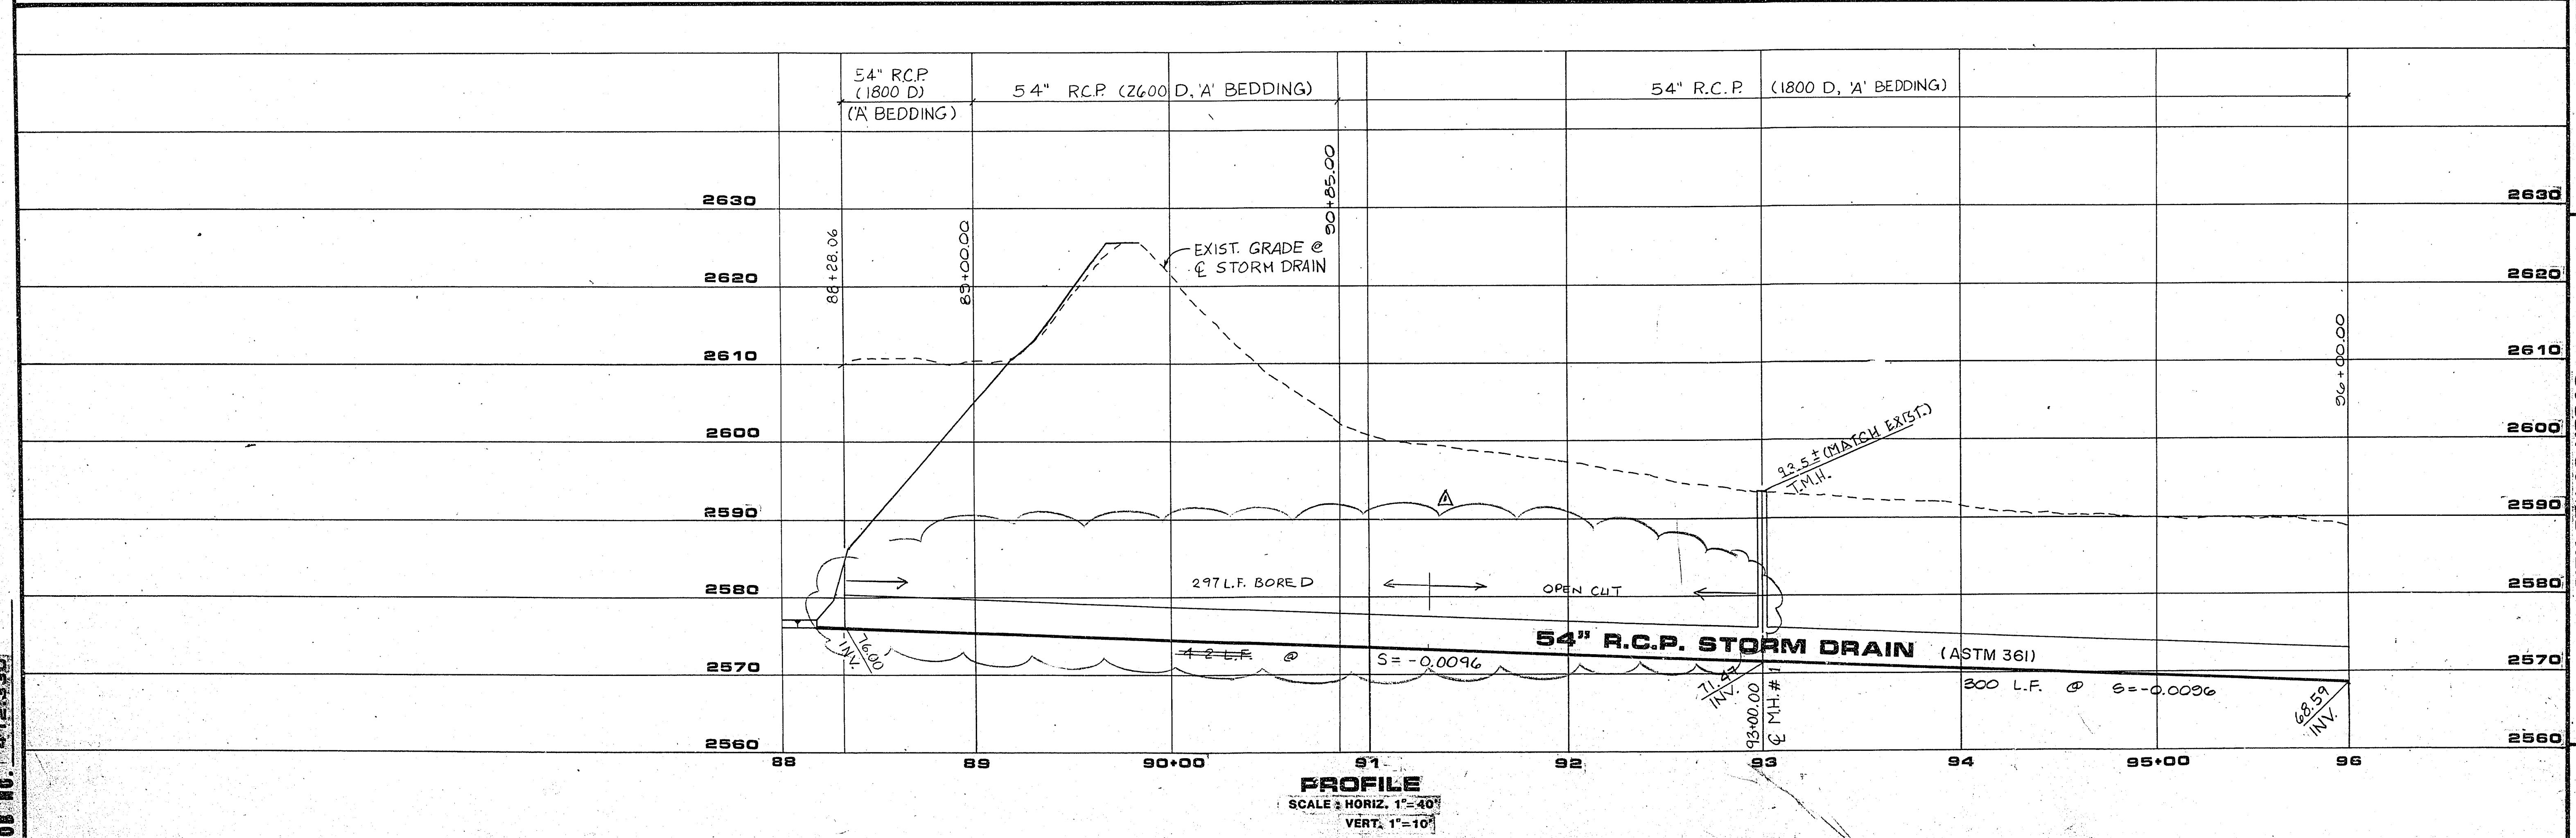

PROFILE
SCALE: HORIZ. 1"=40'
VERT. 1"=10'

REVISION	DATE	DESCRIPTION
1	05-01-92	AS-BUILT

7/87	DATE
	R.E. NO.

RECORDED & RETURNED TO THE CITY OF LAS VEGAS

7/87

RECORD DRAWING- 13 MAY 92

1555 SOUTH RAINBOW BLVD. LAS VEGAS, NEVADA 89102

G.C. WALLACE, INC.
Engineering/Architecture

CITY OF LAS VEGAS

ANGEL PARK OUTLET AND OUTFALL

PLAN AND PROFILE

STATION 88+28.06 TO 96+00.00

SHEET

5

OF 31 SHEETS

737-49