
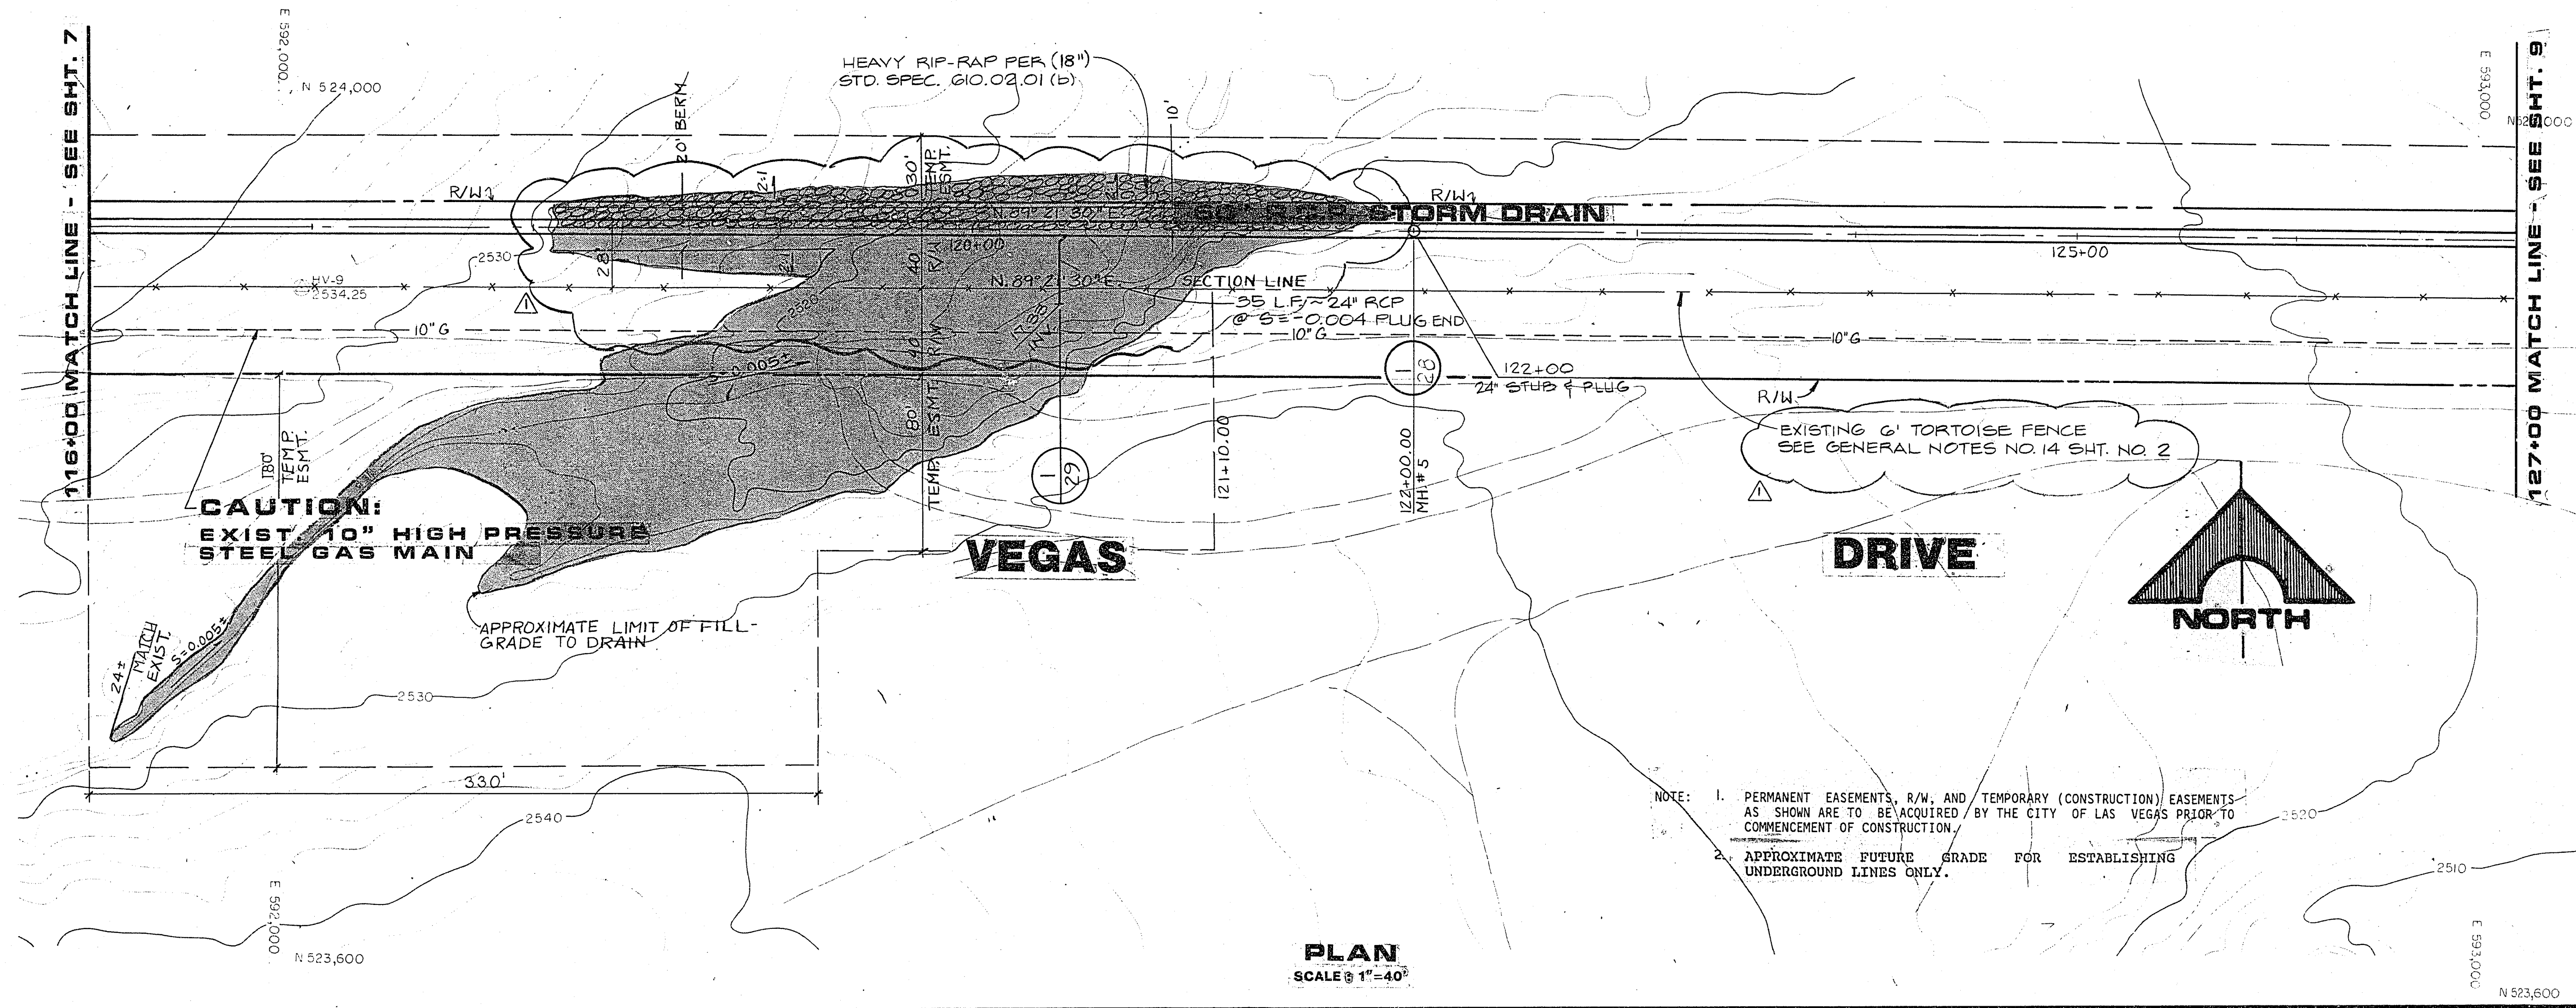


JOB NO. 412350

CAN 100888

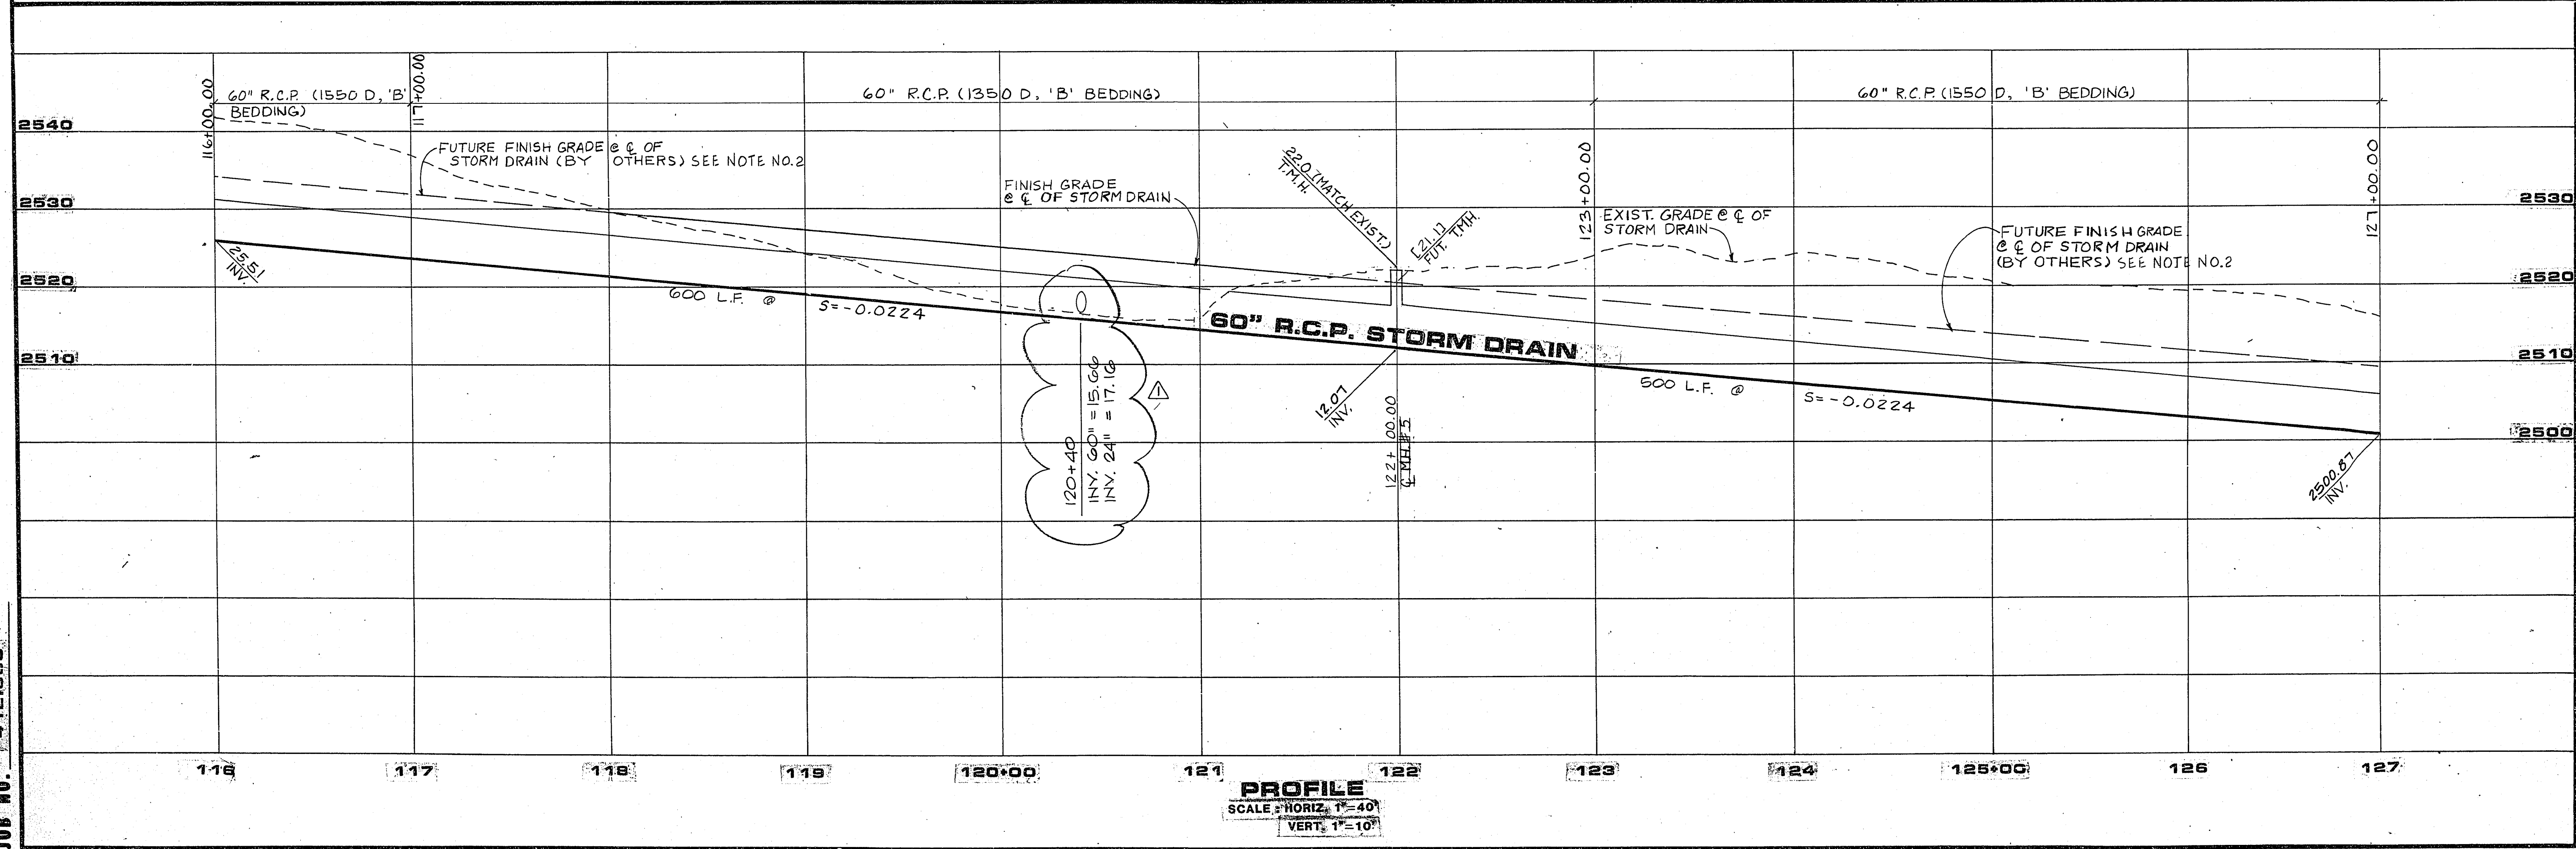

G.C. WALLACE, INC.
Engineering/Architecture
RECORD DRAWING - 13 MAY 92
1555 SOUTH RAINBOW BLVD./LAS VEGAS, NEVADA 89102

CITY OF LAS VEGAS
ANGEL PARK OUTLET AND OUTFALL
PLAN AND PROFILE
STATION 116+00 TO 127+00

SHEET
8
OF 31 SHEETS

731-49