


**PART. 2ND FLOOR PLAN (A)**  
1/2" = 1'-0"

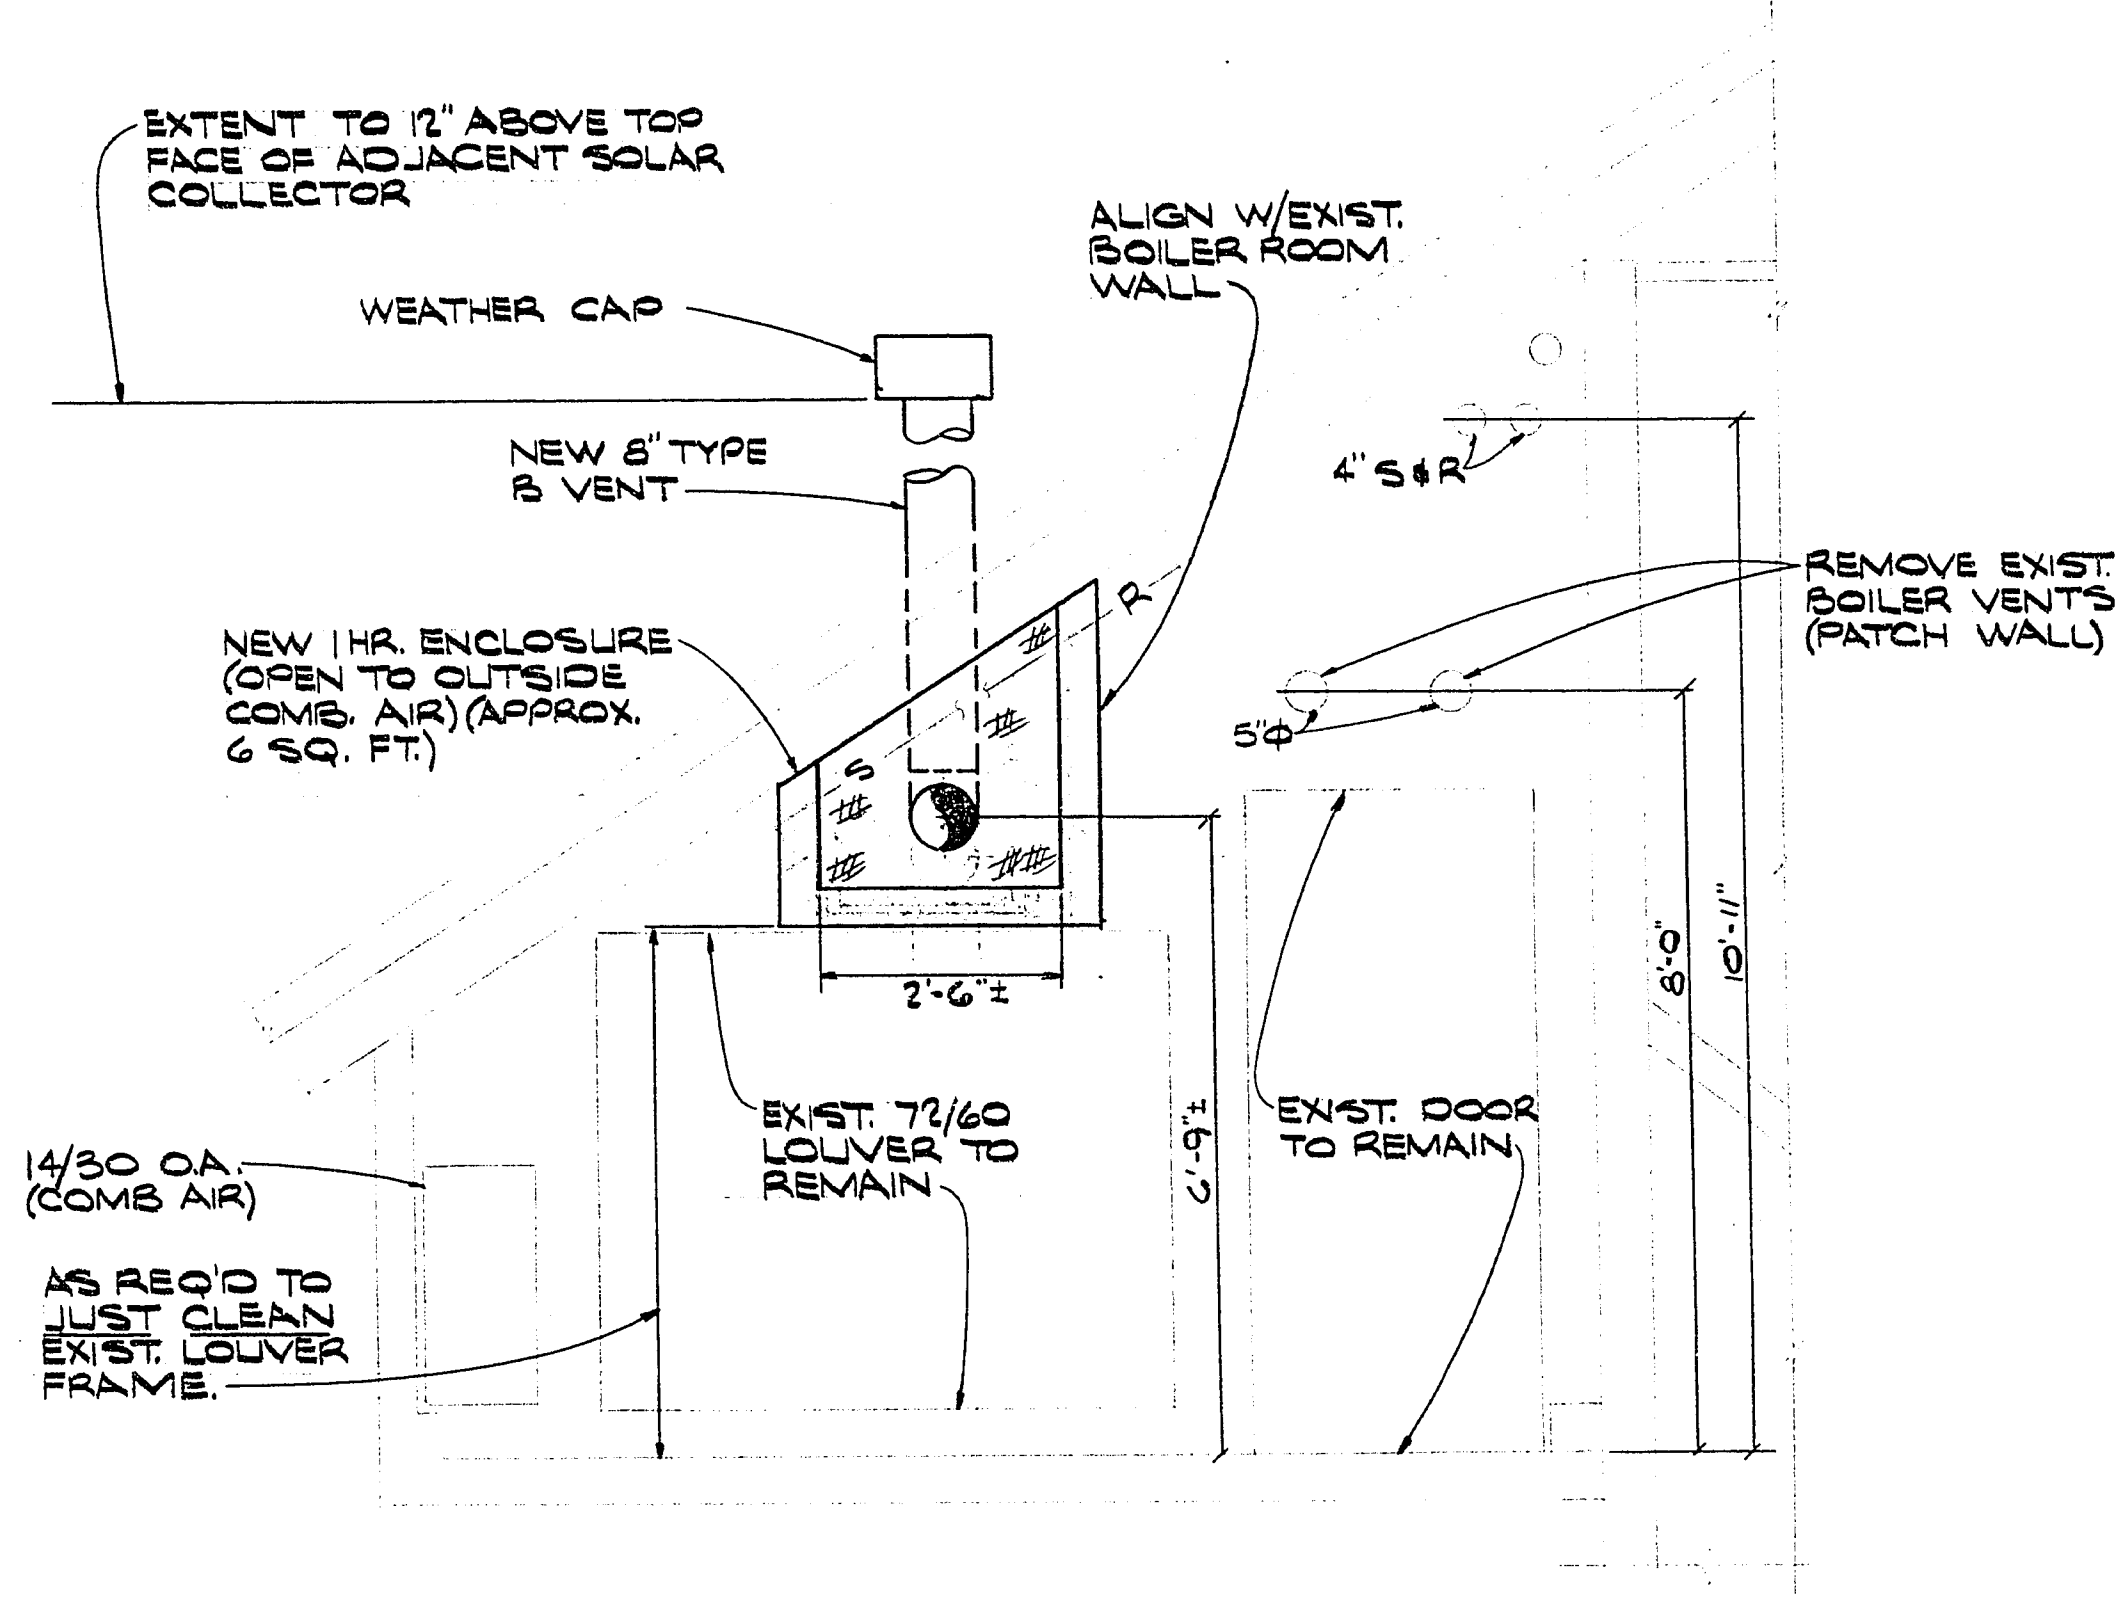

**SECTION (B)**  
1/2" = 1'-0"

- NOTES**
1. PROVIDE AUTO CLOSER ON NEW & EXIST. DOORS (2)
  2. ADD NEW LIGHT FIXTURE TO MATCH EXIST. & SWITCH W/BOIL. ROOM.
  3. NEW 1 HOUR WALLS SHOWN SHADED.

*J. Schmitt*  
3-20-11

*[Signature]*  
3-20-11

<p>drawn by: RMMV checked by: R.T.J. date: 2-11-11</p>		<p>7/99/ R.J. REVISION PER GLEN JOHNSON date by revision</p>
<p>963 EAST SAHARA, SUITE B-23 LAS VEGAS, NEVADA 89104</p>		
<p>1475 TERMINAL WAY, SUITE C RENO, NEVADA 89502</p>		
<p><b>jba</b> CONSULTING ENGINEERS</p>		
<p>STORAGE ROOM ADDITION SAHARA-VOJAVE RECREATION CENTER LAS VEGAS NEVADA</p>		
<p>sheet no: 1</p>	<p>of: 1</p>	