

SHEET NO. 9

GRADING PLAN 5

SHEET NO. 8

GRADING PLAN 4

SHEET NO. 7



GRADING PLAN 3

SHEET NO. 6

GRADING PLAN 2


SHEET NO. 5

GRADING PLAN 1

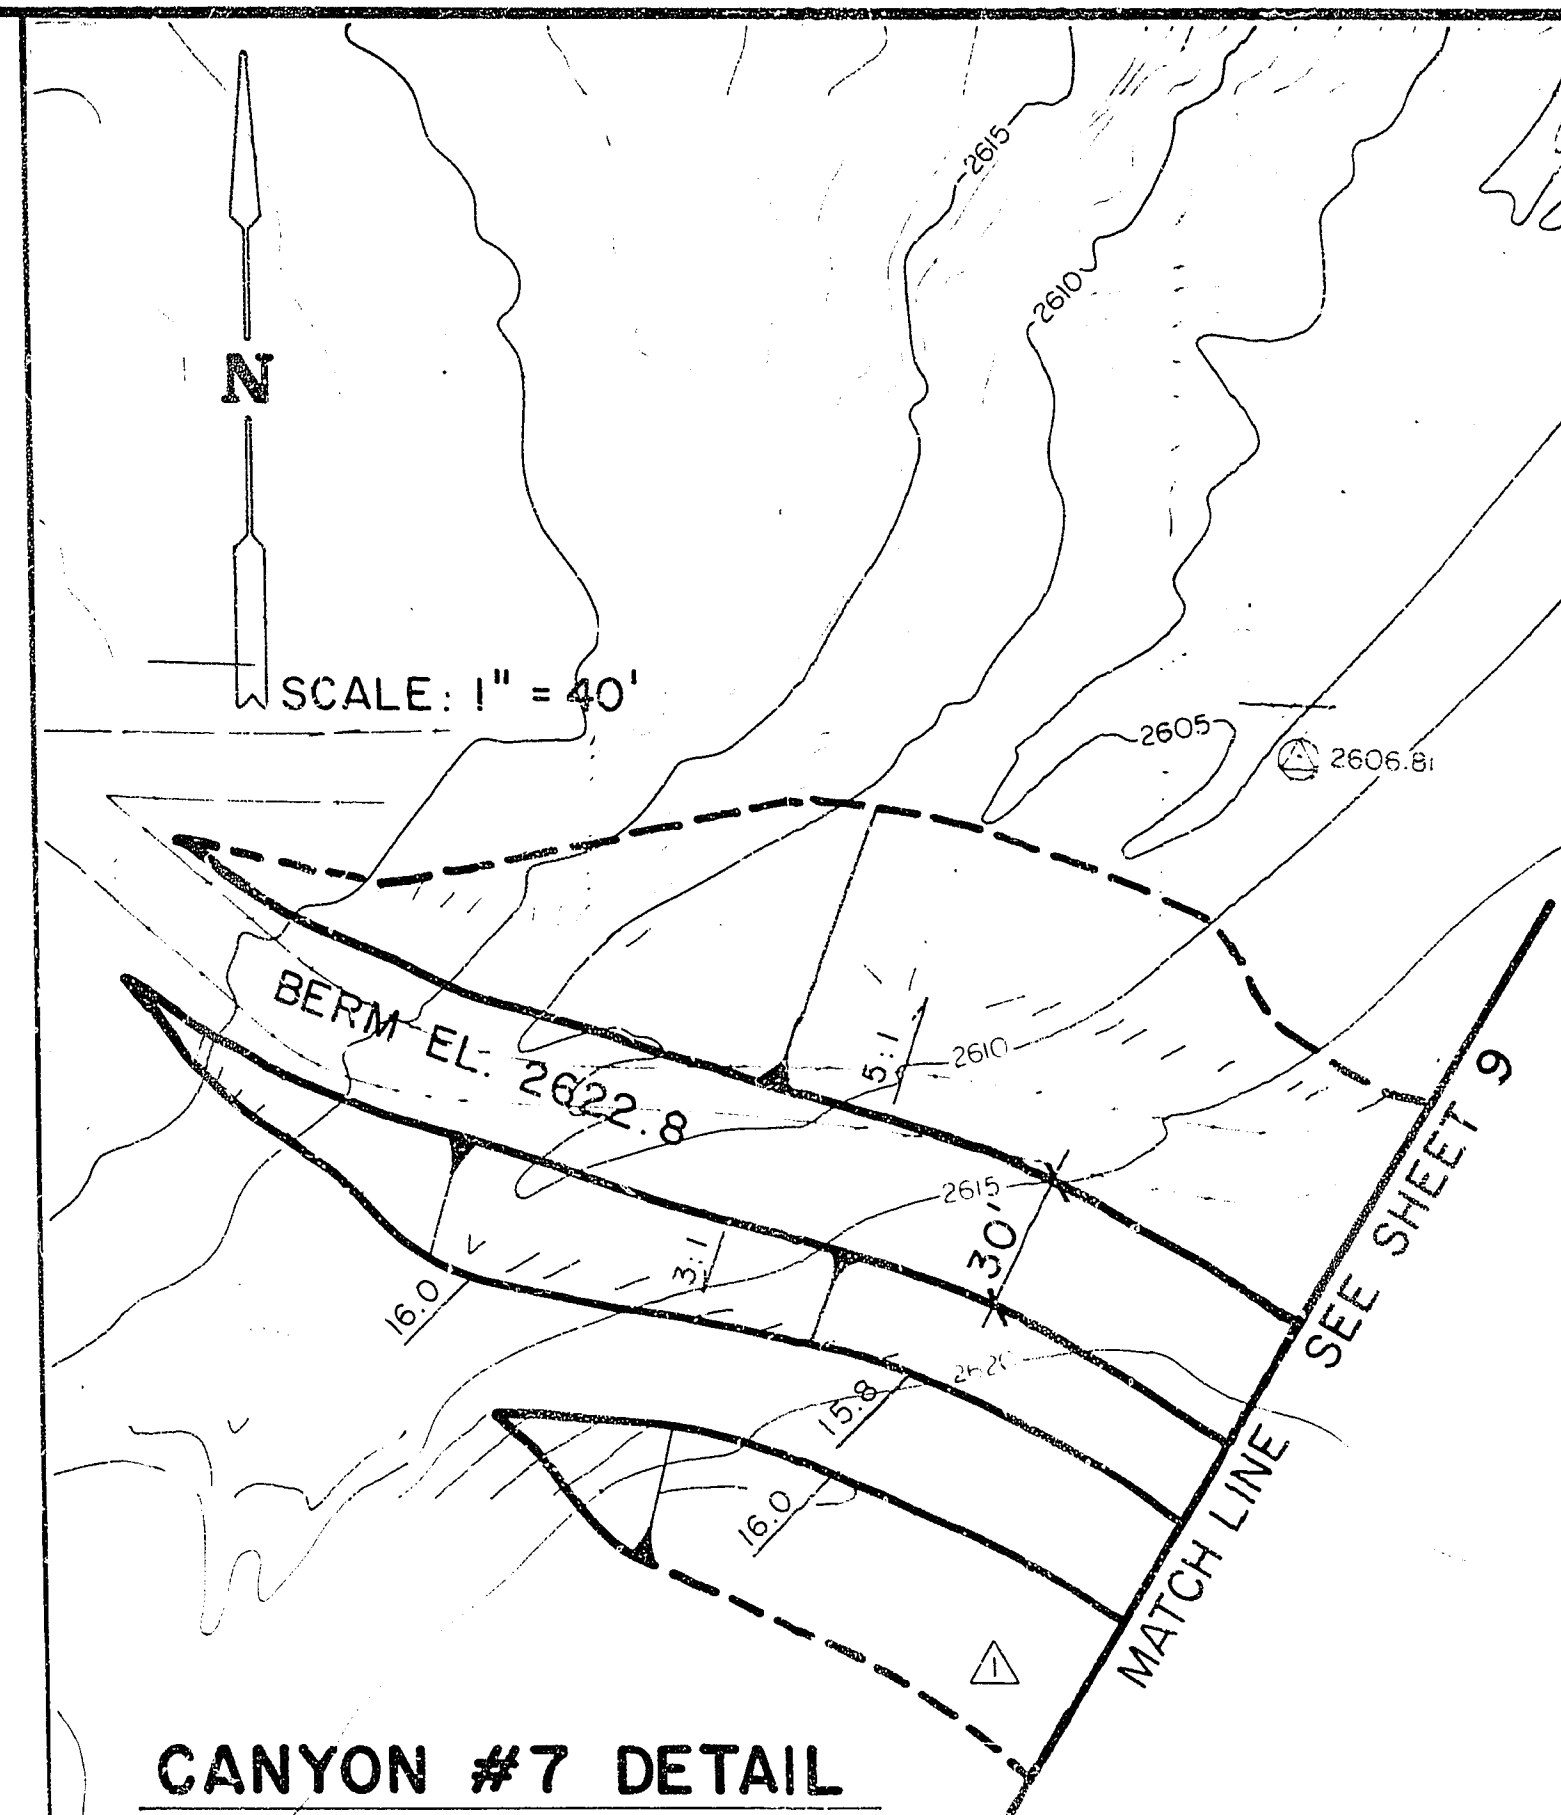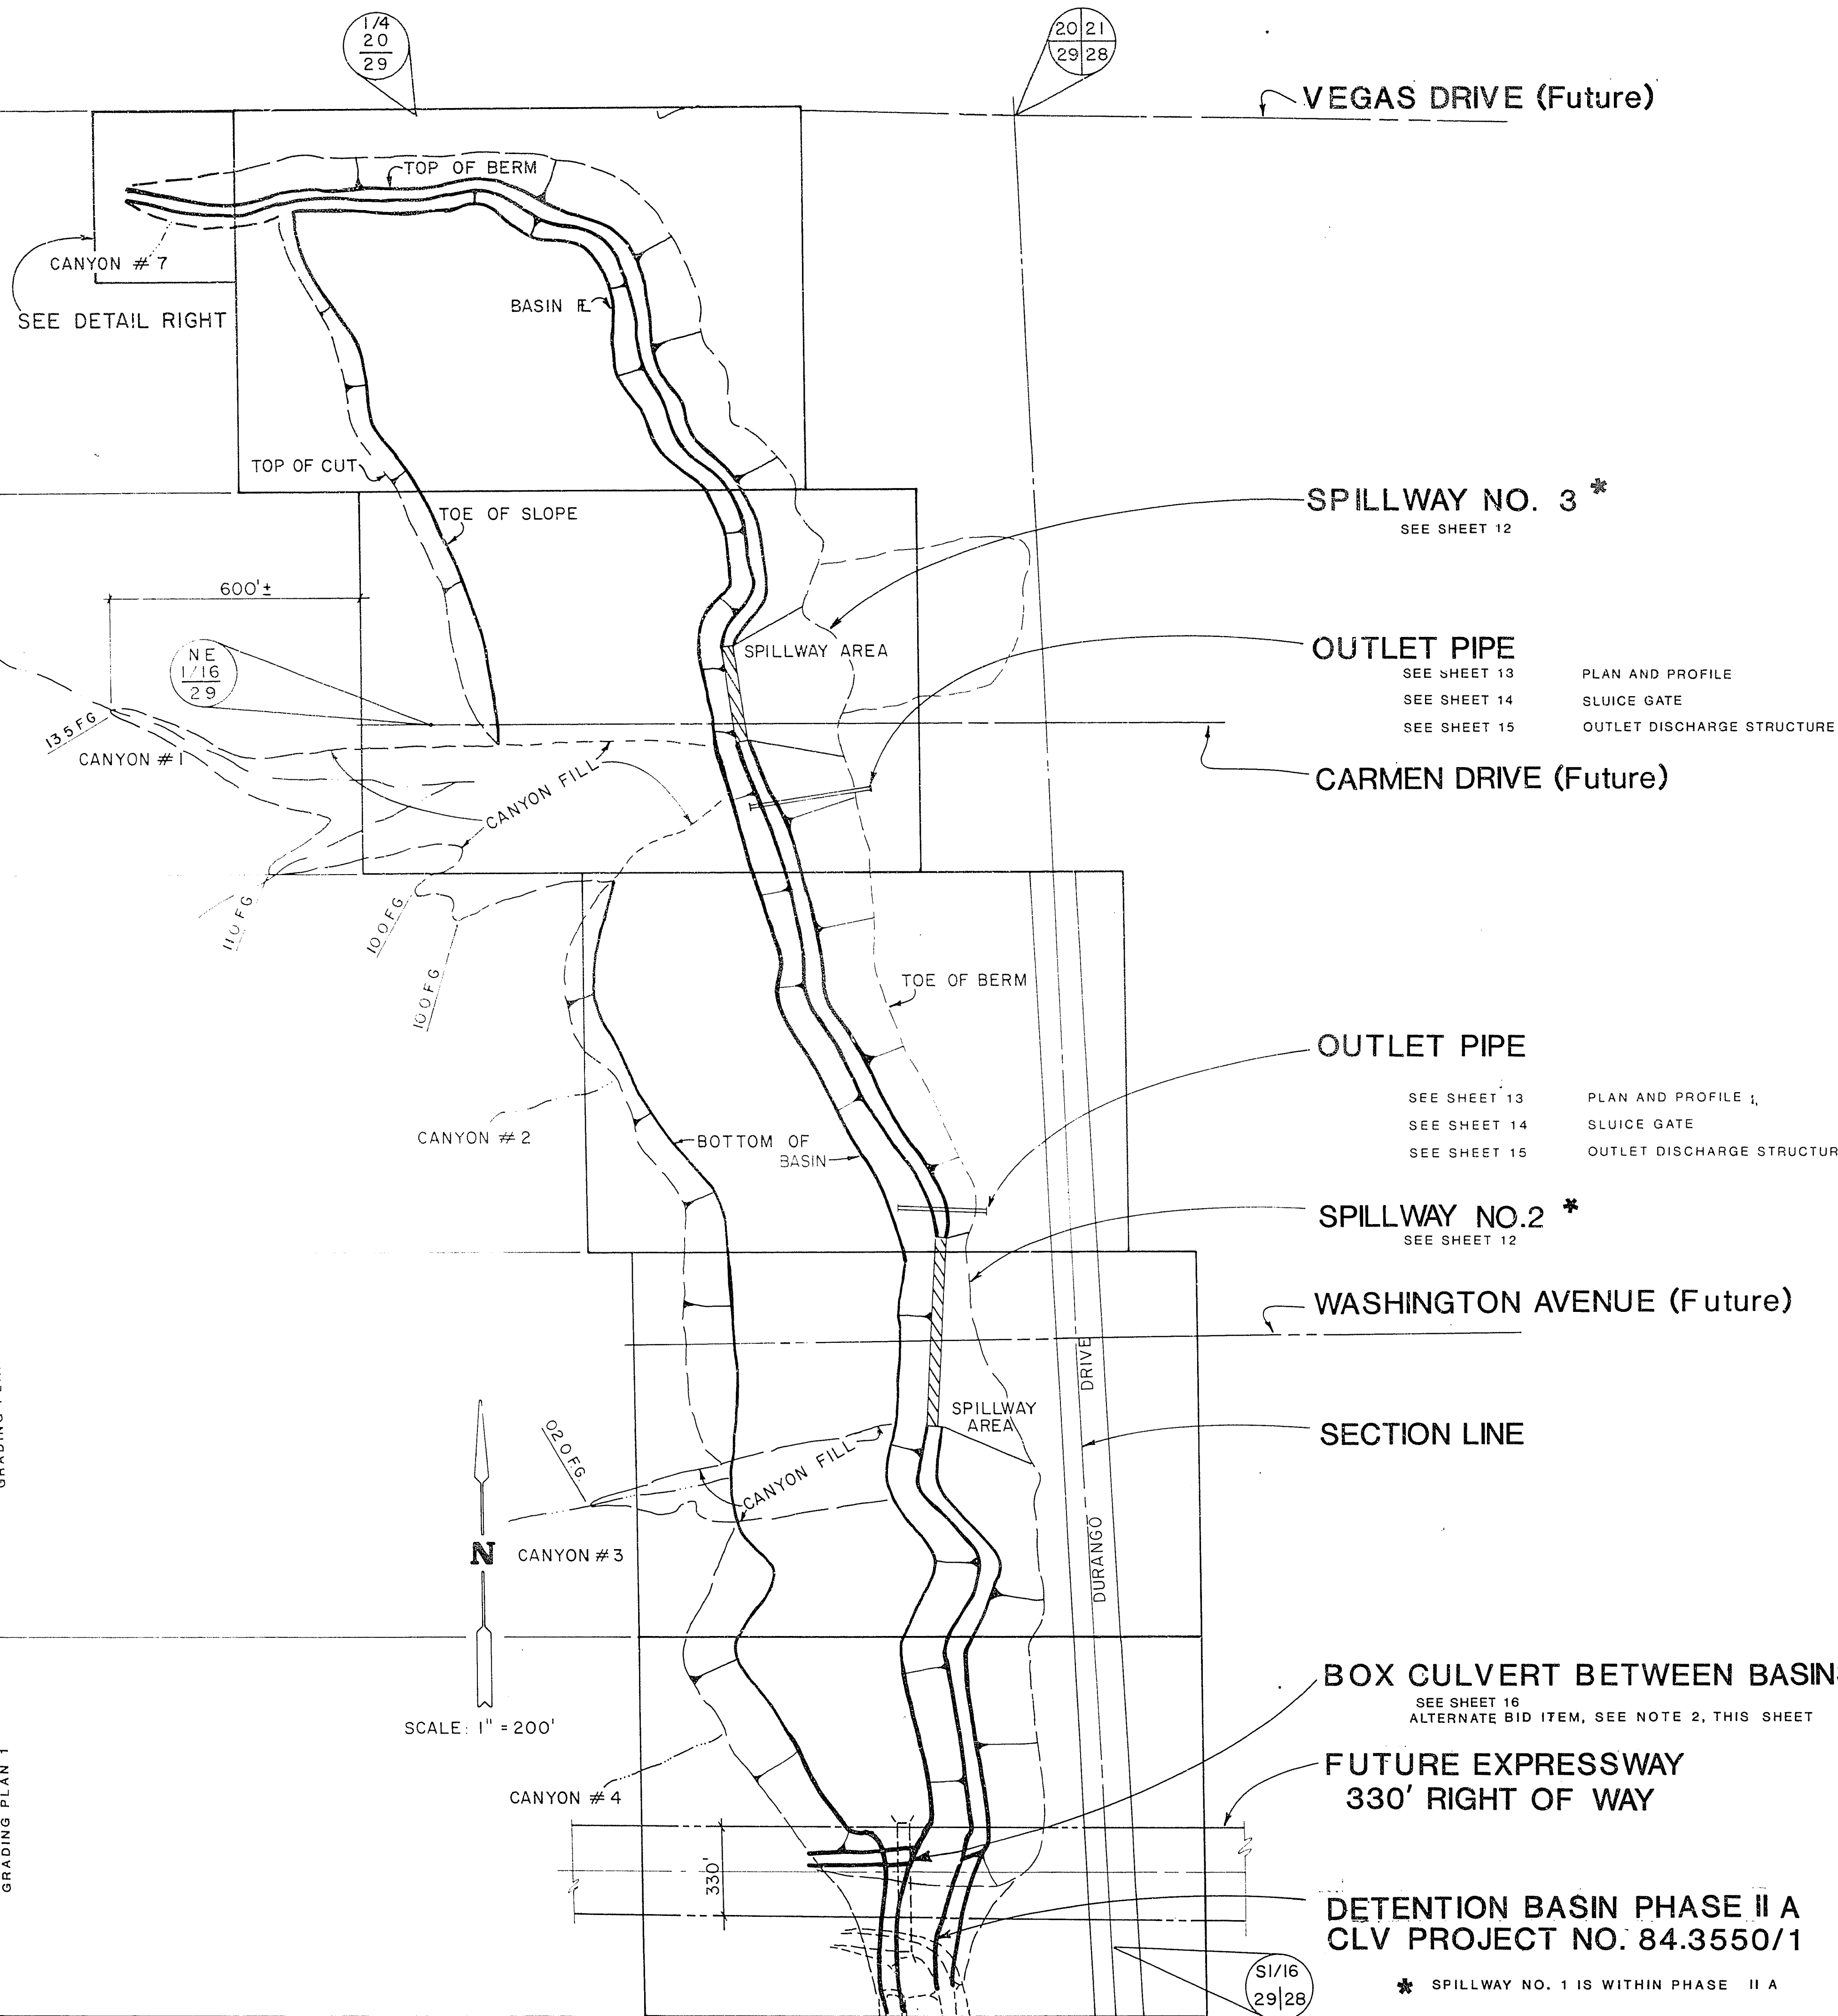

GRADING PLAN NOTES

1. THE BOX CULVERT SHOWN IN PLAN ON SHEET 5 AND IN DETAIL ON SHEET 16 IS AN ALTERNATE BID ITEM. THE ALTERNATE BID PRICE INCLUDES THE ADDITION OF THE BOX CULVERT AND REDUCTION OF 23,000 CUBIC YARDS OF EXCAVATION.
2. PAYMENT FOR EXCAVATION SHALL BE BASED UPON THE VOLUME OF EXCAVATION, AS DETERMINED BY THE ENGINEER, FROM FINISHED GRADES SHOWN ON THE DRAWINGS.
3. STAKING FOR EXCAVATION SHALL BE PROVIDED BY THE OWNER, AS REQUESTED BY THE CONTRACTOR. THE QUANTITY OF STAKING IS PROVIDED IN THE SPECIFICATIONS.
4. THE CONTRACTOR SHALL NOTIFY THE SOUTHWEST GAS CORPORATION WHEN WORKING WITHIN 100 FEET OF THE GAS LINE NEAR DURANGO DRIVE.
5. PRIOR TO PLACING EMBANKMENT MATERIAL, EXISTING SURFACE SHALL BE OVER EXCAVATED IN ACCORDANCE WITH DETAILS ON SHEET 13.

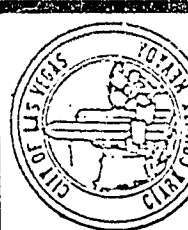

GRADING PLAN SHEET INDEX

ANGEL PARK DETENTION BASIN
PHASE II B

TITLE

WO NO. 3061/B

BY VJS/RLG

DATE 2/6/85

SCALE: 1" = 200'

SHEET

4

OF 16 SHEETS

AS BUILT

650.14-V9

REV	DATE	BY	REVISION
1	7-29-85	MRW	CANYON #7 GRADING

PLANNERS
ENGINEERS • SUITE 100
2300 PASEO DEL PRADO BUILDING A
LAS VEGAS, NEVADA 89102 PHONE (702) 873-7550

CITY OF LAS VEGAS,
NEVADA

City of Las Vegas, Nevada