


9-13-75

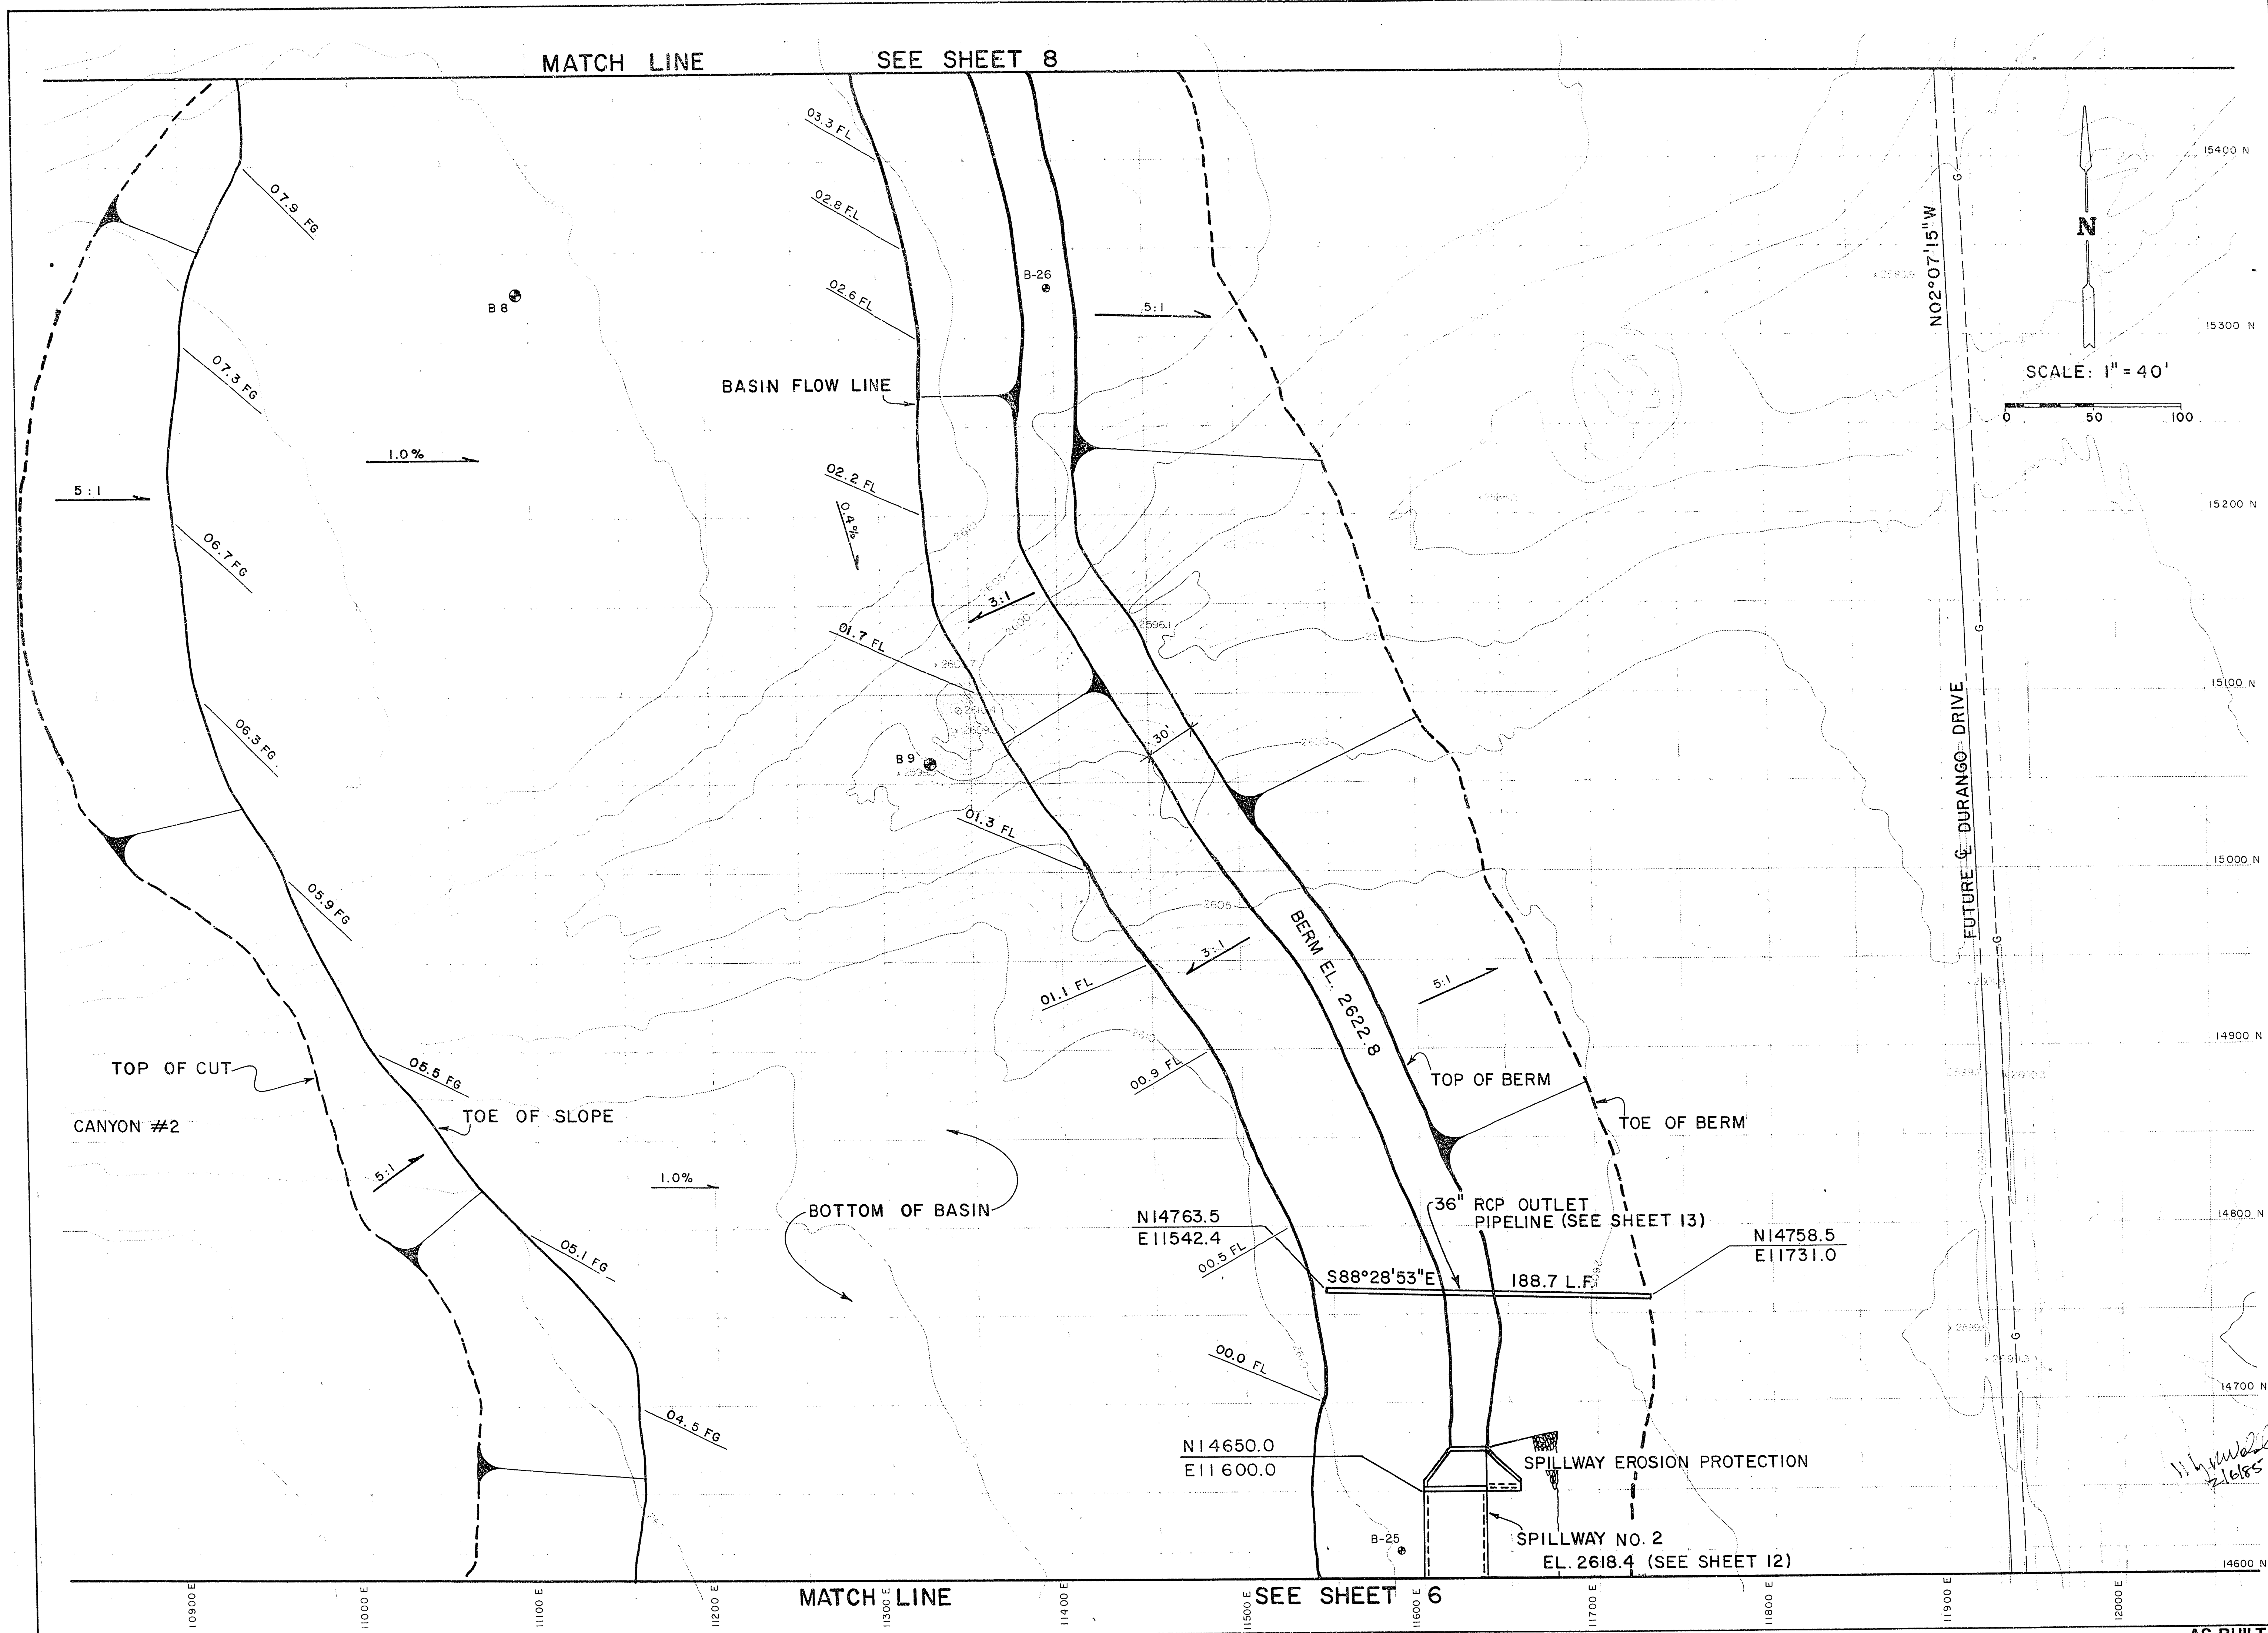

CITY OF LAS VEGAS, NEVADA		CONSULTING ENGINEERS • PLANNERS	
2300 PASEO DEL PRADO BUILDING A SUITE 100		LAS VEGAS, NEVADA 89102 PHONE (702) 873-7550	
vtn nevada			

GRADING PLAN 3	
ANGEL PARK DETENTION BASIN PHASE II B	

TITLE	
PROJECT	

WO NO. 3061/B	
BY	VJS/RLG
DATE	2/6/85
SCALE	1" = 40'

SHEET	
7	
OF 16 SHEETS	

AS BUILT 650.14-V9