


9-13-75

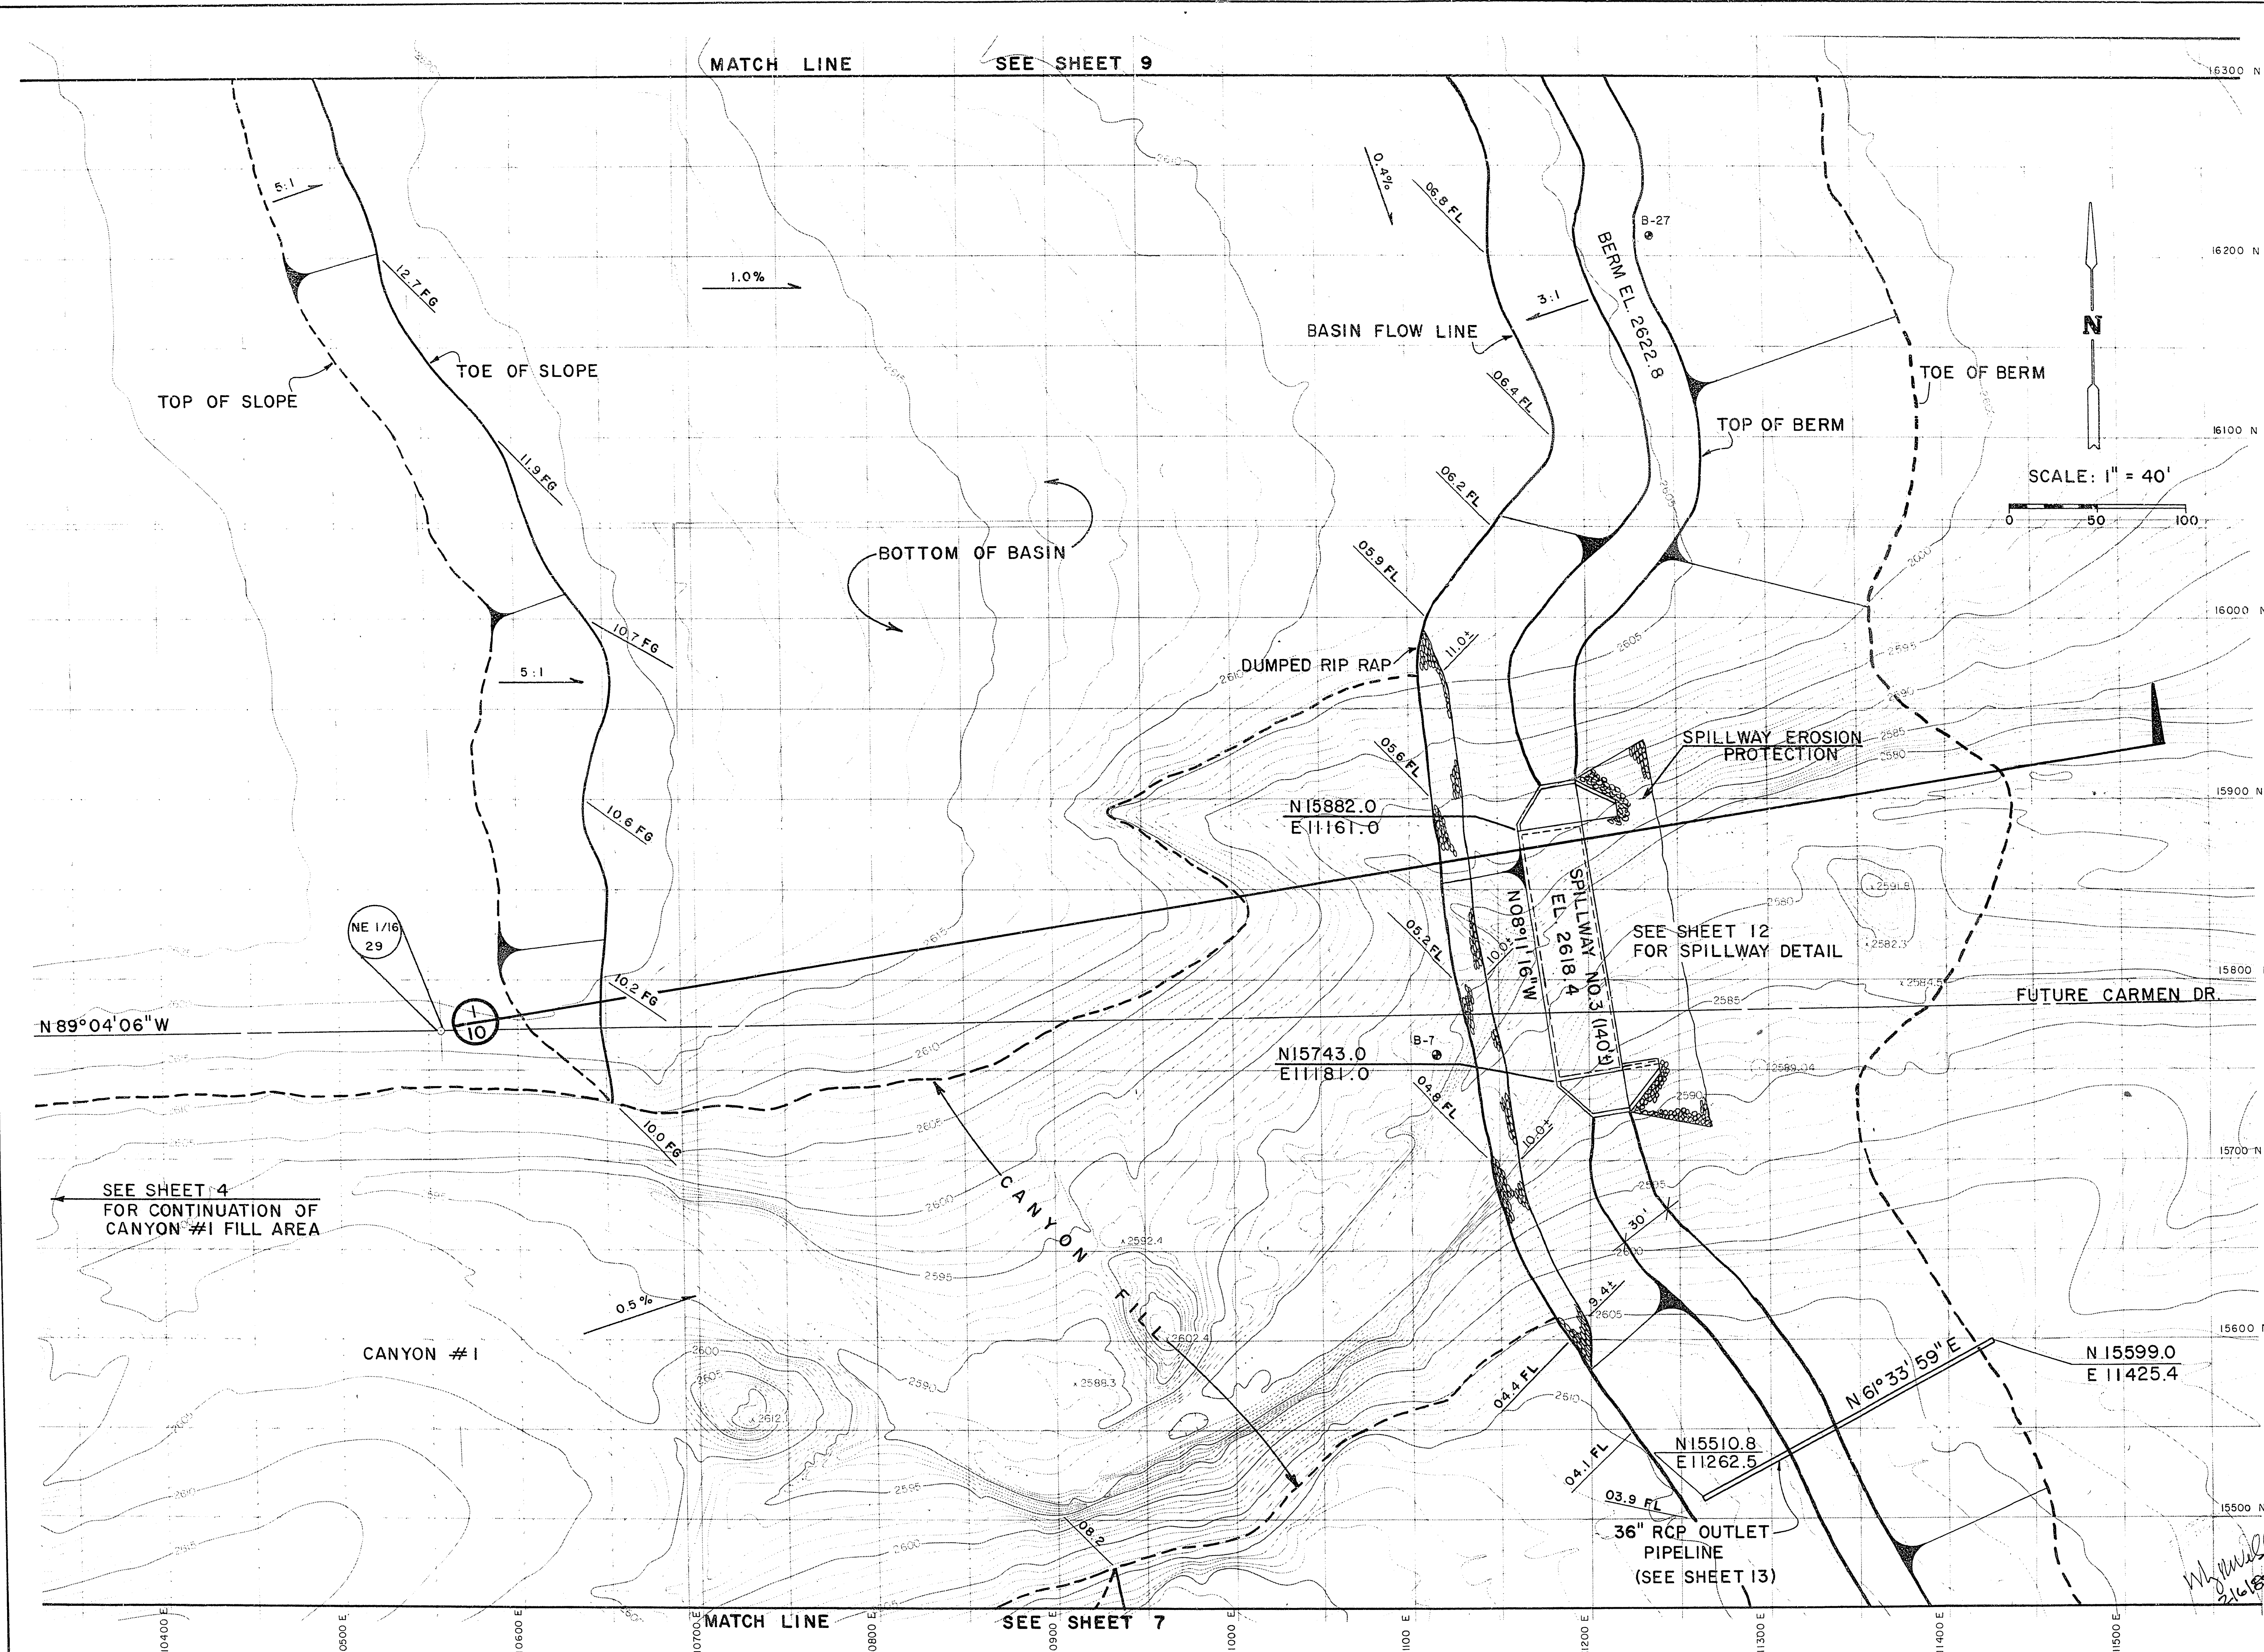

CITY OF LAS VEGAS, NEVADA		CONSULTING ENGINEERS • PLANNERS 2300 PASEO DEL PRADO BUILDING A SUITE 100 LAS VEGAS, NEVADA 89102 PHONE (702) 873-7550	
GRADING PLAN 4		ANGEL PARK DETENTION BASIN PHASE II B	
TITLE		PROJECT	
WO NO. 3061/B		BY VJS/RLG	
DATE 2/6/85		SCALE 1" = 40'	
SHEET 8		OF 16 SHEETS	

AS BUILT 650.14-V9