


9-13-77

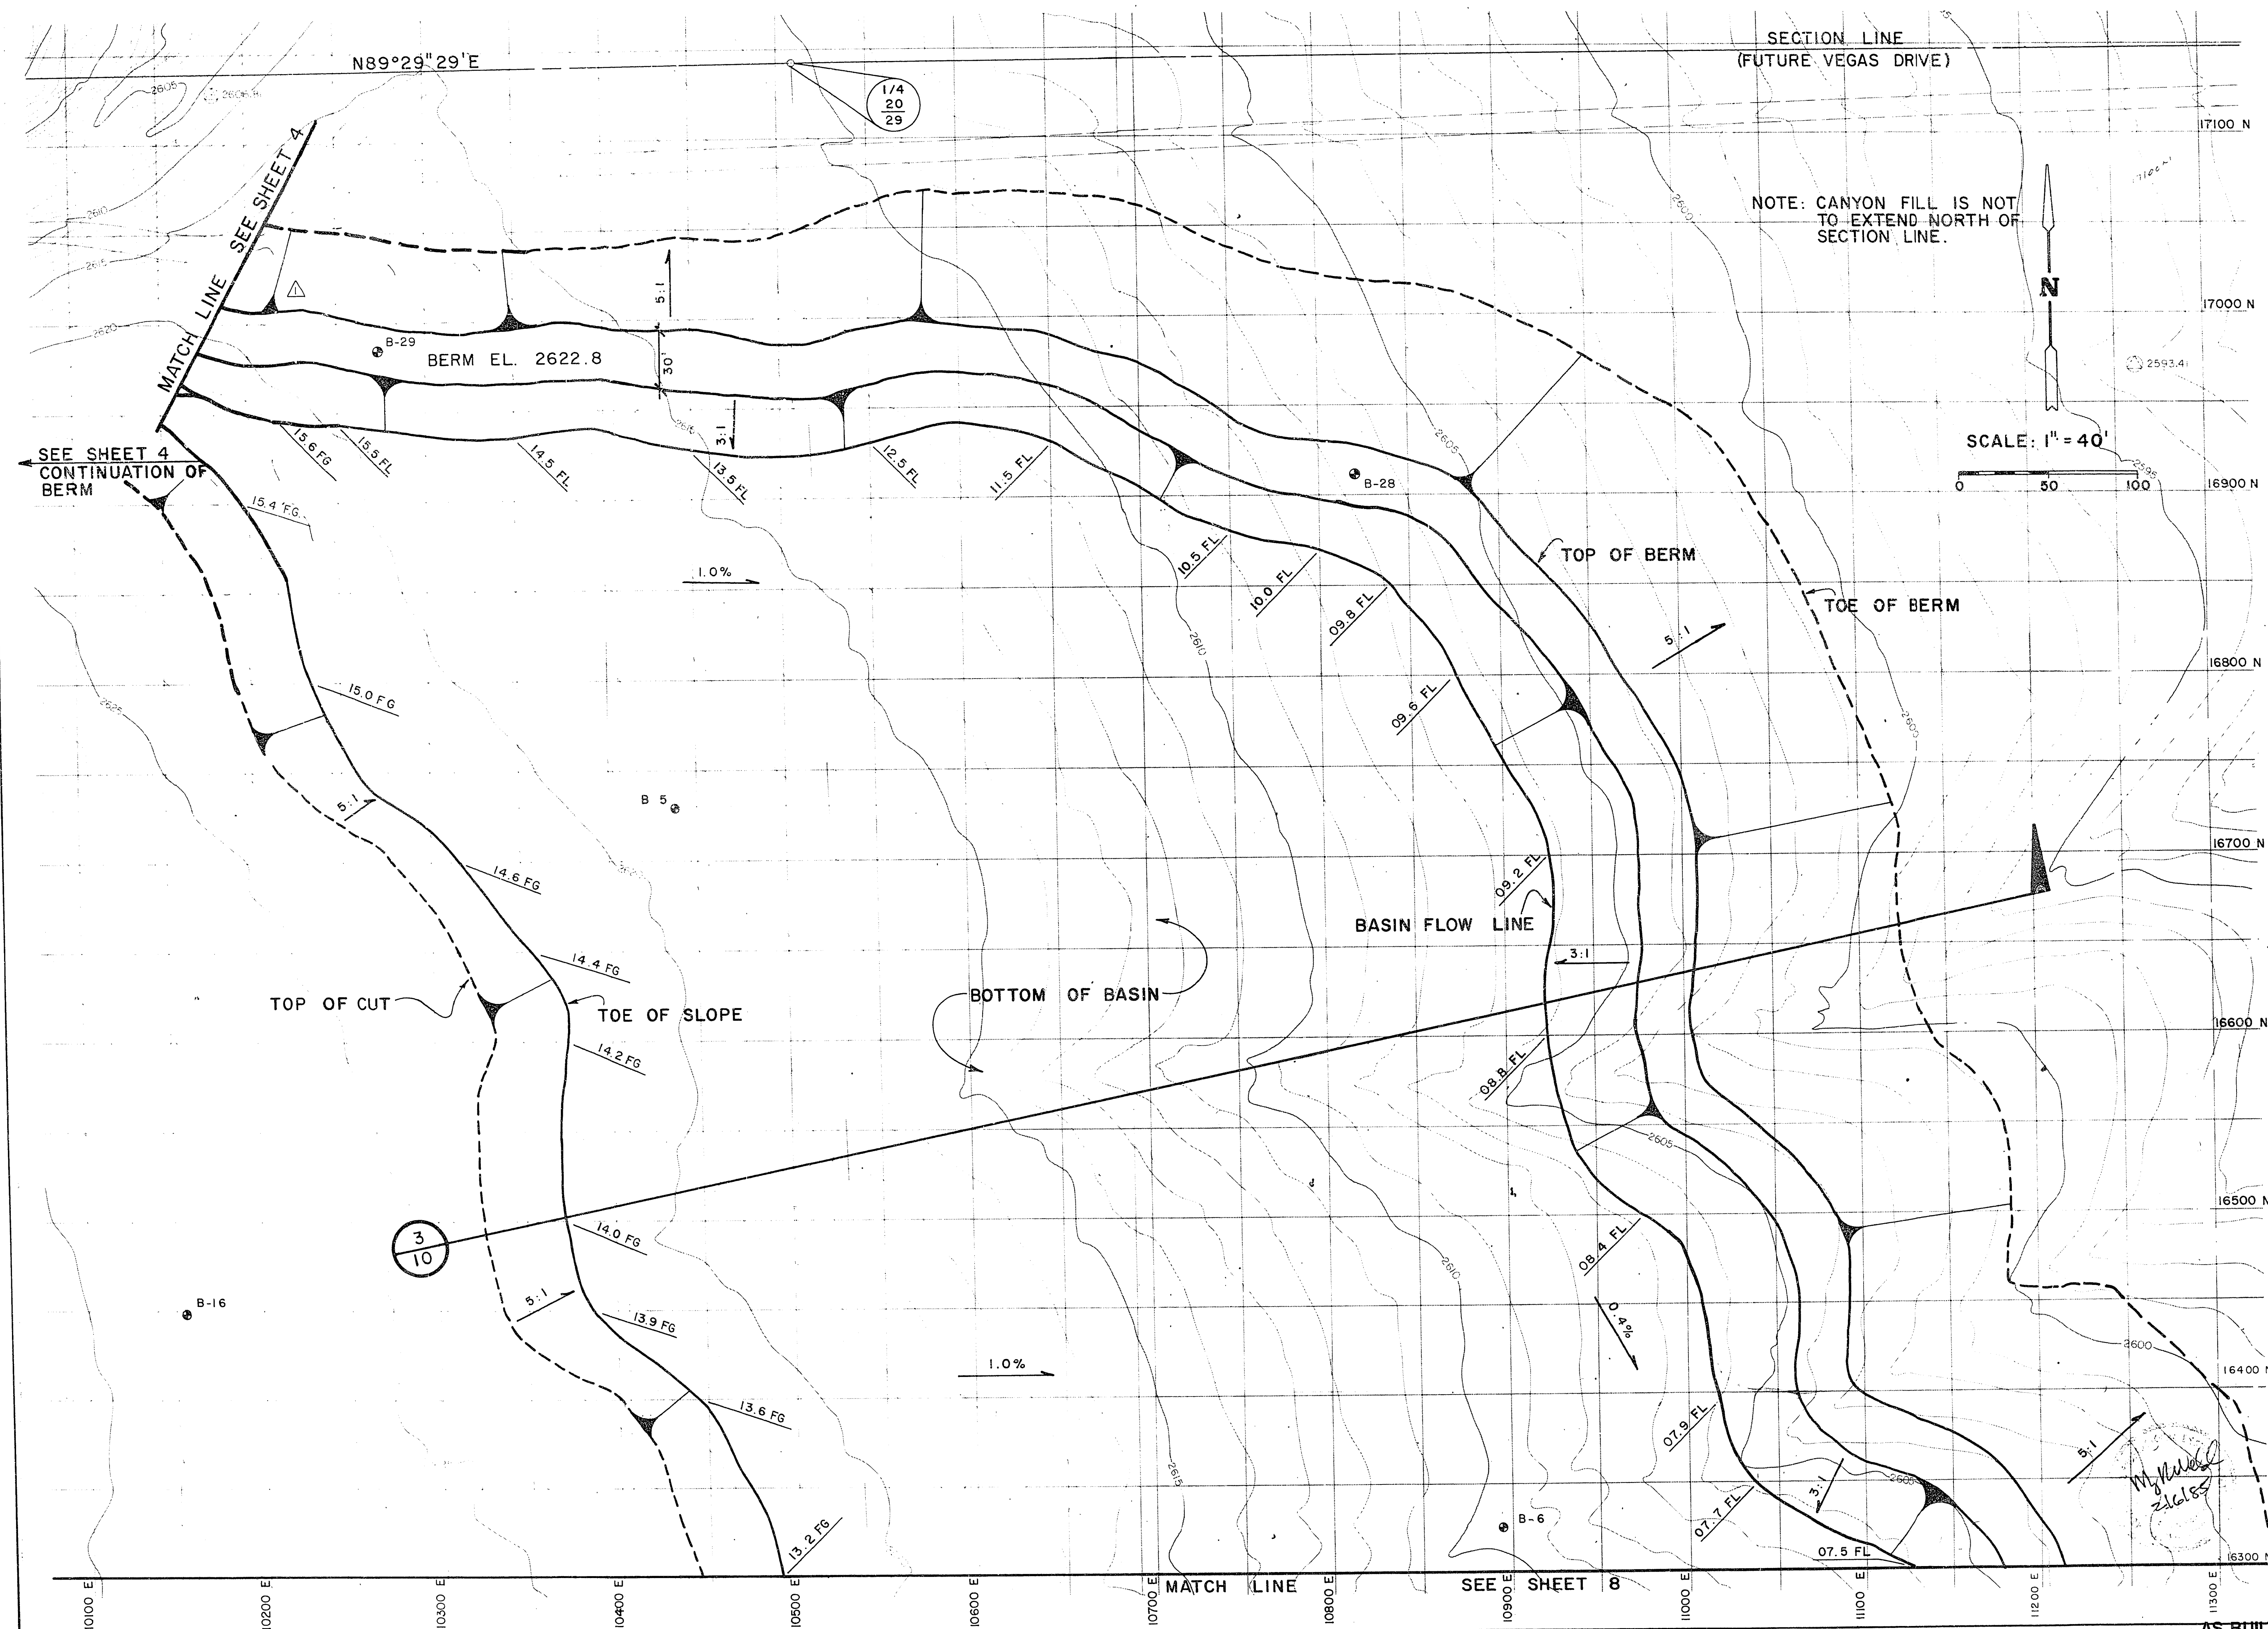

REV	DATE	BY	GRADING	REVISION
1	7-23-85	MRW		

CITY OF LAS VEGAS, NEVADA

GRADING PLAN 5

ANGEL PARK DETENTION BASIN PHASE II B

PLANNERS
CONSULTING ENGINEERS
2300 PASEO DEL PRADO BUILDING A SUITE 100
LAS VEGAS, NEVADA 89102 PHONE (702) 873-7550

WO NO. 3061/B
BY VJS/RLG
DATE 2/6/85
SCALE 1" = 40'

SHEET 9
OF 16 SHEETS

AS BUILT