
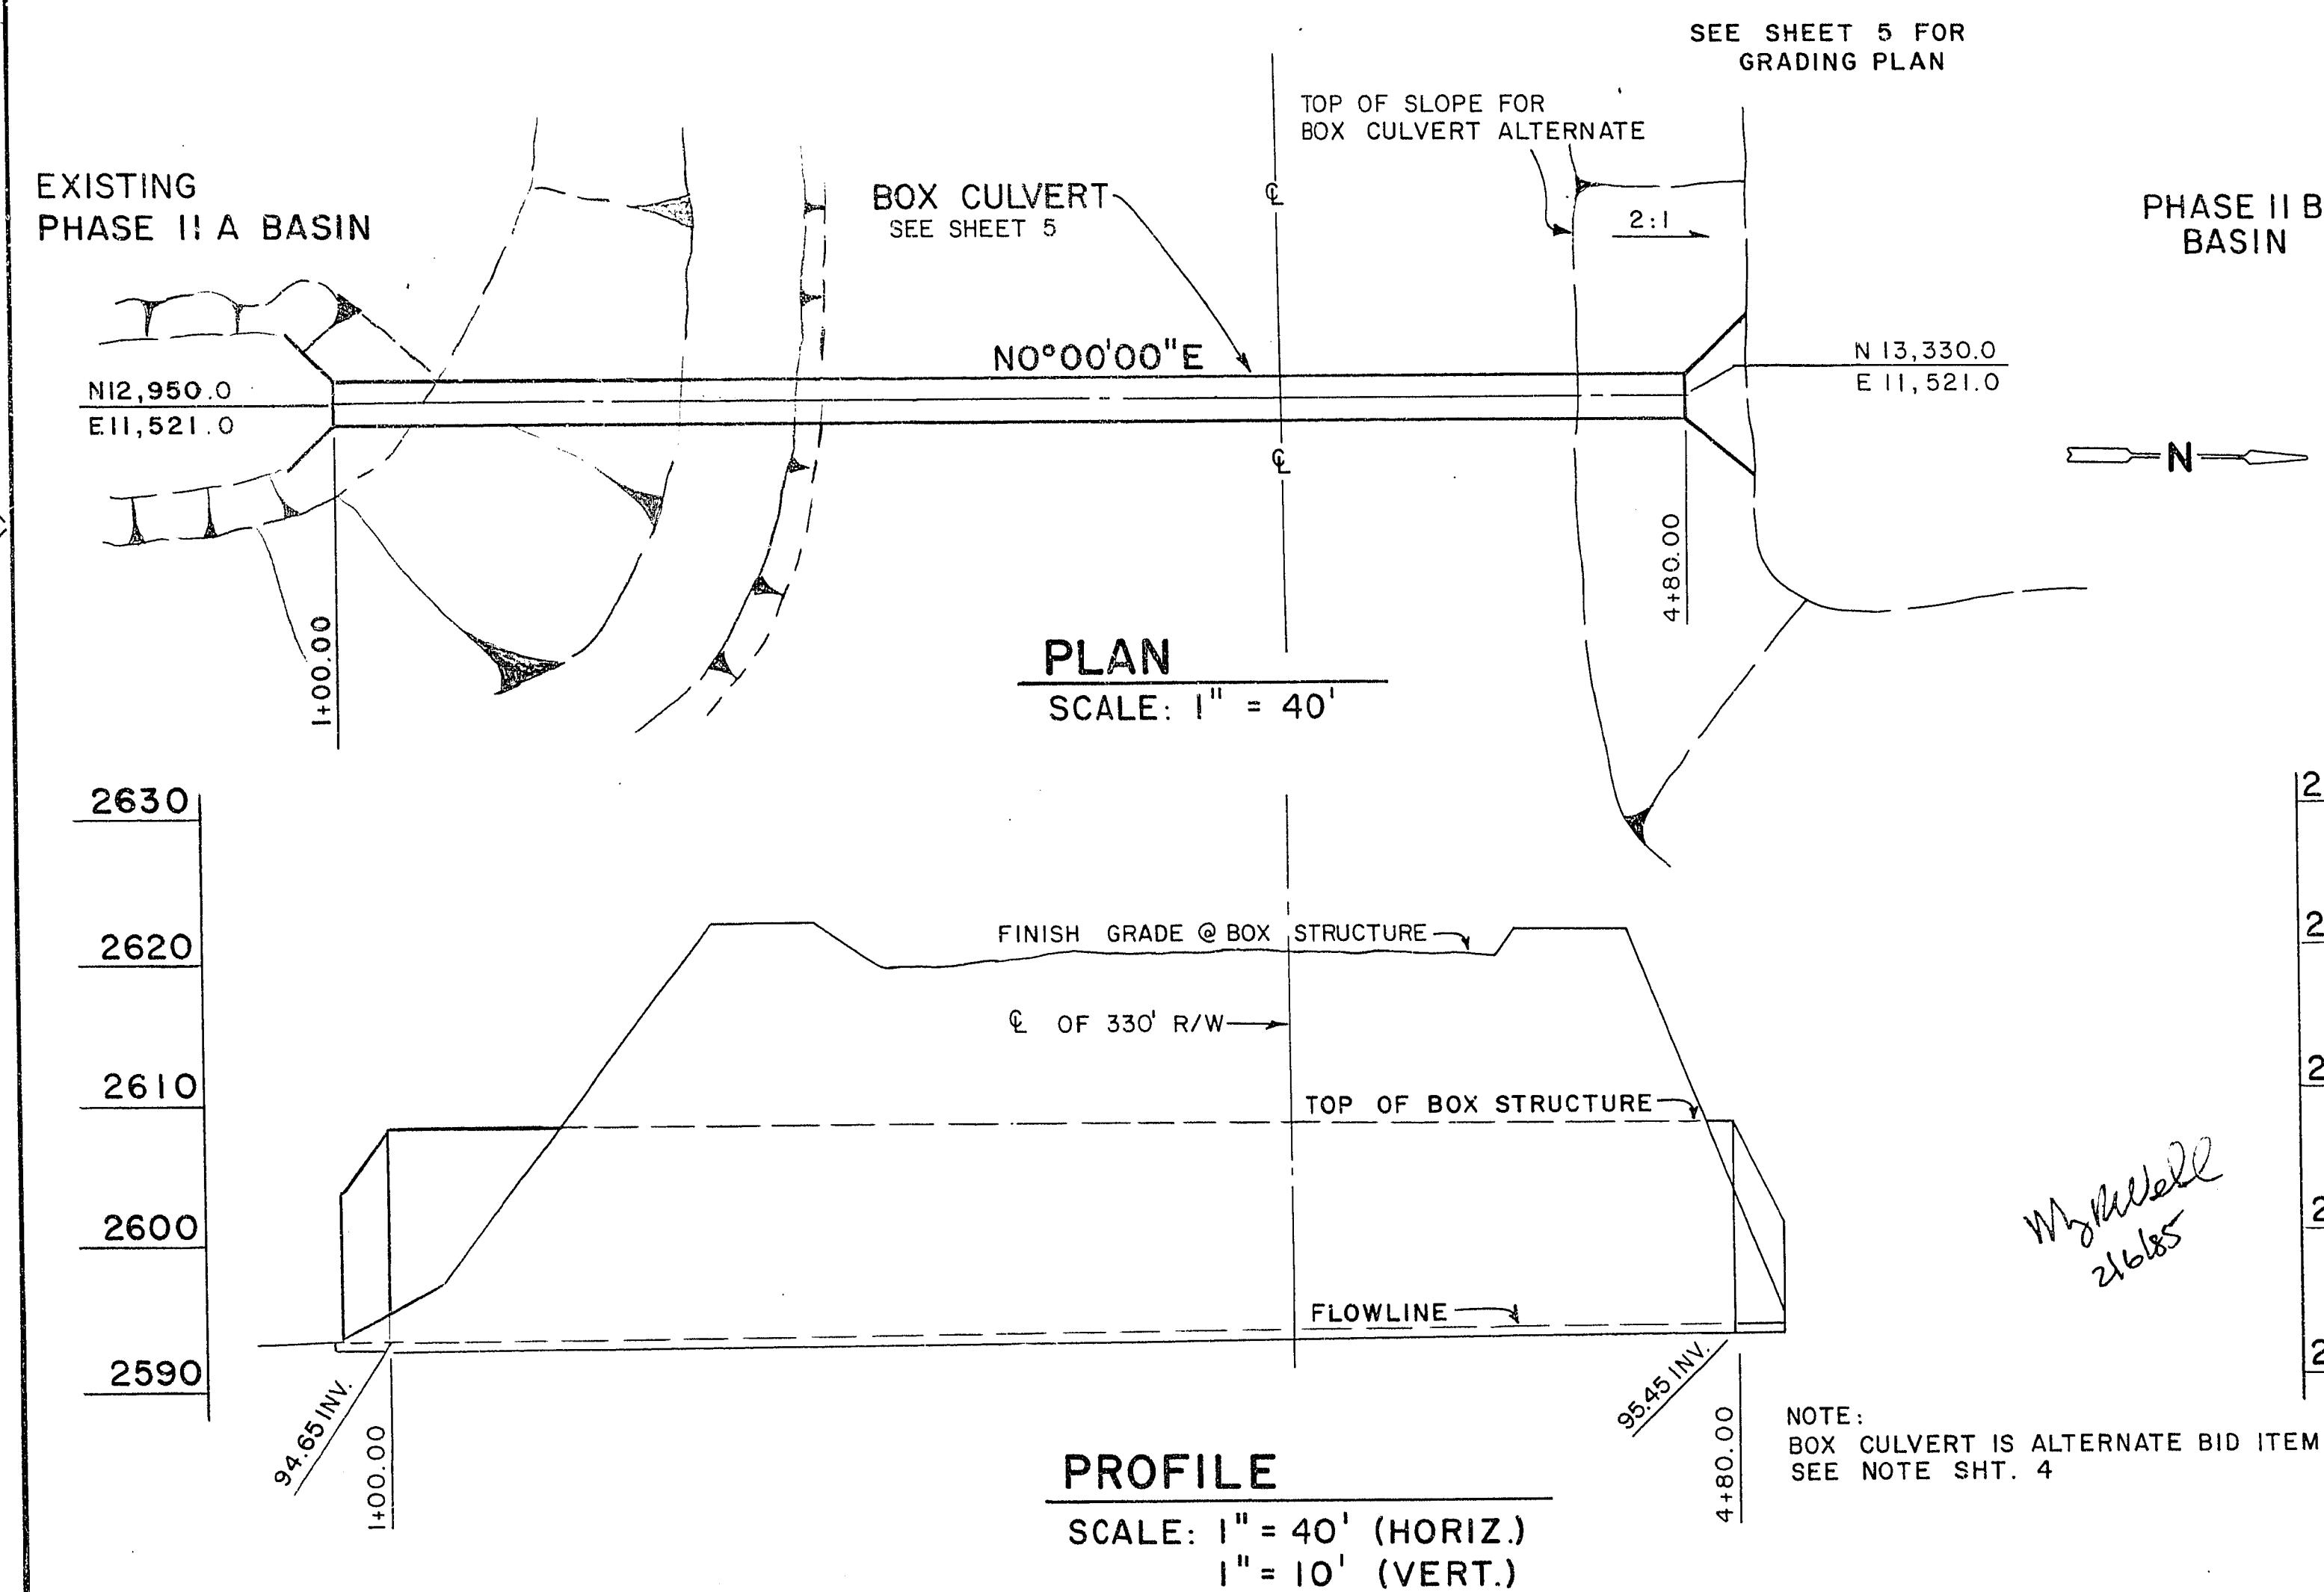
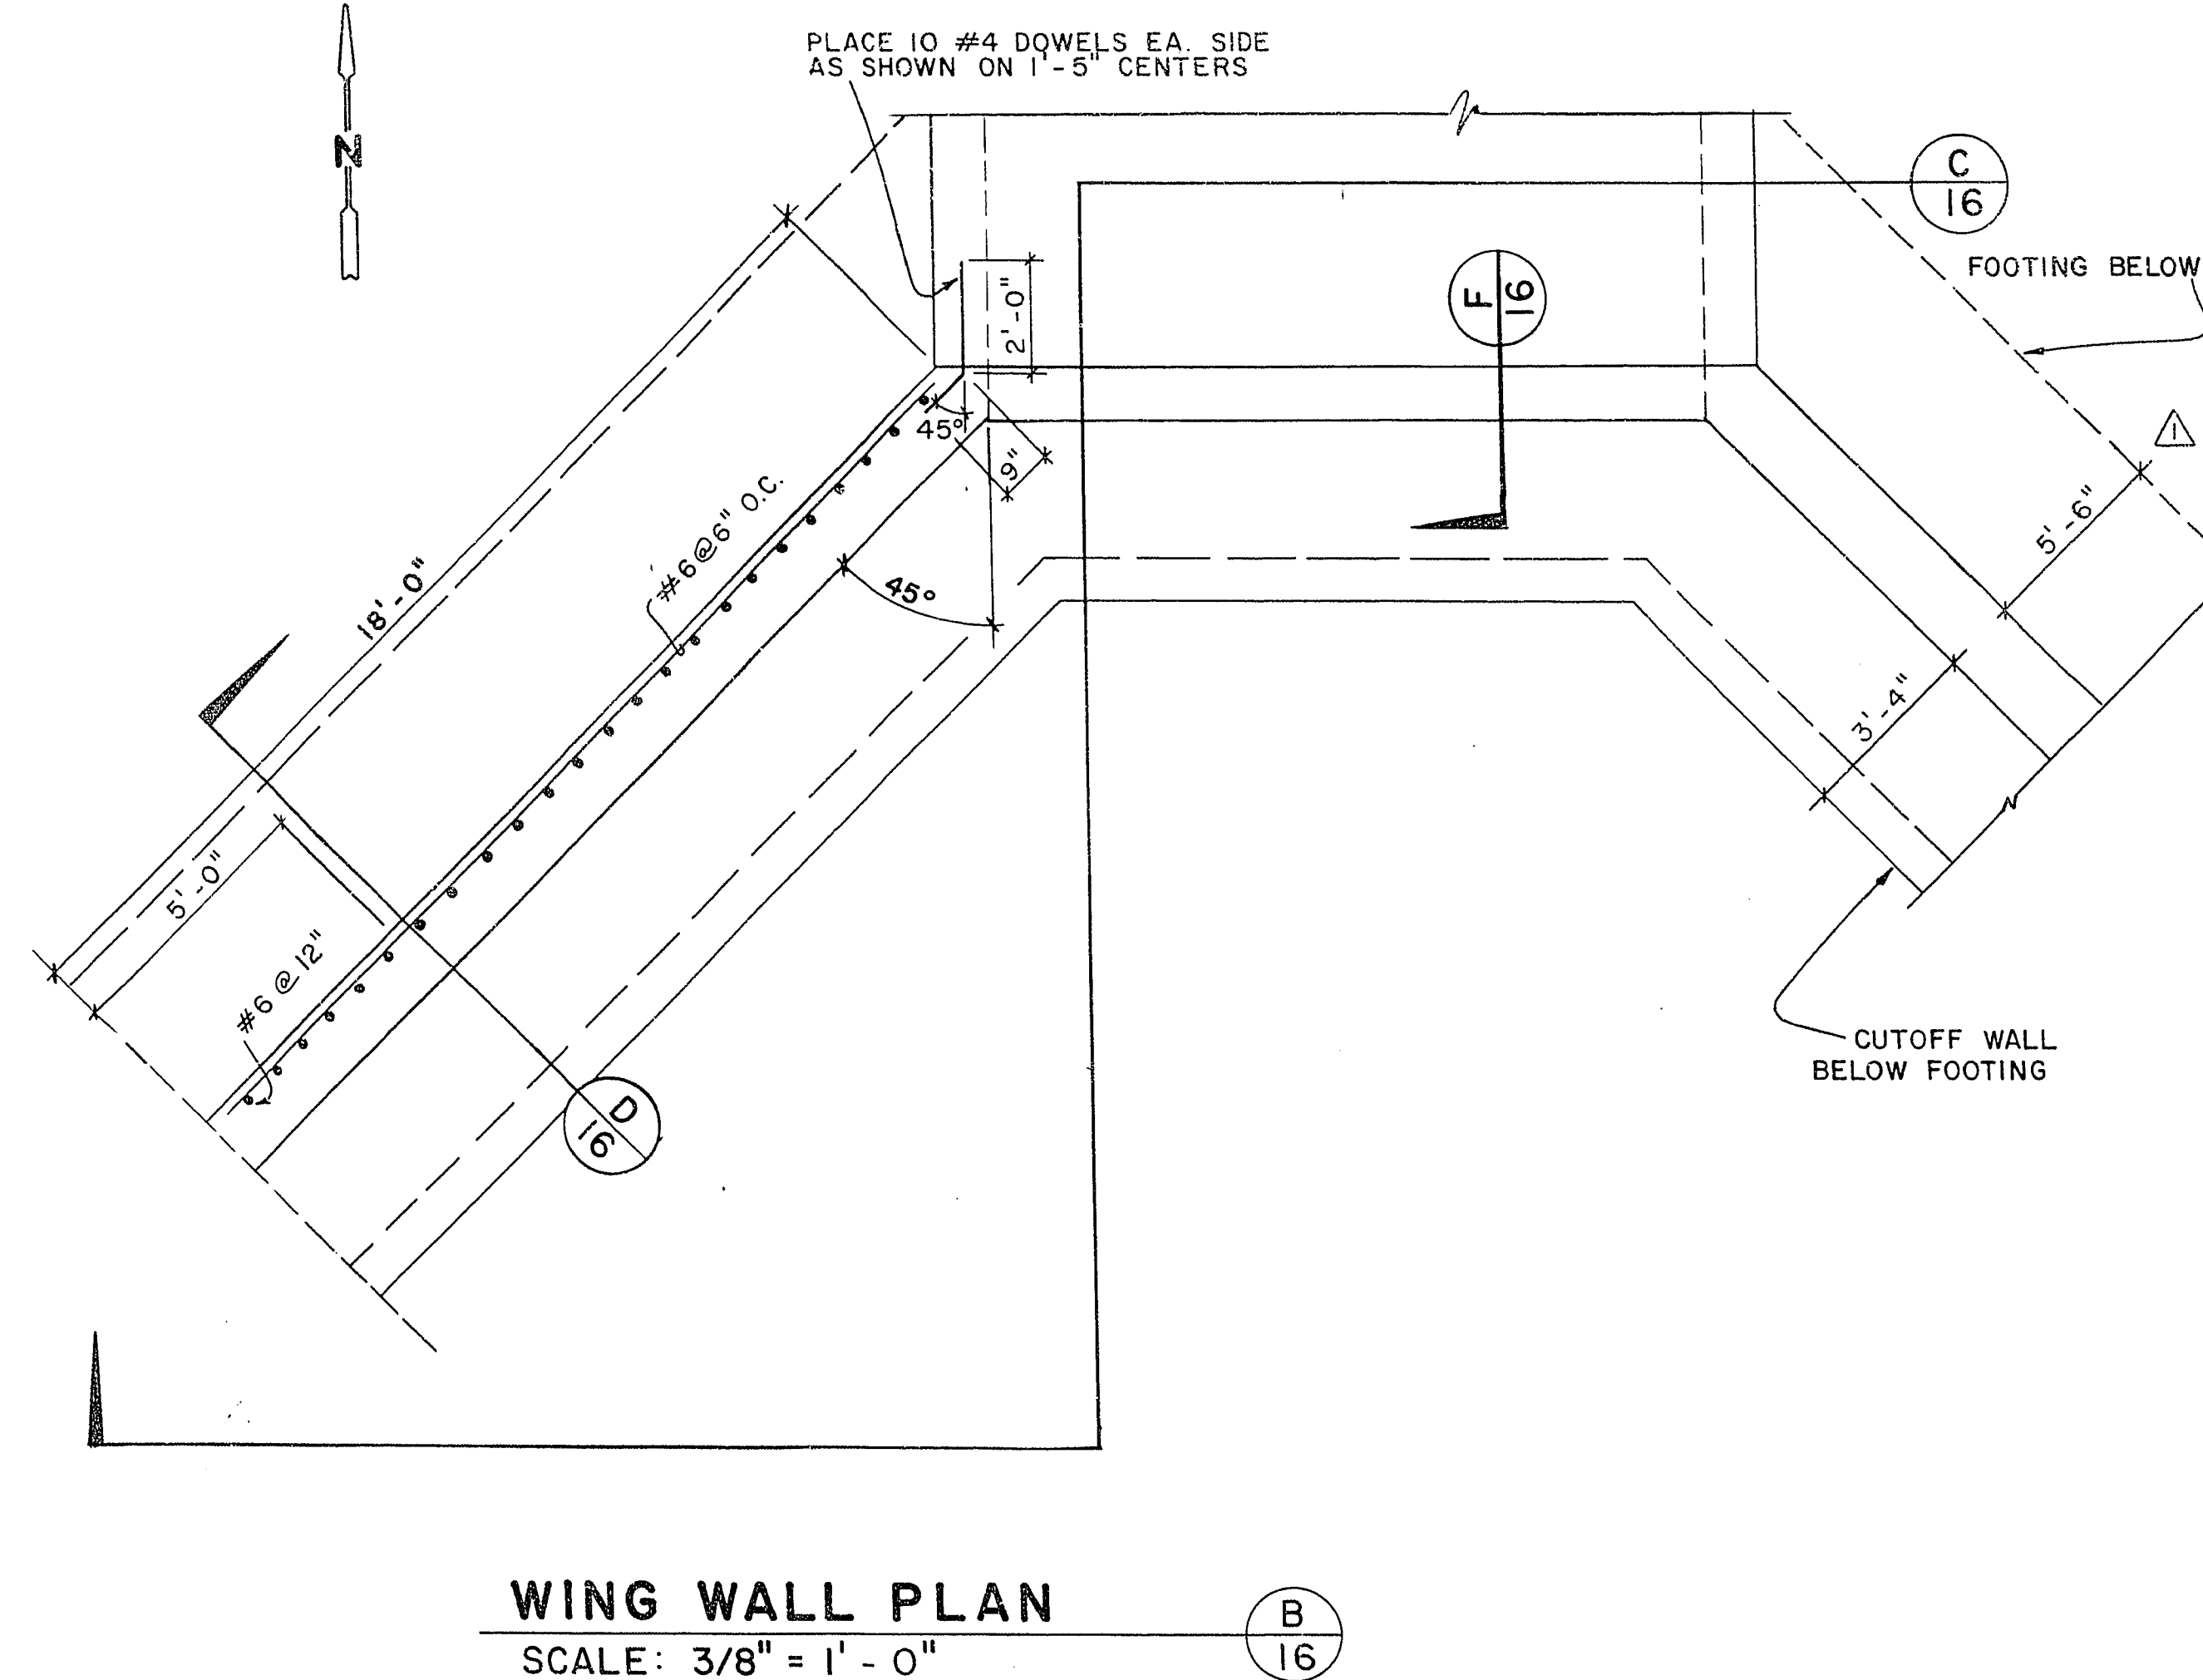
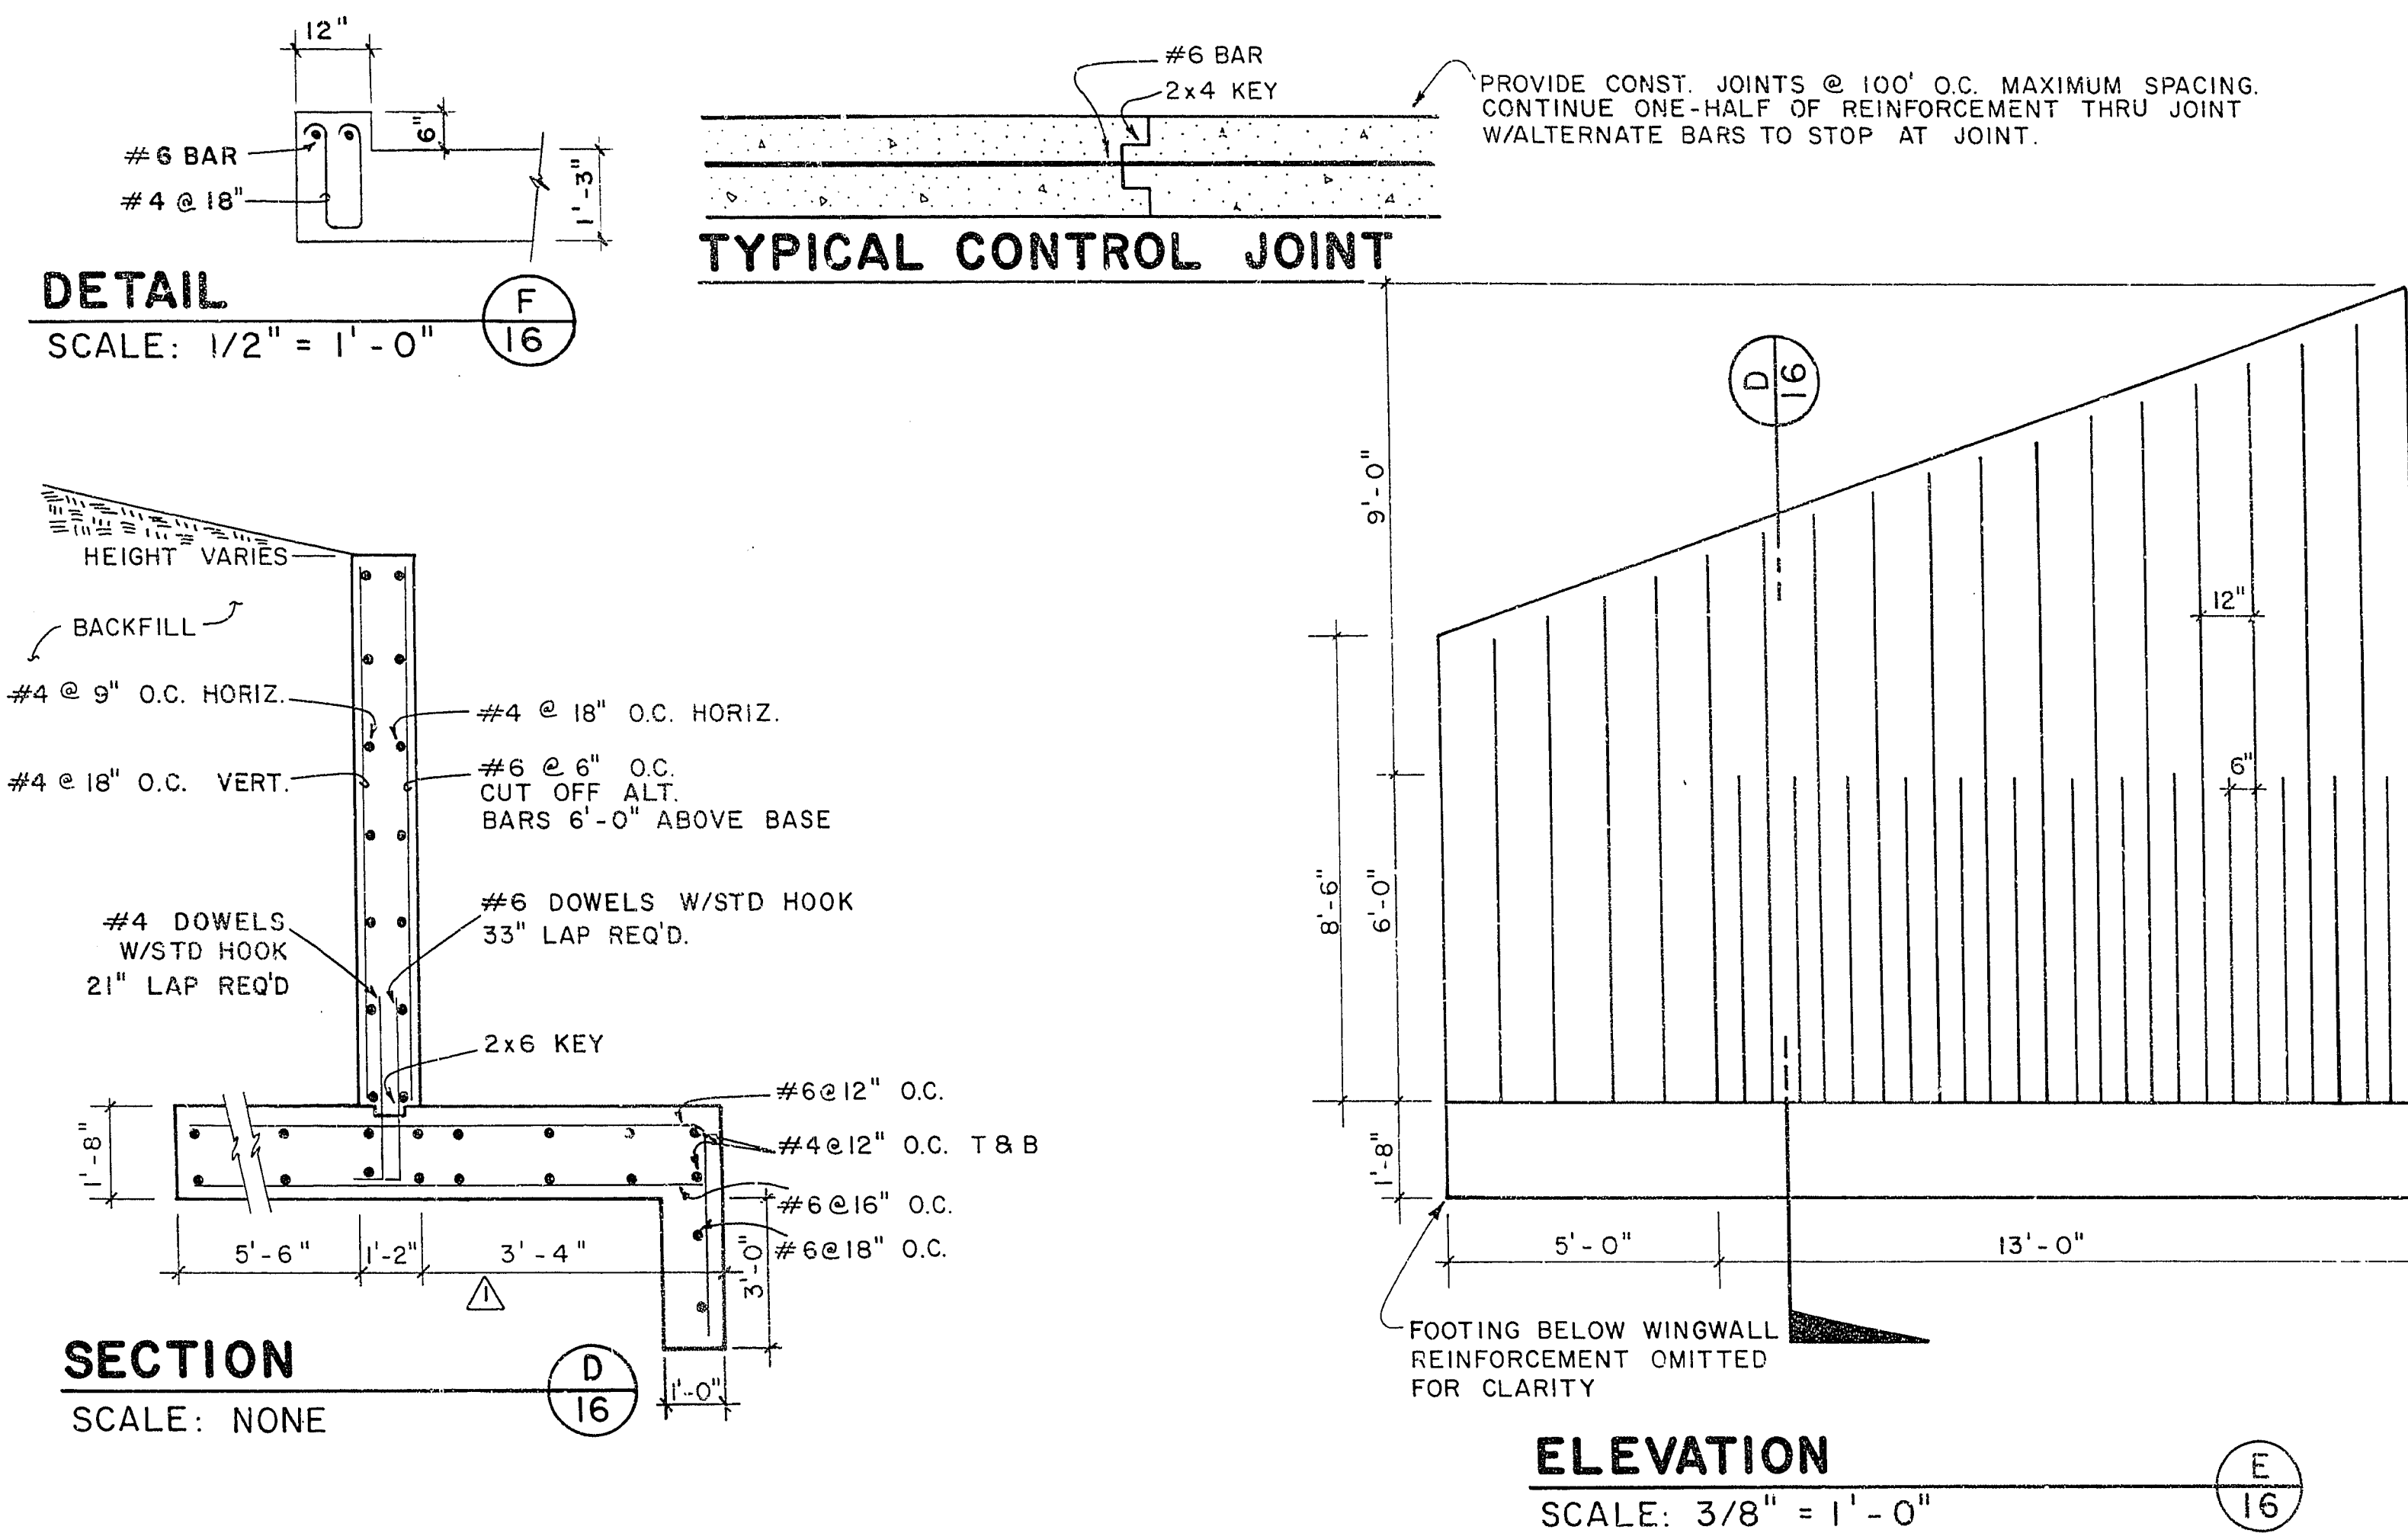


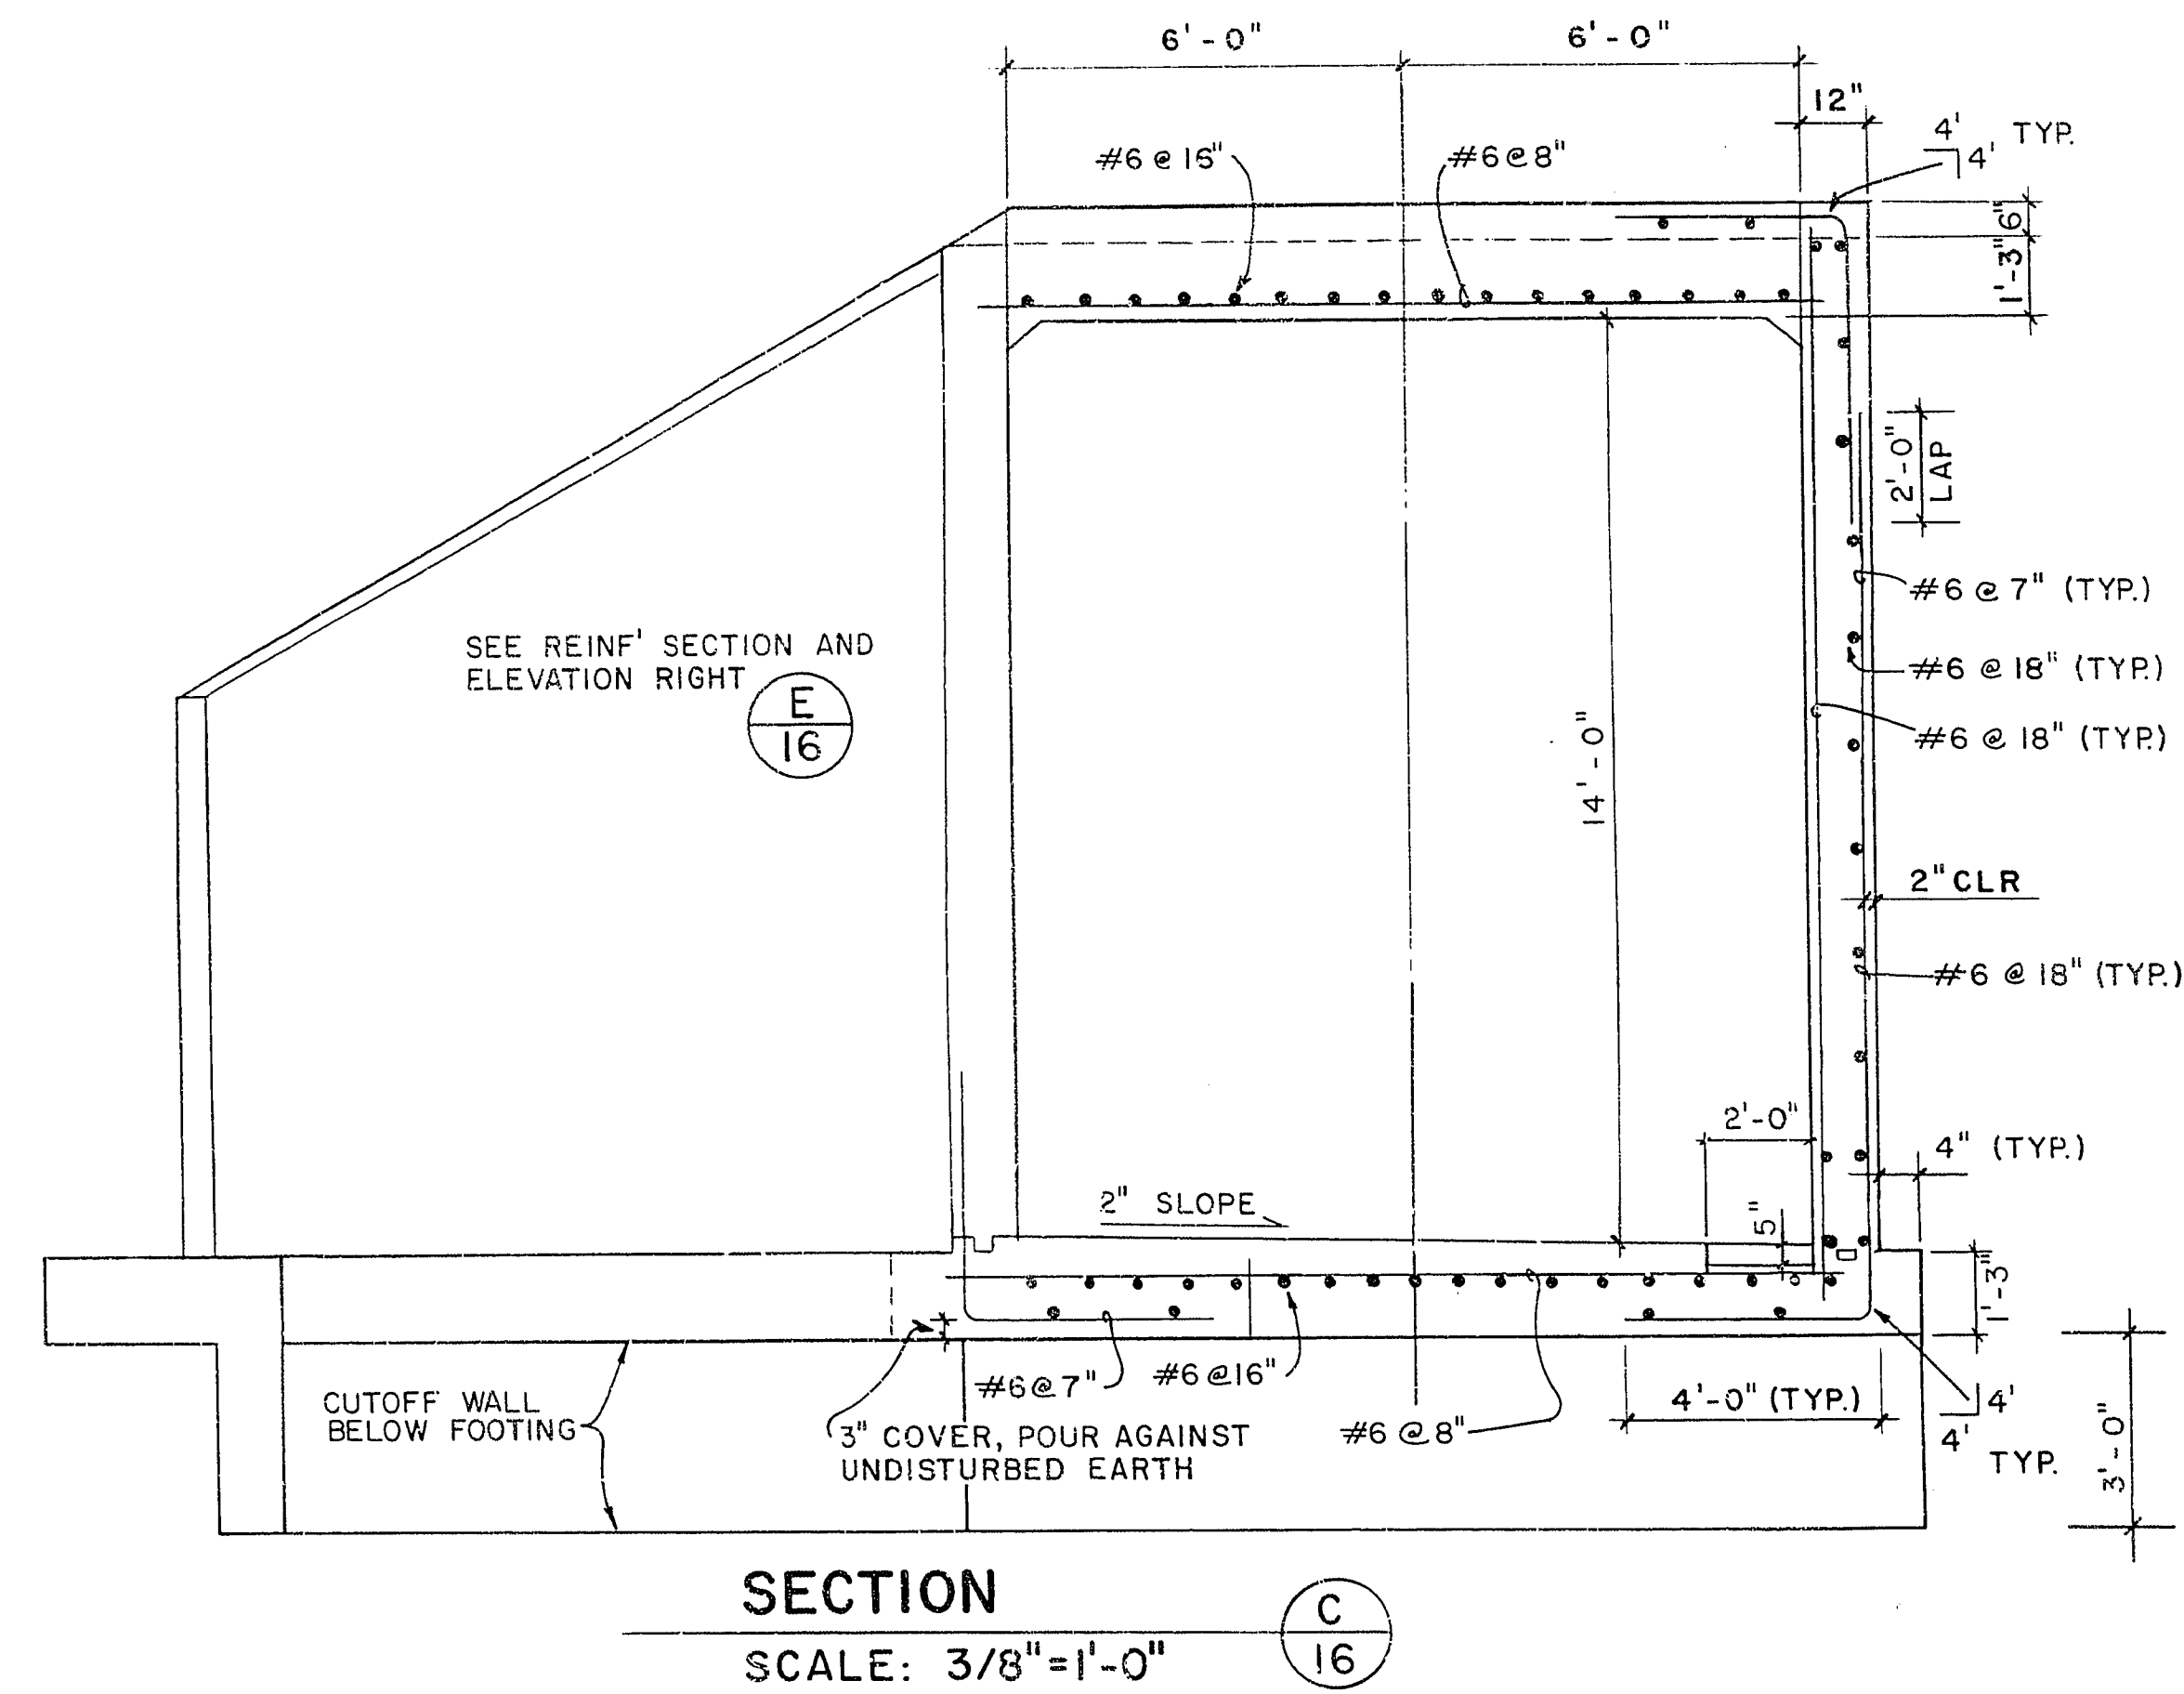

CITY OF LAS VEGAS,
NEVADA

CONSULTING ENGINEERS • PLANNERS
2300 PASEO DEL PRADO BUILDING A SUITE 100
LAS VEGAS, NEVADA 89102 PHONE (702) 873-7550

nevada

TITLE	 BOX CULVERT BETWEEN BASINS
PROJECT	ANGEL PARK DETENTION BASIN PHASE II B

WO NO.	3061/B
BY	MRW/RLG
DATE	2/6/85
SCALE	AS SHOWN

SHEET

16

OF 16 SHEETS

AS BUILT 650.14-V9