

bid no.
84.3550-1



FUNDED BY
1981 CLARK COUNTY
BOND ISSUE

City of Las Vegas Clark County, Nv.

mayor:
Bill Briare

county commissioners

Thalia Dondero, Chairman
Jack Petitti, Vice-Chairman
Manuel Cortez
Karen Hayes
R.J. Ronzone
Woodrow Wilson
Bruce Woodbury

county manager

Bruce W. Spaulding

acting
city manager
Don Saylor


director of engineering services
Charles E. Gilpin

ANGEL PARK DETENTION BASIN PHASE IIA

councilmen
Ron Lurie
Paul J. Christensen
Al Levy
Bob Nolen



location map

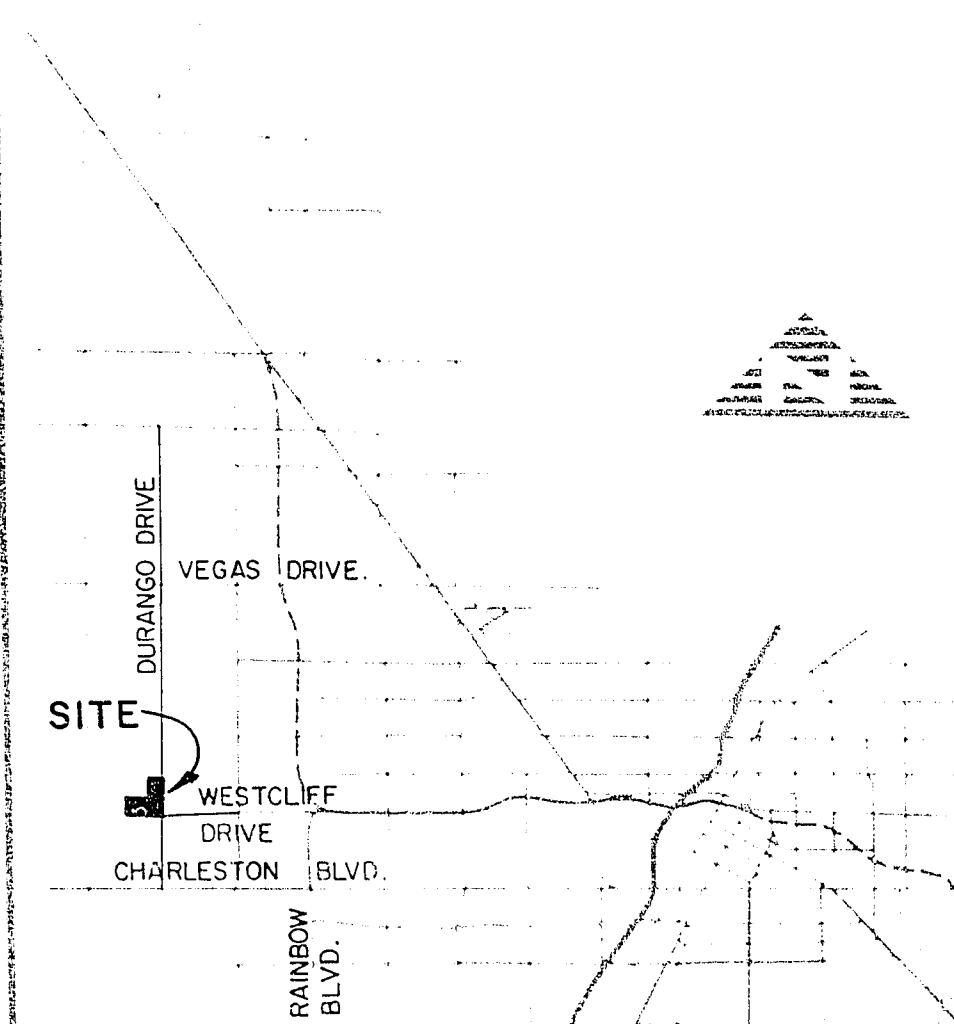

agency	approved date
Director of Comm. Plan. & Dev.	N/A
Director of Rec. & Leisure Activities	N/A
Director of Fire Services	N/A
Director of Arch. Serv. & Proj. Control	N/A
contractor	
Bid Group I (Angel Park Detention Basin)	
J.R. Jacks	
5023 East Monroe, Las Vegas, Nev.	
Bid Group II (Angel Park Outlet Drain)	
Burdick Contractors	
3333 Procyon Ave., Las Vegas, Nev.	

index of sheets

no.	description
1	COVER SHEET
2	VICINITY MAP, WATERSHED BOUNDARY MAP & LOCATION MAP
3	ABBREVIATIONS & SYMBOLS
4	LOCATION PLAN & AXIAL PROFILE OF EMBANKMENT
5	AXIAL PROFILE OF EMBANKMENT
6	GRADING PLAN SHEET BREAKDOWN
7	GRADING PLAN
8	GRADING PLAN
9	GRADING PLAN
10	GRADING PLAN
11	PHASE I BASIN SECTIONS
12	PHASE IIA BASIN SECTIONS
13	GRADING DETAILS
14	HAUL ROUTE, STOCKPILE LOCATION & WORKING LIMITS
15	SPILLWAY DETAILS
16	24" BASIN OUTLET
17	42" PIPE INLET STRUCTURE
18	42" PIPE EMERGENCY OUTLET
19	PLAN & PROFILE BASIN OUTLET PIPE
20	EMERGENCY OUTLET PLAN & PROFILE
21	STAGE DISCHARGE SHEET
22	SPILLWAY EROSION PROTECTION PLAN
23	STREET PLAN & PROFILE (DURANGO DRIVE)
24	UTILITY PLAN
25	BID GROUP II OVERALL & SHEET LAYOUT
26	MANHOLE DETAILS
27	STREET DRAIN INLET DETAILS
28	PLAN & PROFILE (OUTLET DRAIN) 0+00 - 2+75.45
29	PLAN & PROFILE (OUTLET DRAIN) 2+75.45 - 14+25.63
30	PLAN & PROFILE (OUTLET DRAIN) 14+25.63 - 25+25.63
31	PLAN & PROFILE (OUTLET DRAIN) 25+25.63 - 37+25.63
32	PLAN & PROFILE (OUTLET DRAIN) 37+25.63 - 48+76.78
33	PLAN & PROFILE (OUTLET DRAIN) 48+76.78 - 60+27.88
34	PLAN & PROFILE (OUTLET DRAIN) 60+27.88 - 71+28.01
35	PLAN & PROFILE (OUTLET DRAIN) 71+28.01 - 83+28.01
36	PLAN & PROFILE (OUTLET DRAIN) 83+28.01 - 93+13.11
18A	42 INCH PIPE OUTLET STRUCTURE

agency	approved date
Deputy City Manager	10/15/84
Director of Engineering Services	10/15/84
Chief, Land Development and Flood Control	10/15/84
Chief of Engineering Design	N/A
Chief of Traffic	10/15/84
Chief of Quality Control	10/15/84
Chief of Electrical Services	10/15/84
Chief of Sanitation	N/A
Director of Building and Safety	N/A

agency	approved date
Regional Transportation Commission	N/A
Nevada State Dept. of Transportation	N/A
Central Telephone Company	10/27/83
Las Vegas Valley Water District	10-28-83
Nevada Power Company	10-28-83
Southwest Gas Corporation	10-28-83
Bureau of Land Management	N/A
Director - Clark County Public Works	10/28/83

AS BUILT 11/15/84

date 10/2/83

no. description by date app.
revisions

drawing number 650.14-7

sheet 1 of 36