
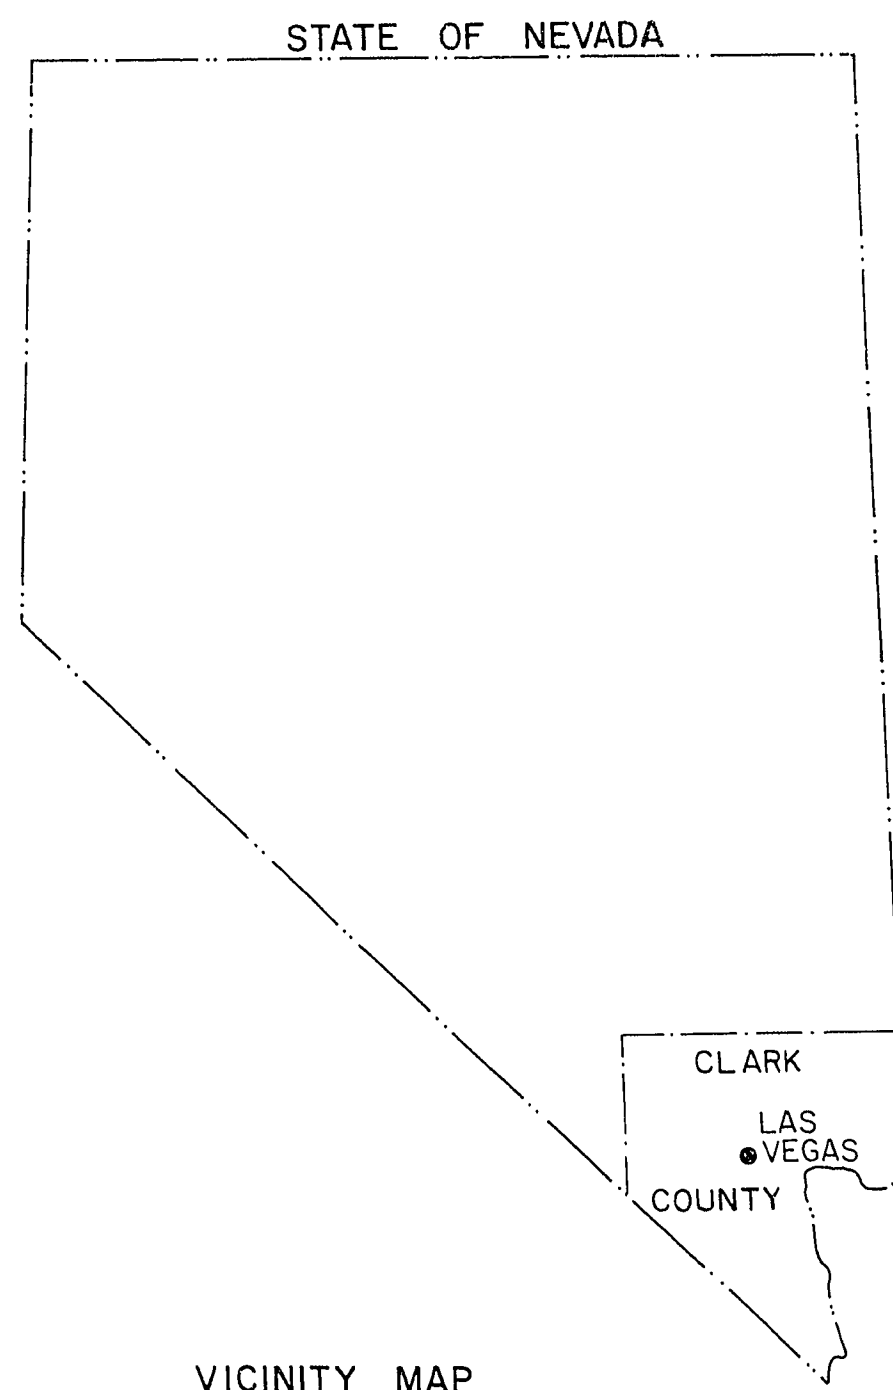



9-13-102

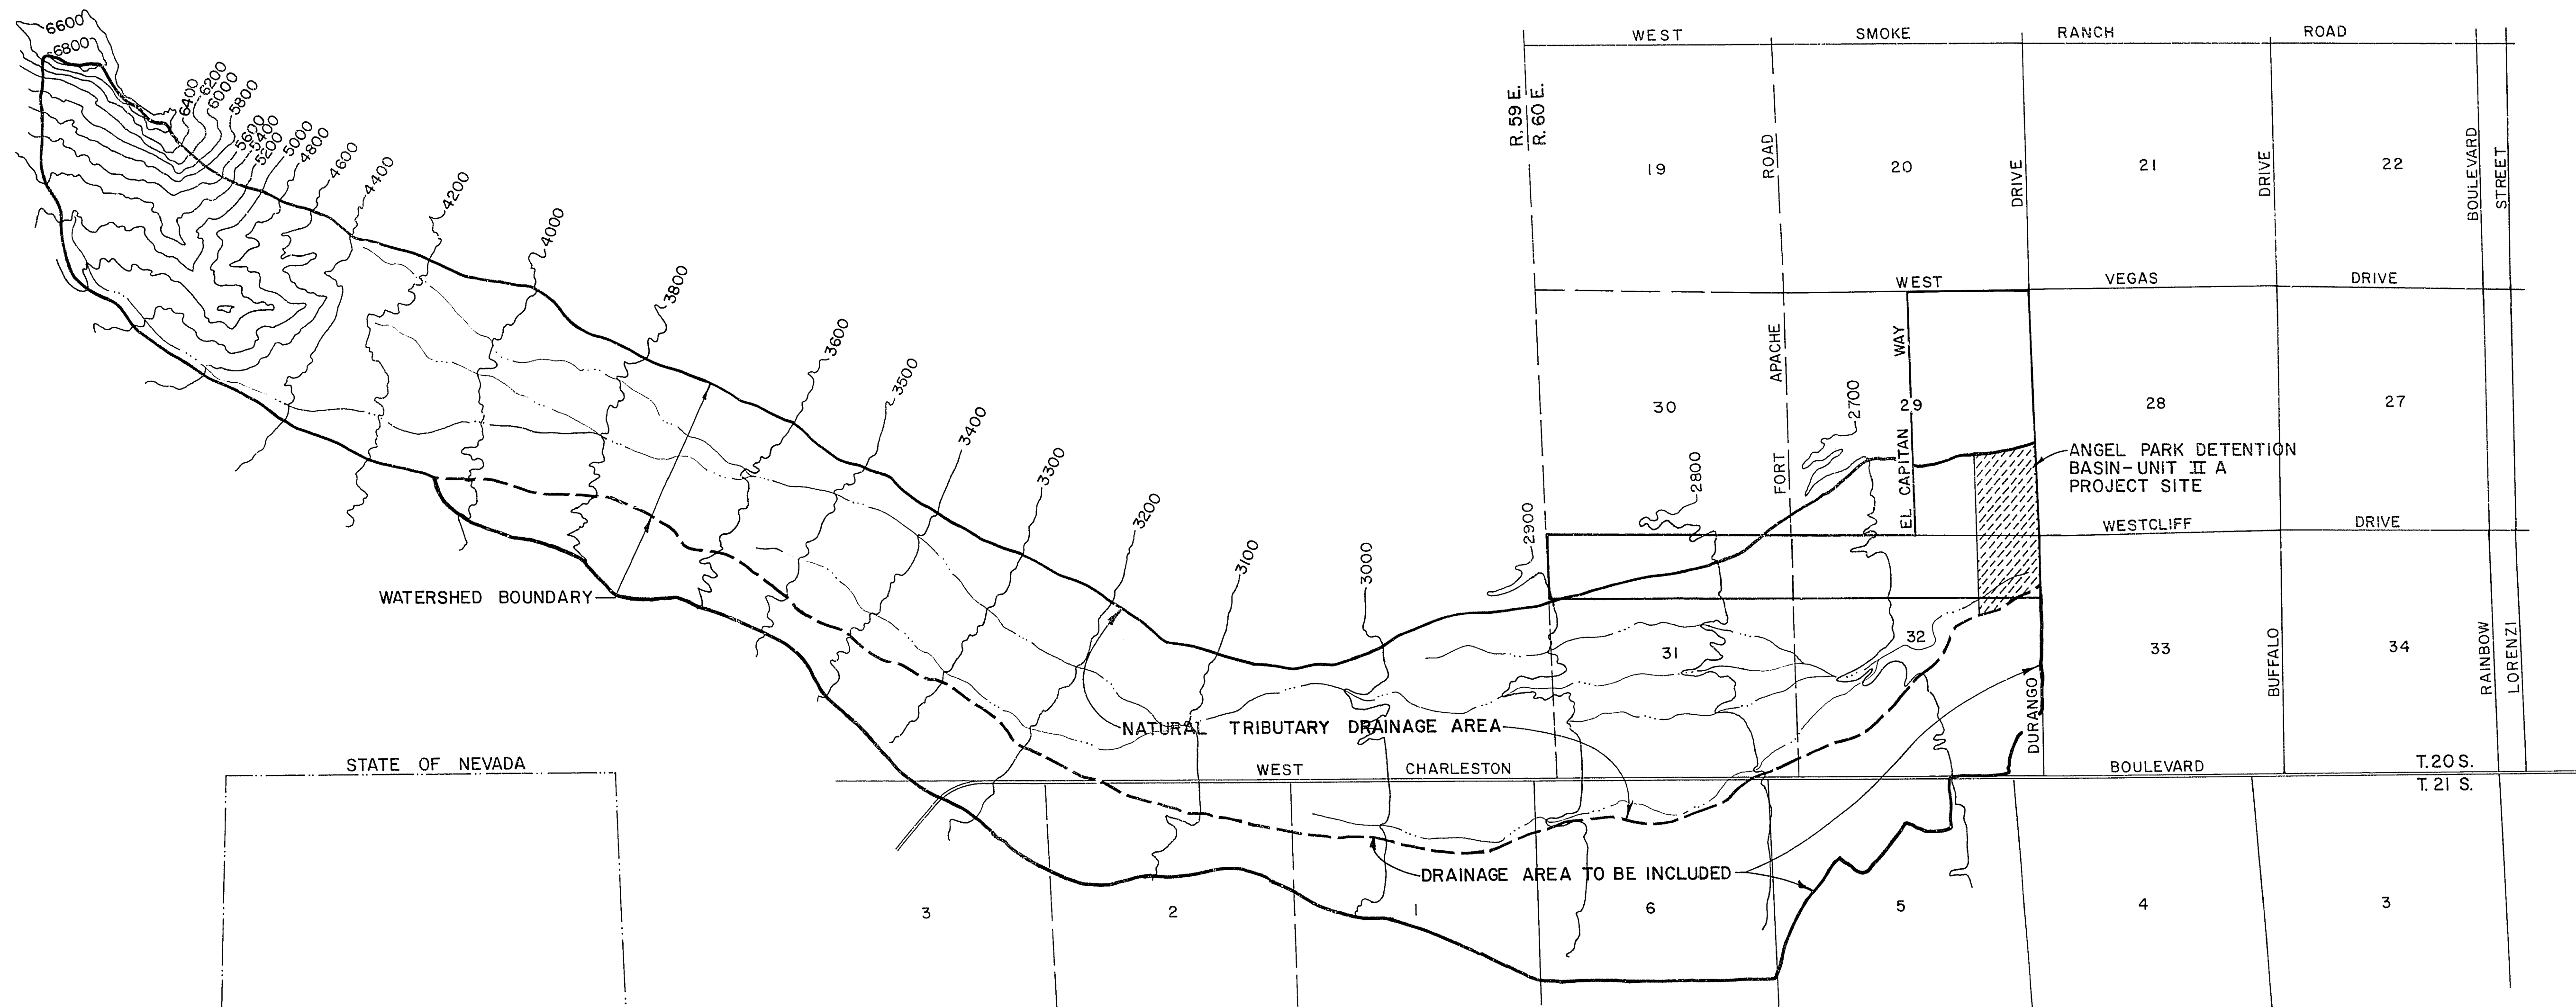

WATERSHED BOUNDARY & ANGEL PARK LOCATION MAP

REFERENCE
 BLUE DIAMOND NE &
 LA MADRE MTN. 7.5 MINUTE
 U.S.G.S. QUADRANGLE MAPS

WATERSHED AREA = 6.40 SQ. MILES

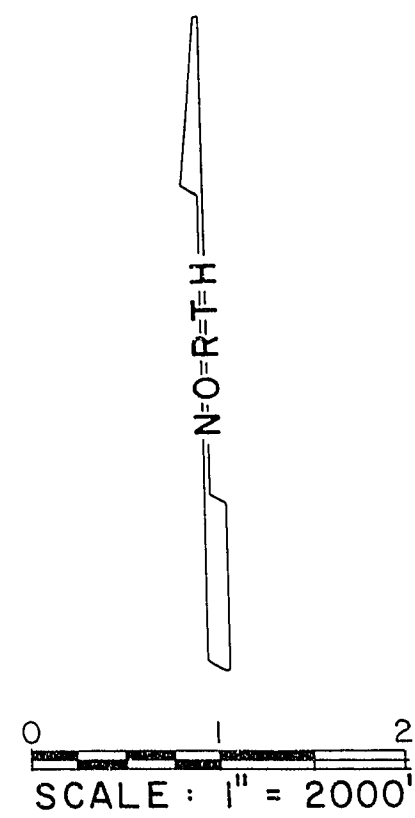

BENCH MARK

USGS BLM BRASS CAP NORTHEAST CORNER
 SECTION 32, T.20S., R.60E., M.D.M., CITY OF
 LAS VEGAS, CLARK COUNTY, NEVADA.
 1974 SURVEY, ELEVATION = 2611.11 CLV DATUM
 TO BE REESTABLISHED, SEE SHEET NO. 23

BASIS OF BEARING

N. 88°22'24" E., BEING THE NORTH LINE OF
 THE NORTHWEST QUARTER (NW 1/4) OF SECTION
 33, T.20S., R.60E., M.D.M., CLARK COUNTY,
 NEVADA.

AS BUILT
 11/15/84

| | | | |
|-----|------|----|----------|
| REV | DATE | BY | REVISION |
| | | | |
| | | | |
| | | | |

PLANNERS
 ENGINEERS • CONSULTING ENGINEERS
 BUILDING 4 SUITE B
 2800 WEST SAHARA AVENUE
 LAS VEGAS, NEVADA 89102
 PHONE (702) 873-7550

77-243
 11/15/84
 [Signature]

mtm nevada

TITLE: **VICINITY MAP, WATERSHED BOUNDARY MAP AND LOCATION MAP**

PROJECT: **ANGEL PARK DETENTION BASIN PHASE II A**

WO NO. 3061
 BY RPF/MJB/
 DATE 10/2/83
 SCALE AS NOTED

SHEET
2
 OF 36 SHEETS