
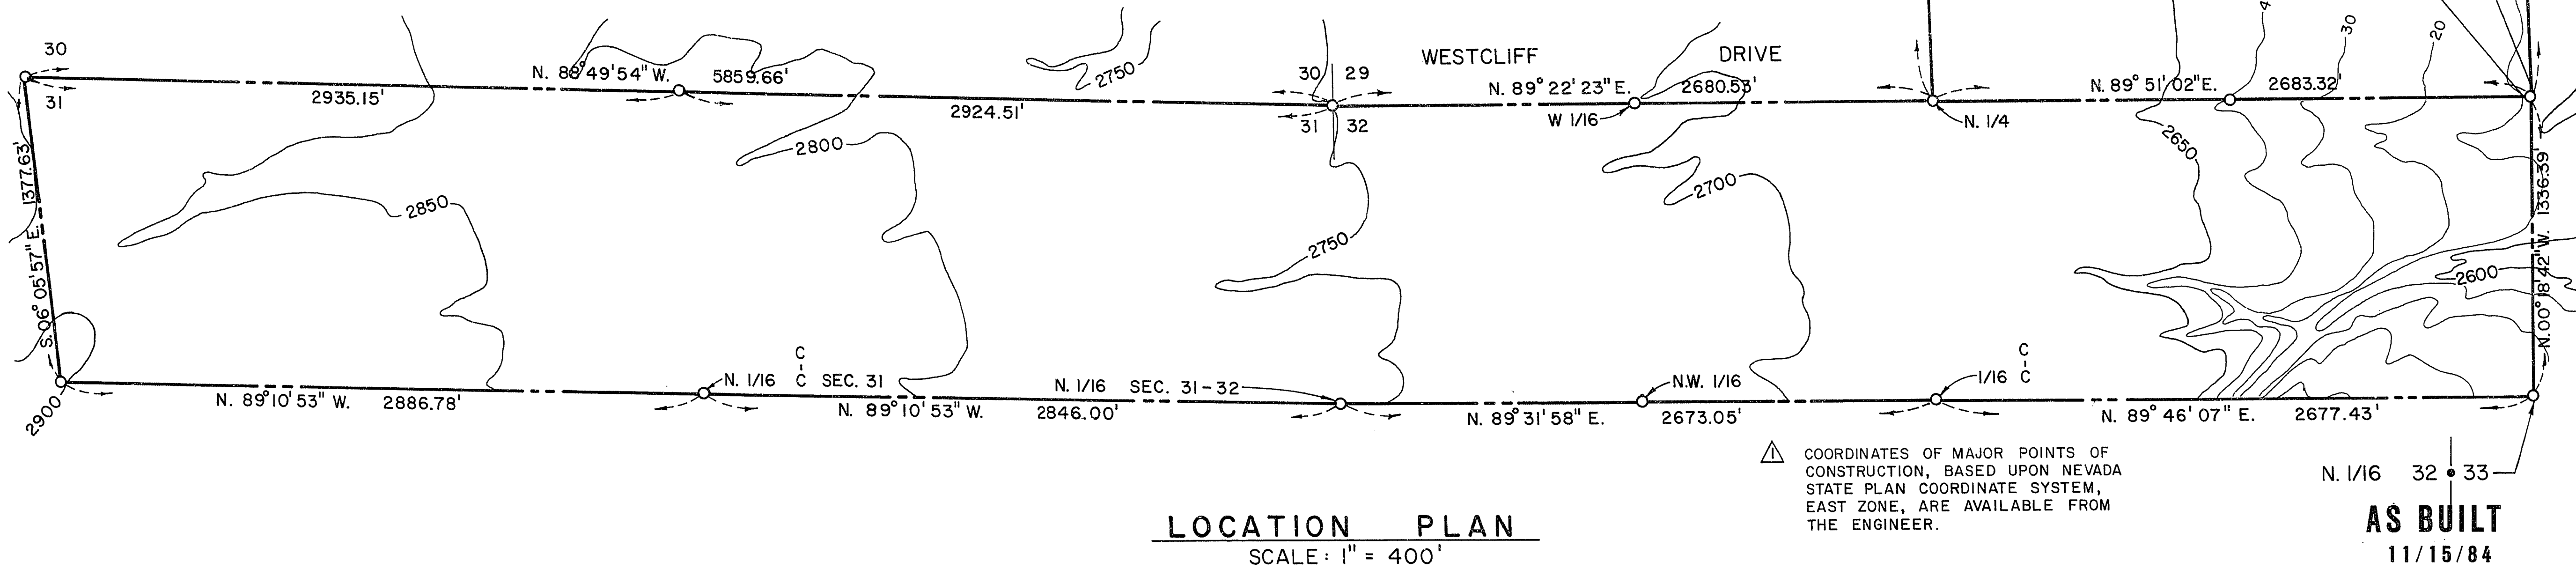


9-13-105

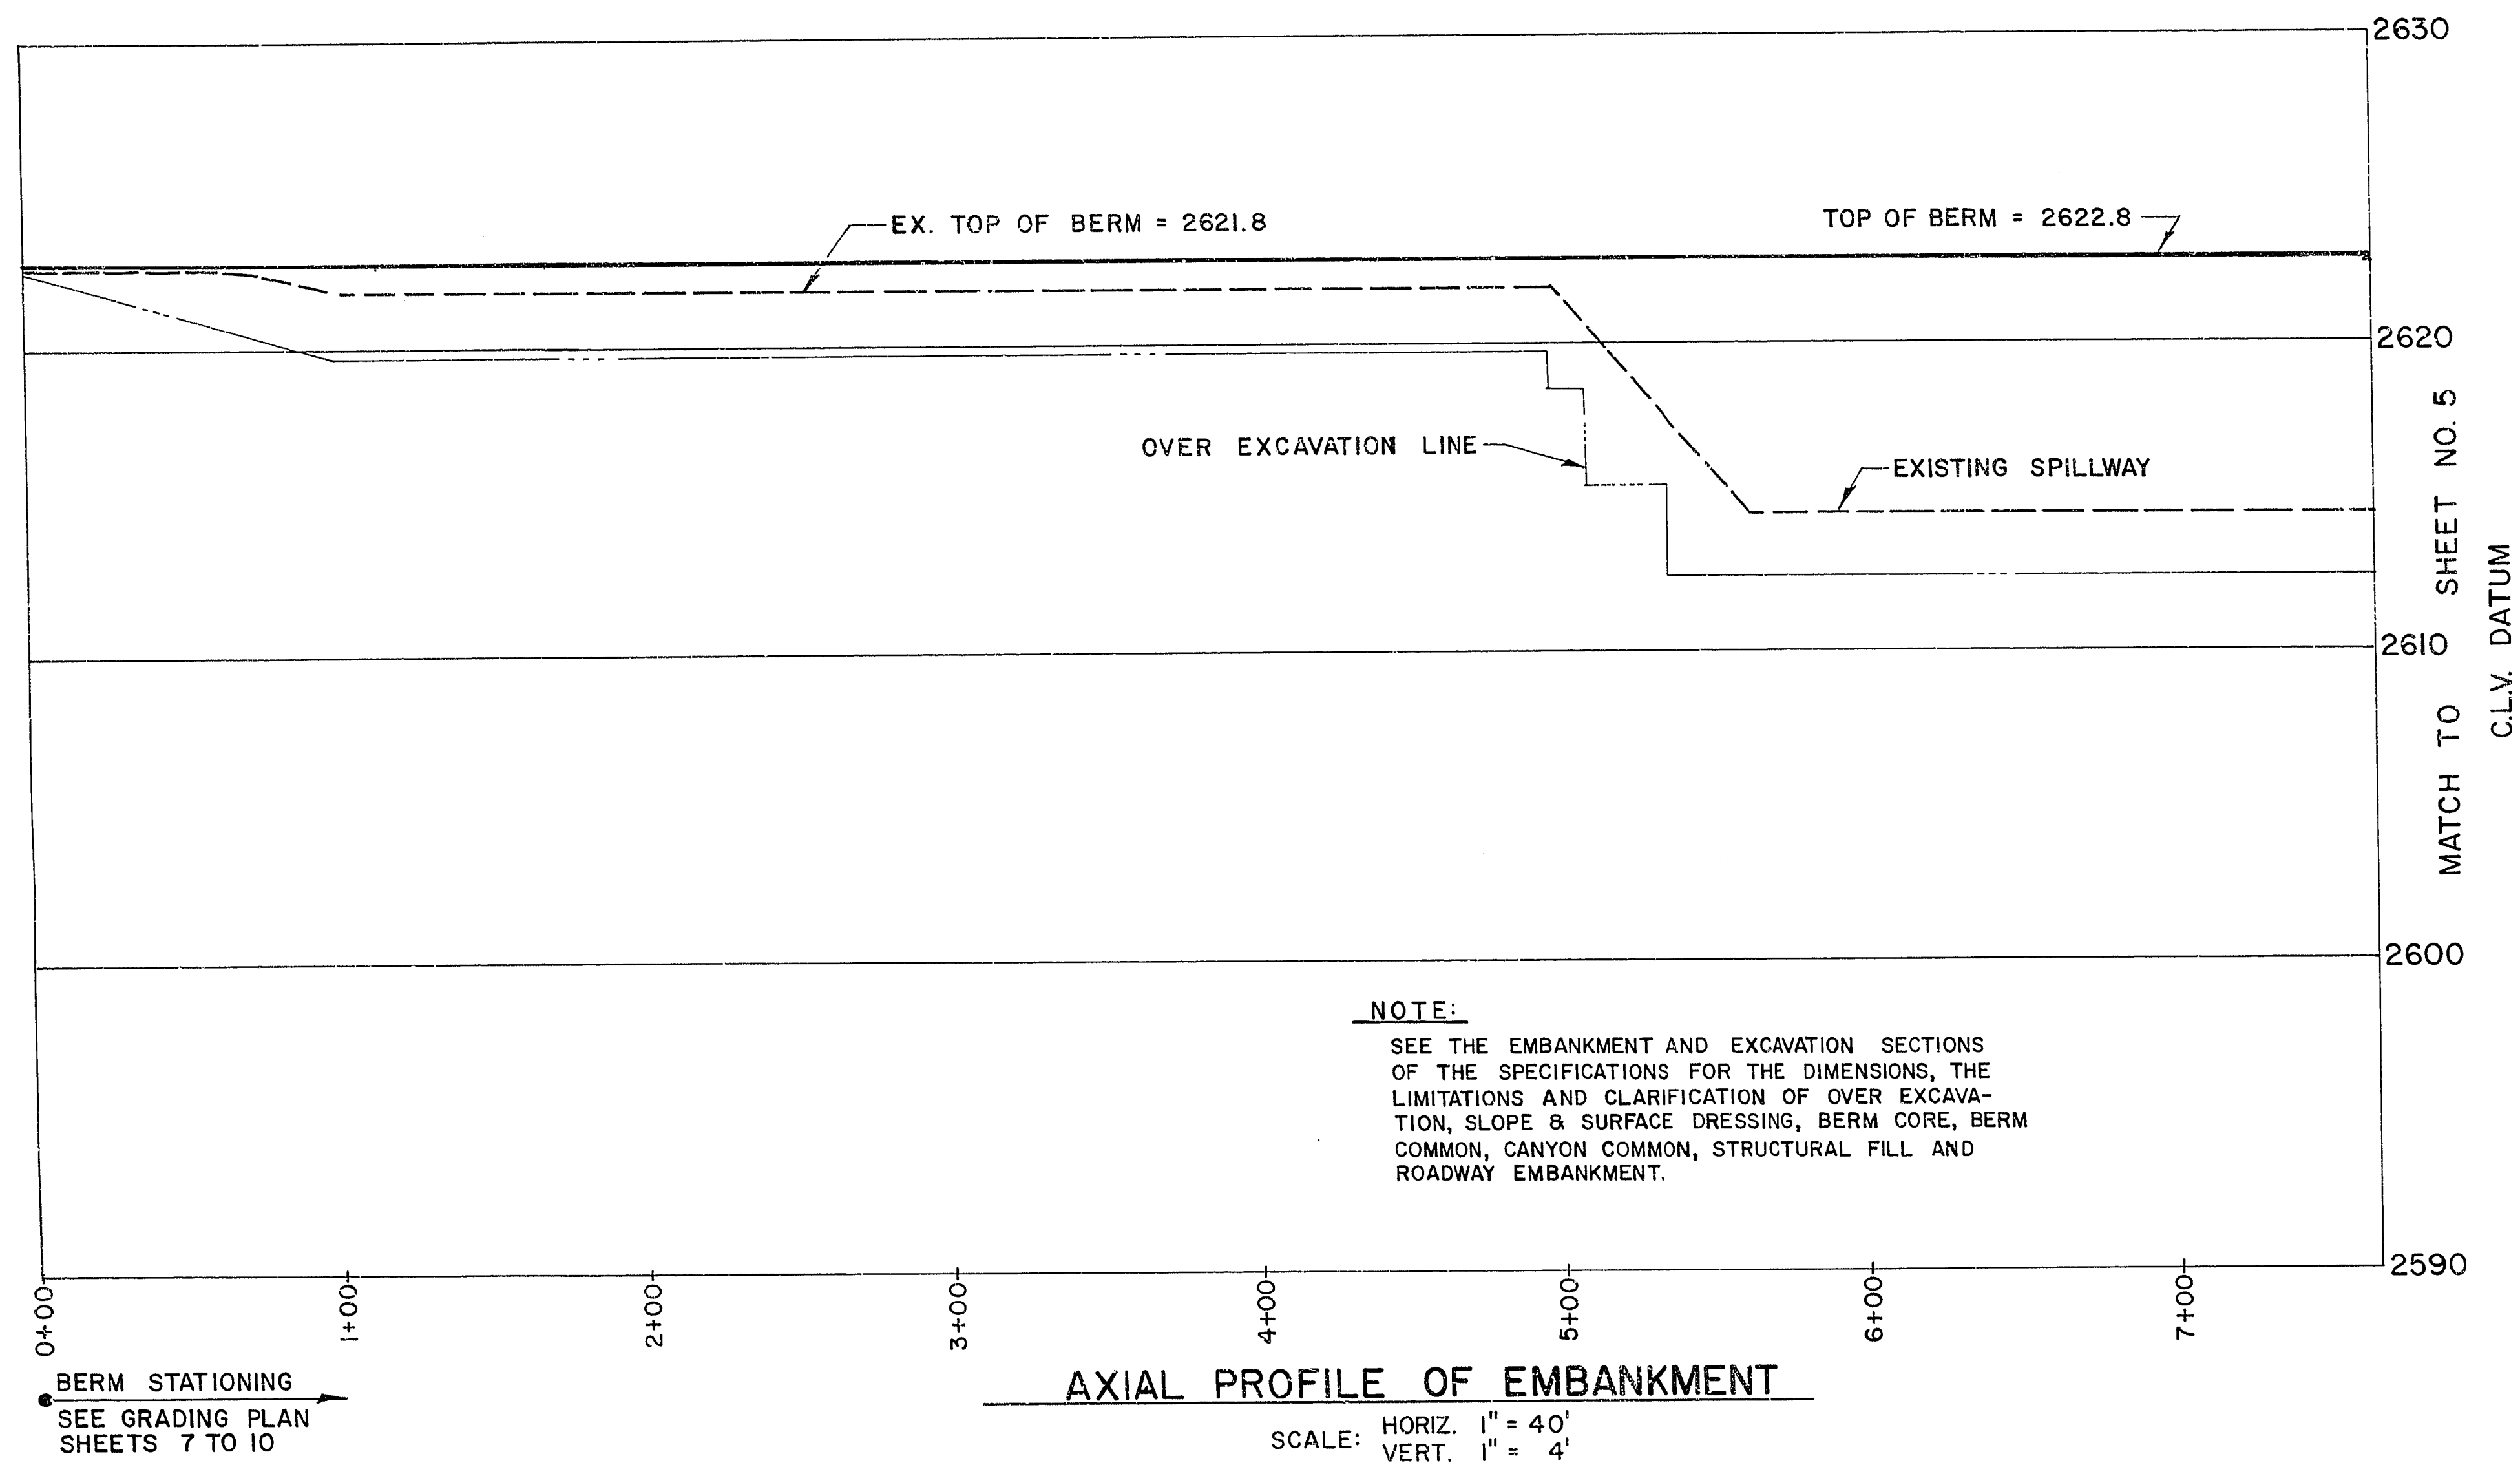

COORDINATES OF MAJOR POINTS OF CONSTRUCTION, BASED UPON NEVADA STATE PLAN COORDINATE SYSTEM, EAST ZONE, ARE AVAILABLE FROM THE ENGINEER.

AS BUILT
11/15/84

REV	DATE	BY	REVISION
1	1/24/84	MW	ADDED NOTE PER ADDENDUM

CONSULTING ENGINEERS • PLANNERS
2800 WEST SAHARA AVENUE BUILDING 4 SUITE B
LAS VEGAS, NEVADA 89102 PHONE (702) 873-7950

LOCATION PLAN
AND
AXIAL PROFILE OF EMBANKMENT
ANGEL PARK DETENTION BASIN
PHASE II A

WO NO. 3061
BY RPF/MJB
DATE 10/2/83
SCALE AS NOTED

SHEET
4
OF 36 SHEETS

650.14-7