



9-13-126

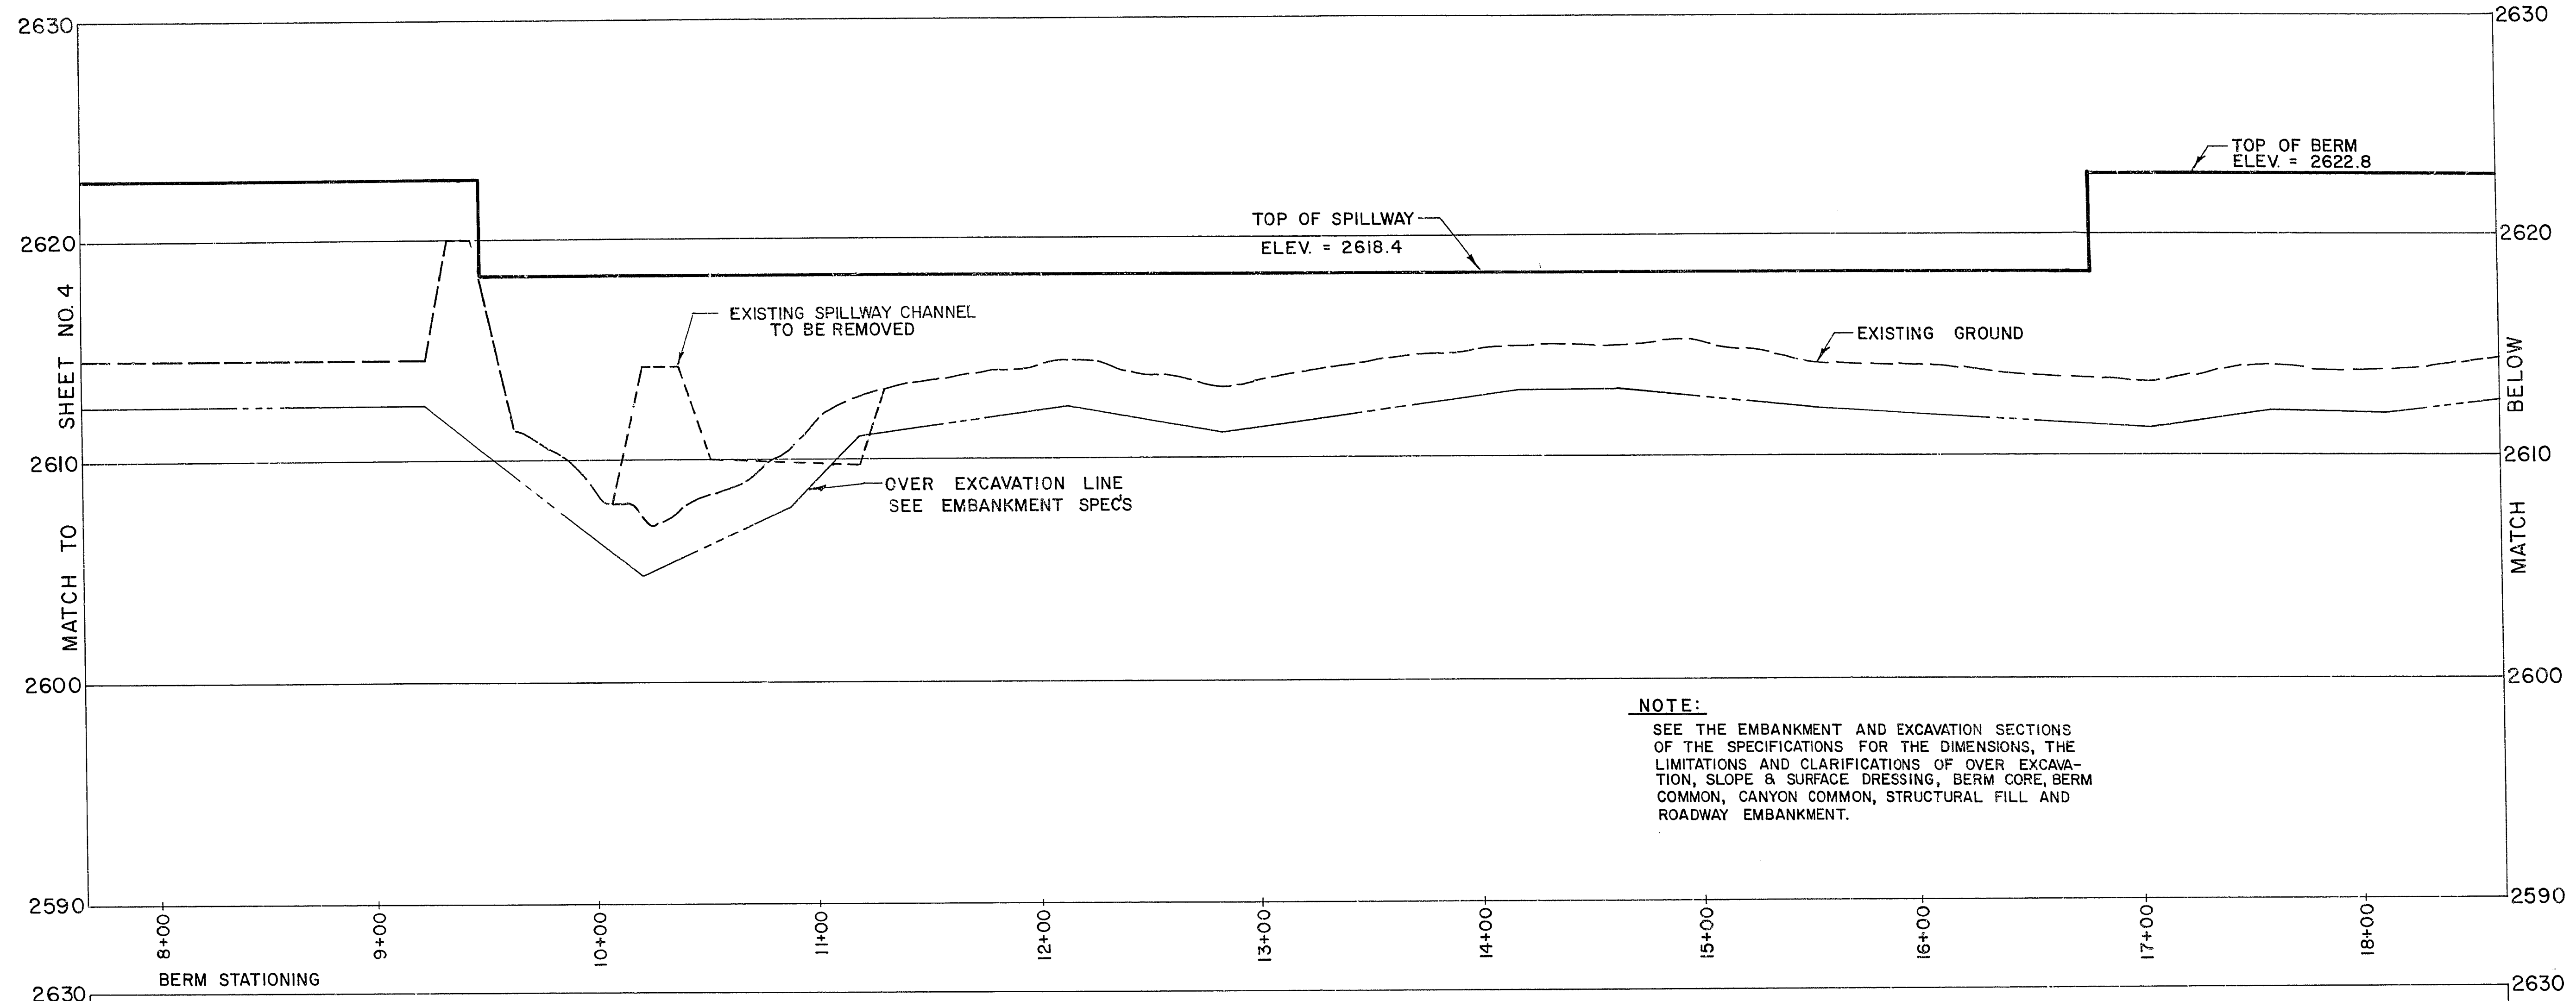

NOTE:
SEE THE EMBANKMENT AND EXCAVATION SECTIONS OF THE SPECIFICATIONS FOR THE DIMENSIONS, THE LIMITATIONS AND CLARIFICATIONS OF OVER EXCAVATION, SLOPE & SURFACE DRESSING, BERM CORE, BERM COMMON, CANYON COMMON, STRUCTURAL FILL AND ROADWAY EMBANKMENT.

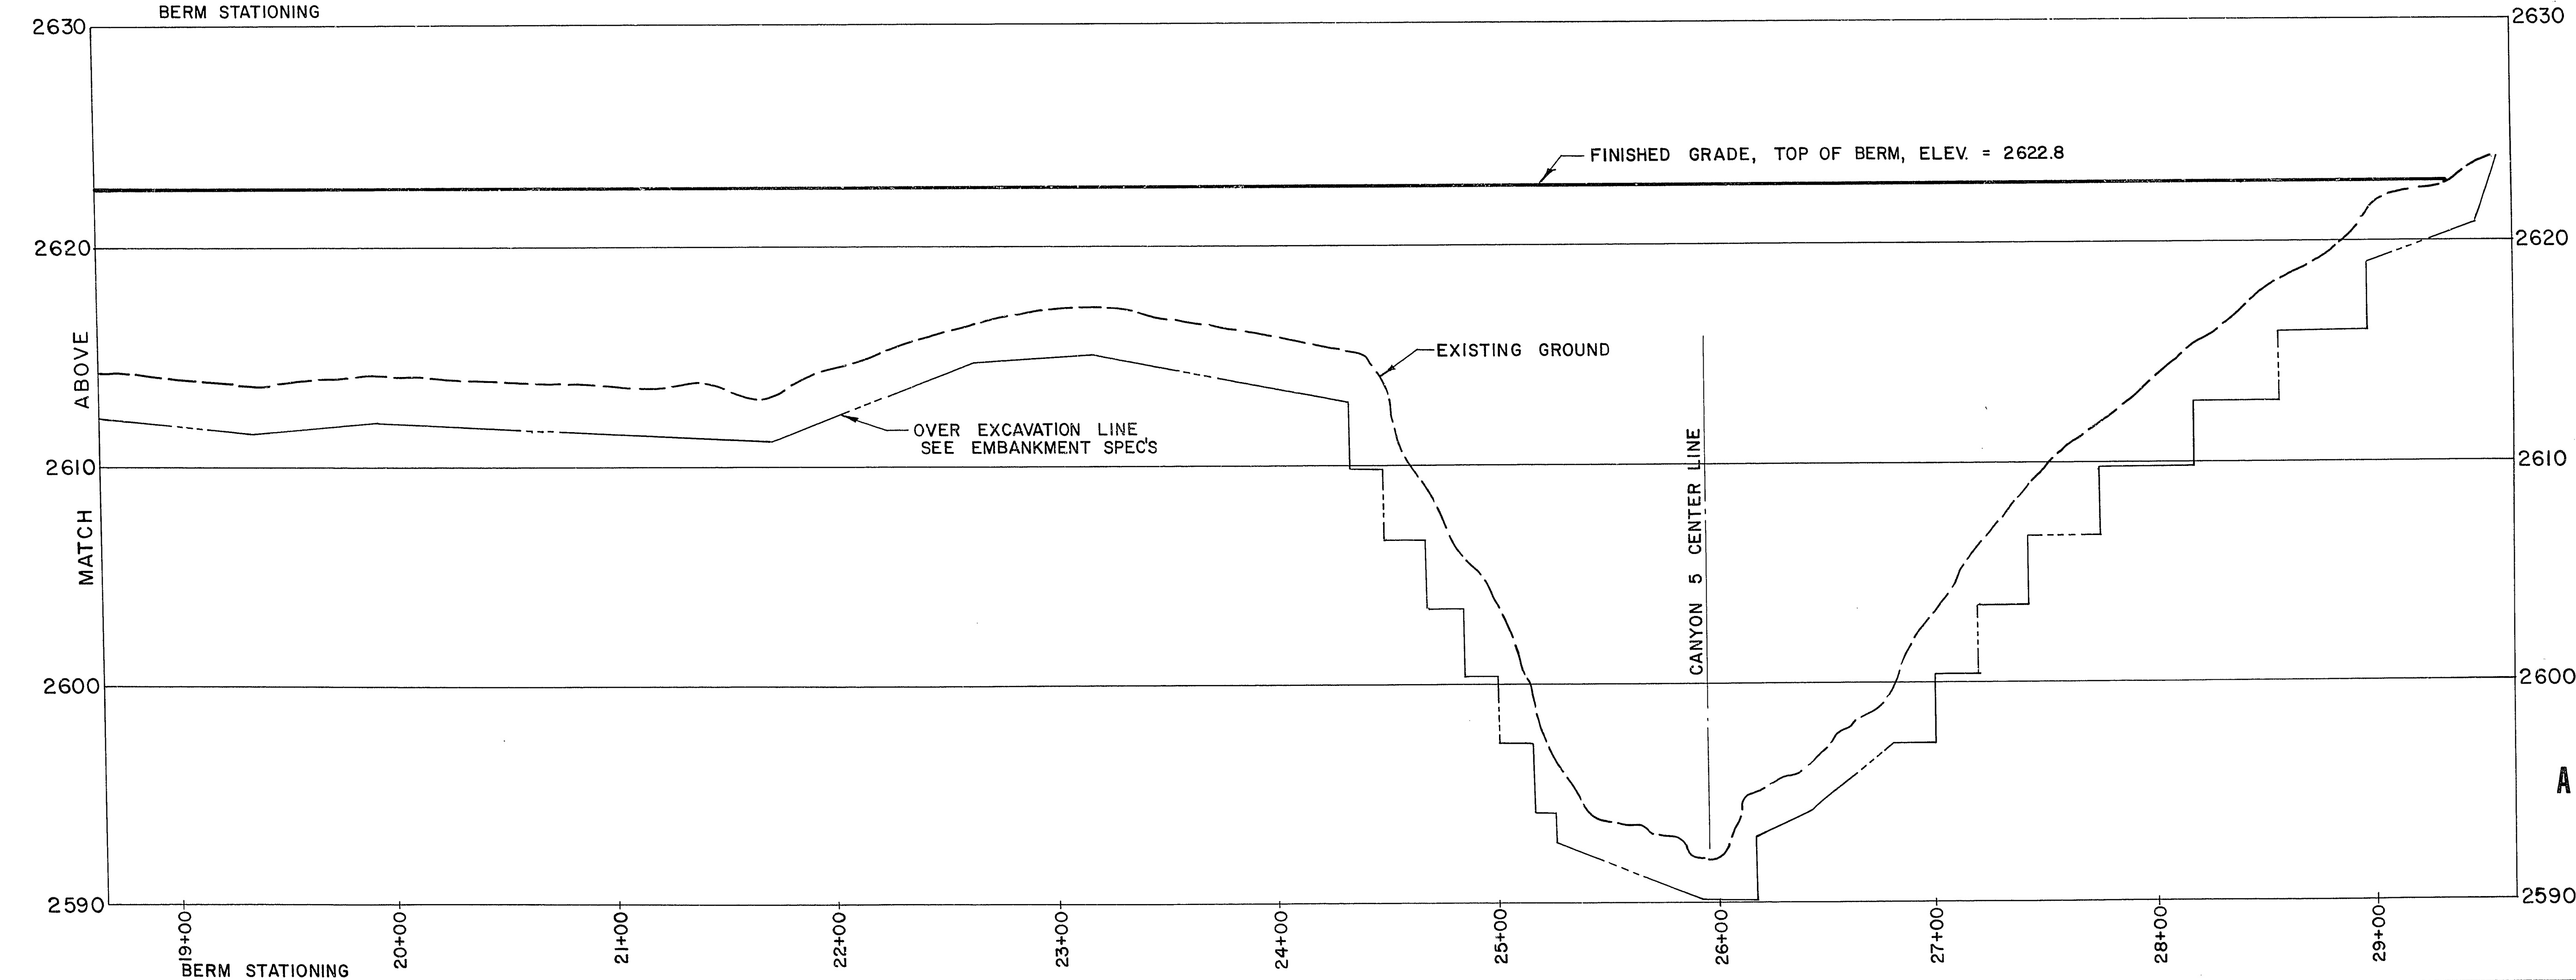

AS BUILT
11/15/84

REVISION	
REV	DATE
BY	
PLANNERS	
CONSULTING ENGINEERS	
2800 WEST SAHARA AVENUE BUILDING 4 SUITE B	
LAS VEGAS, NEVADA 89102 PHONE (702) 873-7550	

James K. [Signature]
10-213
nevada

TITLE	
AXIAL PROFILE OF EMBANKMENT	
PROJECT	
ANGEL PARK DETENTION BASIN	
PHASE II A	
WO NO. 3061	
BY RPF/MJB	
DATE 10/2/83	
SCALE HOR. 1" = 40'	
VERT. 1" = 4'	
SHEET	
5	
OF 36 SHEETS	