


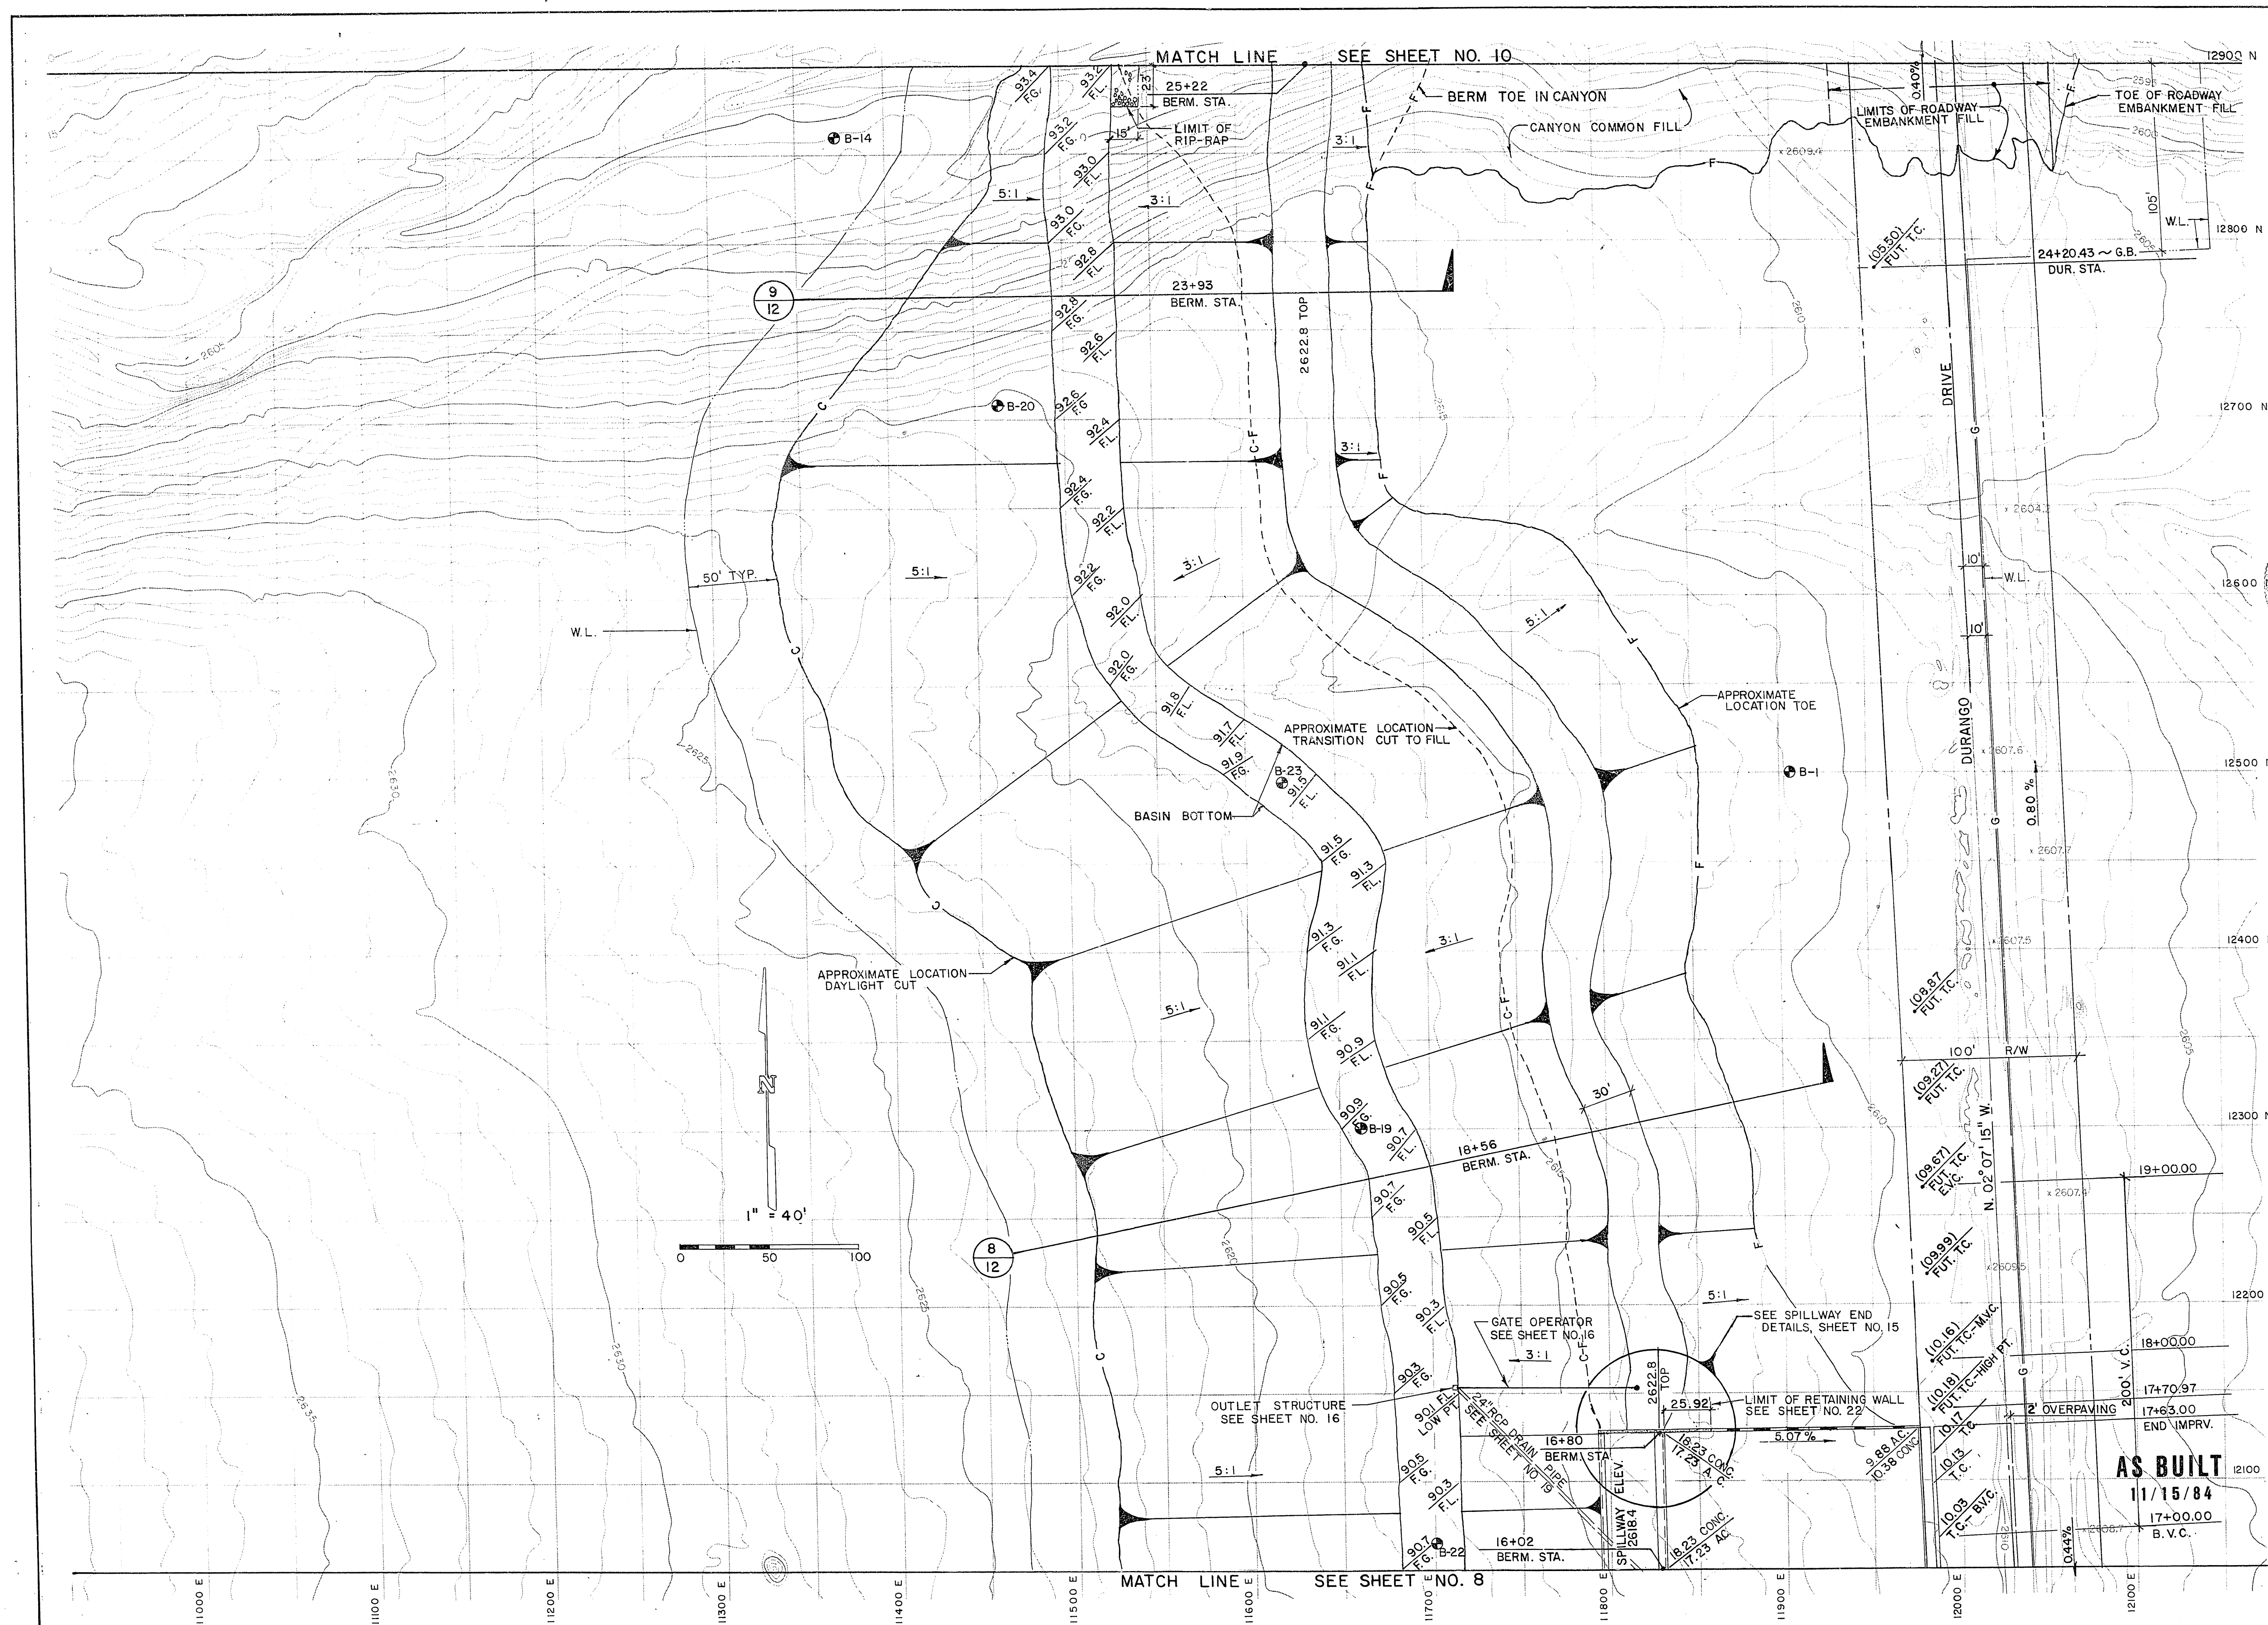

9-15-110

REV	DATE	BY	REVISION
1	10/4/83	RPF	ADD BORINGS B-22 & B-23
2	11/20/83	RPF	ADDED GAS LINE
3	11/1/85	EDY	REMOVED PLANTER AREAS

James L. ...

CONSULTING ENGINEERS • PLANNERS

2800 WEST SAHARA AVENUE BUILDING 4 SUITE B

LAS VEGAS, NEVADA 89102 PHONE (702) 873-7550

vtm nevada

GRADING PLAN

ANGEL PARK DETENTION BASIN

PHASE II A

WO NO. 3061

BY RPF/MJB

DATE 10/2/83

SCALE 1" = 40'

SHEET

9

OF 36 SHEETS

AS BUILT
11/15/84
17+00.00
B.V.C.