


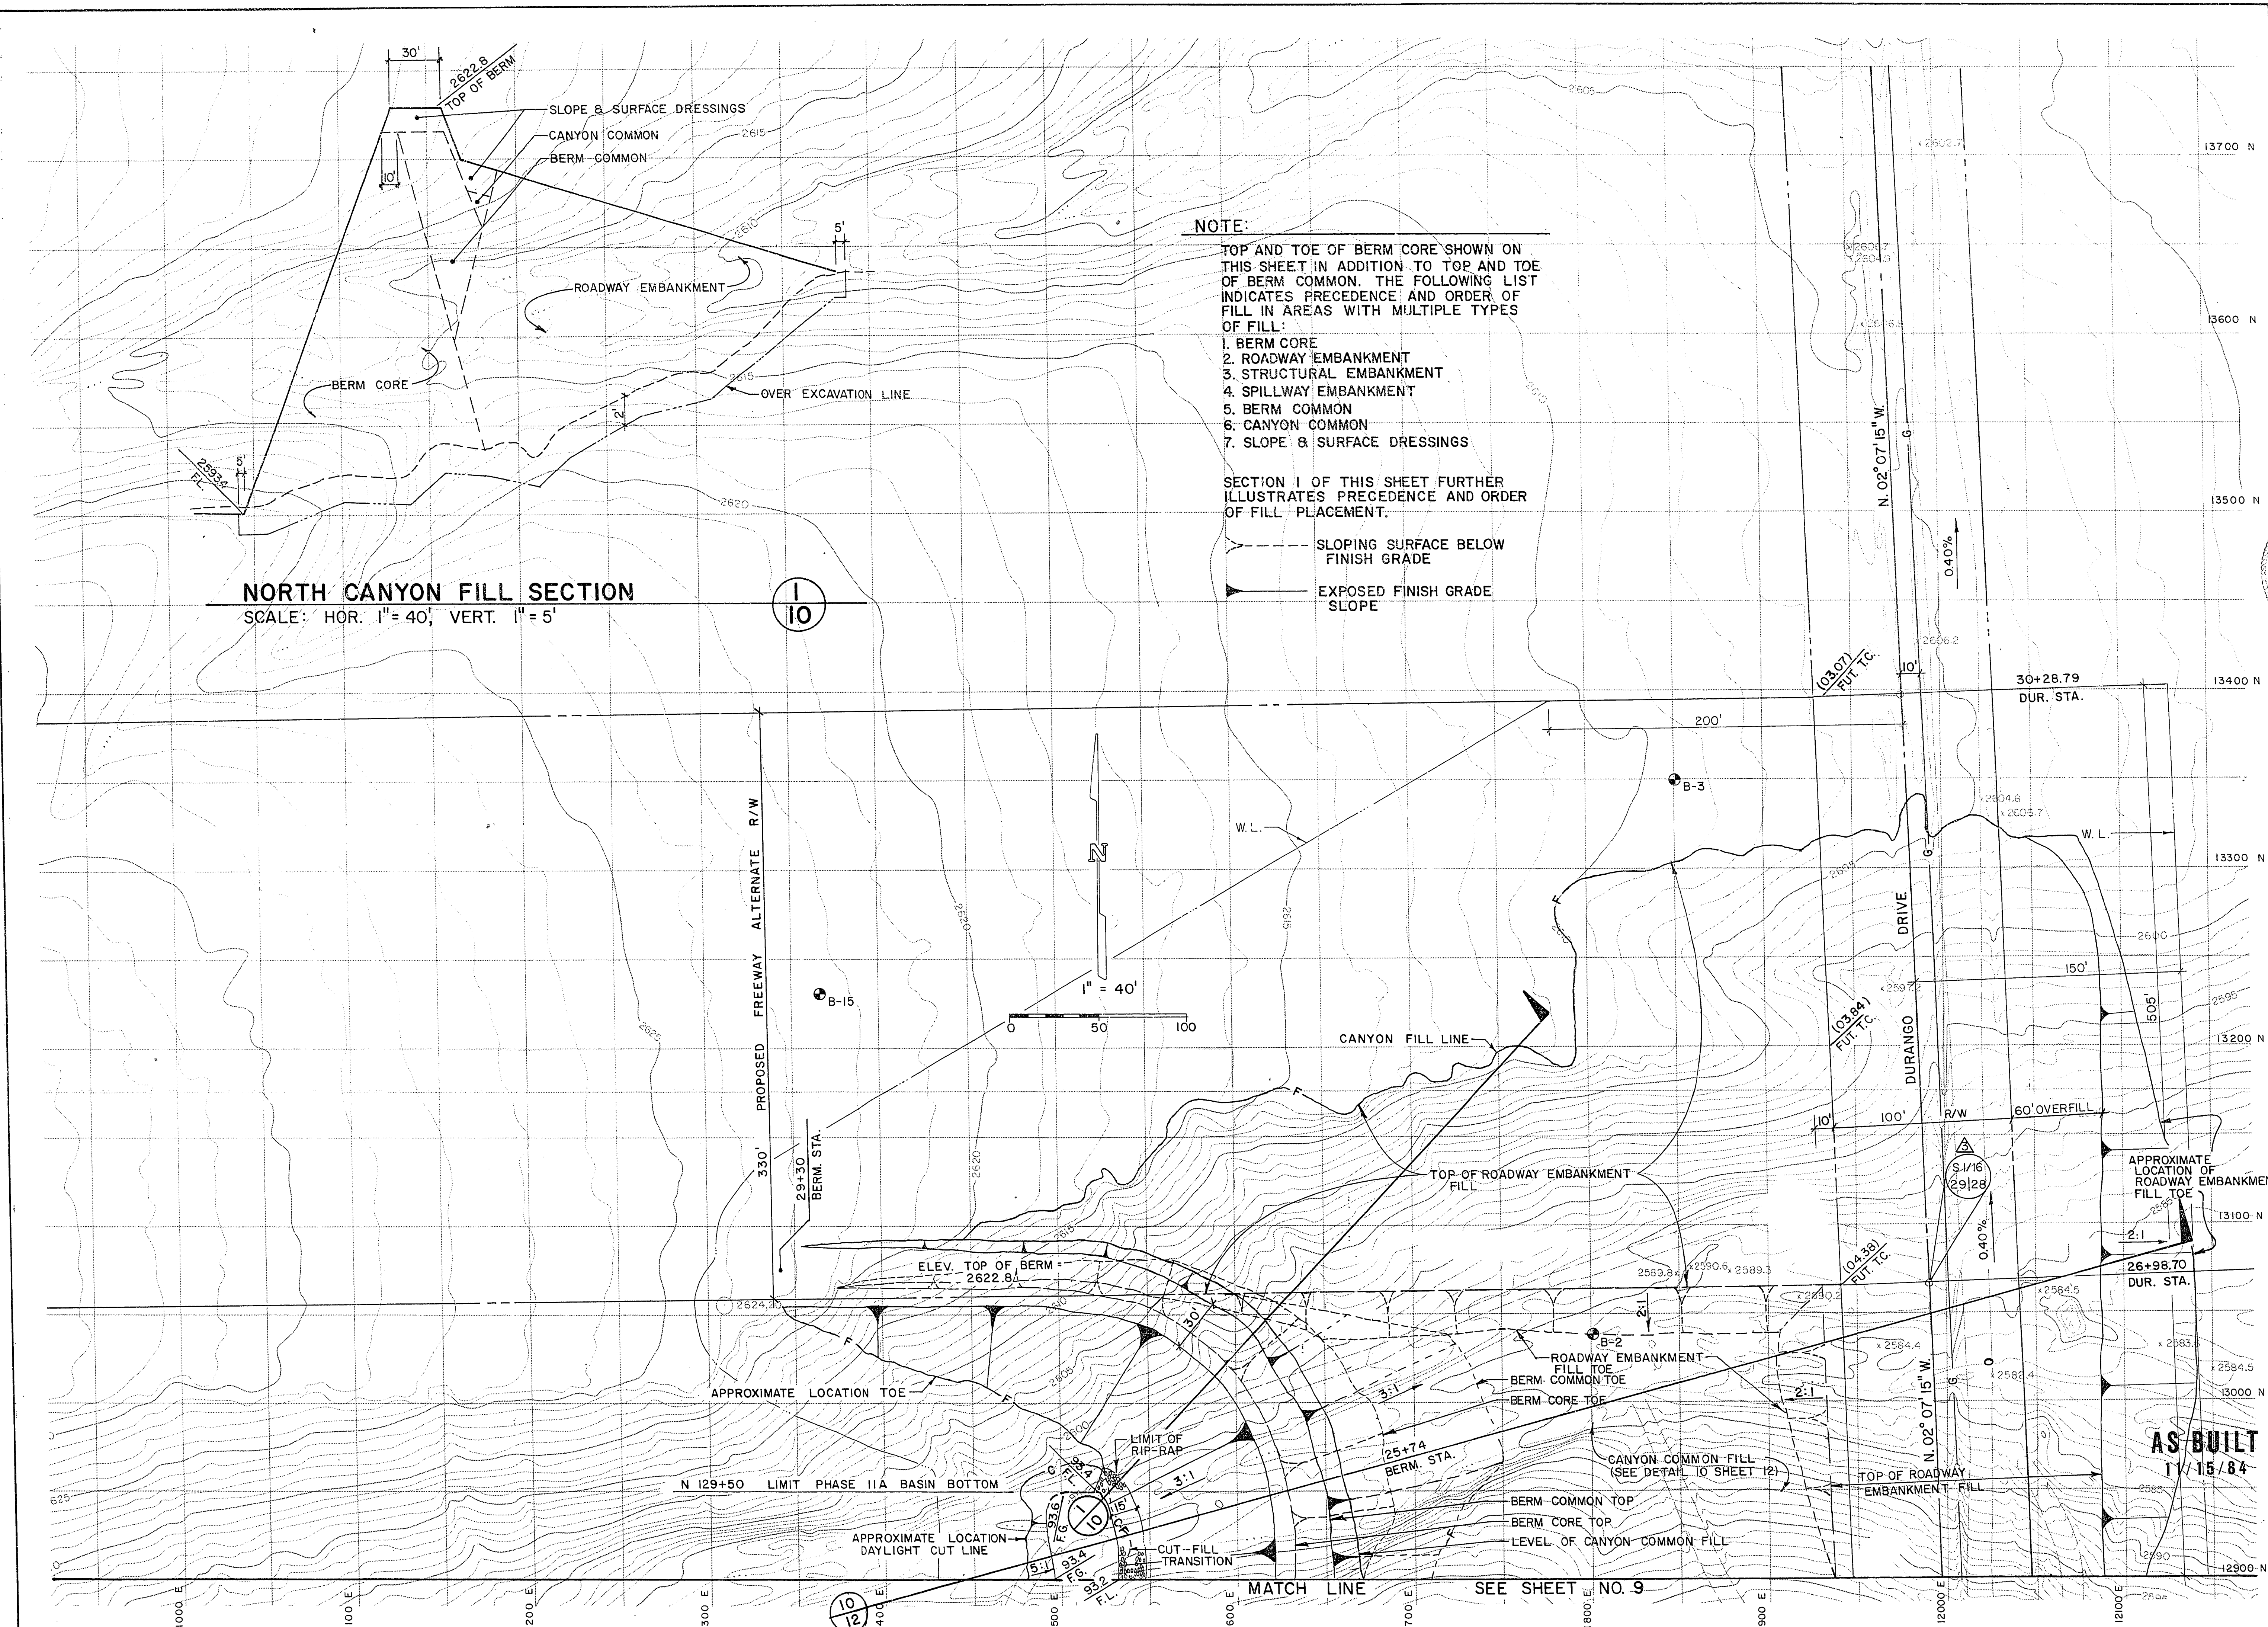

NOTE:
TOP AND TOE OF BERM CORE SHOWN ON THIS SHEET IN ADDITION TO TOP AND TOE OF BERM COMMON. THE FOLLOWING LIST INDICATES PRECEDENCE AND ORDER OF FILL IN AREAS WITH MULTIPLE TYPES OF FILL:
1. BERM CORE
2. ROADWAY EMBANKMENT
3. STRUCTURAL EMBANKMENT
4. SPILLWAY EMBANKMENT
5. BERM COMMON
6. CANYON COMMON
7. SLOPE & SURFACE DRESSINGS
SECTION 1 OF THIS SHEET FURTHER ILLUSTRATES PRECEDENCE AND ORDER OF FILL PLACEMENT.

--- SLOPING SURFACE BELOW FINISH GRADE
▲ EXPOSED FINISH GRADE SLOPE

NORTH CANYON FILL SECTION
SCALE: HOR. 1" = 40', VERT. 1" = 5'

7-12-111

REV	DATE	BY	REVISION
1	10/4/83	RPF	ADD SECTION 1 & NOTE
2	1/20/83	RPF	ALTER SLOPES & ADDED GAS LINE, NOTES
3	5/4/84	MW	AS BUILT OVERFILL, CORRECT COR. LOC.

10-2-83

10-2-83

10-2-83

CONSULTING ENGINEERS • PLANNERS
2800 WEST SAHARA AVENUE BUILDING 4 SUITE B
LAS VEGAS, NEVADA 89102 PHONE (702) 873-7550

10-2-83

10-2-83

10-2-83

vtm nevada

GRADING PLAN

ANGEL PARK DETENTION BASIN
PHASE II A

WO NO. 3061

BY RPF/MJB

DATE 10/2/83

SCALE 1" = 40'

SHEET 10

OF 36 SHEETS

650.14-7