




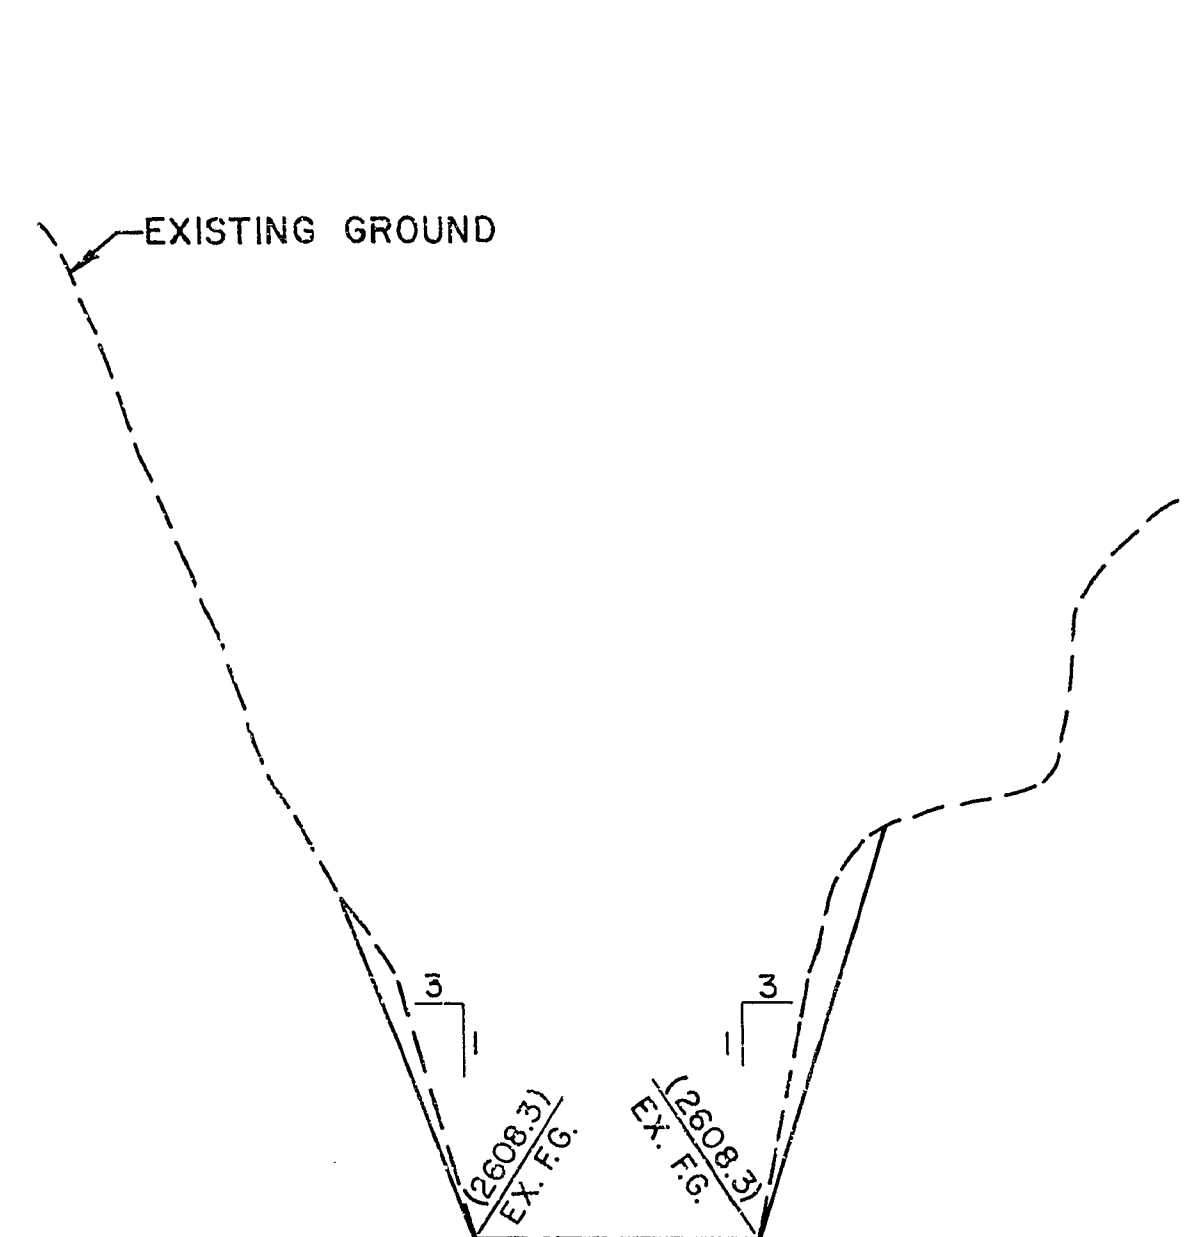


CANYON 6 SECTION 1

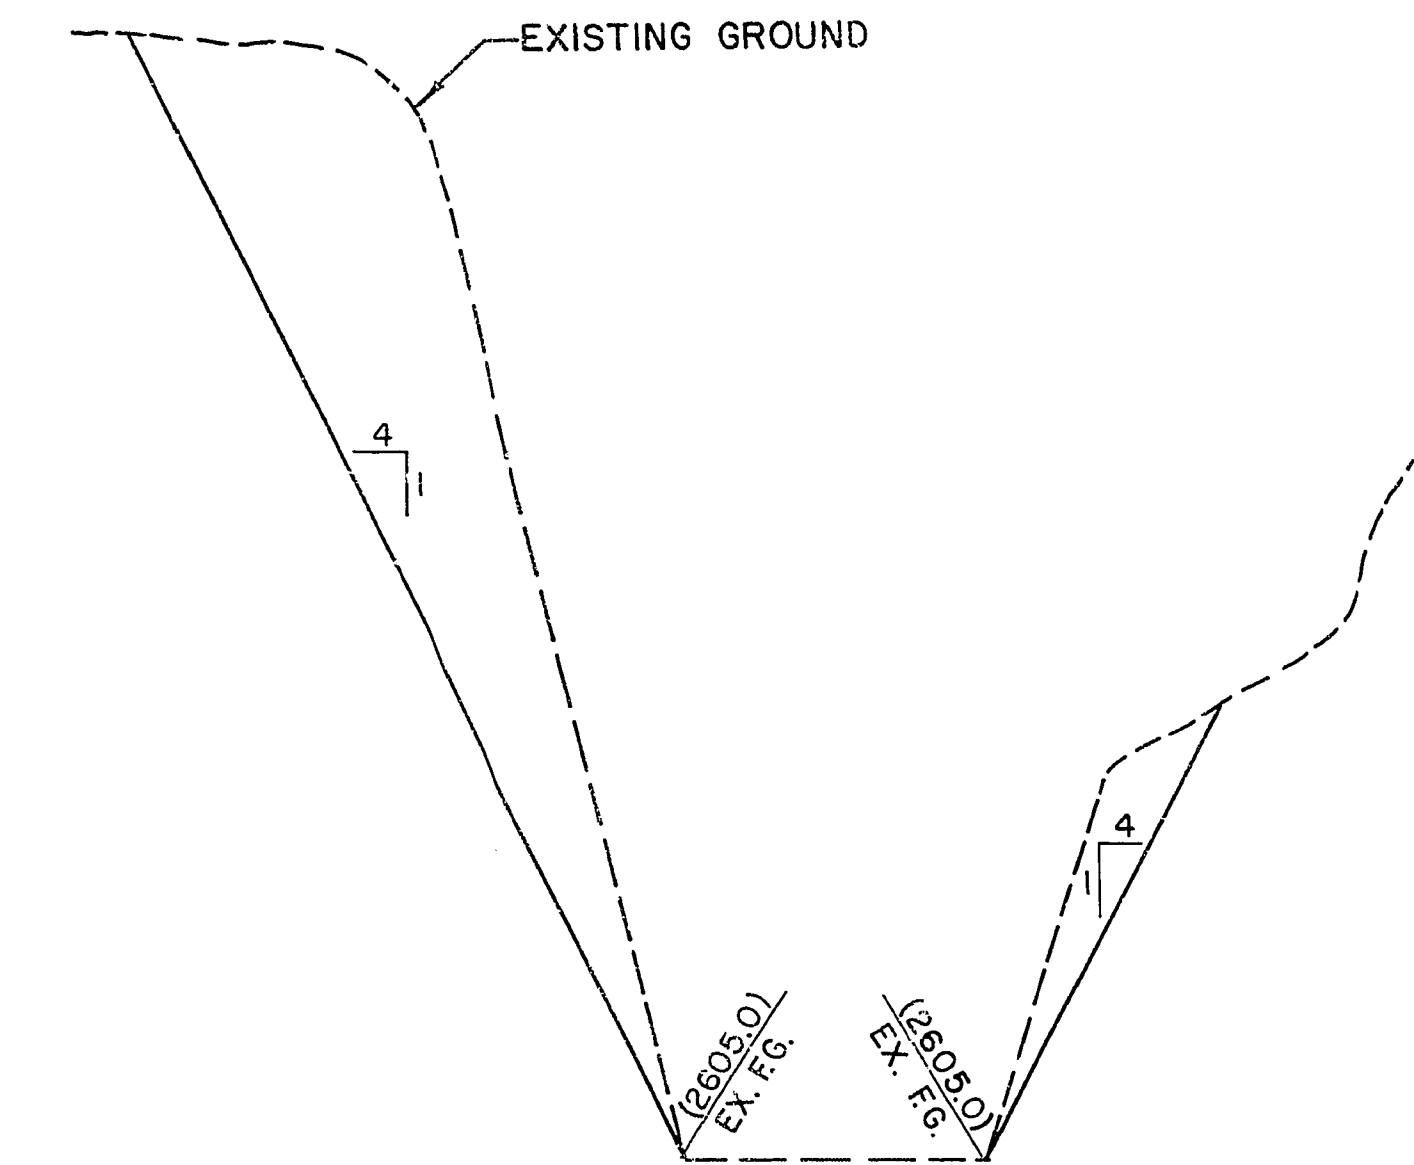


CANYON 6 SECTION 2

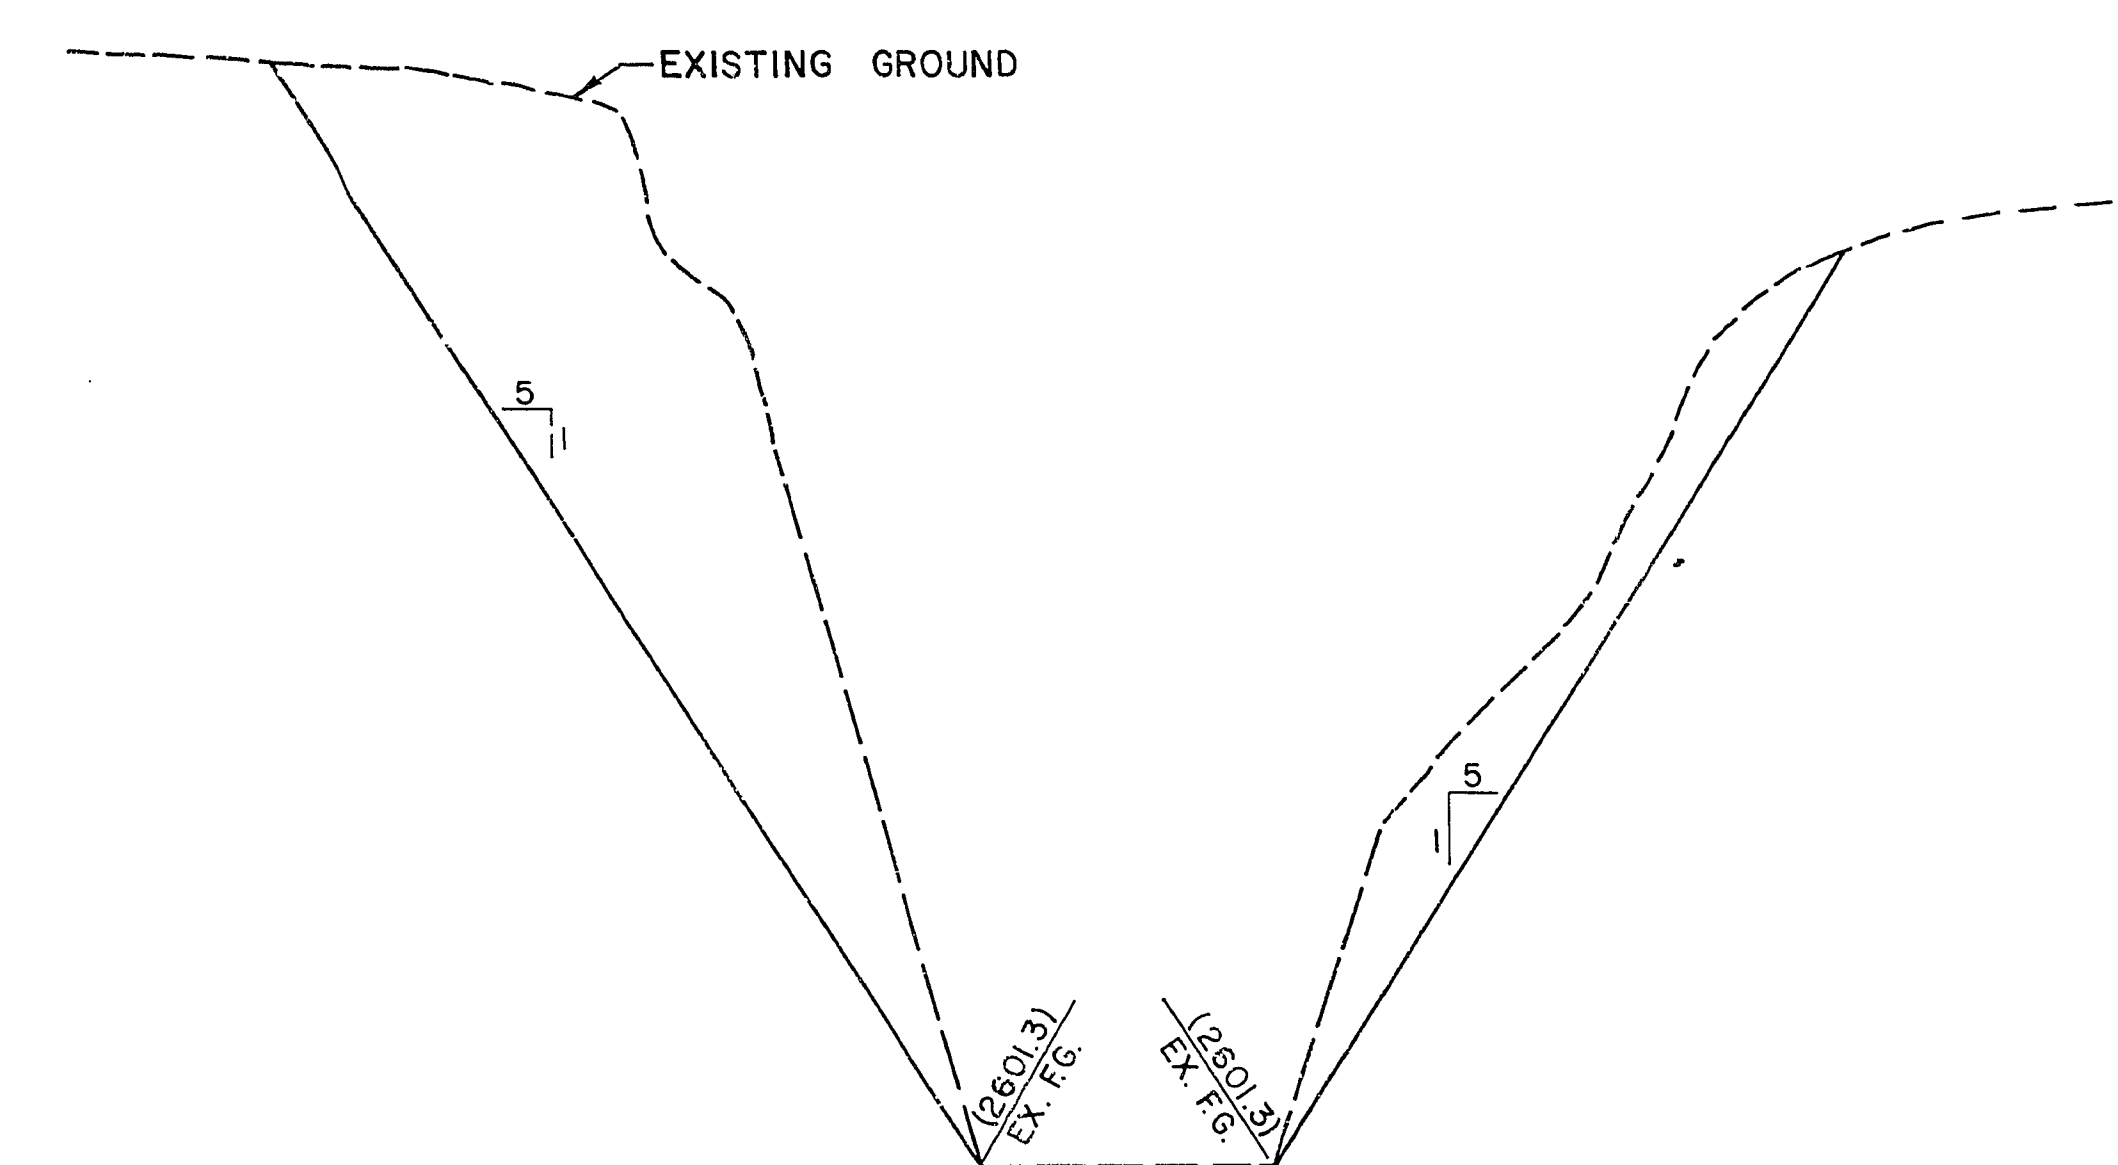


CANYON 6 SECTION 3

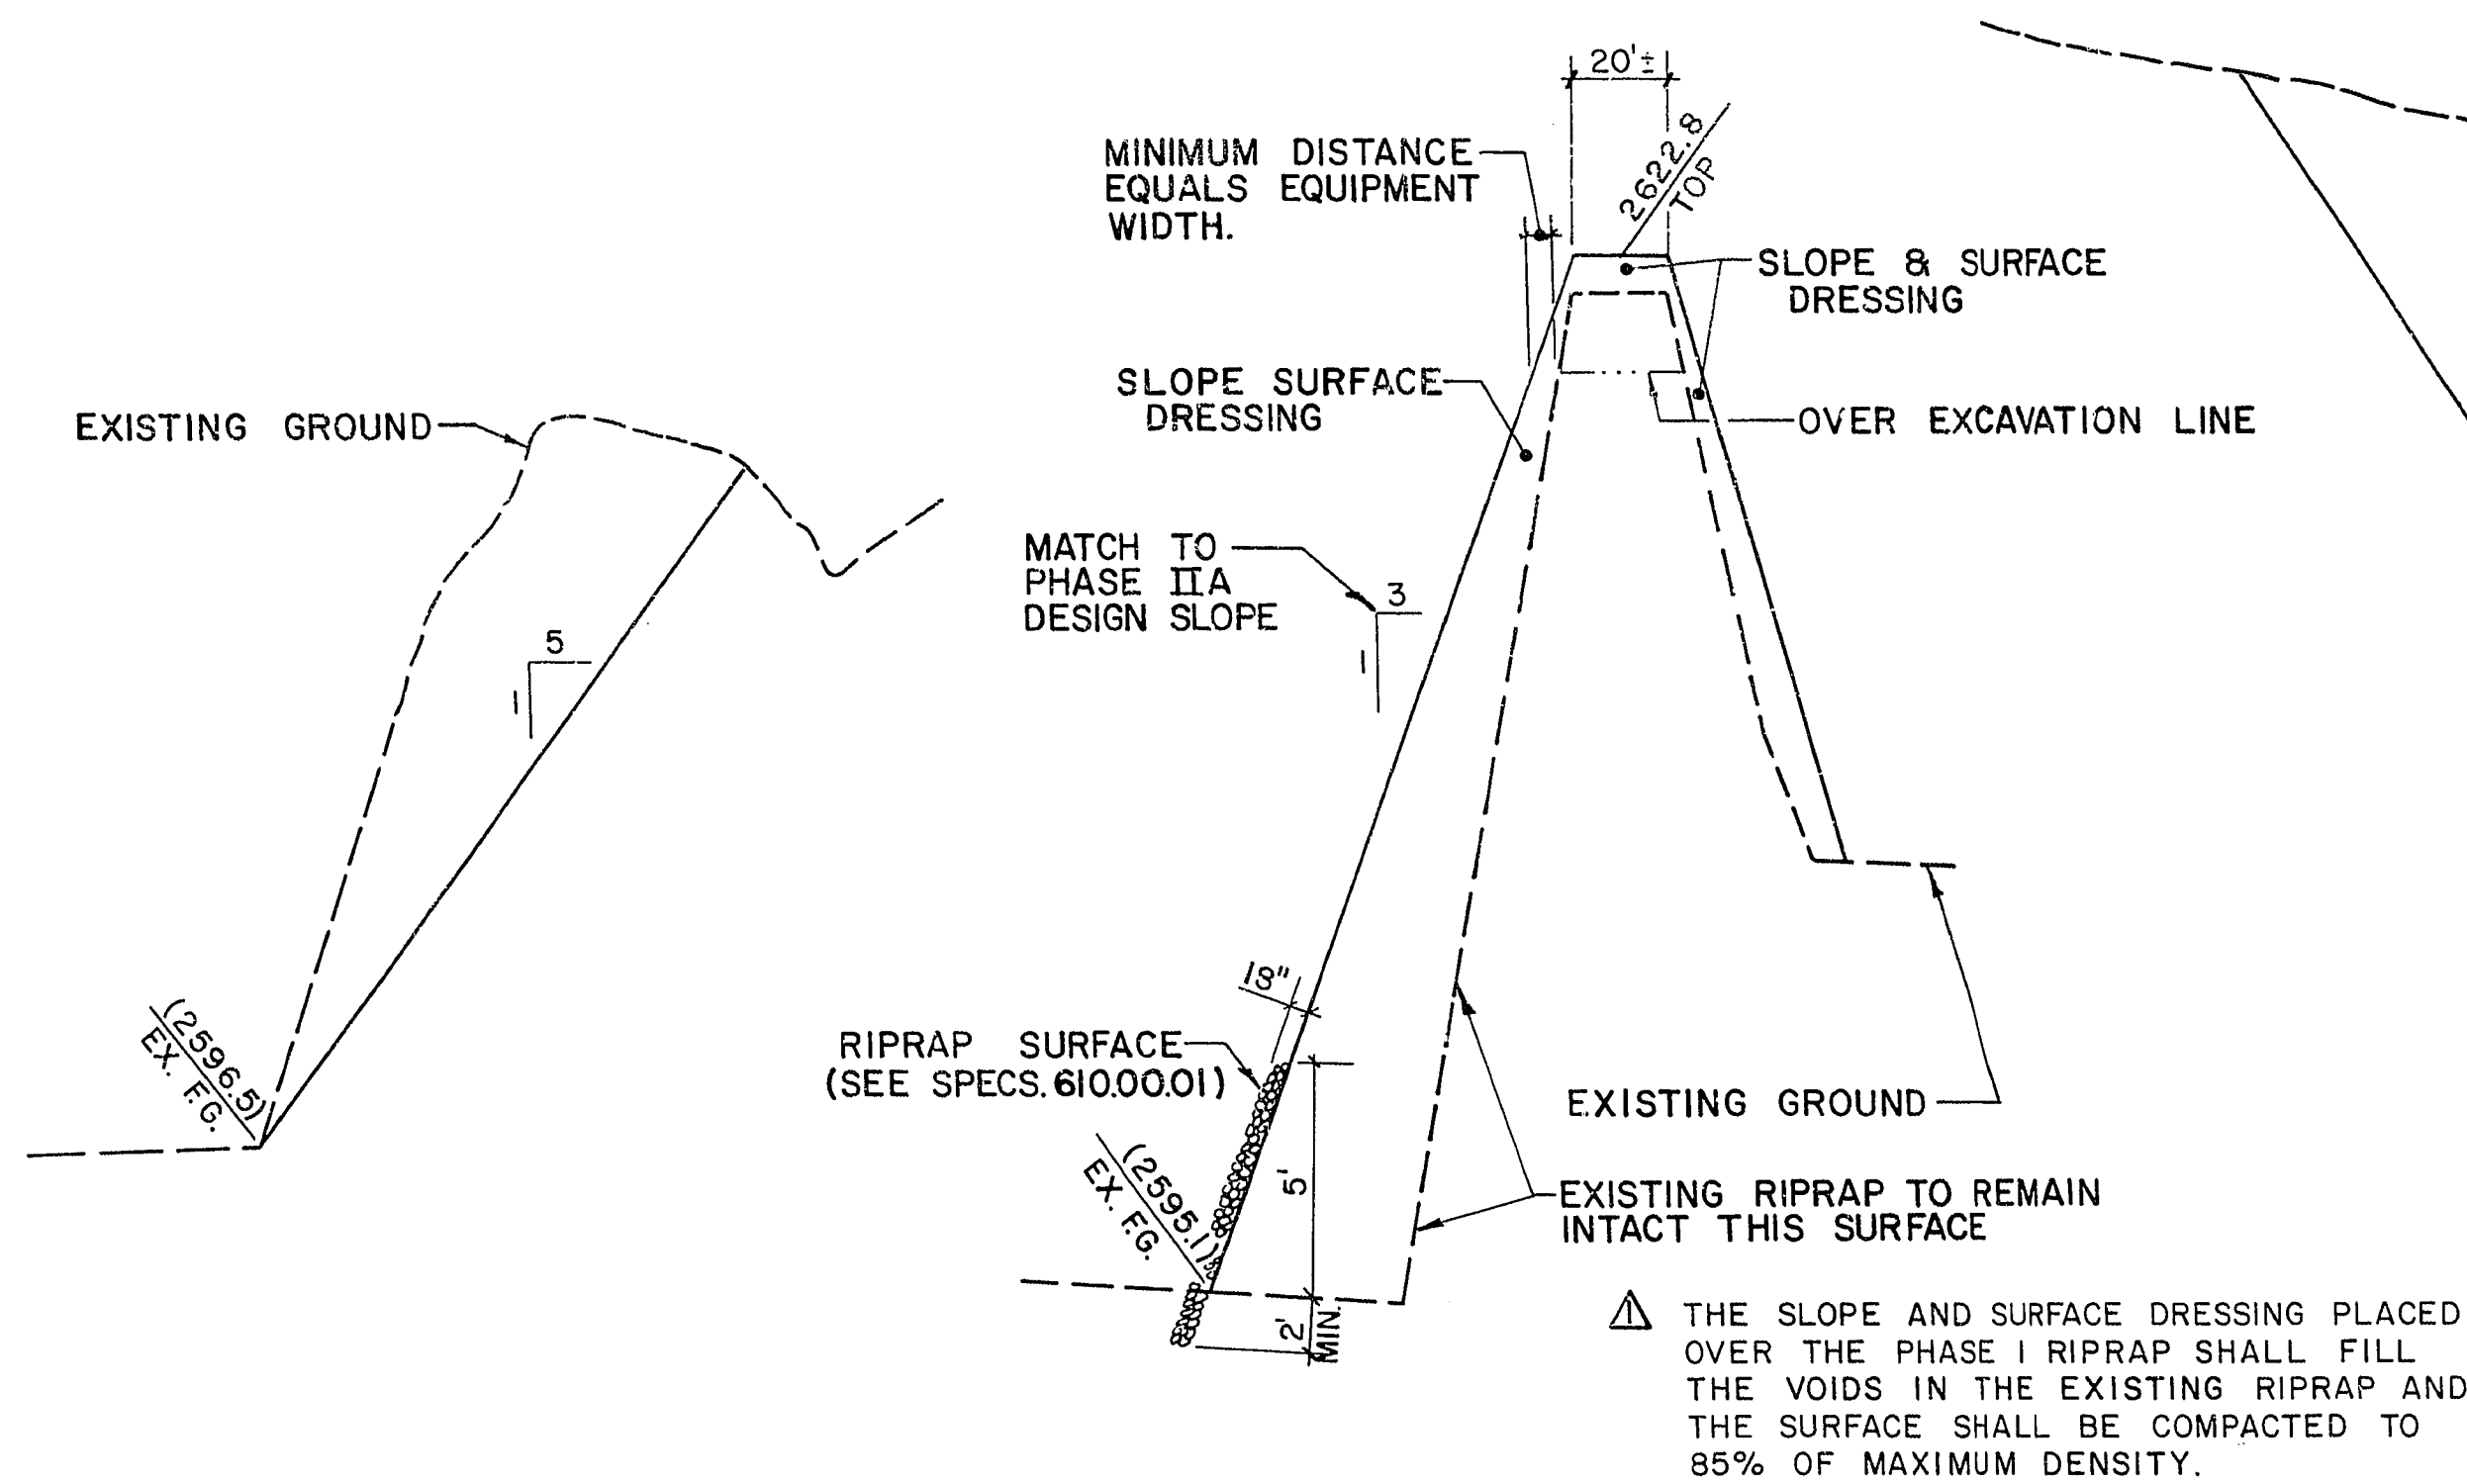

PHASE I SOUTH SLOPE SECTION 4

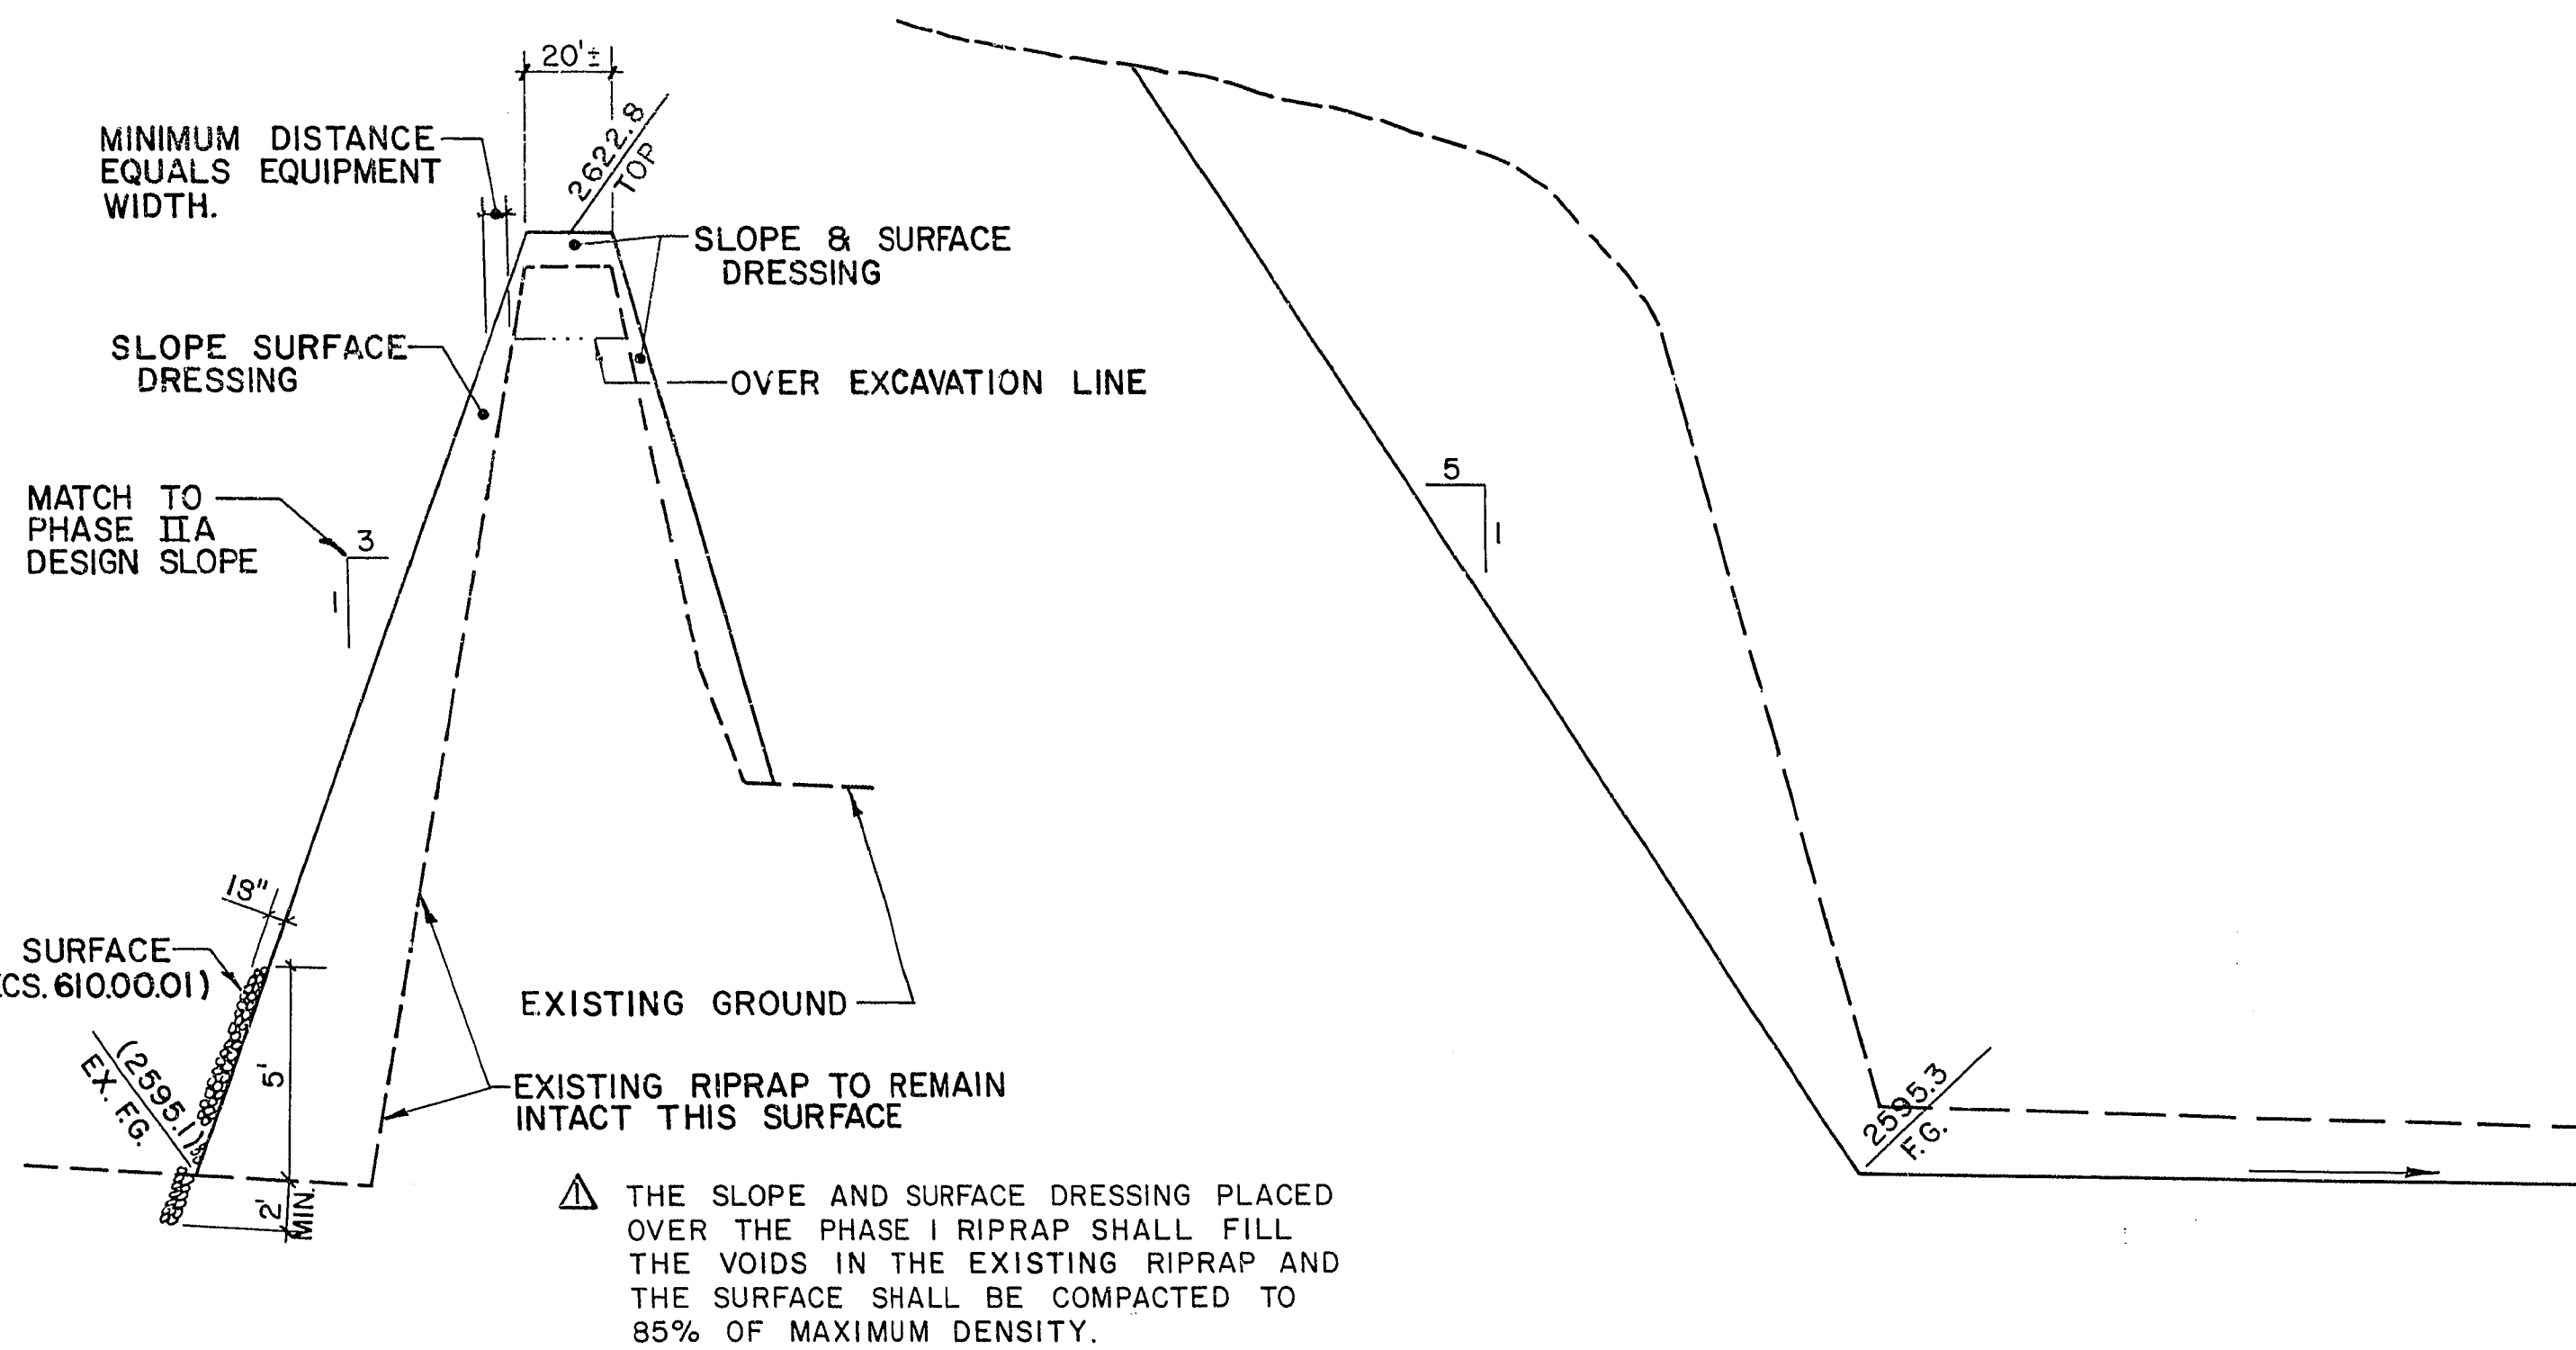

PHASE I BASIN SECTION 5

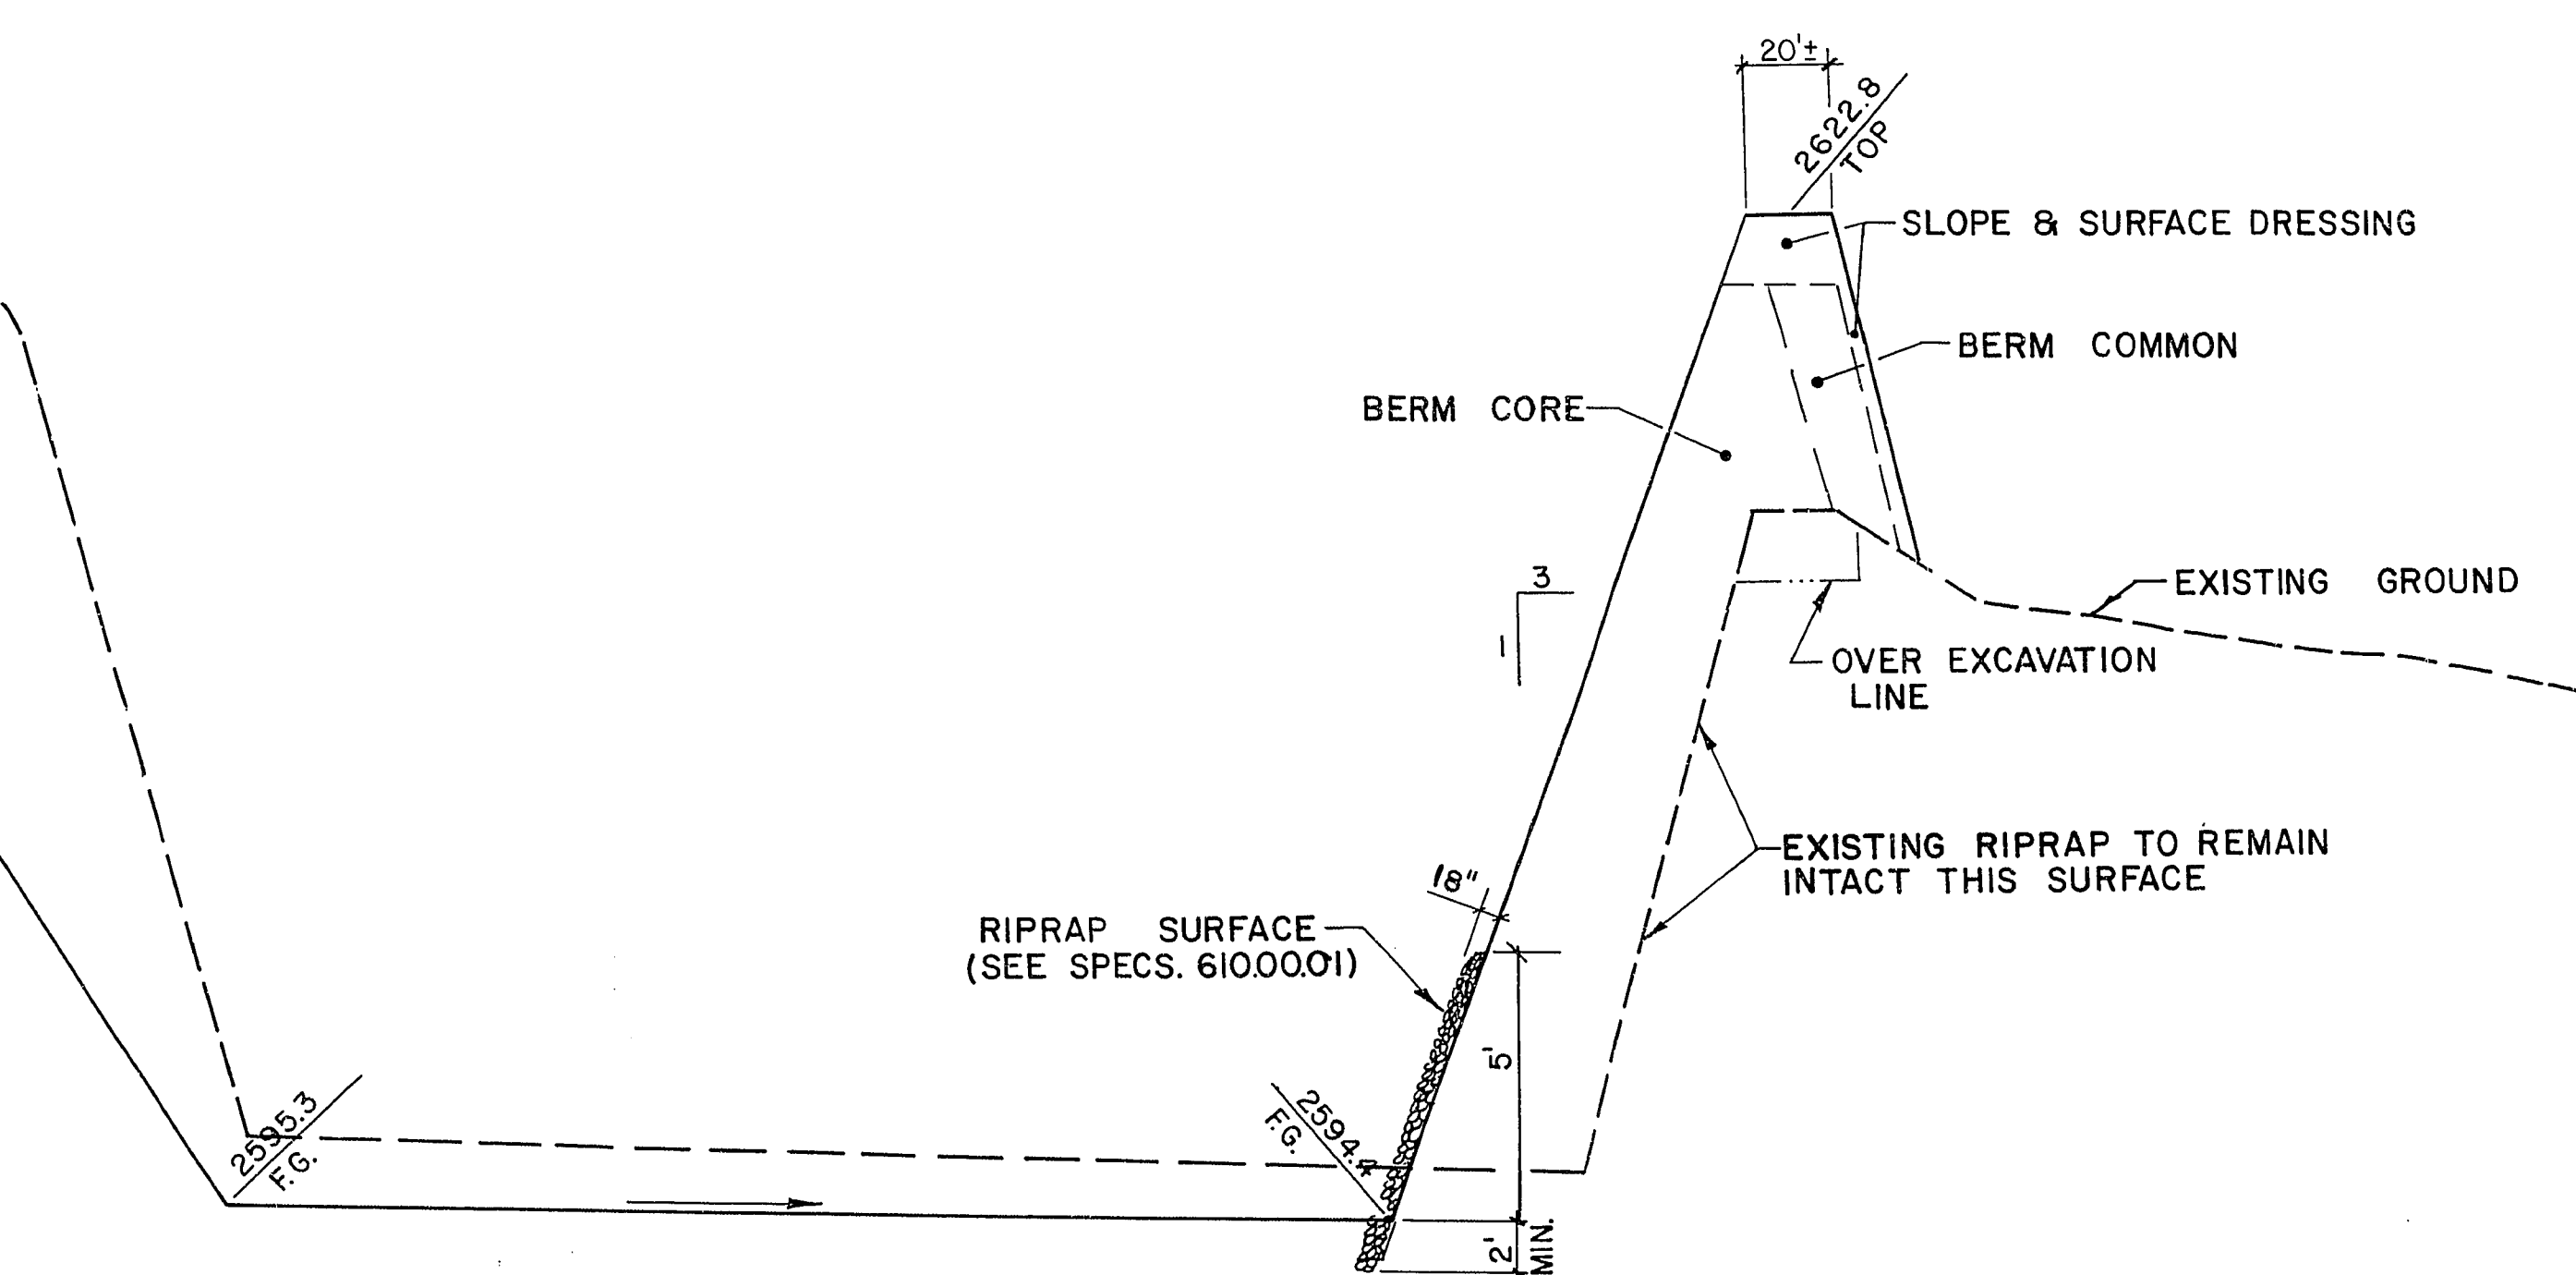

PHASE I BASIN SECTION 6

**NOTE:**  
SEE THE EMBANKMENT AND EXCAVATION SECTIONS OF THE SPECIFICATIONS FOR THE DIMENSIONS, THE LIMITATIONS AND CLARIFICATION OF OVER EXCAVATION, SLOPE & SURFACE DRESSING, BERM CORE, BERM COMMON, CANYON COMMON, STRUCTURAL FILL AND ROADWAY EMBANKMENT.

**AS BUILT**  
11/15/84

|          |    |         |                               |
|----------|----|---------|-------------------------------|
| REVISION | BY | DATE    | ADDED NOTE PER ADDENDUM NO. 1 |
| 1        | MW | 1/24/84 |                               |

CONSULTING ENGINEERS & PLANNERS  
BUILDING 4 SUITE B  
2800 WEST SAHARA AVENUE  
LAS VEGAS, NEVADA 89102 PHONE (702) 873-7550

9-13-112

**PHASE I BASIN SECTIONS**

ANGEL PARK DETENTION BASIN  
PHASE IIA

WO NO. 3061  
BY RPF/MJB  
DATE 10/2/83  
SCALE HOR. 1"=40'  
VERT. 1"=5'

SHEET 11  
OF 36 SHEETS