




NOTE:
SEE THE EMBANKMENT AND EXCAVATION SECTIONS OF THE SPECIFICATIONS FOR THE DIMENSIONS, THE LIMITATIONS AND CLARIFICATION OF OVER EXCAVATION, SLOPE & SURFACE DRESSING, BERM CORE, BERM COMMON, CANYON COMMON, STRUCTURAL FILL AND ROADWAY EMBANKMENT.

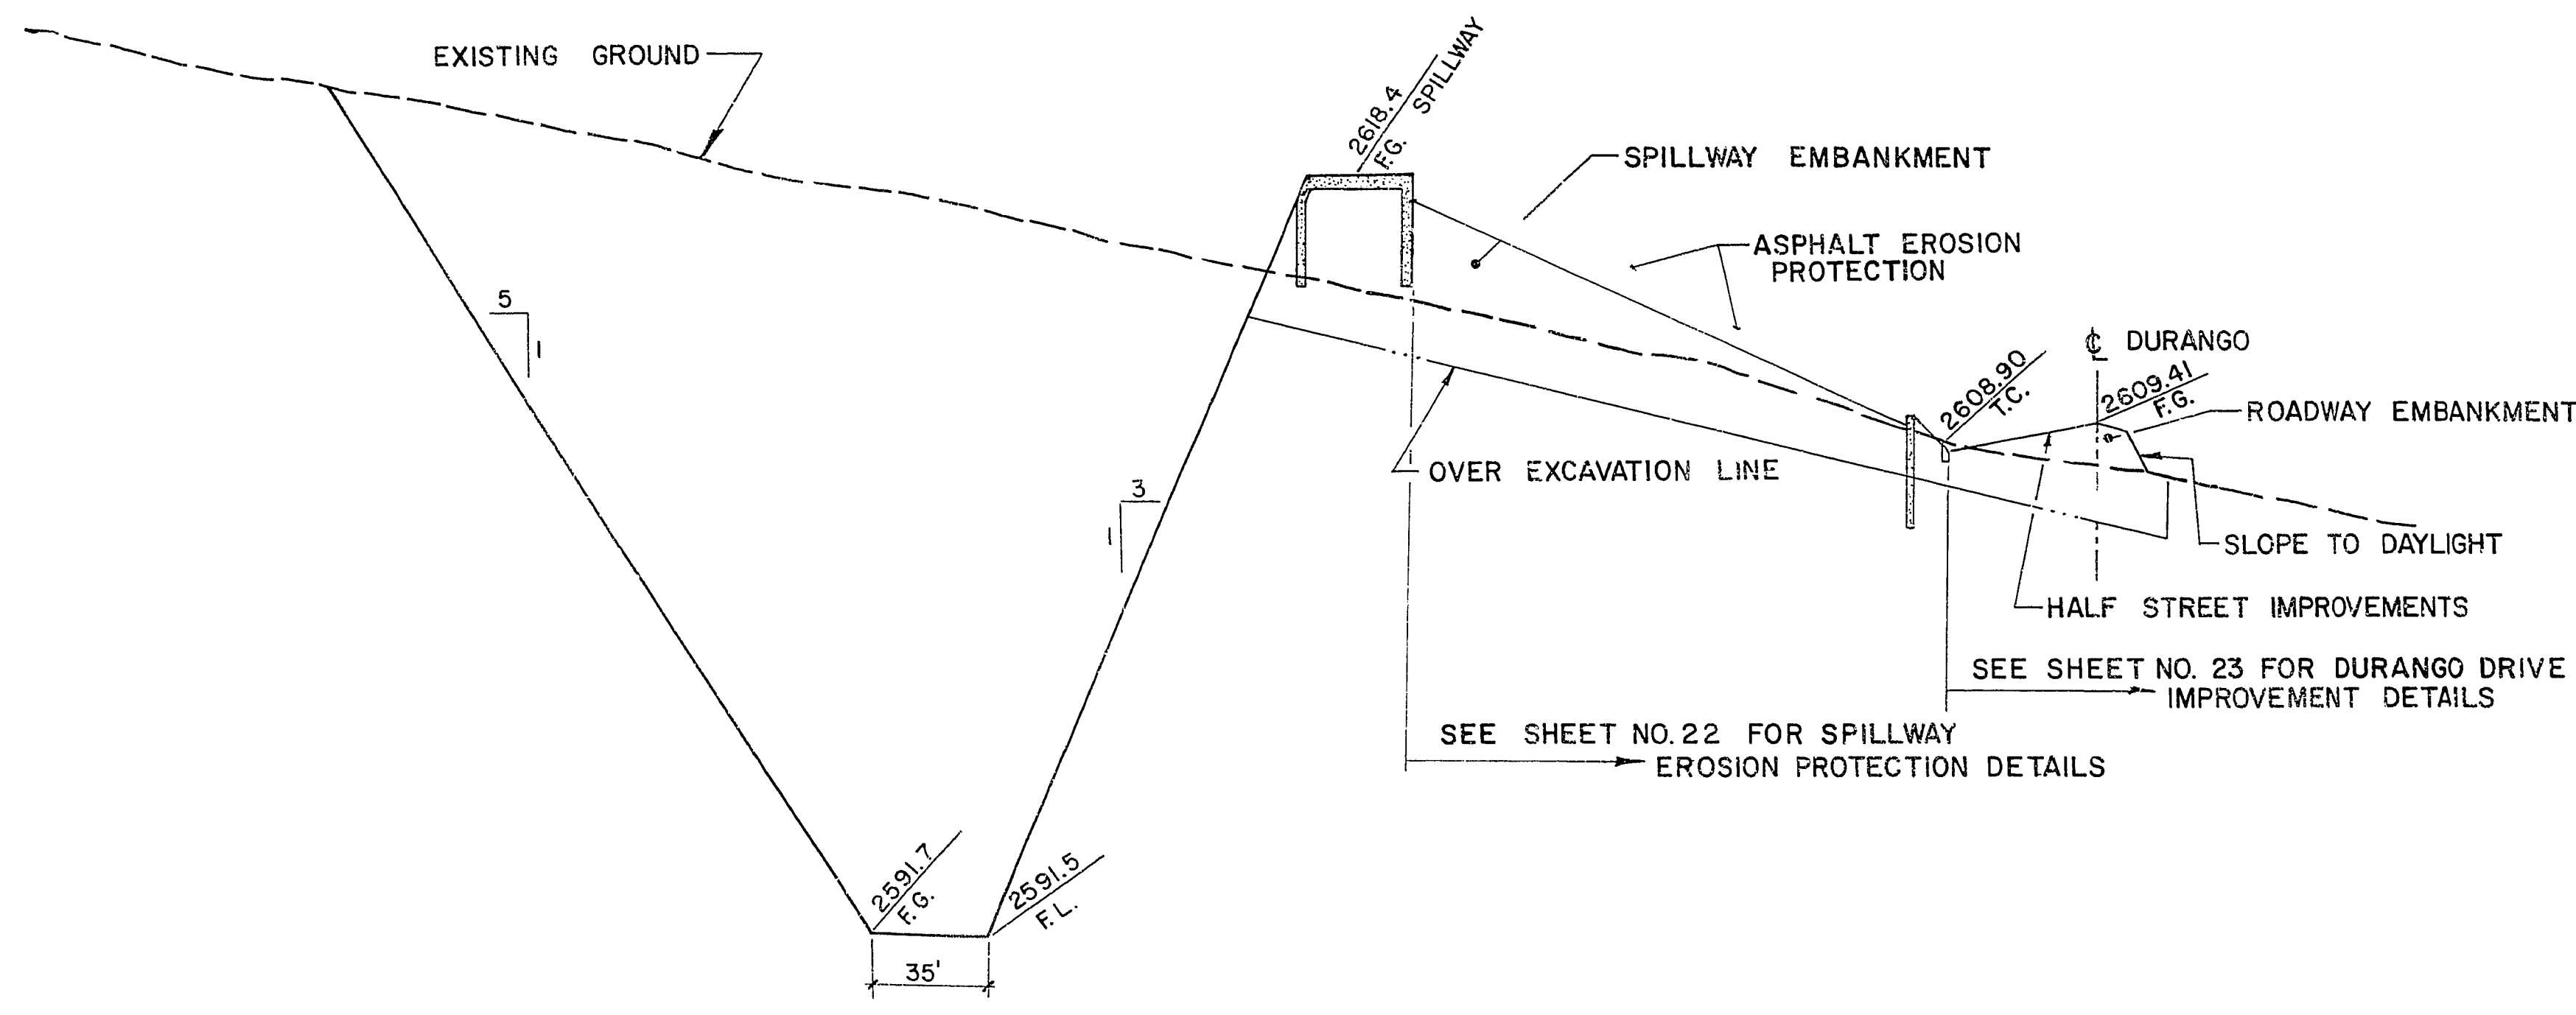


PHASE IIA SPILLWAY SECTION 7
12

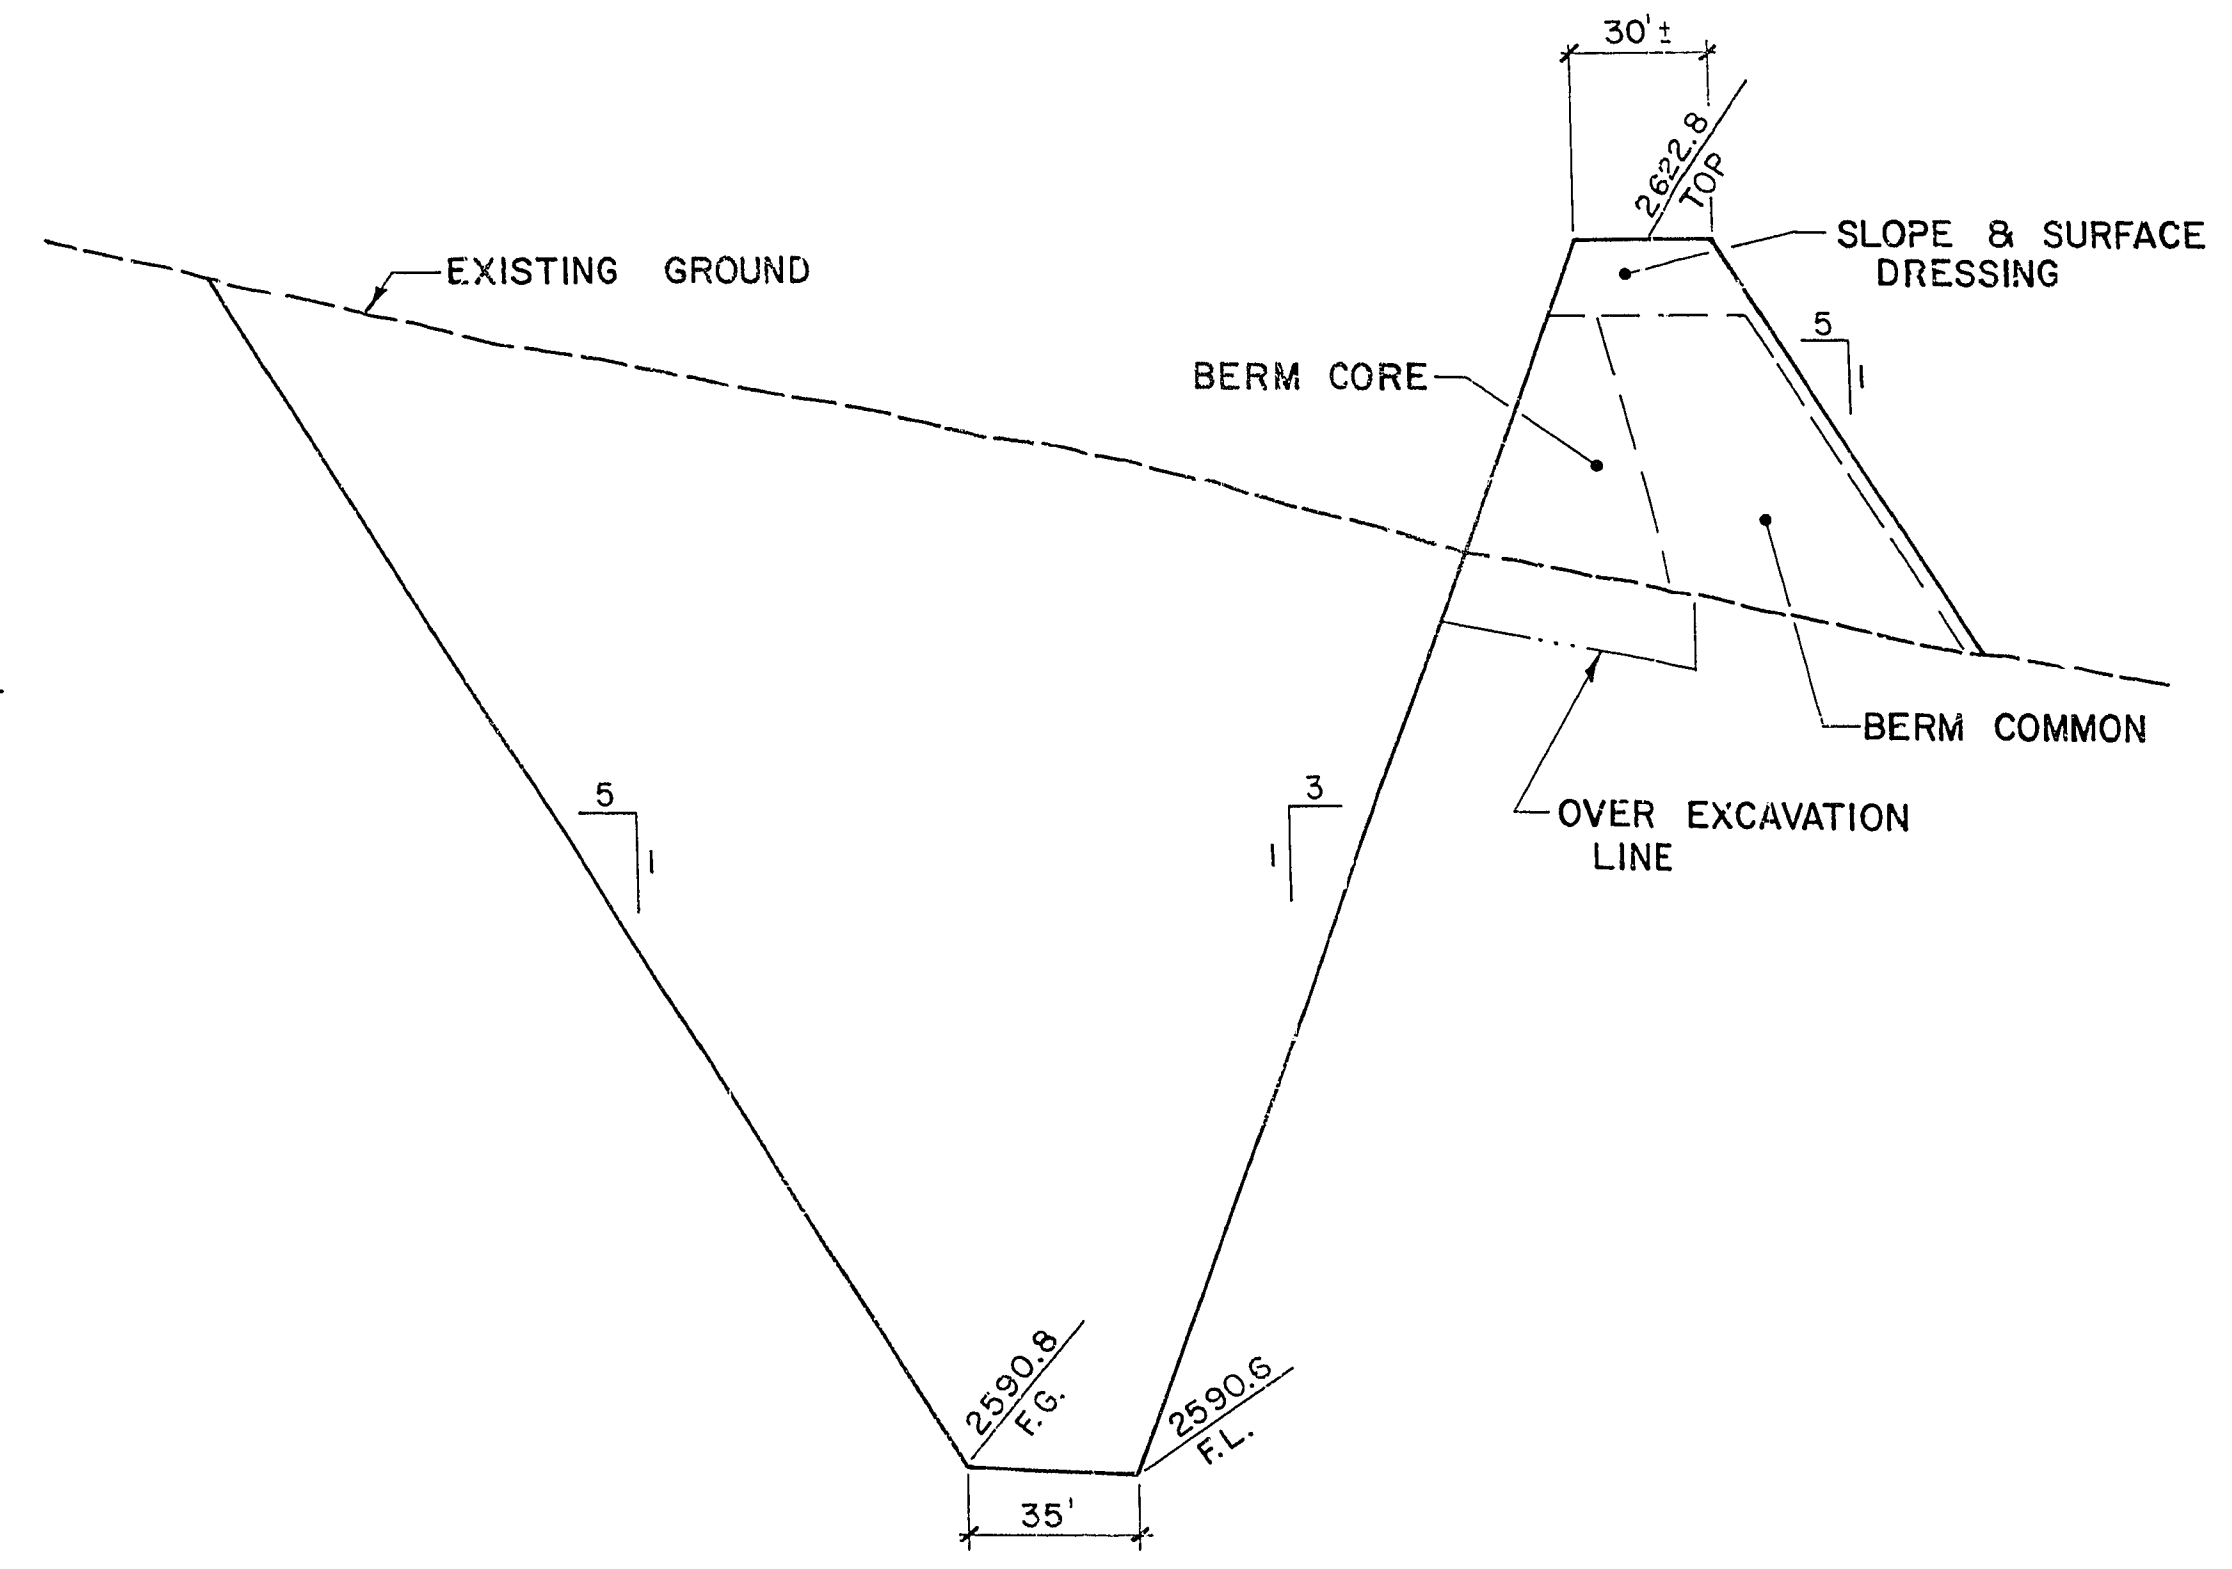

PHASE IIA BASIN SECTION 8
12

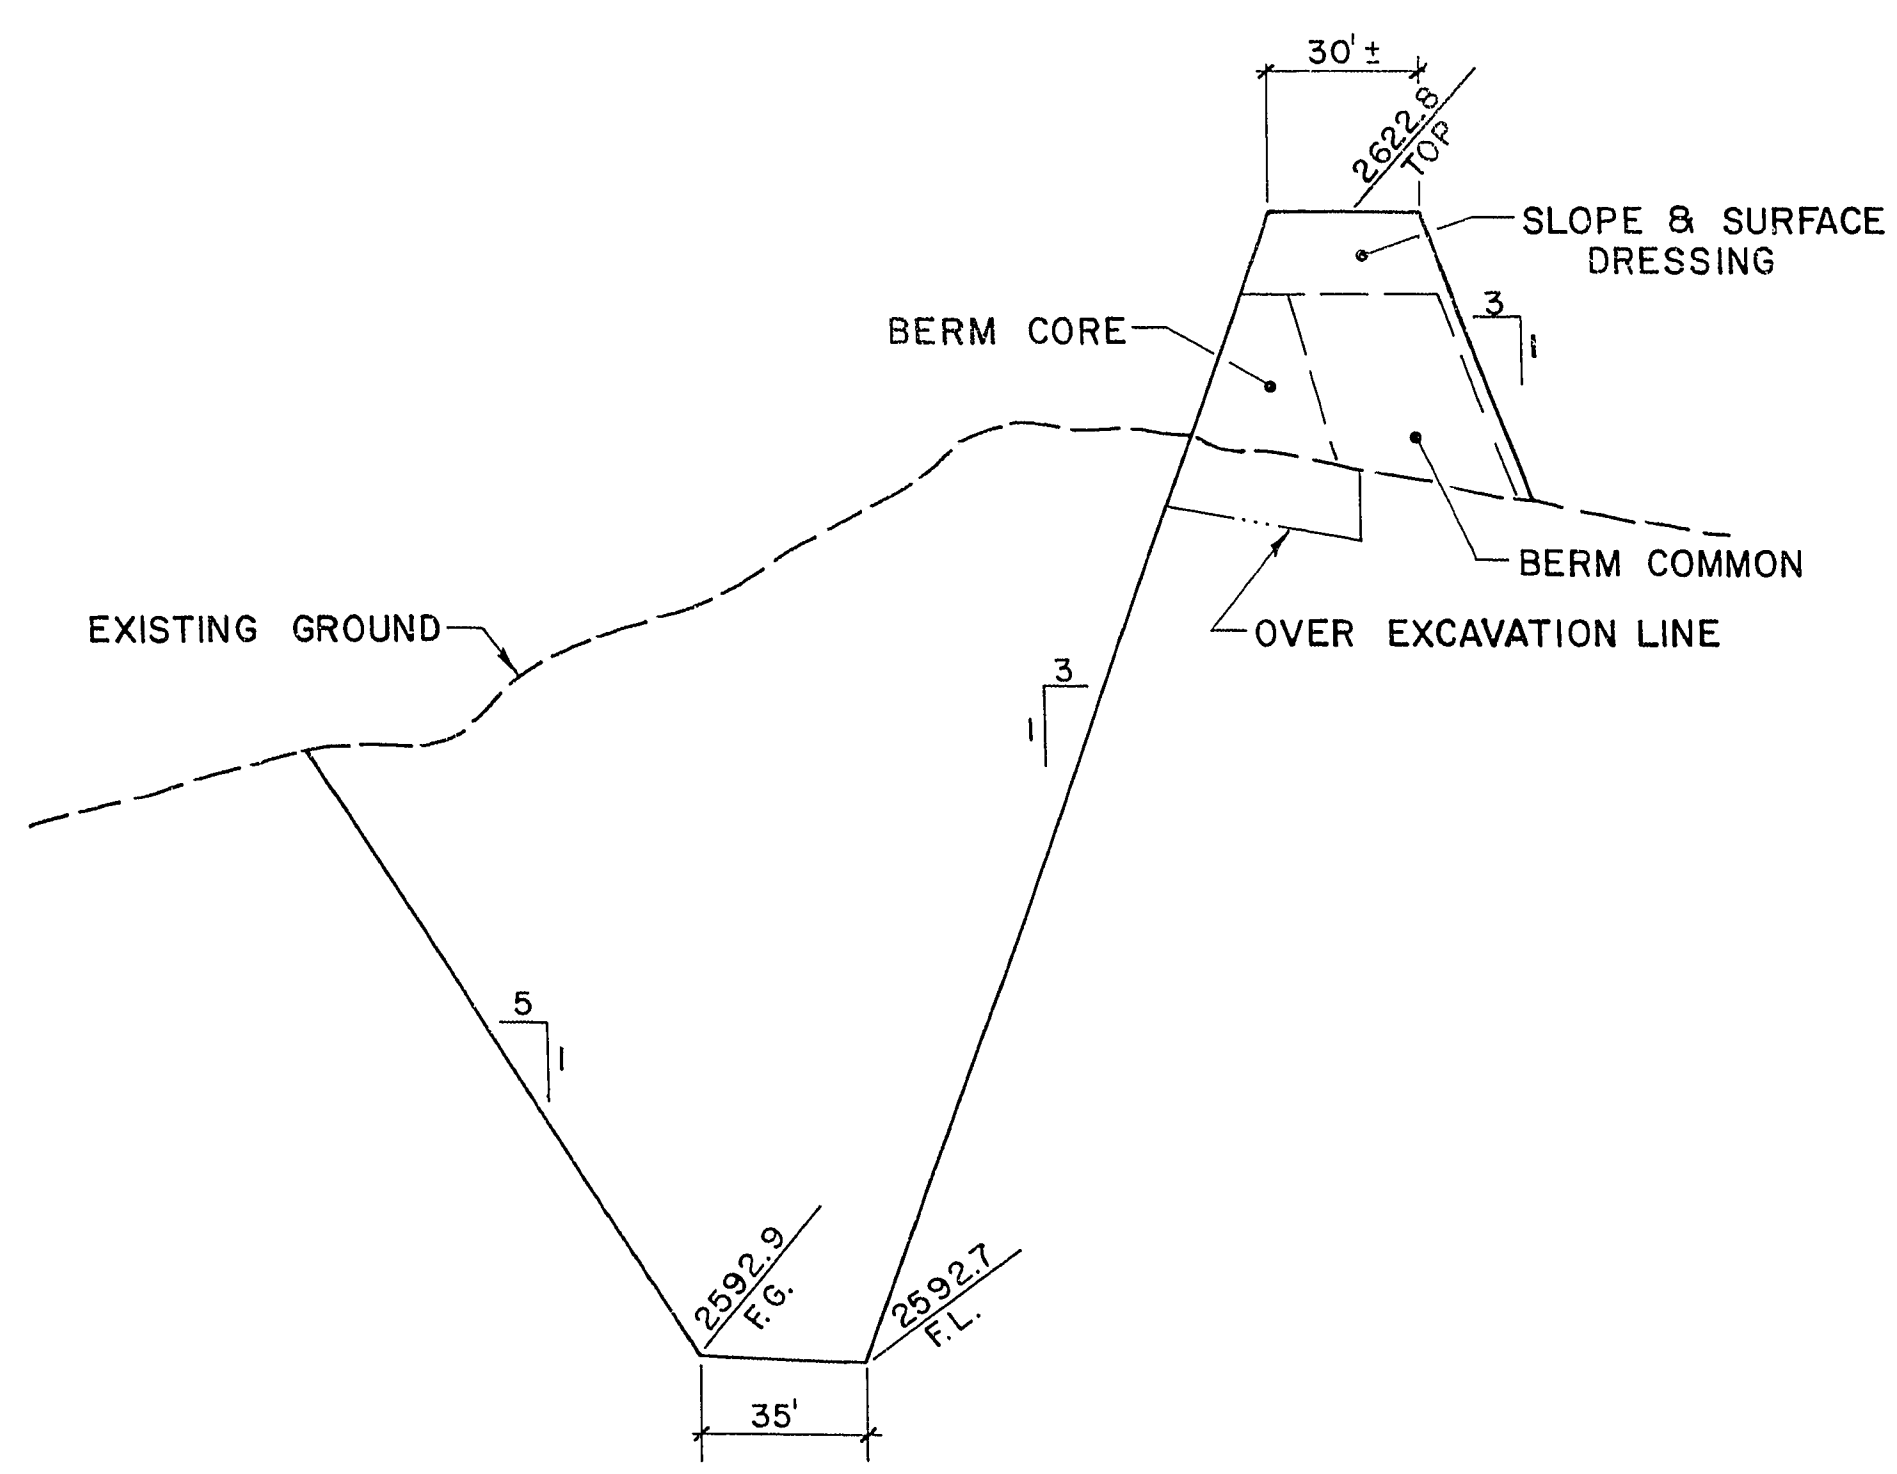

PHASE IIA BASIN SECTION 9
12

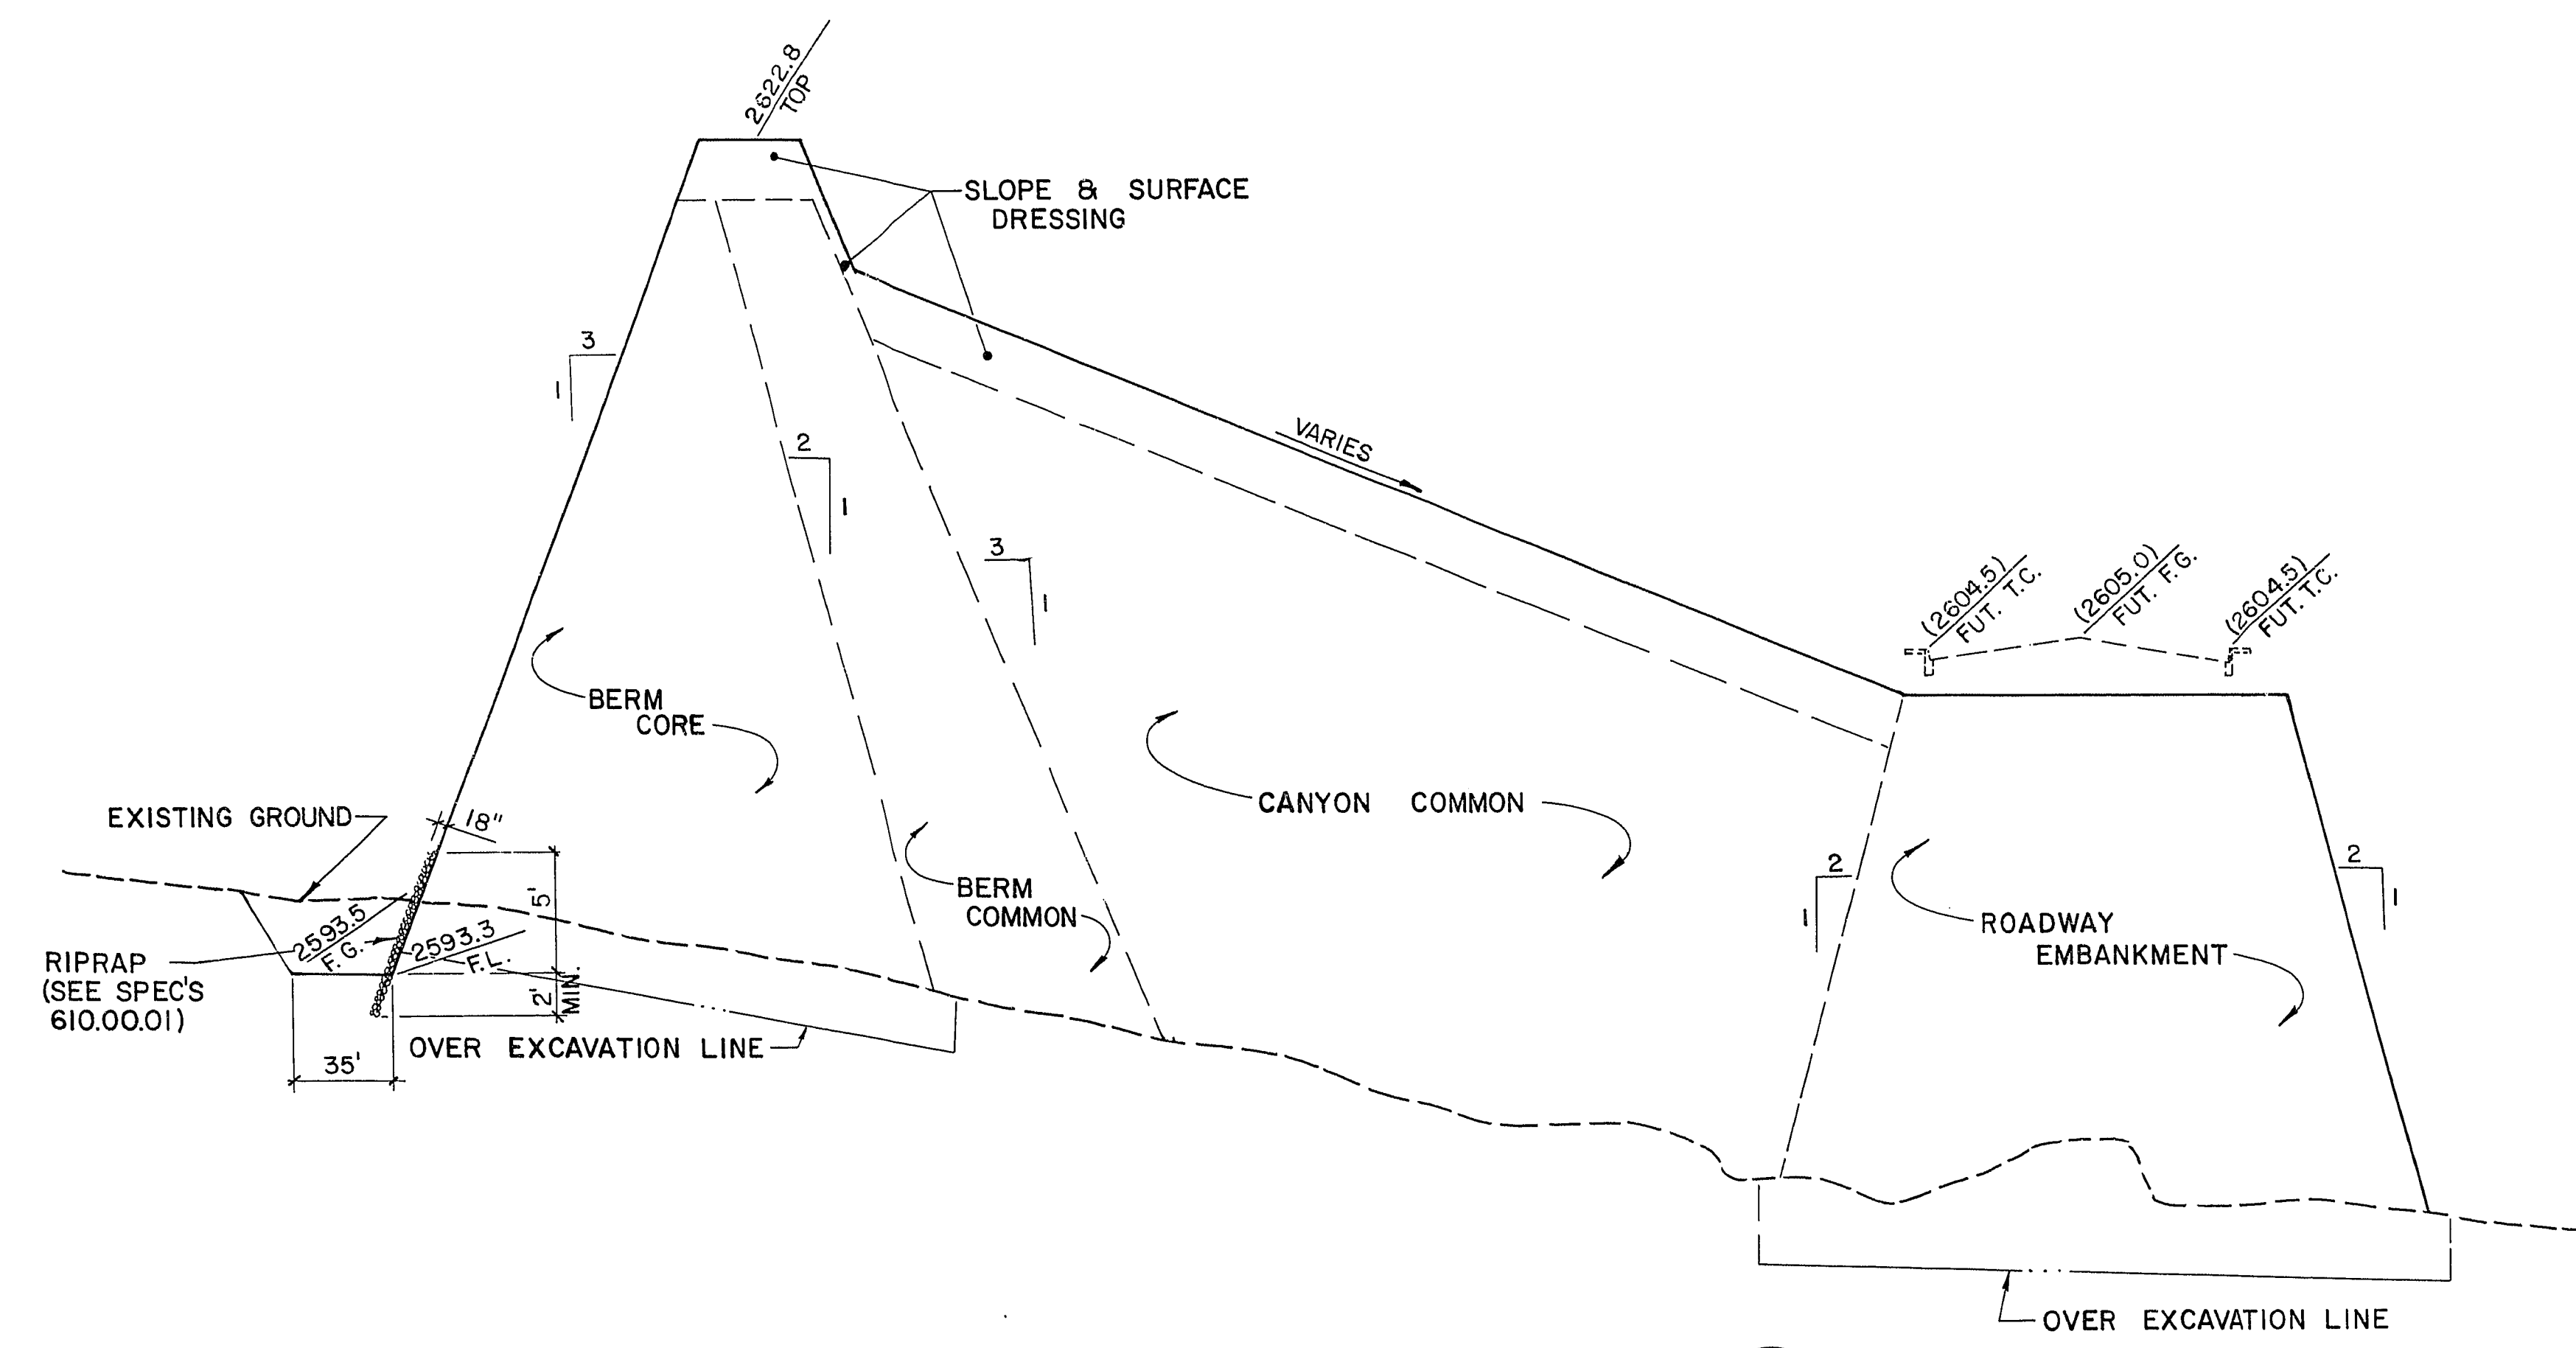

CANYON 5 SECTION 10
12

AS BUILT
11/15/84

PHASE IIA BASIN SECTIONS ANGEL PARK DETENTION BASIN PHASE IIA		PLANNERS CONSULTING ENGINEERS • BUILDING 4 SUITE B 2800 WEST SAHARA AVENUE LAS VEGAS, NEVADA 89102 PHONE (702) 873-7550
TITLE PROJECT	REVISION BY DATE REV	SPILLWAY EMBANKMENT CHENCH SEC 7-12 10/4/83 RPF 11/2/83 EDY 1 2
WO NO. 3061 BY RPF/MJB DATE 10/2/83 SCALE HOR. 1" = 40' VERT. 1" = 5'		
12 OF 36 SHEETS		