




9-13-15

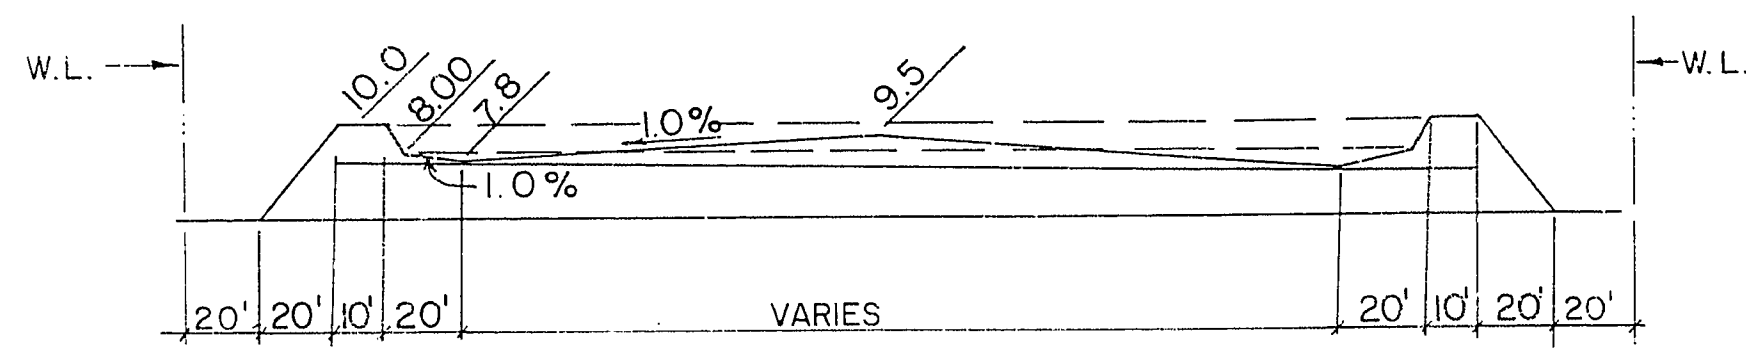

SECTION A-A TYPICAL
NO SCALE

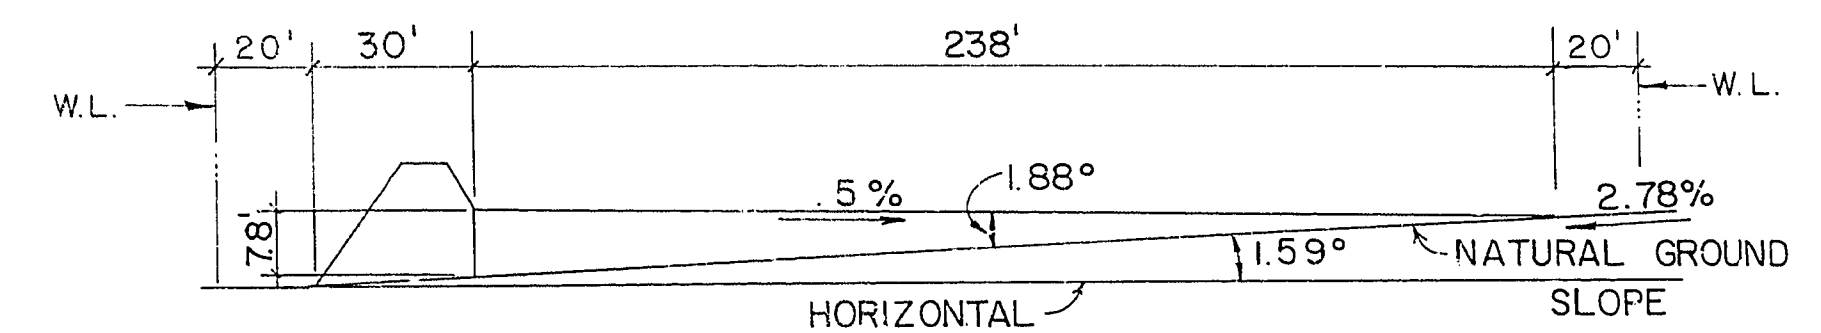

SECTION B-B TYPICAL
NO SCALE

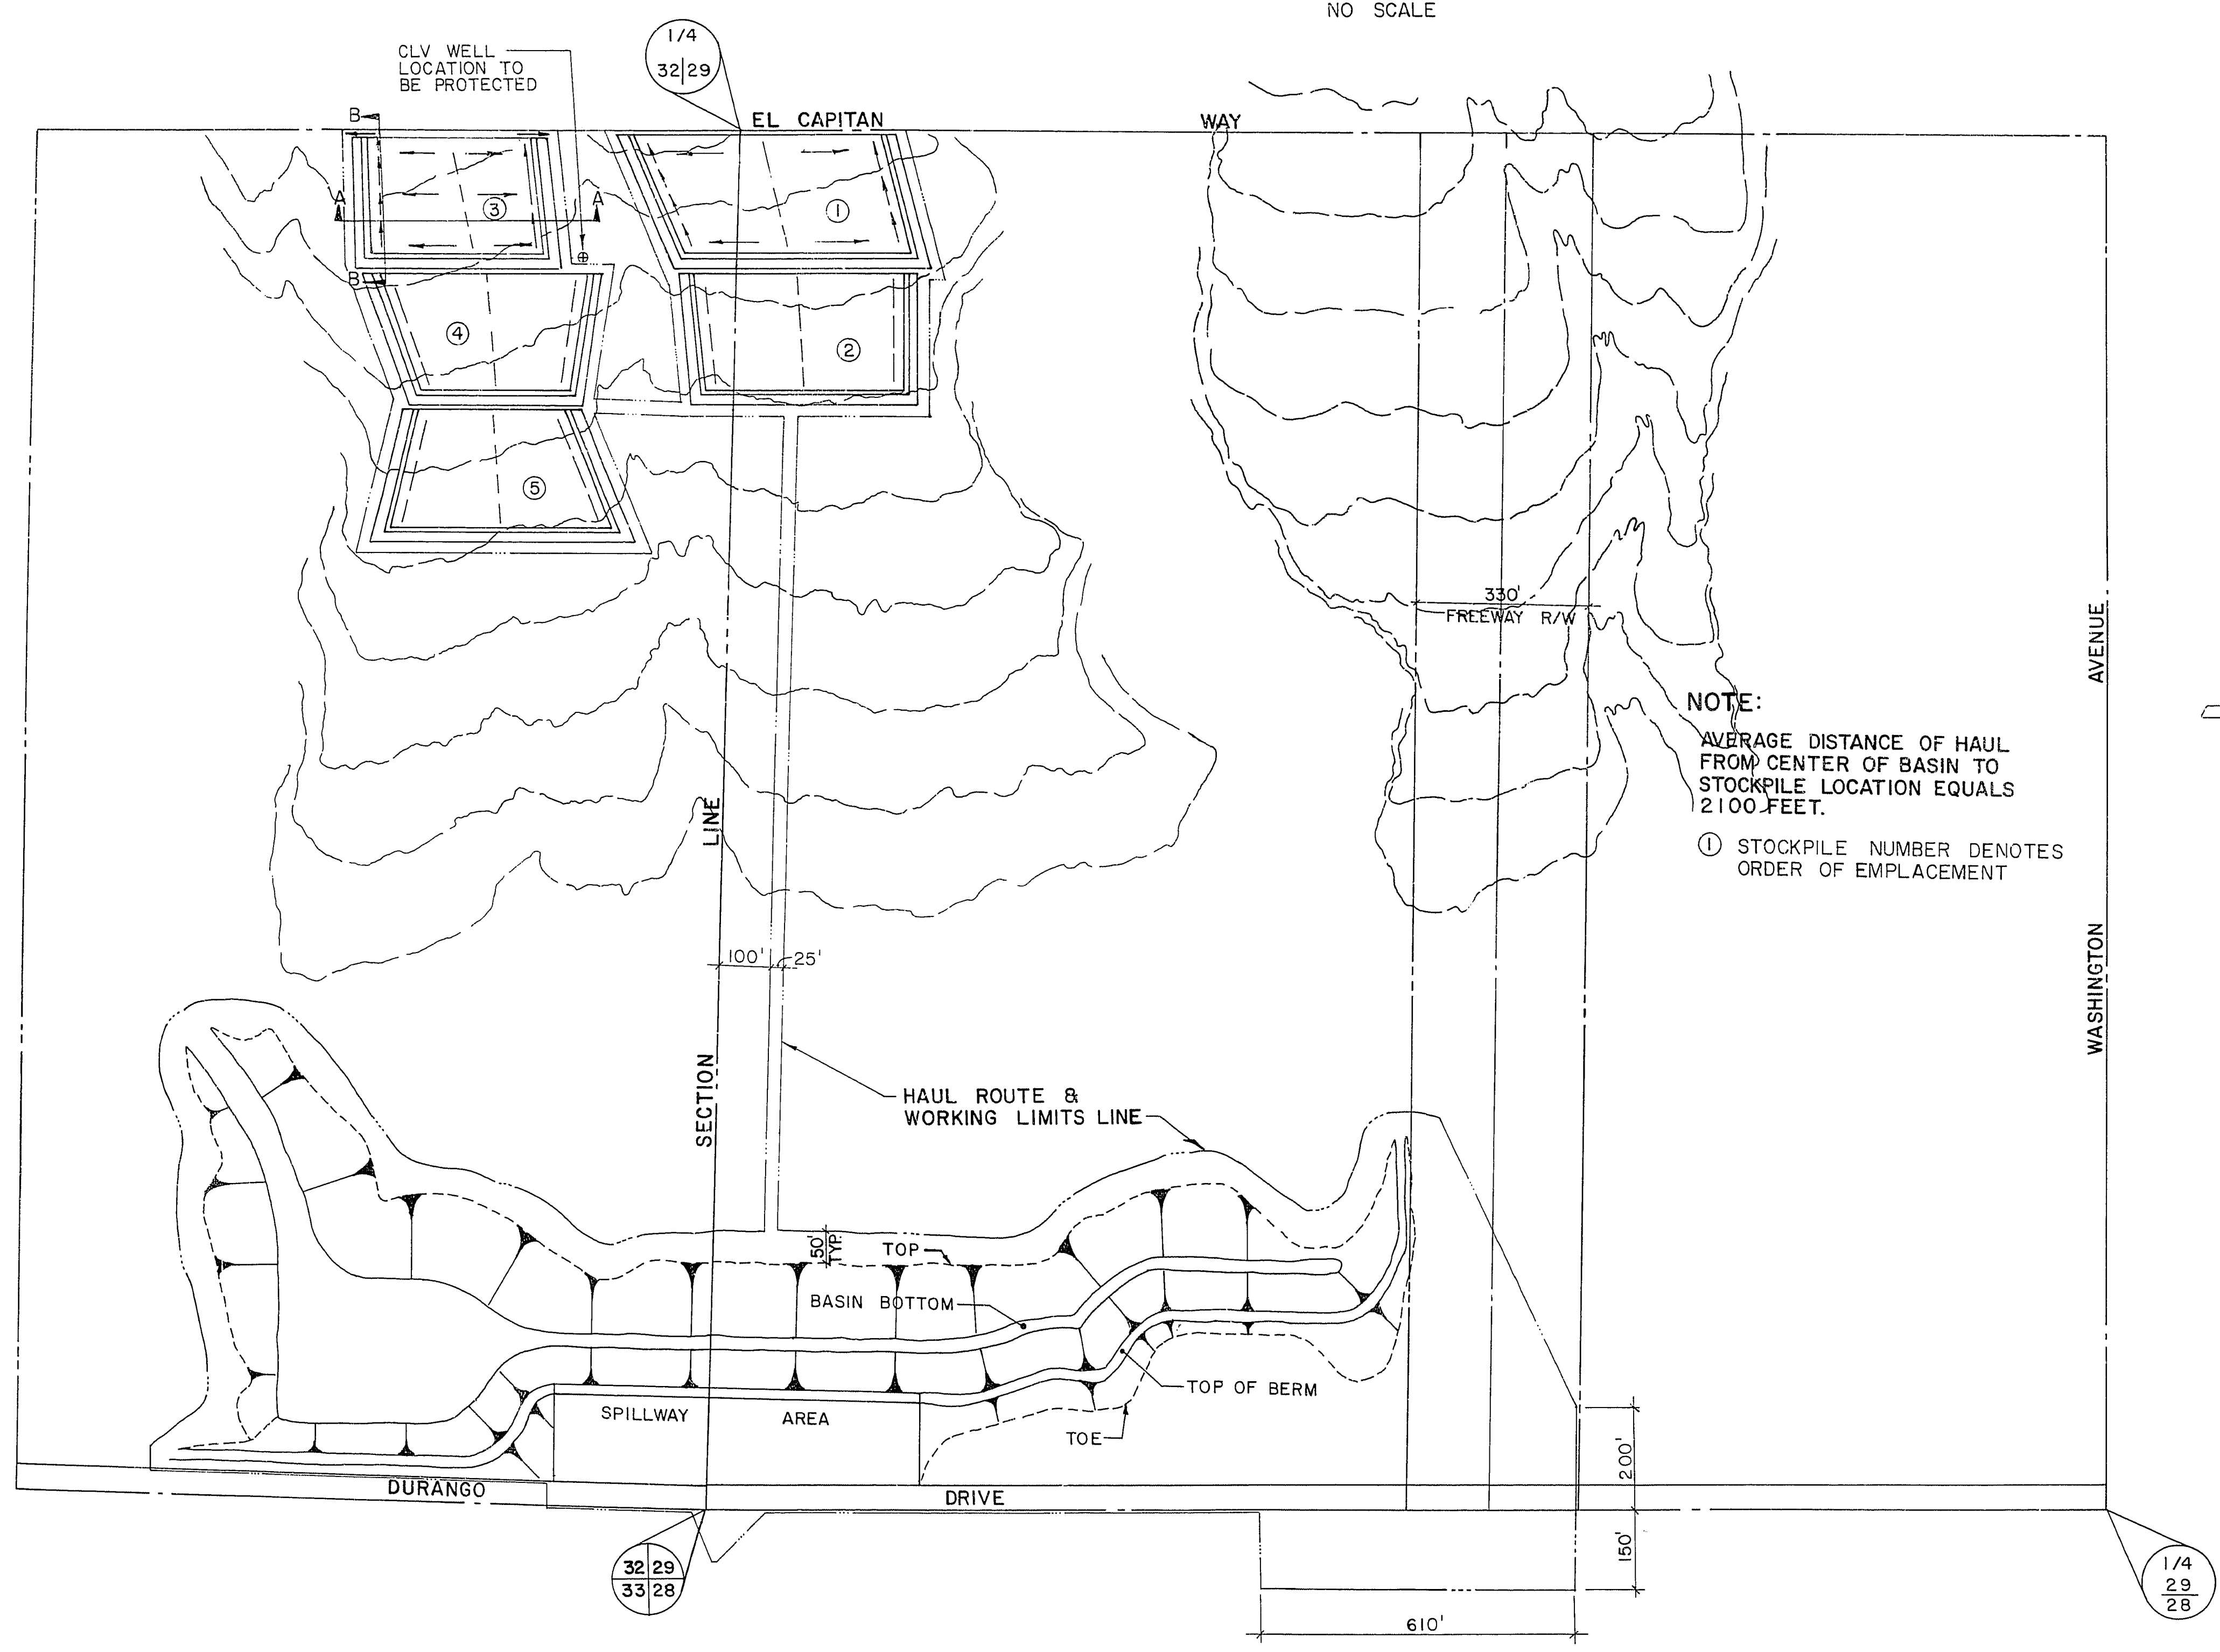

REV	DATE	BY	ADD	NOTE
1	10/3/83	RPF	CHANGE STOCKPILE LOCATIONS	
2	11/20/83	RPF	ADDED SECTIONS A-A & B-B	
3	10/31/83	EDY		

CONSULTING ENGINEERS • PLANNERS
2800 WEST SAHARA AVENUE BUILDING 4 SUITE B
LAS VEGAS, NEVADA 89102 PHONE (702) 873-7550

VTM nevada

HAUL ROUTE, STOCKPILE LOCATION & WORKING LIMITS

ANGEL PARK DETENTION BASIN
PHASE IIA

WO NO. 3061
BY RPF/MJB
DATE 10/2/83
SCALE 1" = 200'

SHEET 14
OF 36 SHEETS

AS BUILT
11/15/84

650.14-7