



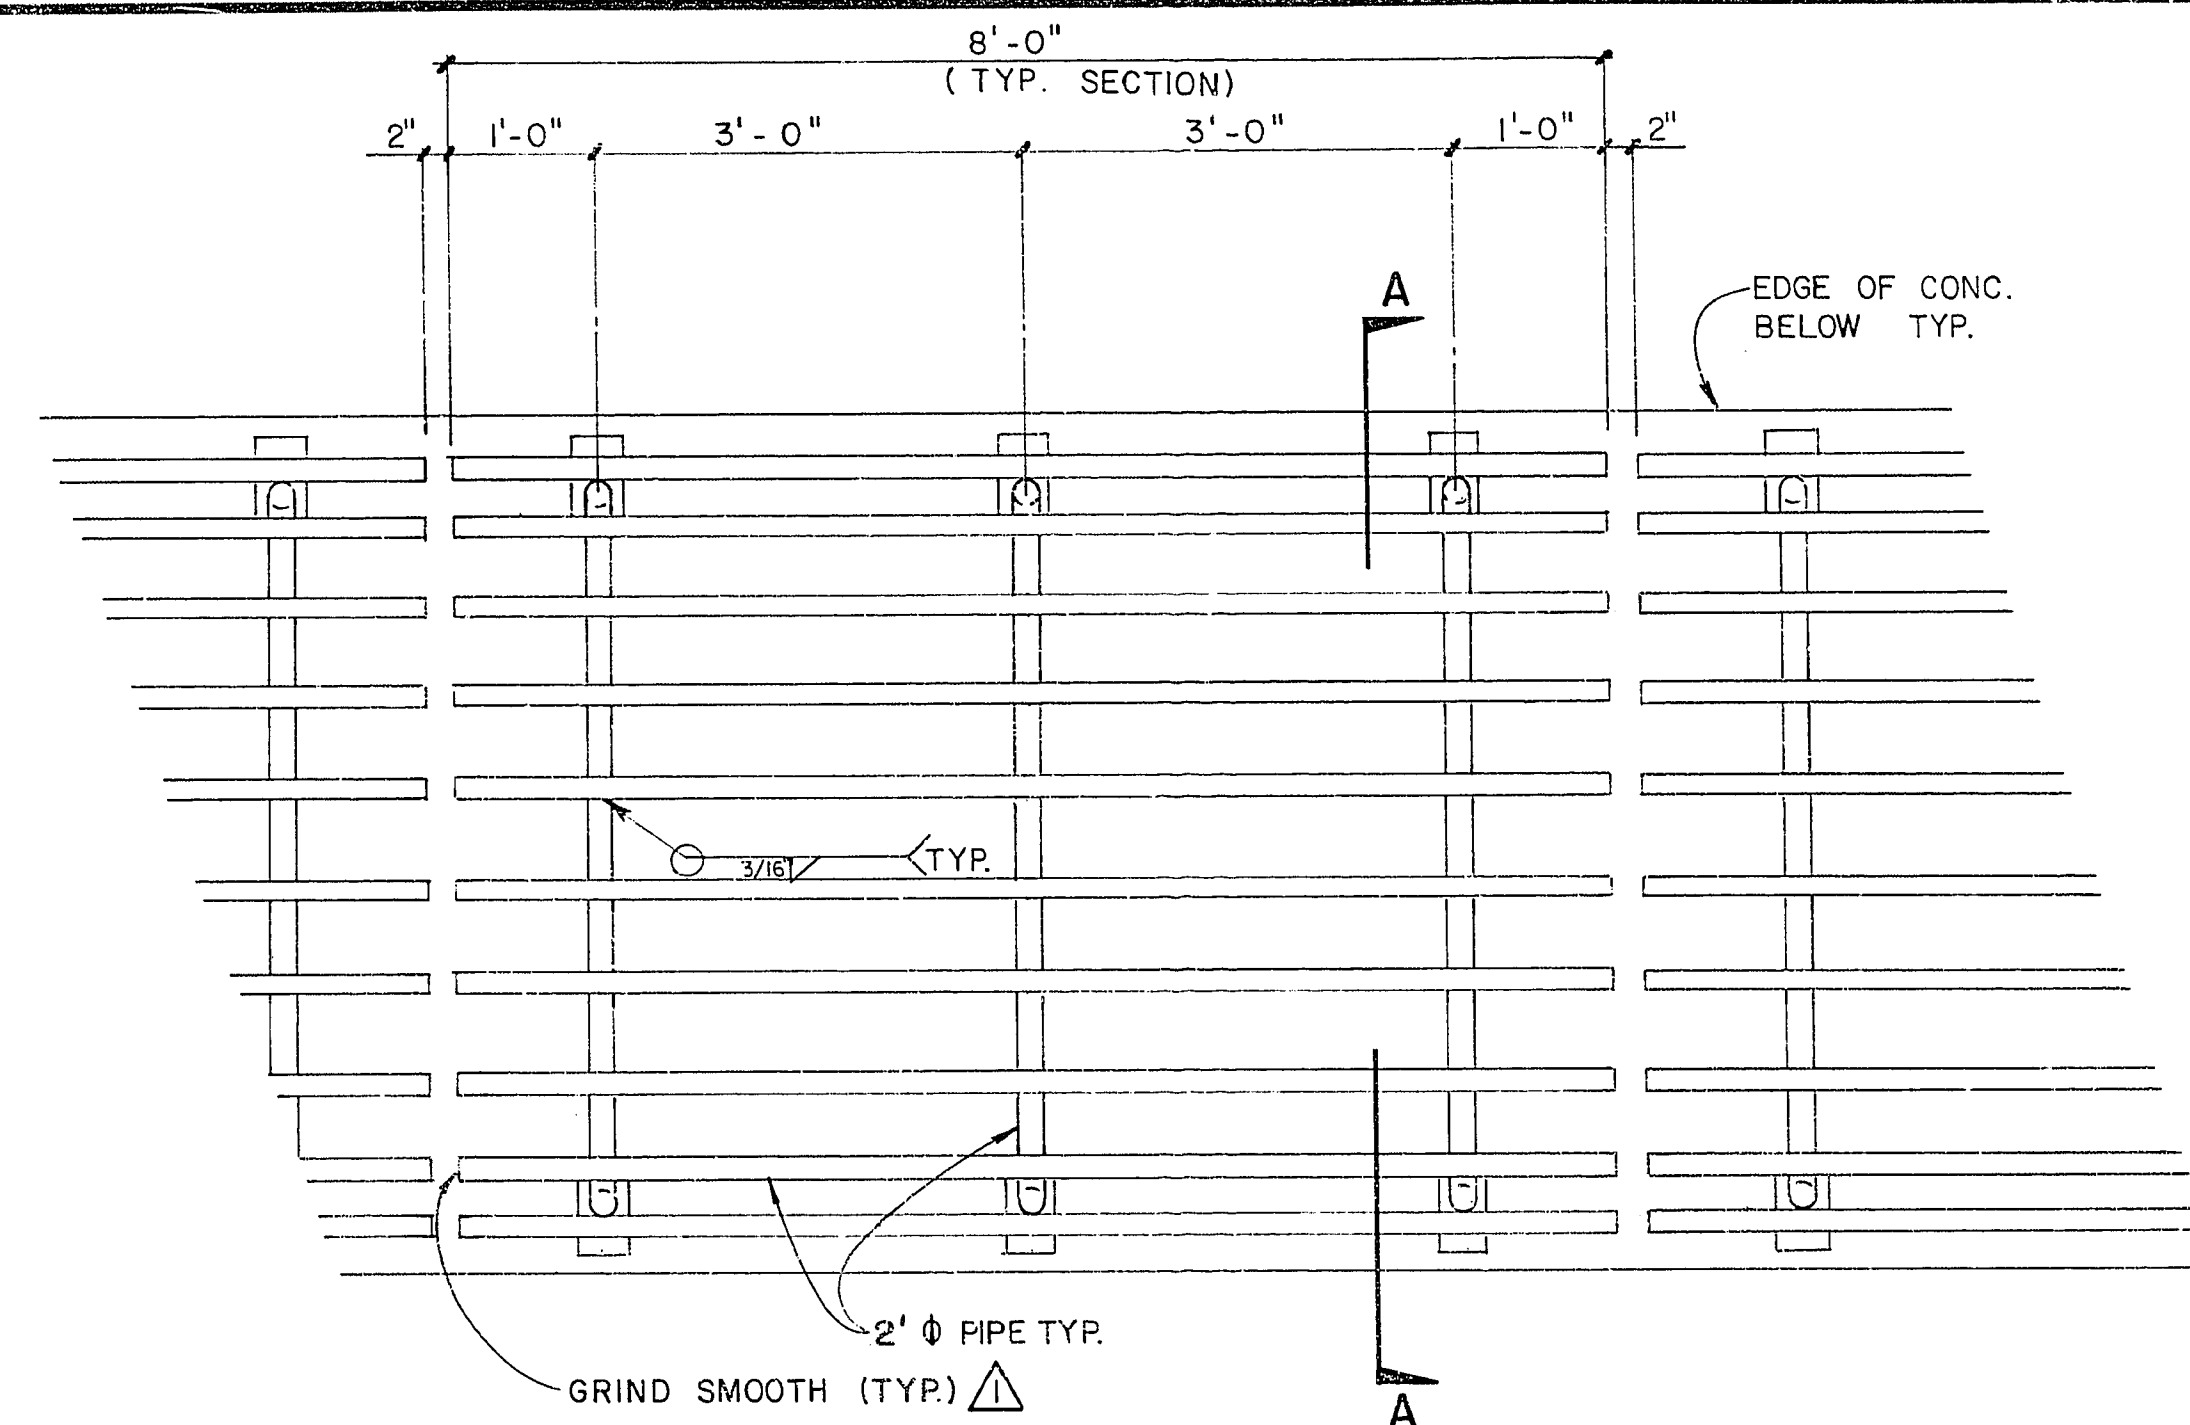


PLAN @ TYPICAL TRASH RACK SECTION

3/4" = 1'-0"

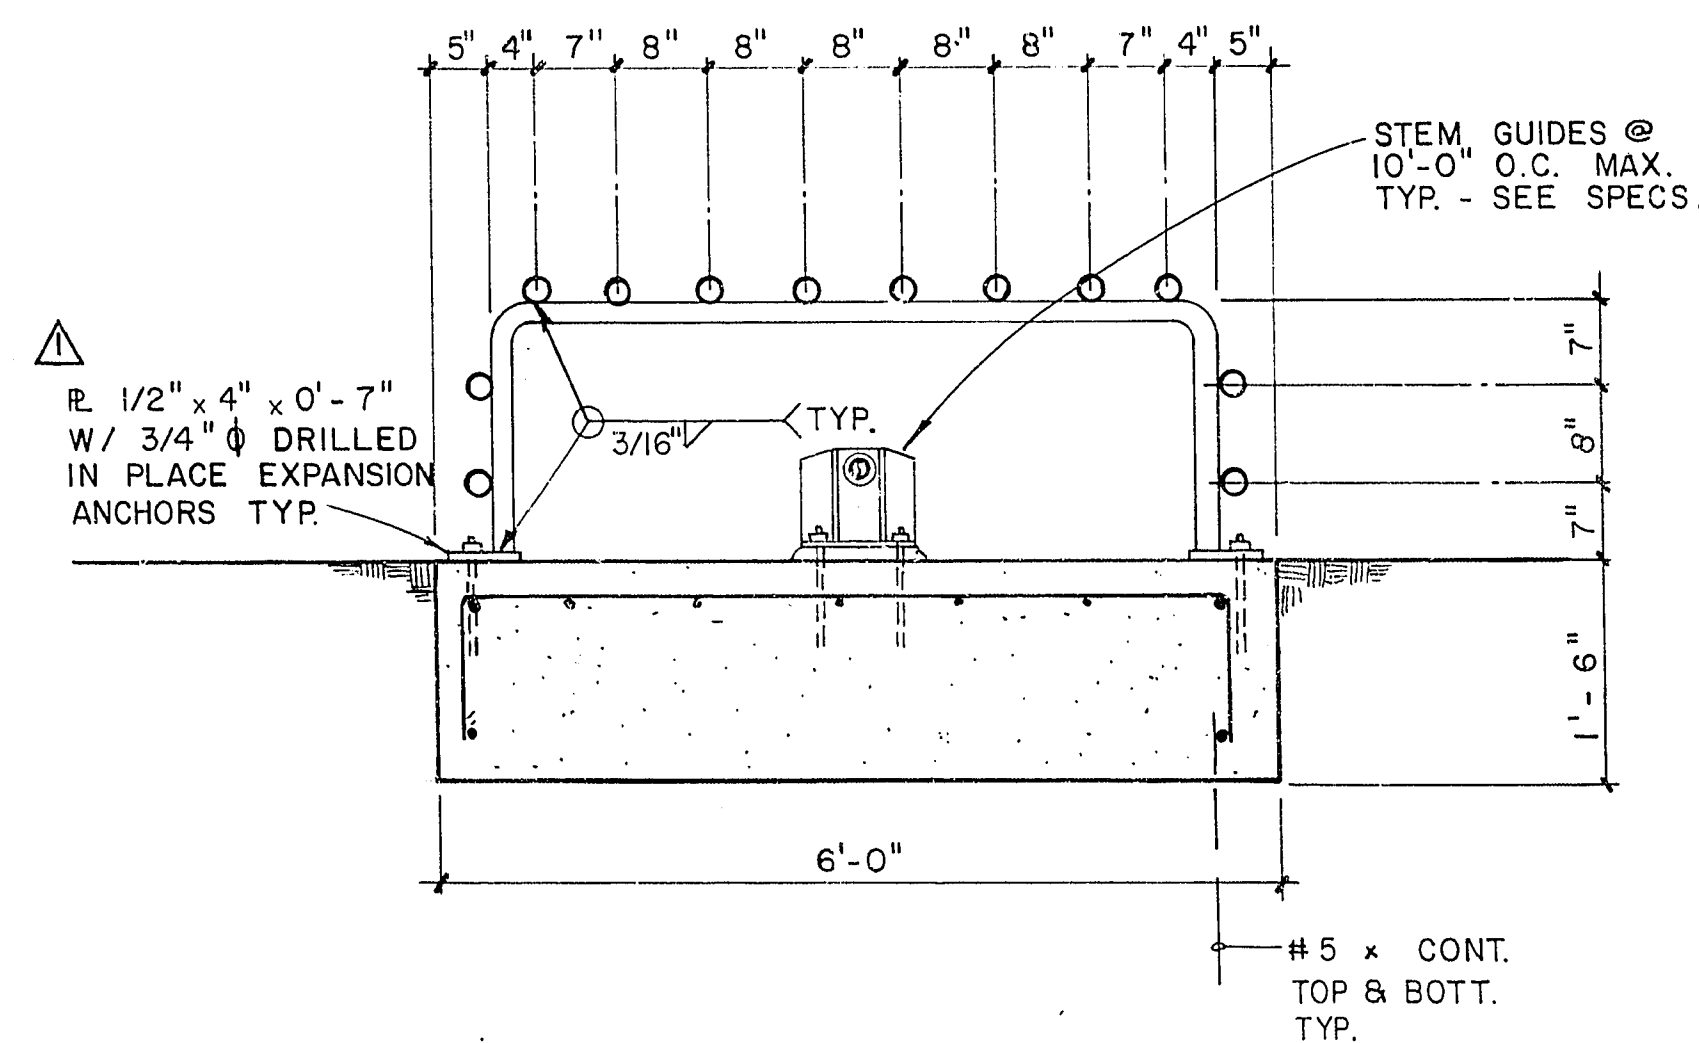


CROSS SECTION A-A

3/4" = 1'-0"

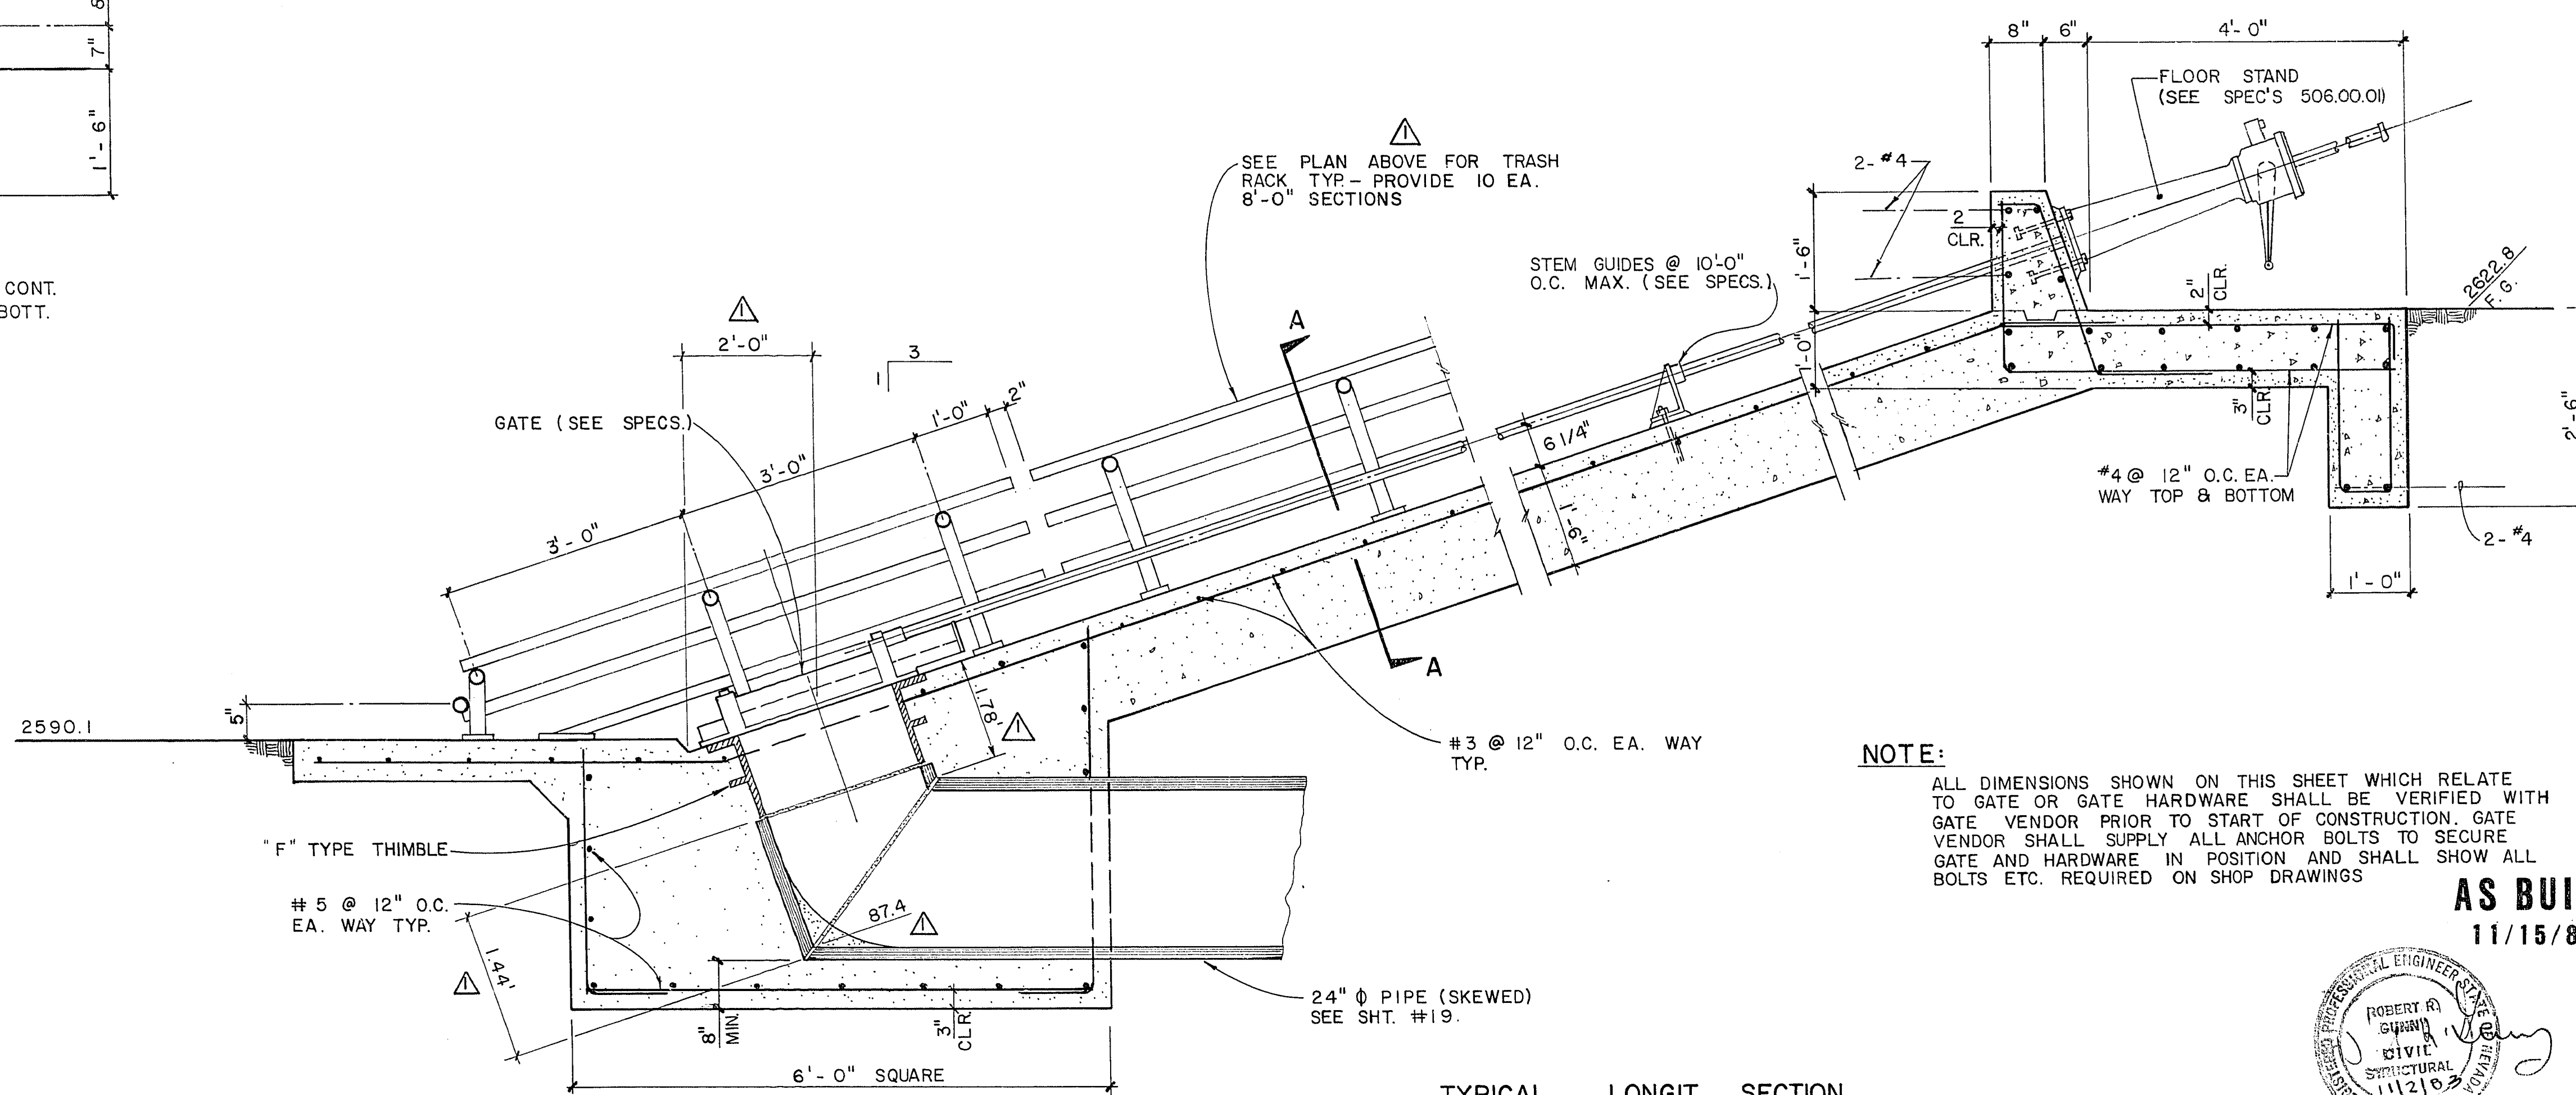

TYPICAL LONGIT. SECTION

3/4" = 1'-0"

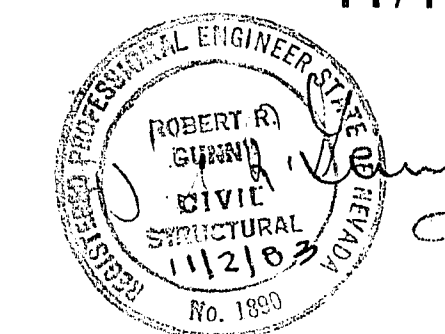

AS BUILT
11/15/84

REV	DATE	BY	REVISION
1	8/30/84	MW	EXP. ANC. IN LIEU OF ANC. BOLTS. DELETE PIPE CAPS, CAST SOLID CONC. SUPPORT.

CONSULTING ENGINEERS • PLANNERS
2800 WEST SAHARA AVENUE
LAS VEGAS, NEVADA 89102

vtm nevada

24" Ø BASIN OUTLET

ANGEL PARK DETENTION BASIN
PHASE II A

WO NO. 3061
BY EDY/RRG
DATE 11/17/83
SCALE AS NOTED

SHEET
16
OF 36 SHEETS

650.14-7