

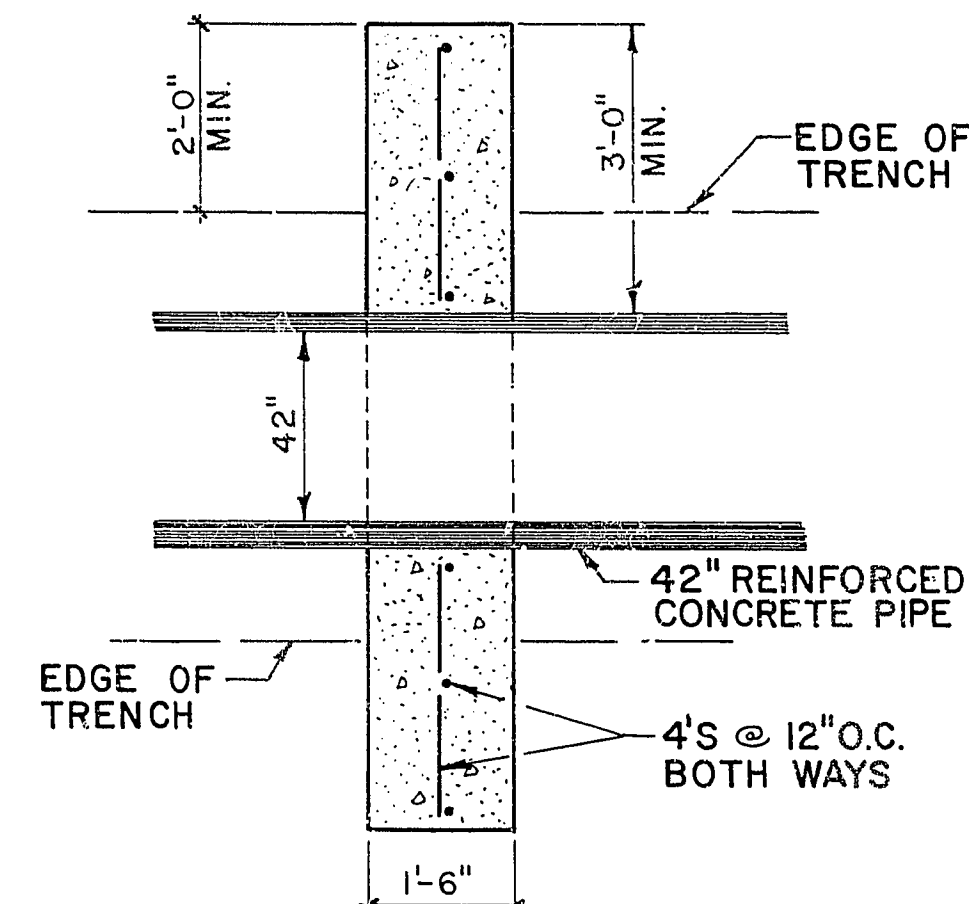


EXISTING GROUND SURFACE
OR COMPACTED FILL

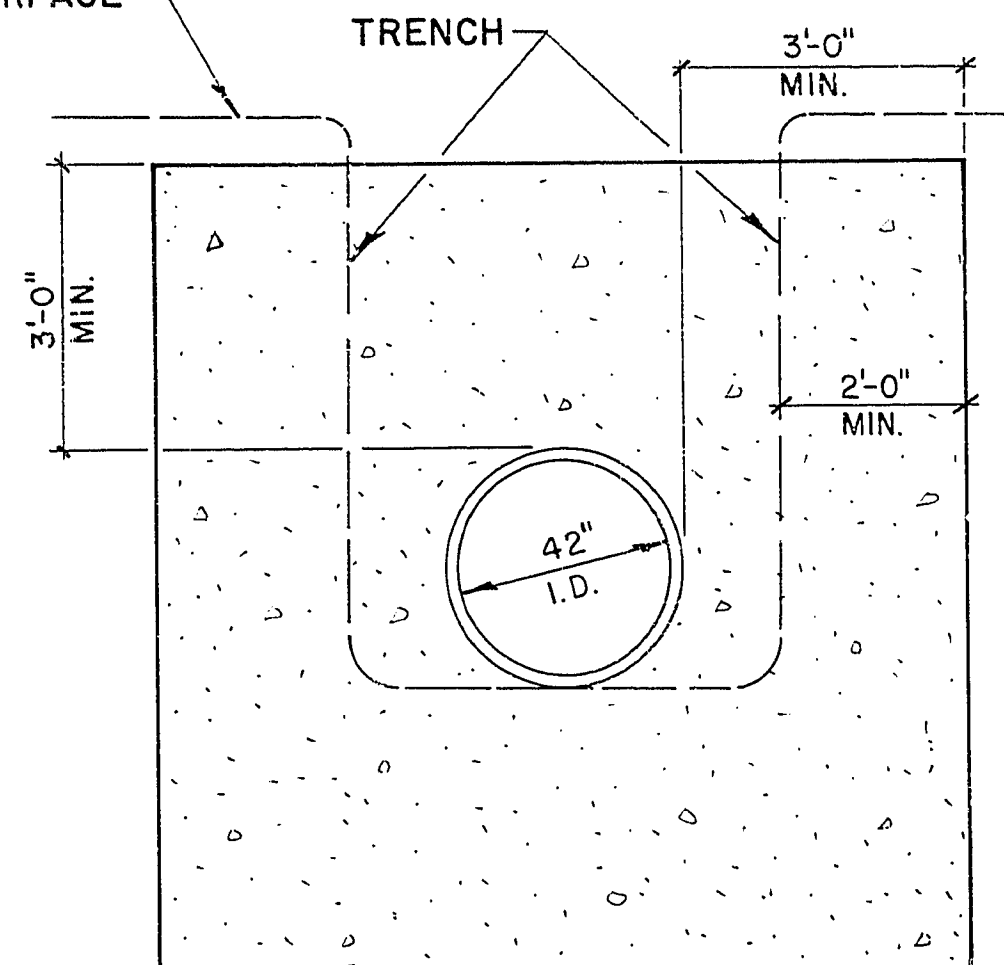


CUTOFF COLLAR DETAIL
NO SCALE

1
18

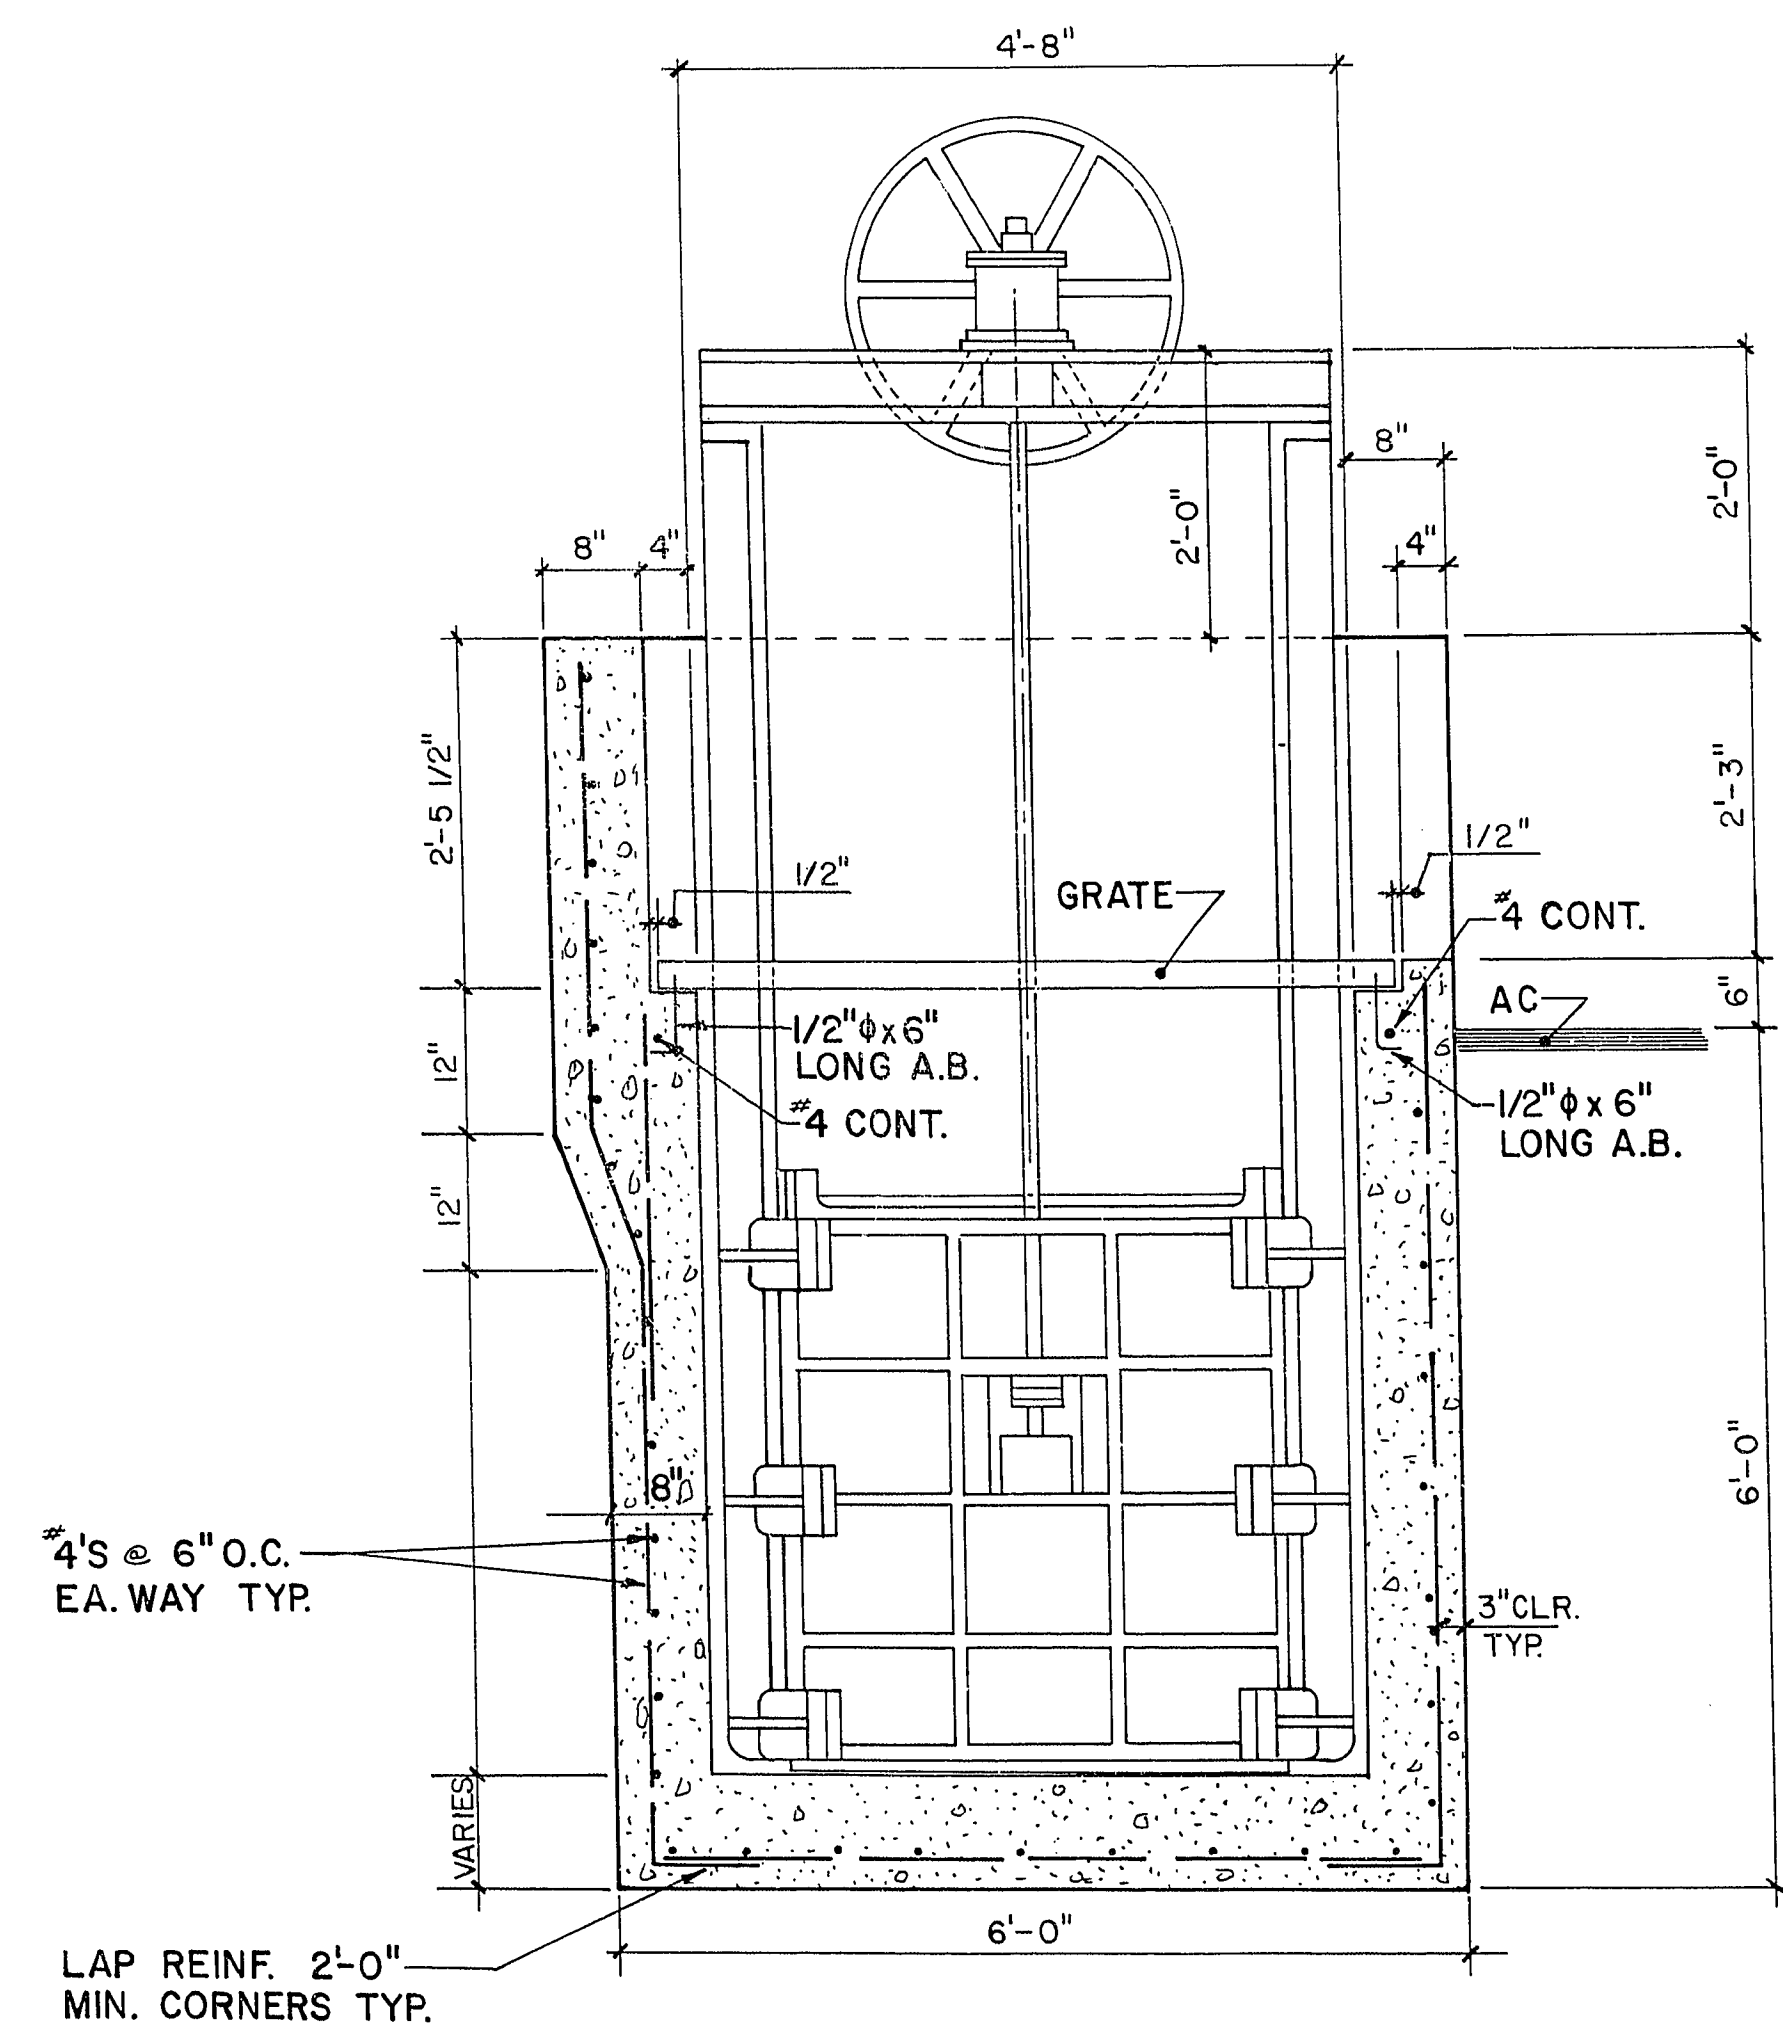


SECTION "B-B"
3/4" = 1'-0"

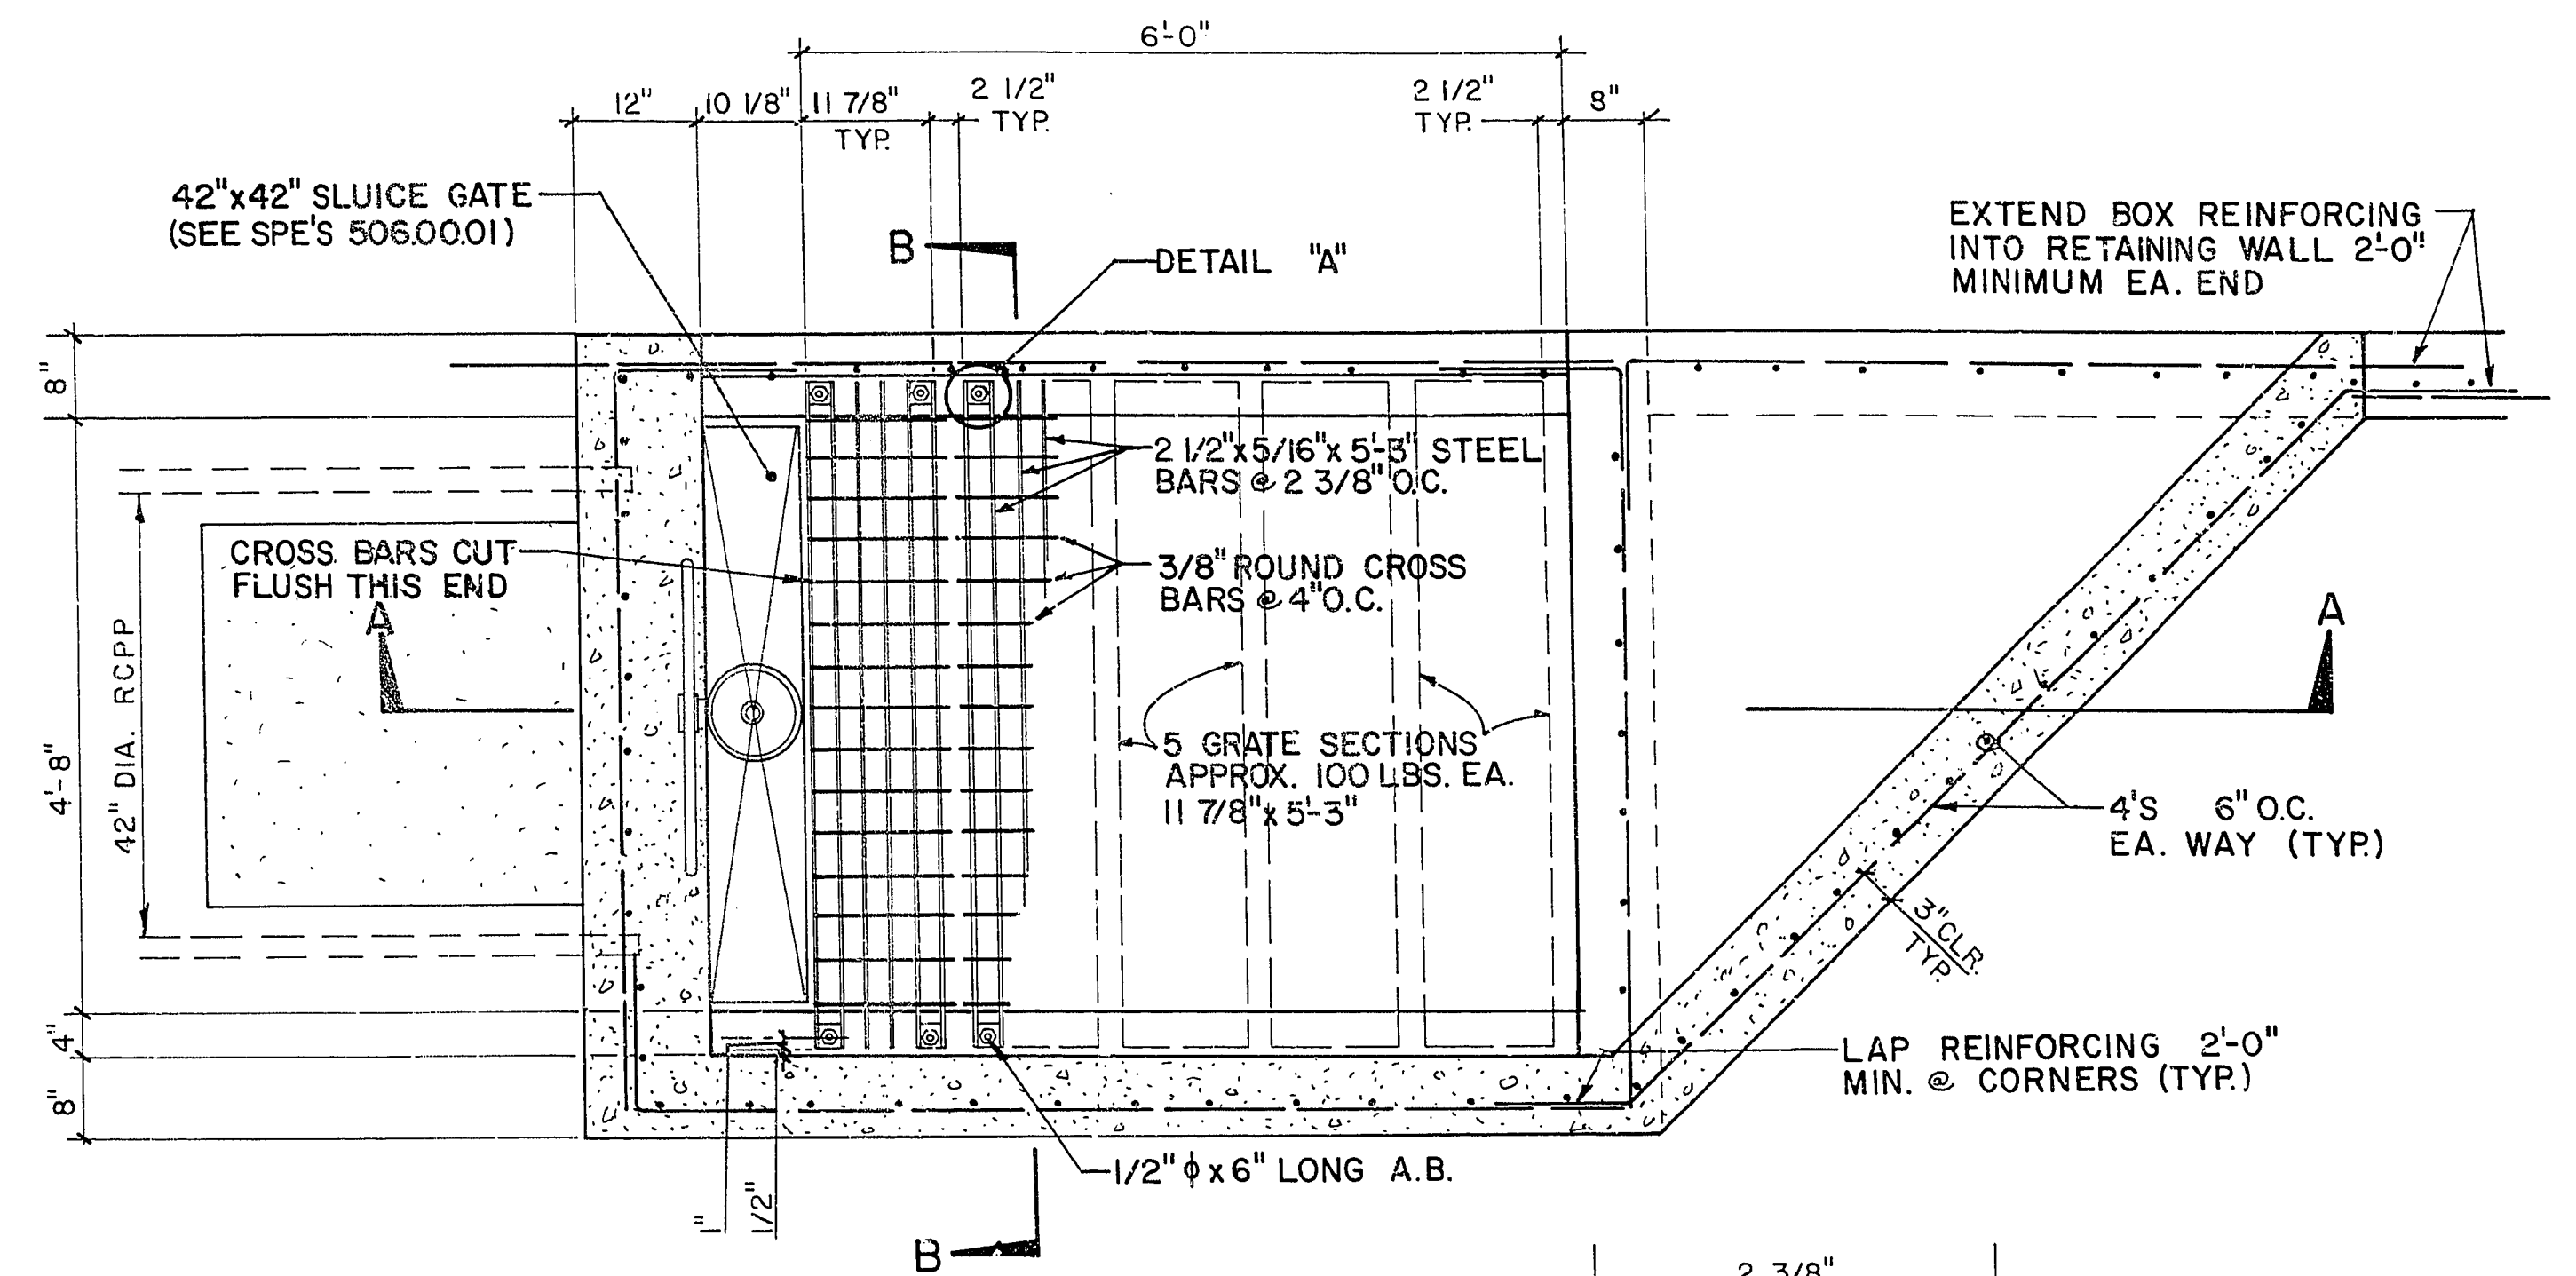


PLAN VIEW
3/4" = 1'-0"

2
18

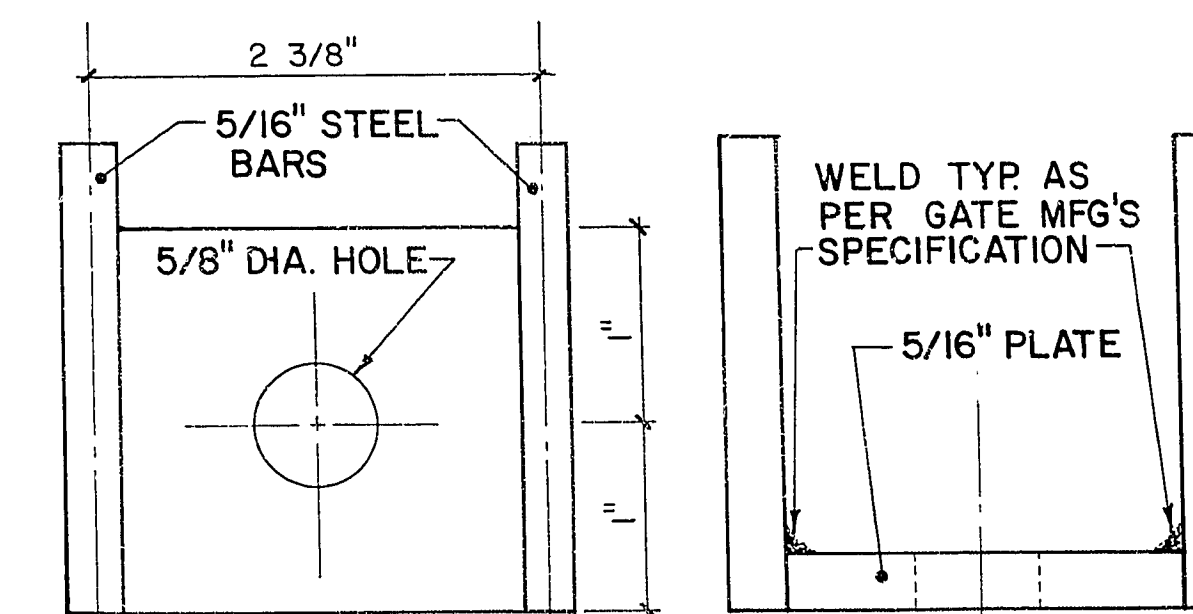


DETAIL "A"
1" = 1"

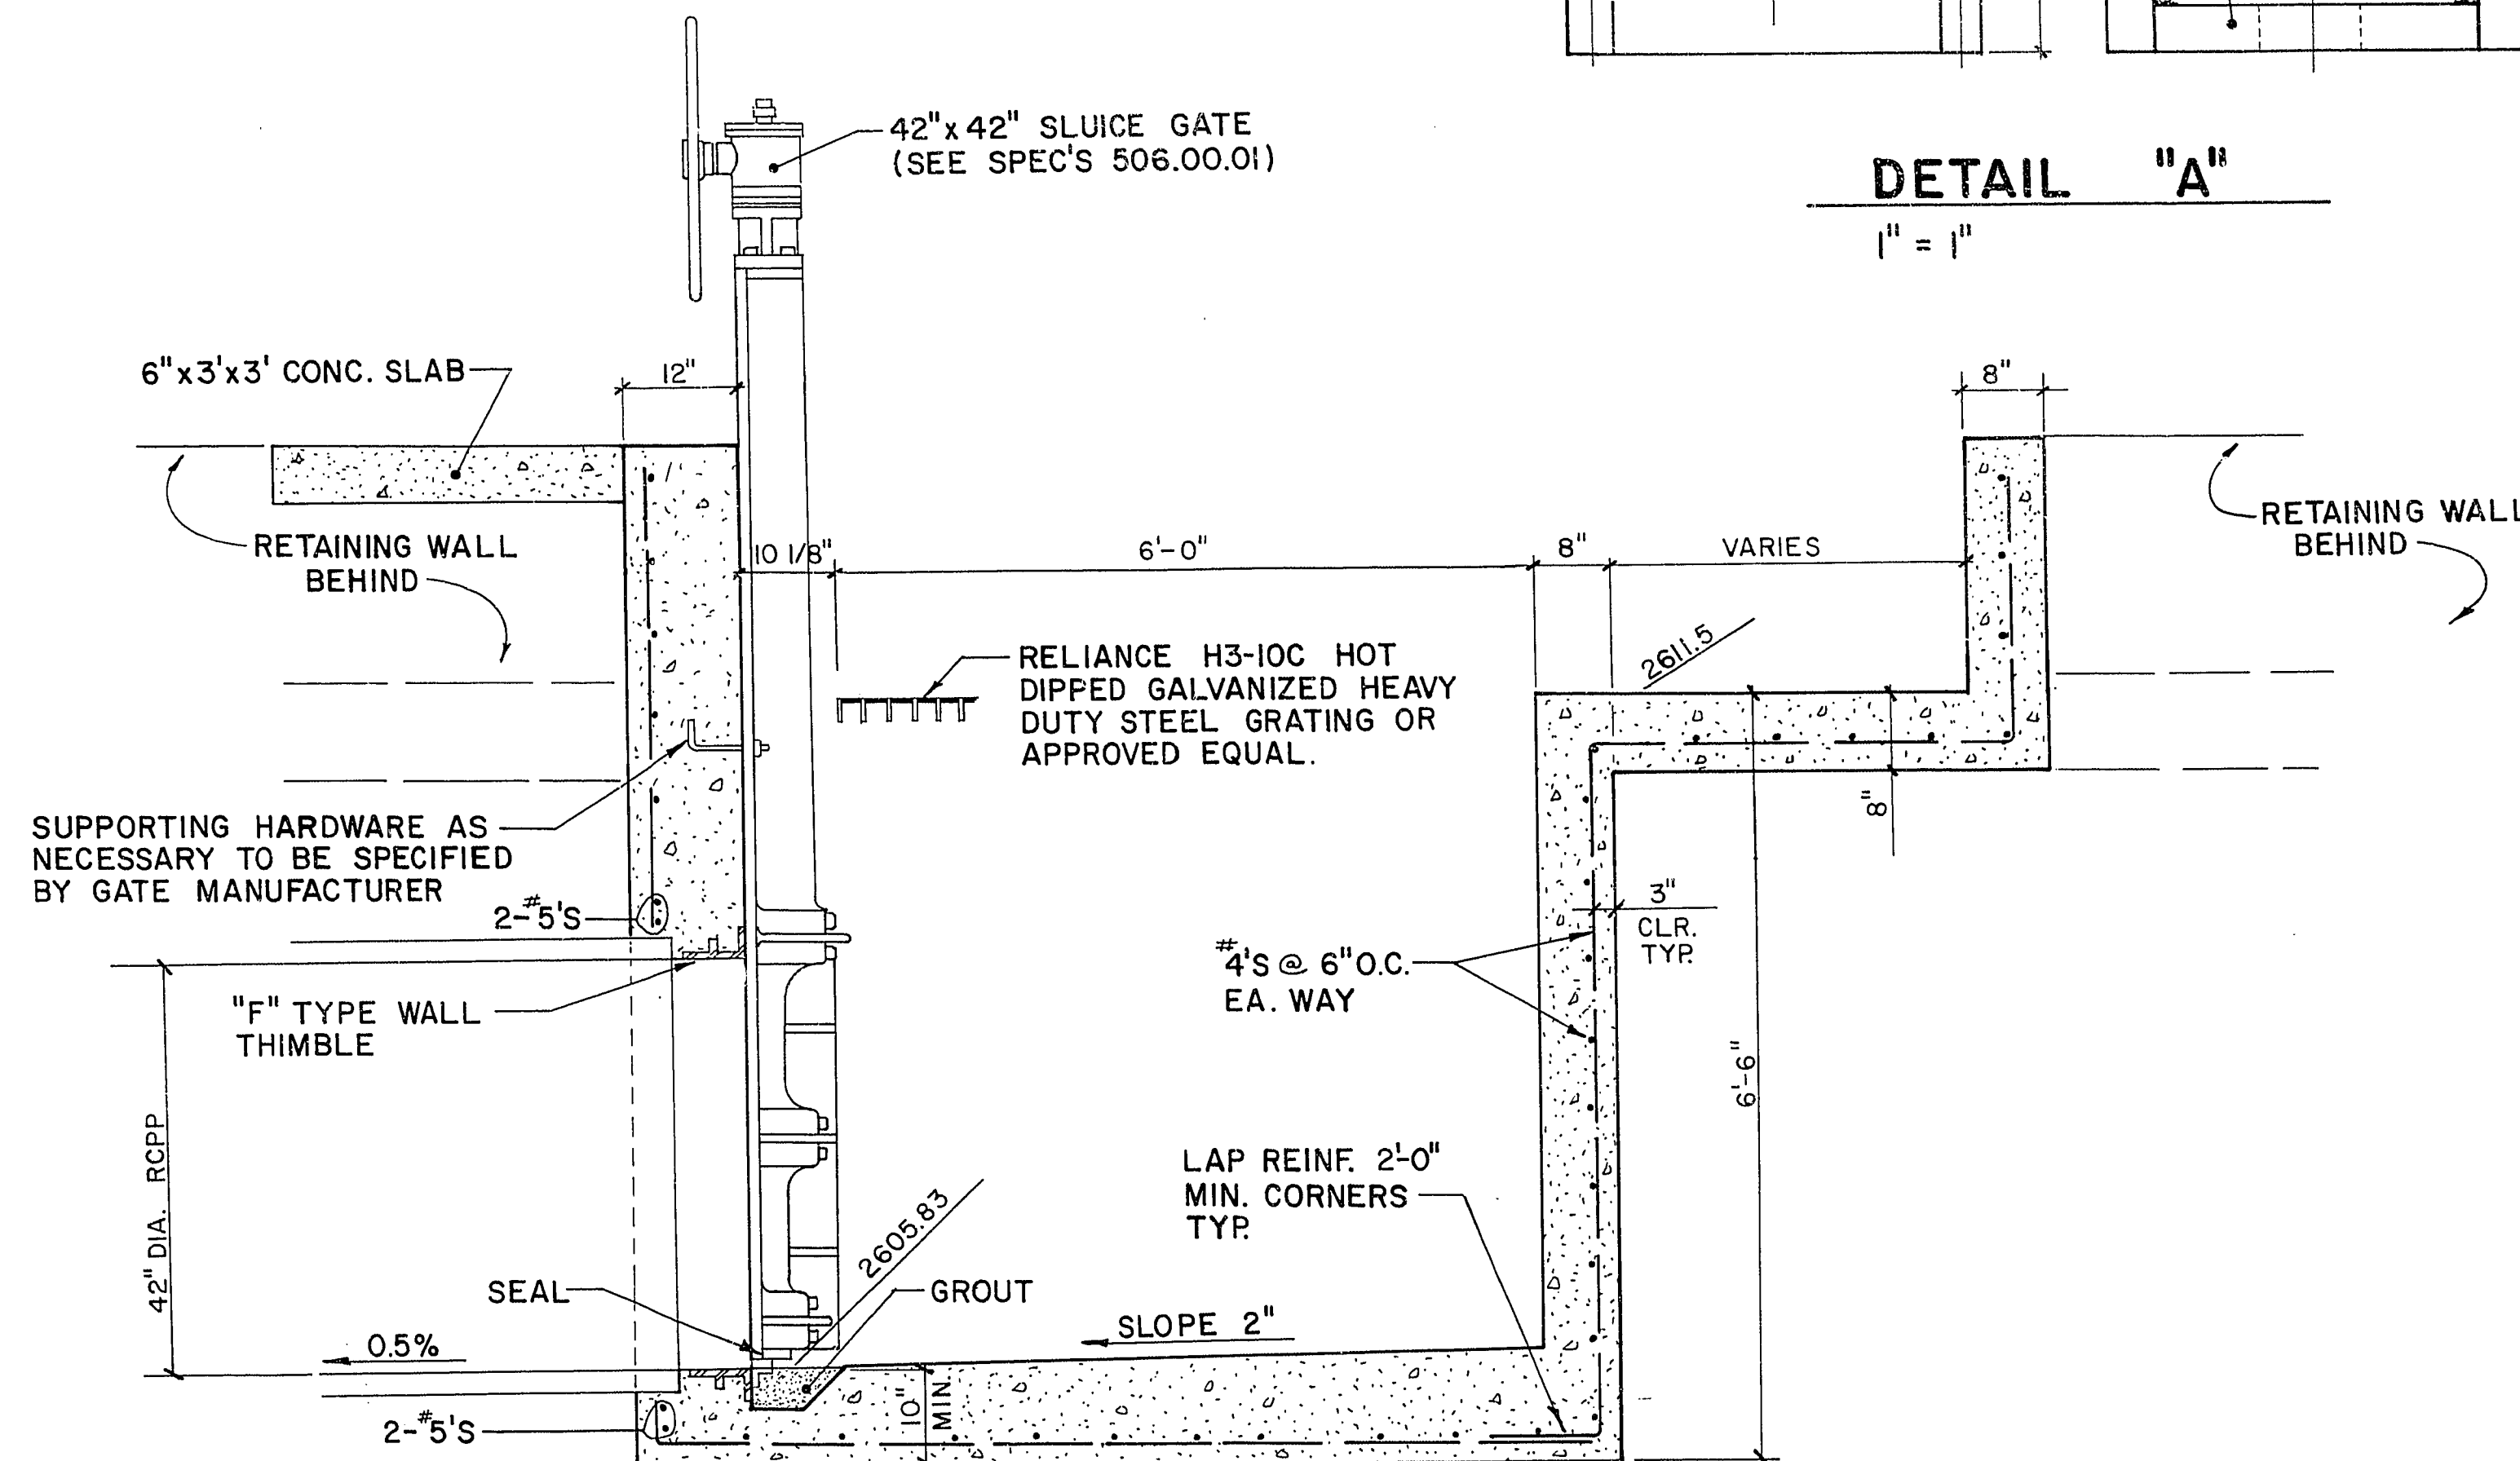

SECTION "A-A"
3/4" = 1'-0"

- NOTE:
1. SEE SHEET 20 FOR LOCATION OF OUTLET STRUCTURE.
 2. SEE SHEET 18 A FOR ELEVATION OF OUTLET STRUCTURE AND ADJACENT RETAINING WALL.

AS BUILT
11/15/84

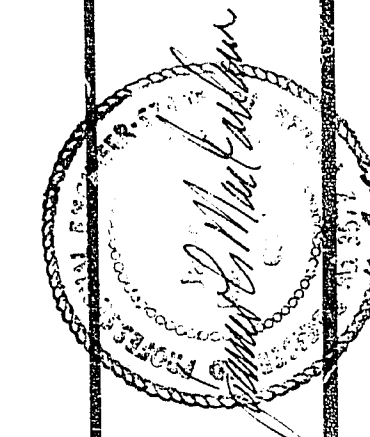

REV	DATE	BY	ADD. DIMENSIONS
1	10/2/83	RPF	ADD NOTE 1, PER ADDENDUM #1
2	1/24/84	MW	ADD NOTE 2, SHEET 18A
3	8/20/84	MW	

PLANNERS
CONSULTING ENGINEERS
2800 WEST SAHARA AVENUE BUILDING 4 SUITE B
LAS VEGAS, NEVADA 89102 PHONE (702) 873-5500

42" PIPE EMERGENCY OUTLET

ANGEL PARK DETENTION BASIN
PHASE II A

WO NO.	3061
BY	RPF/MJB
DATE	10/2/83
SCALE	AS NOTED

SHEET	18
OF 36 SHEETS	

650.14-7