



9-13-120

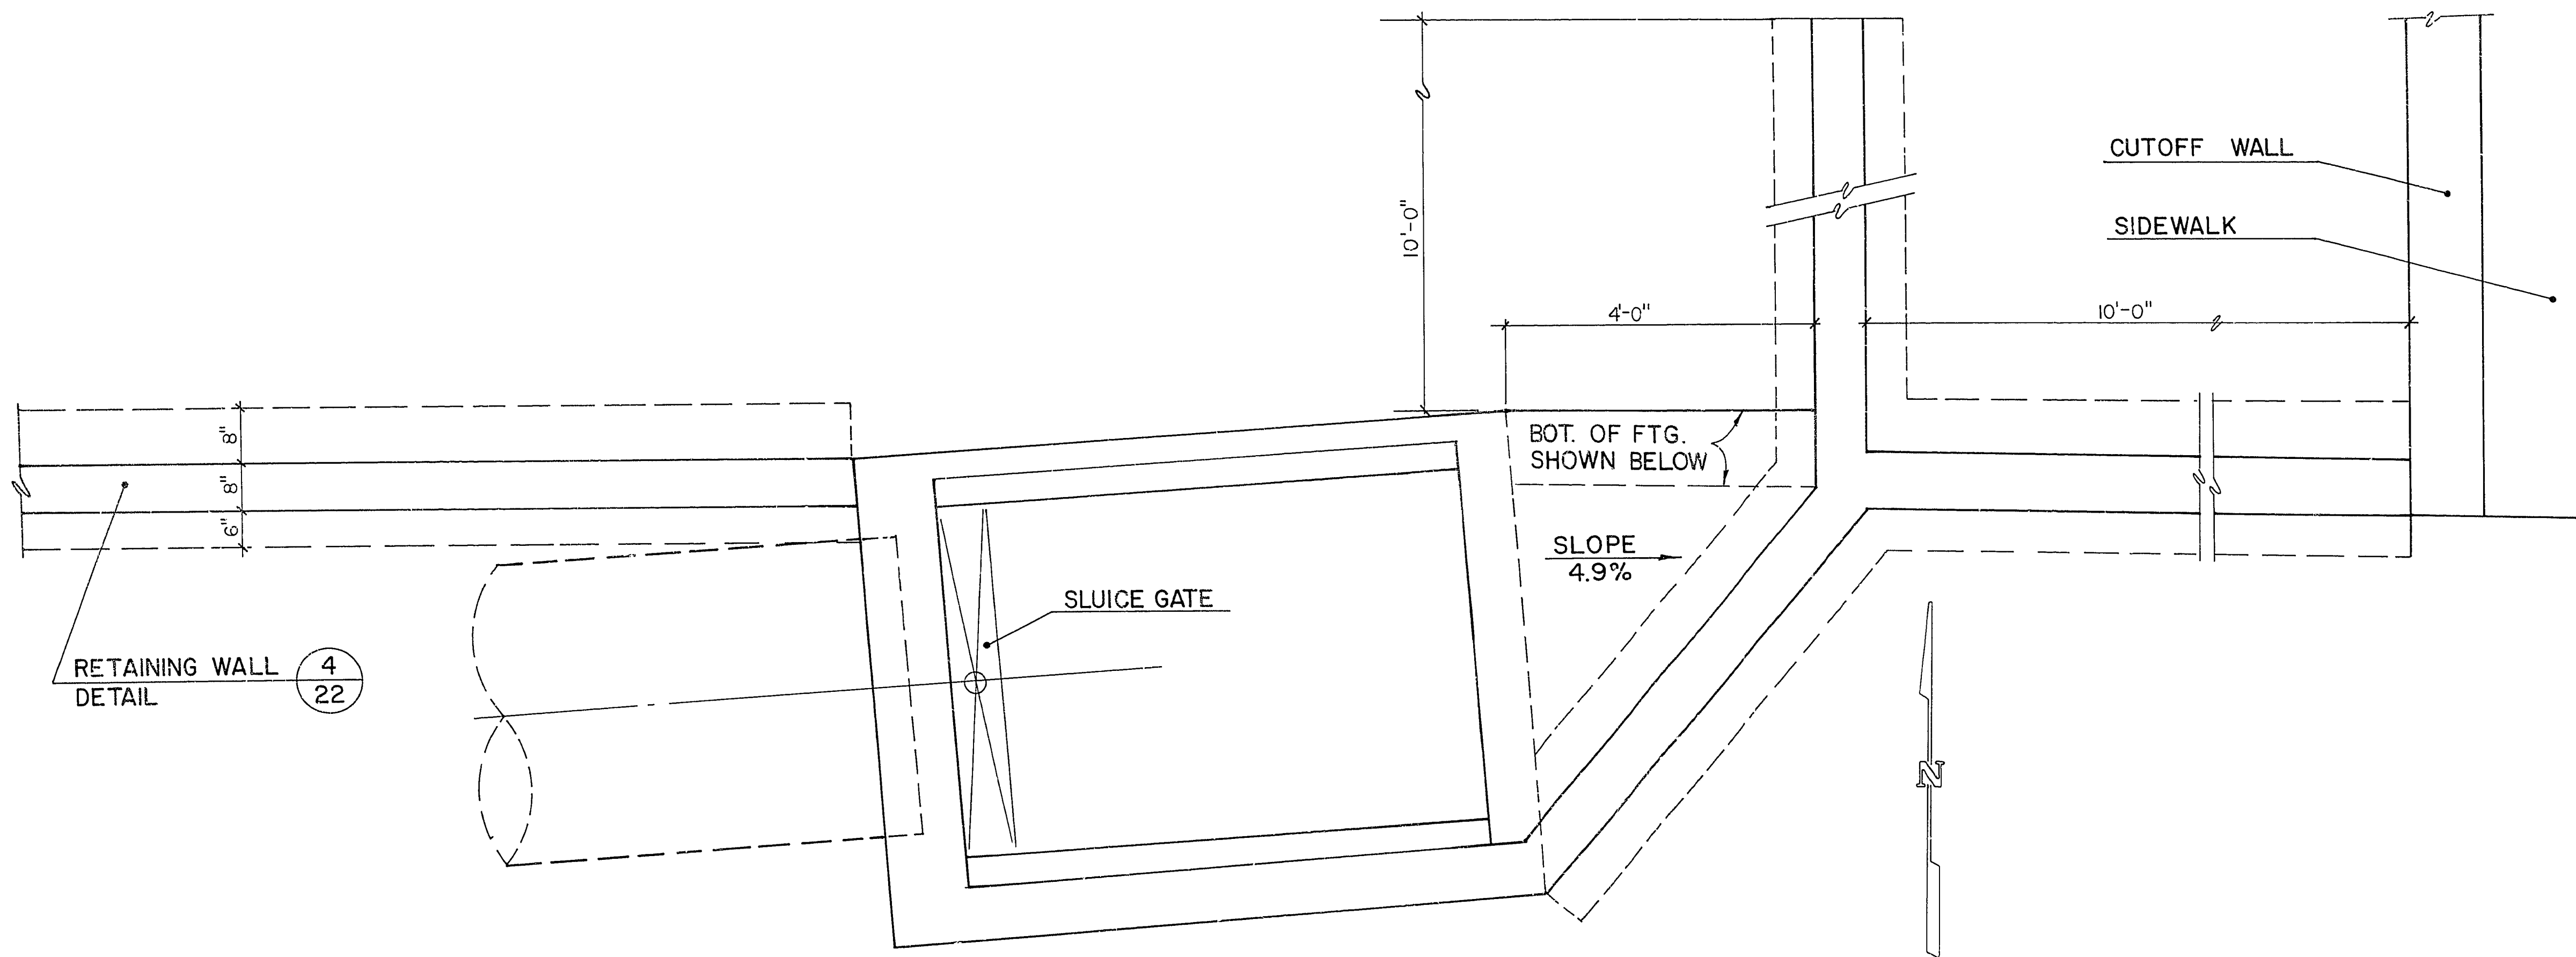

PLAN

3/4" = 1'-0"

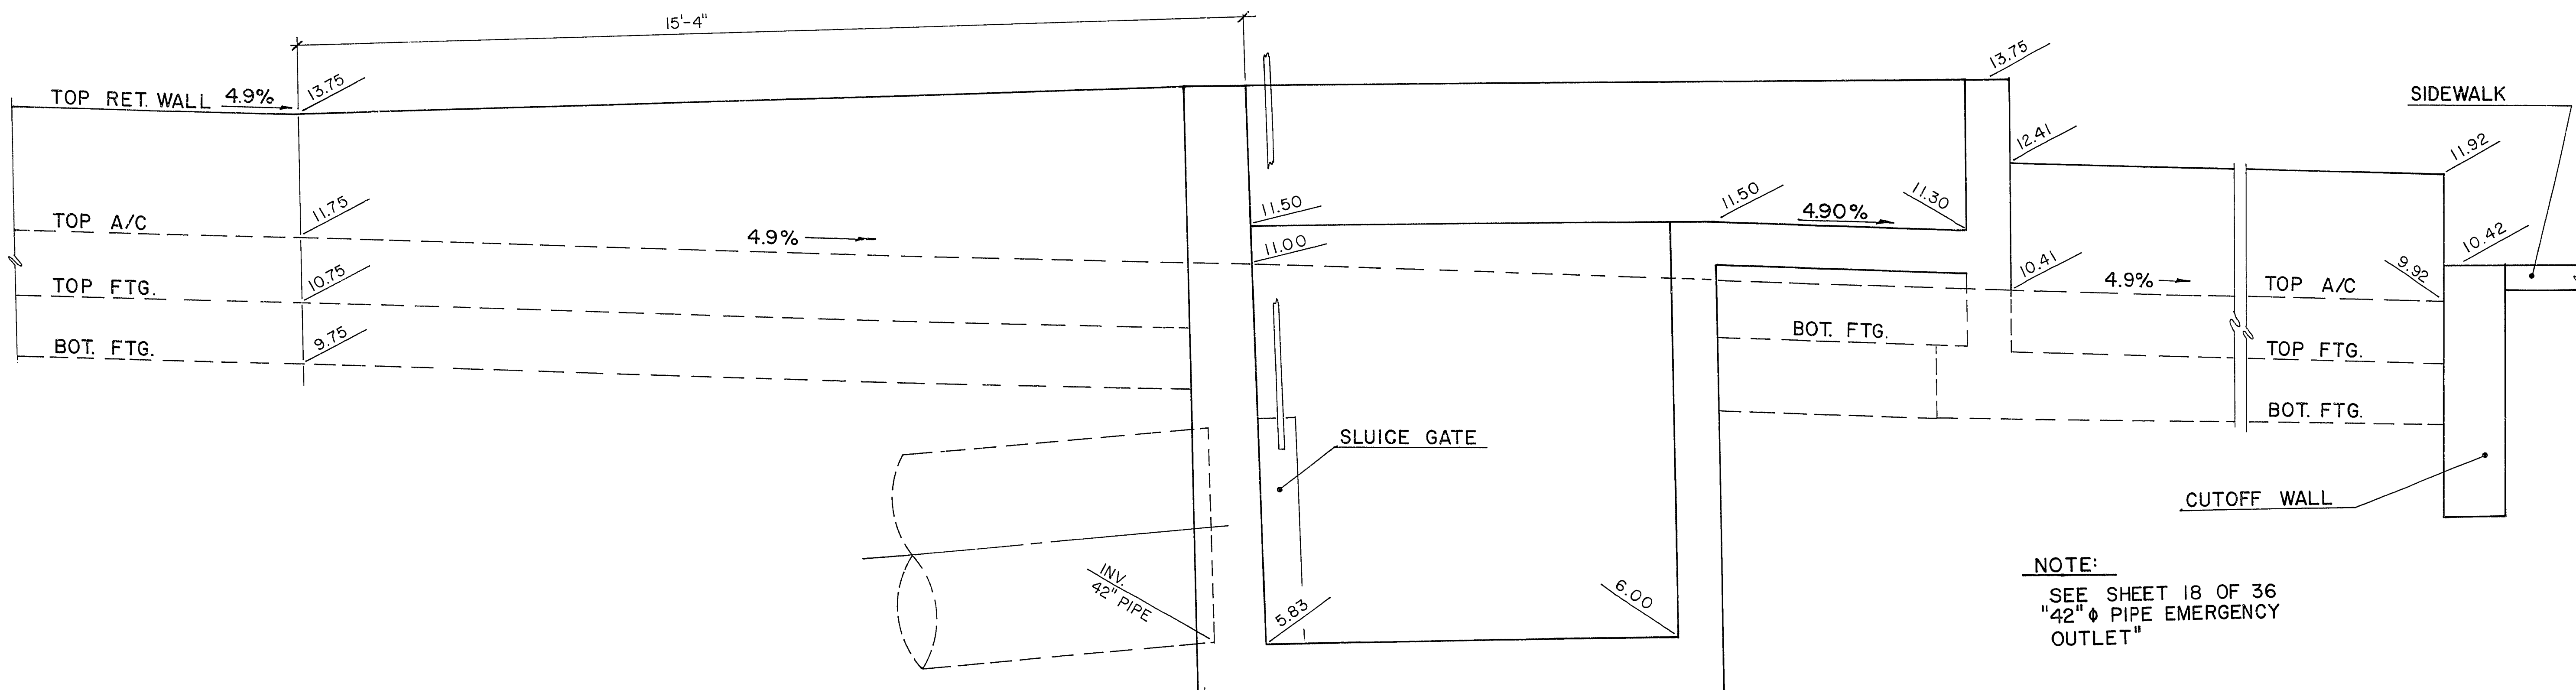

SECTION

3/4" = 1'-0"

NOTE:
SEE SHEET 18 OF 36
"42" ϕ PIPE EMERGENCY
OUTLET"

AS BUILT
11/15/84

REVISION	DATE	BY

CONSULTING ENGINEERS • PLANNERS
2300 PASEO DEL PRADO BUILDING A SUITE 100
LAS VEGAS, NEVADA 89102 PHONE (702) 873-7550

vtm nevada

42 INCH PIPE OUTLET STRUCTURE

PROJECT: ANGEL PARK DETENTION BASIN PHASE II A

WO NO. 3061
BY RPF/MW
DATE 8/20/84
SCALE AS NOTED

SHEET
18 A
OF 36 SHEETS

650.14-7