

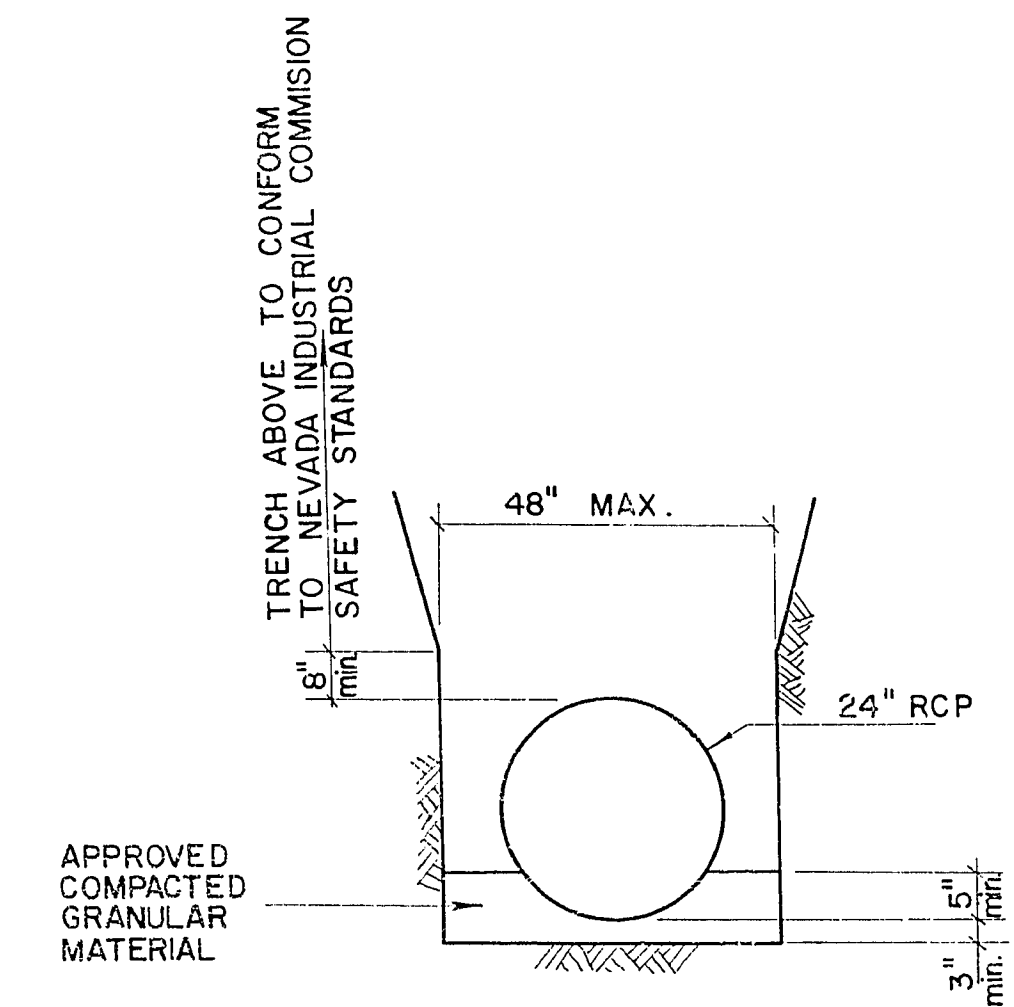


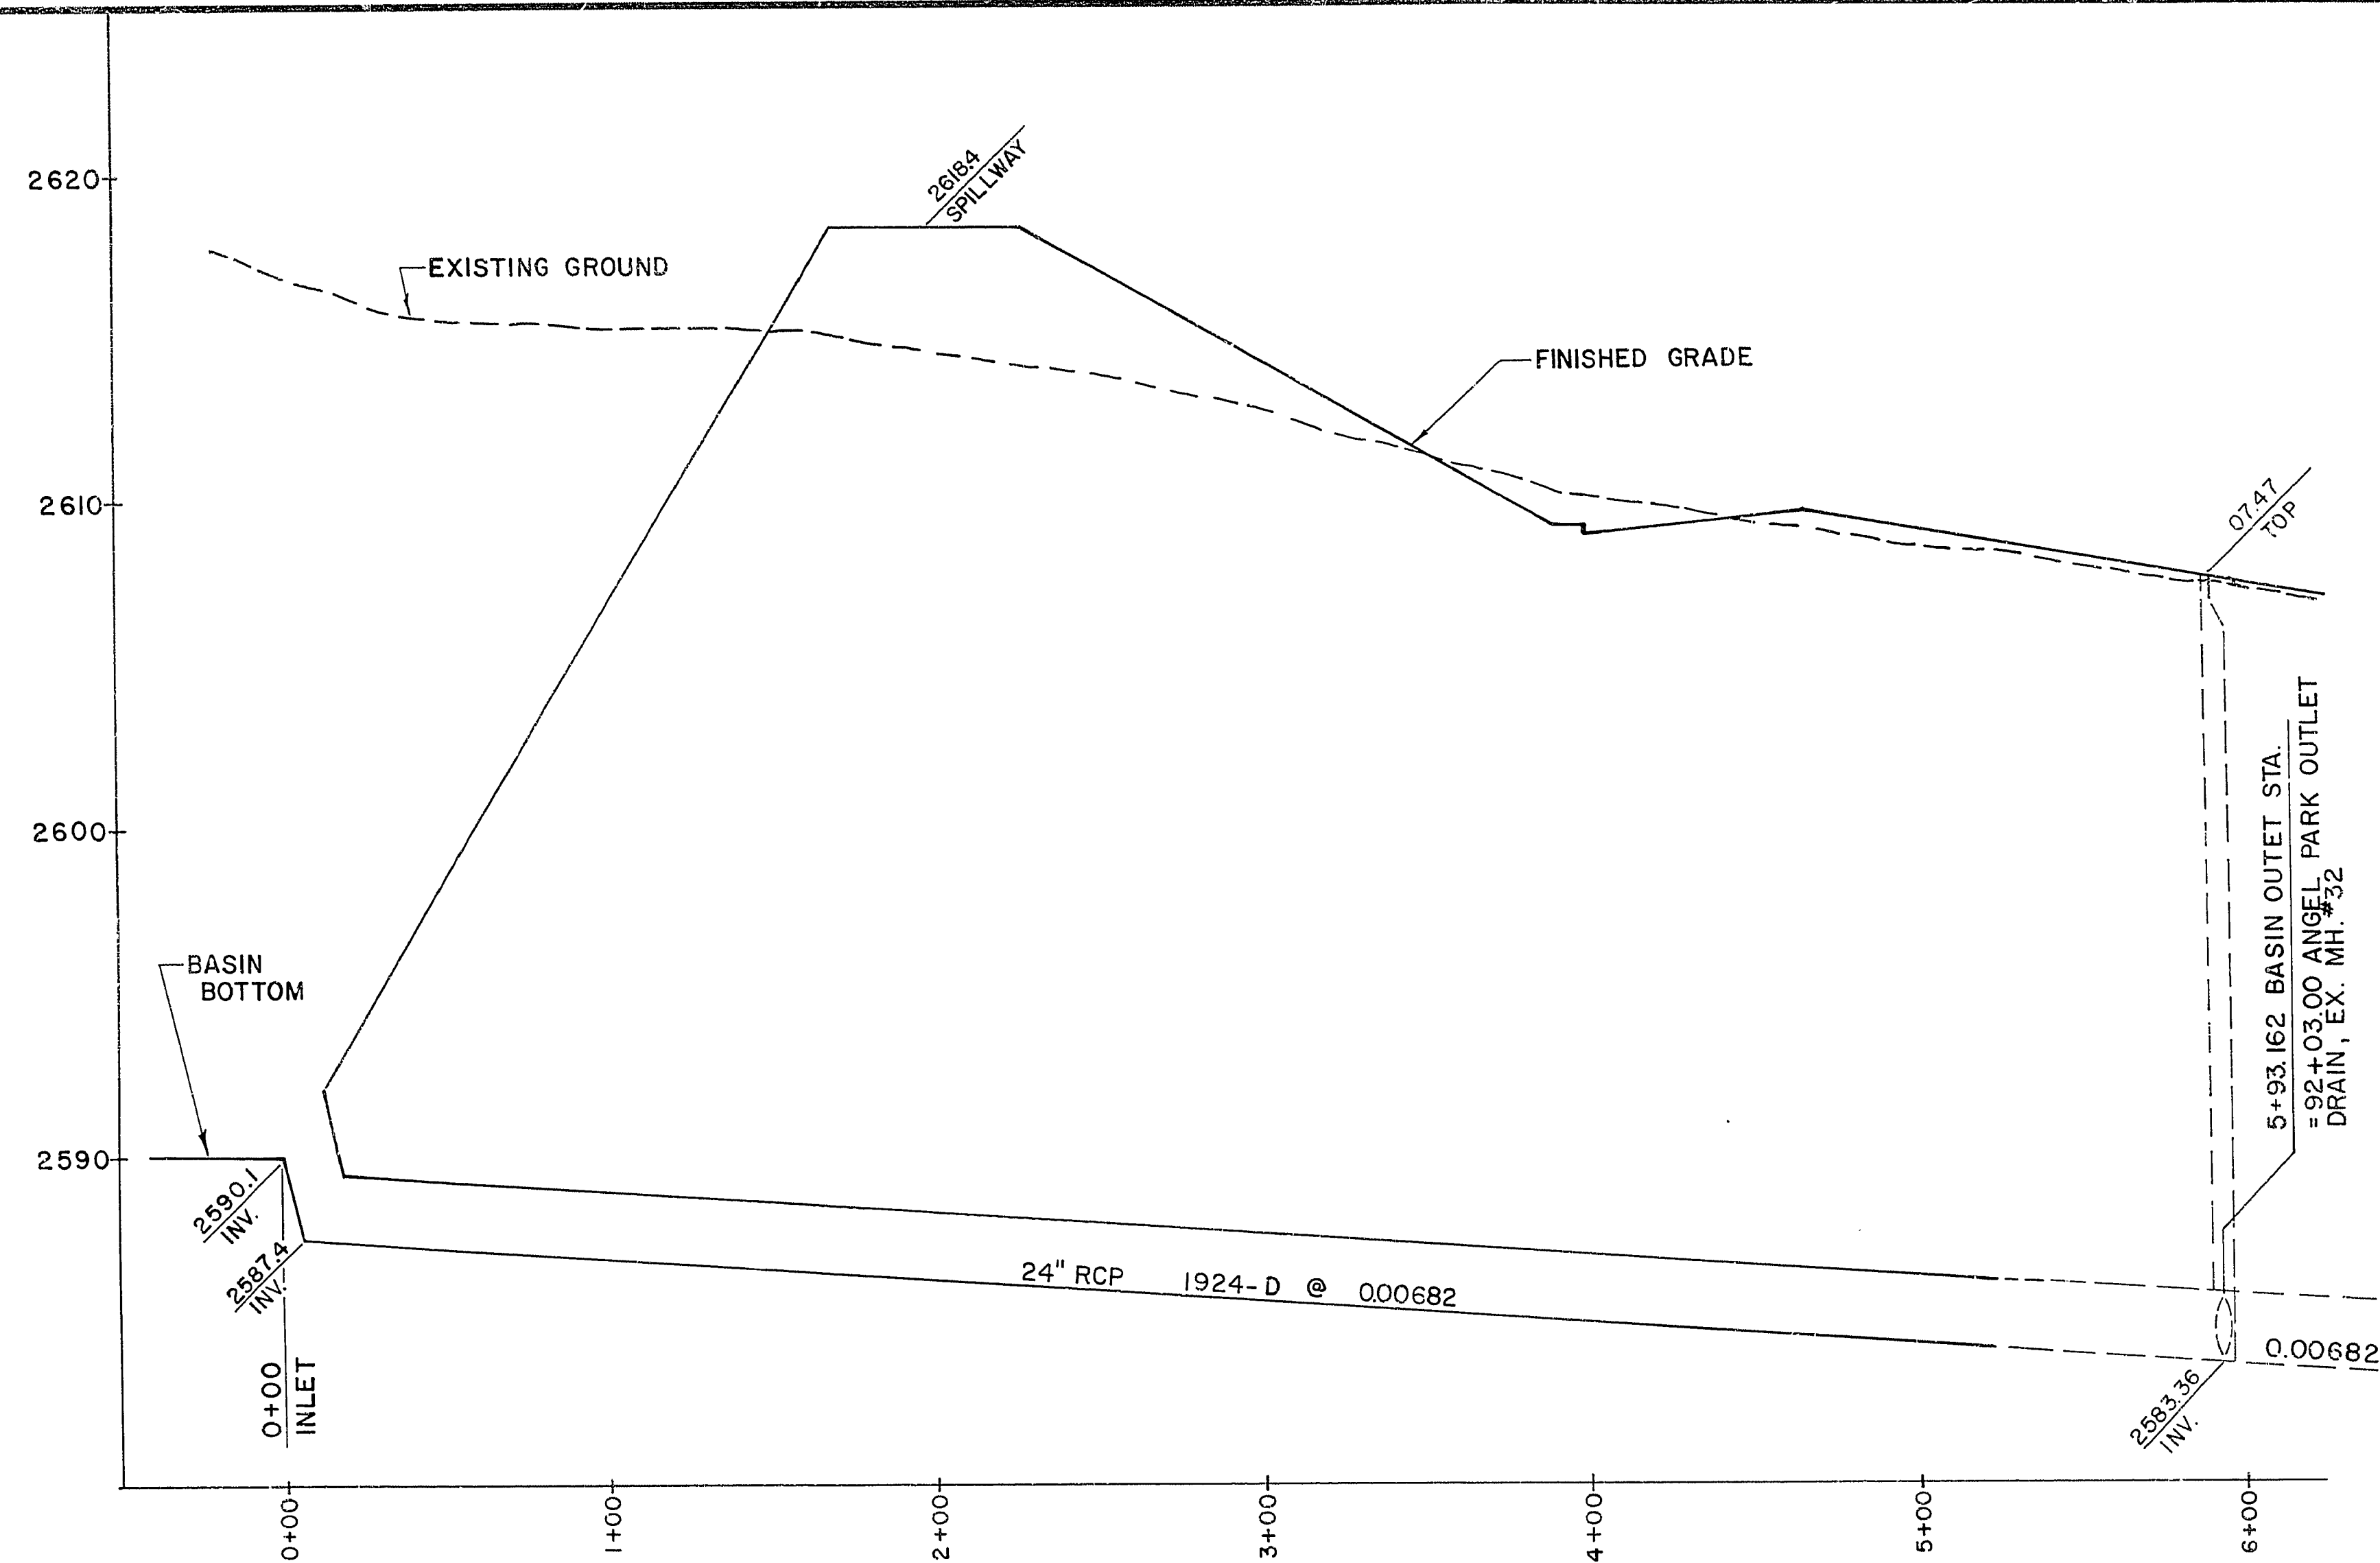

TRENCH DETAIL

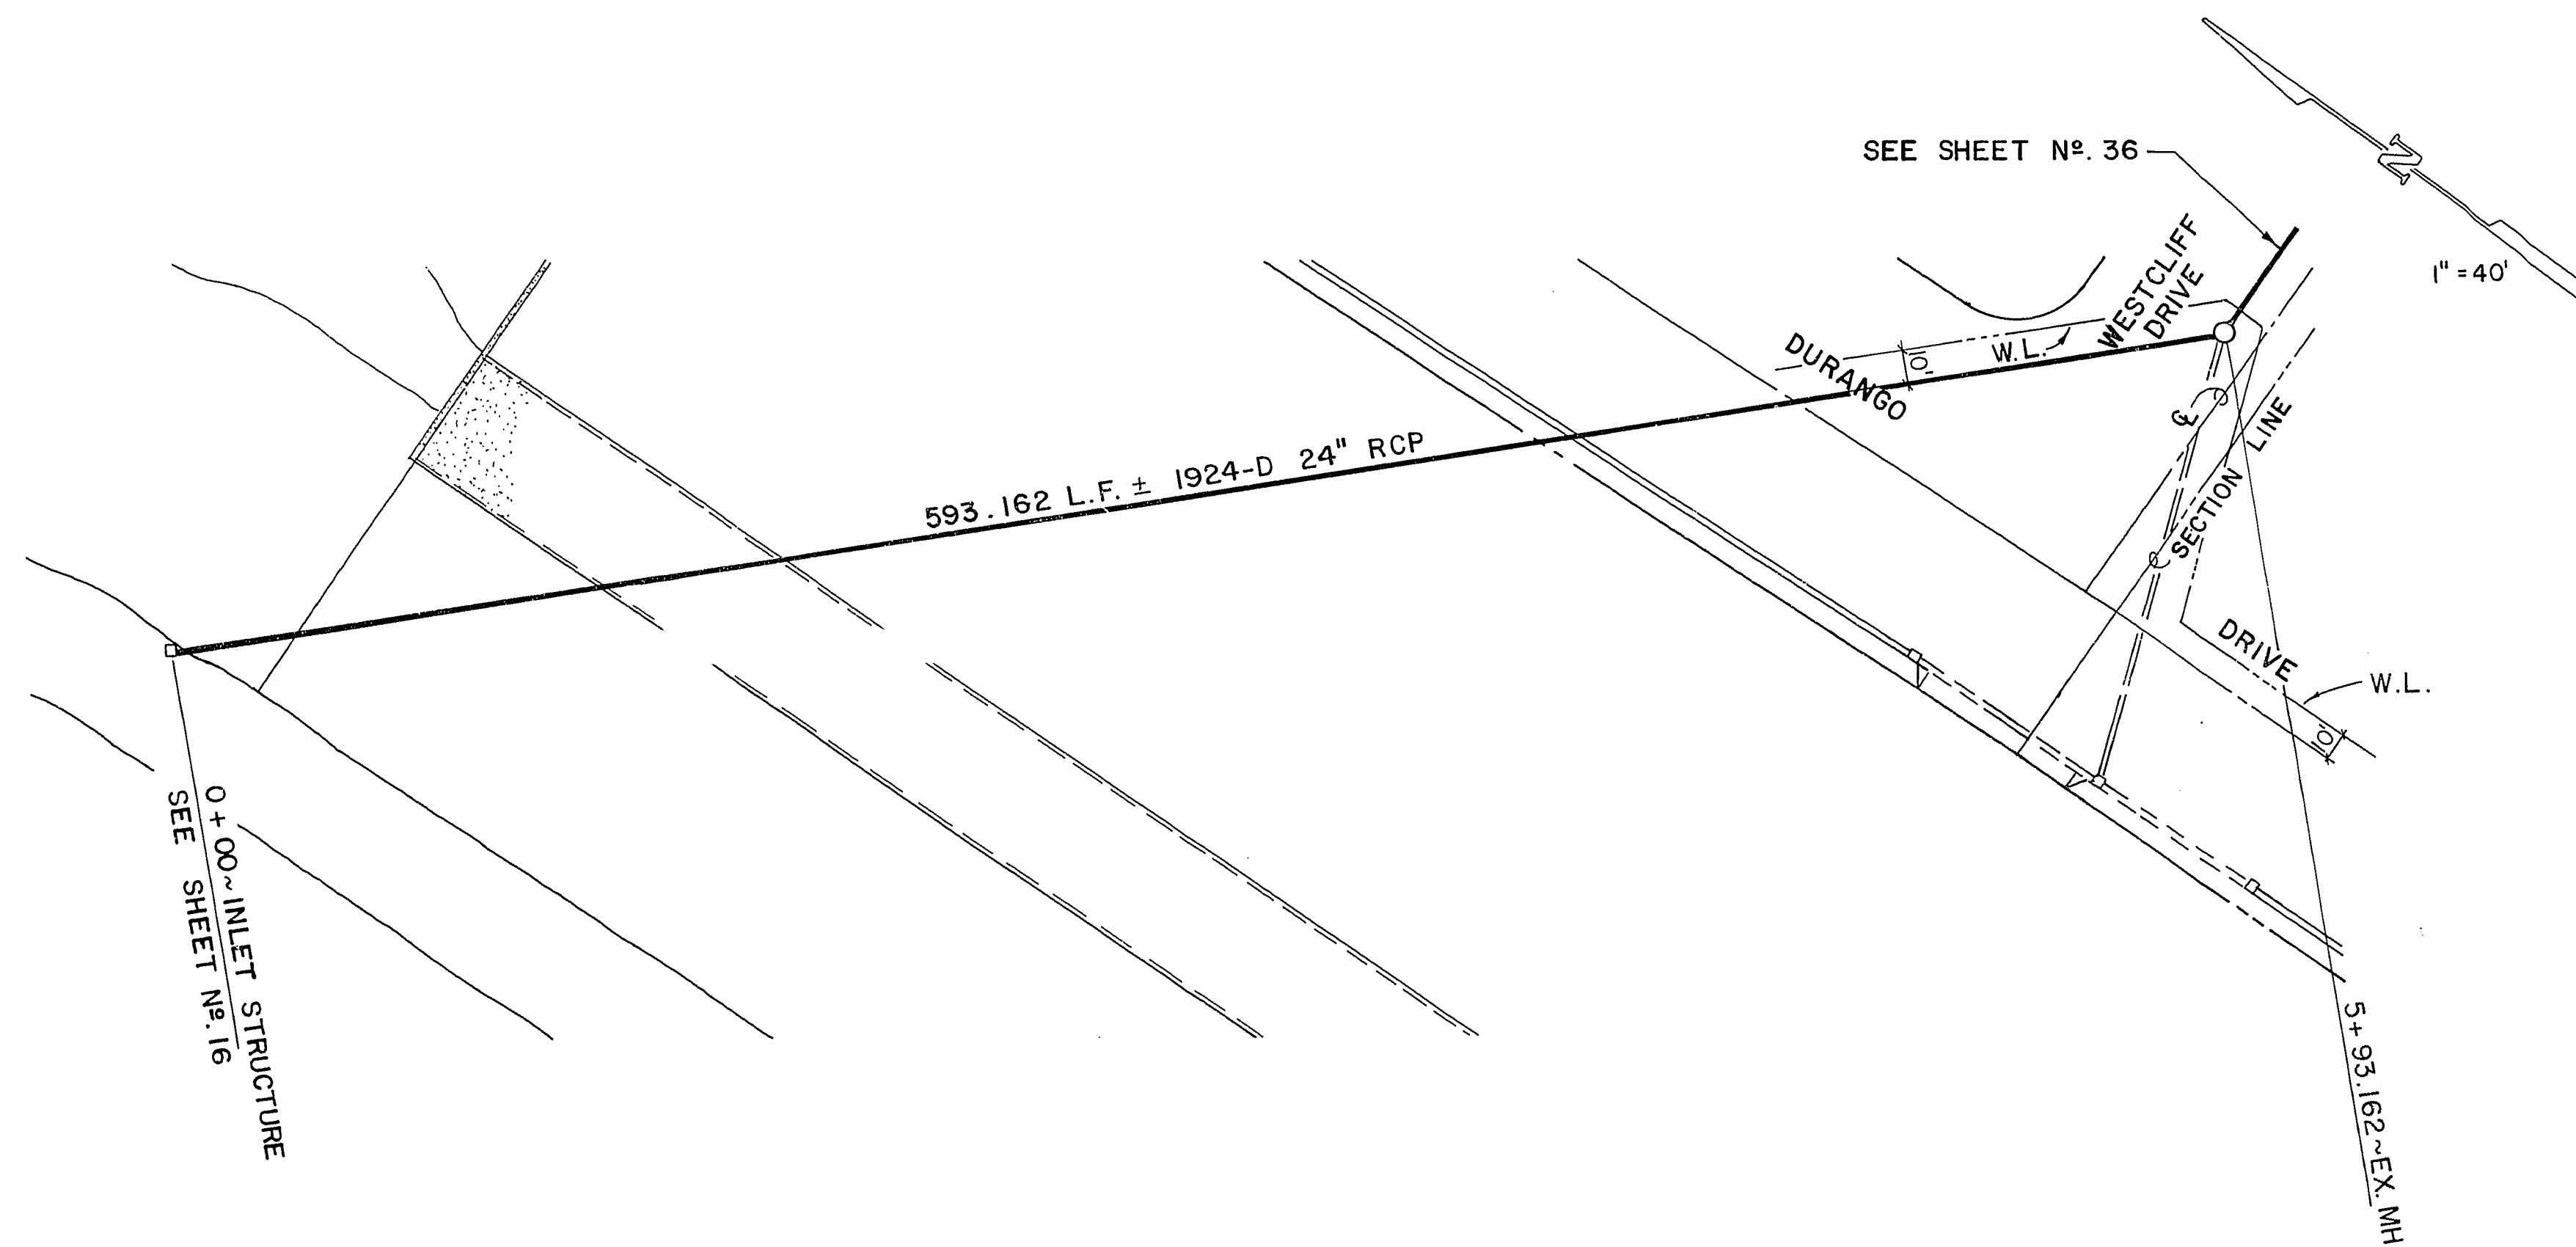

AS BUILT  
11/15/84

PLAN & PROFILE

BASIN OUTLET PIPE

ANGEL PARK DETENTION BASIN  
PHASE IIA

|        |                                |
|--------|--------------------------------|
| WO NO. | 3061                           |
| BY     | RPF/MJB/ED                     |
| DATE   | 10/2/83                        |
| SCALE  | HOR. 1" = 40'<br>VERT. 1" = 4' |

|              |    |
|--------------|----|
| SHEET        | 19 |
| OF 36 SHEETS |    |

|     |         |     |              |
|-----|---------|-----|--------------|
| REV | DATE    | BY  | REVISION     |
| 1   | 11/6/83 | EDY | LOC. MH. #32 |

CONSULTING ENGINEERS • PLANNERS  
2800 WEST SAHARA AVENUE BUILDING 4 SUITE B  
LAS VEGAS, NEVADA 89102 PHONE (702) 873-7550

vtm nevada