


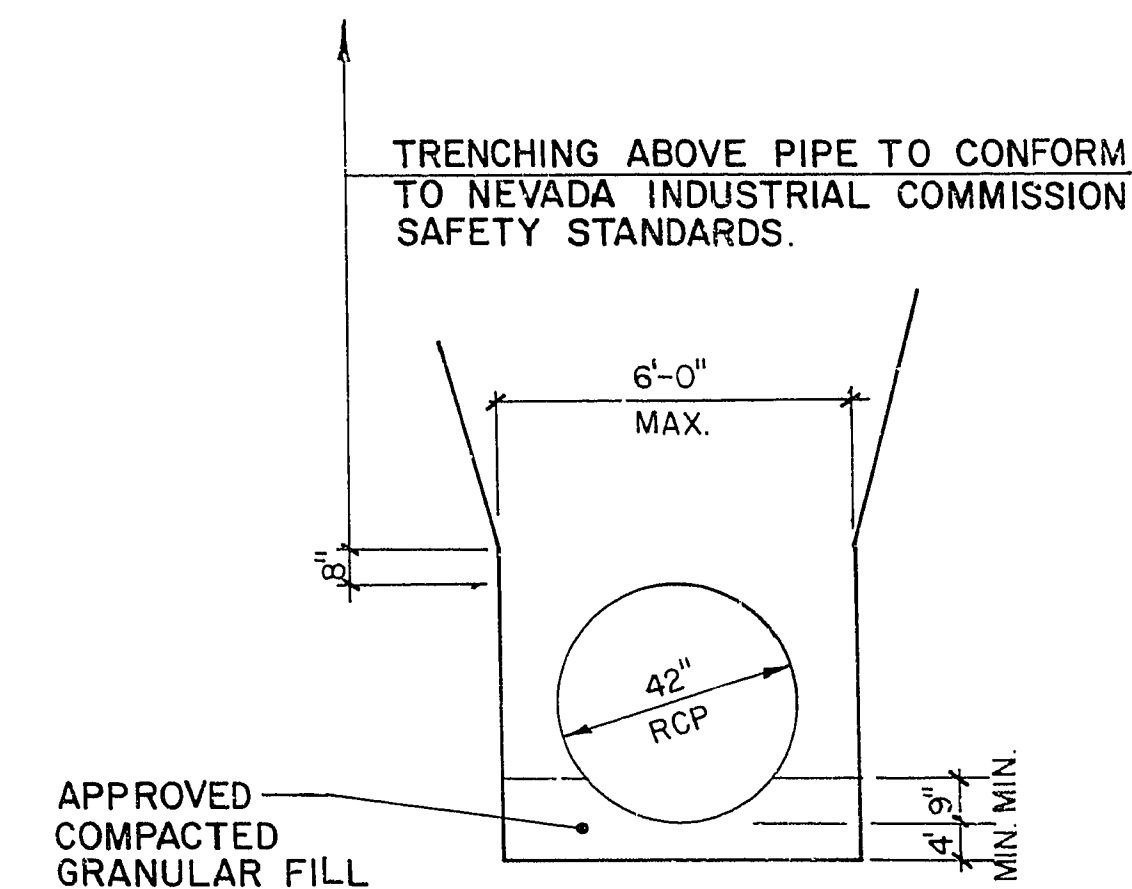
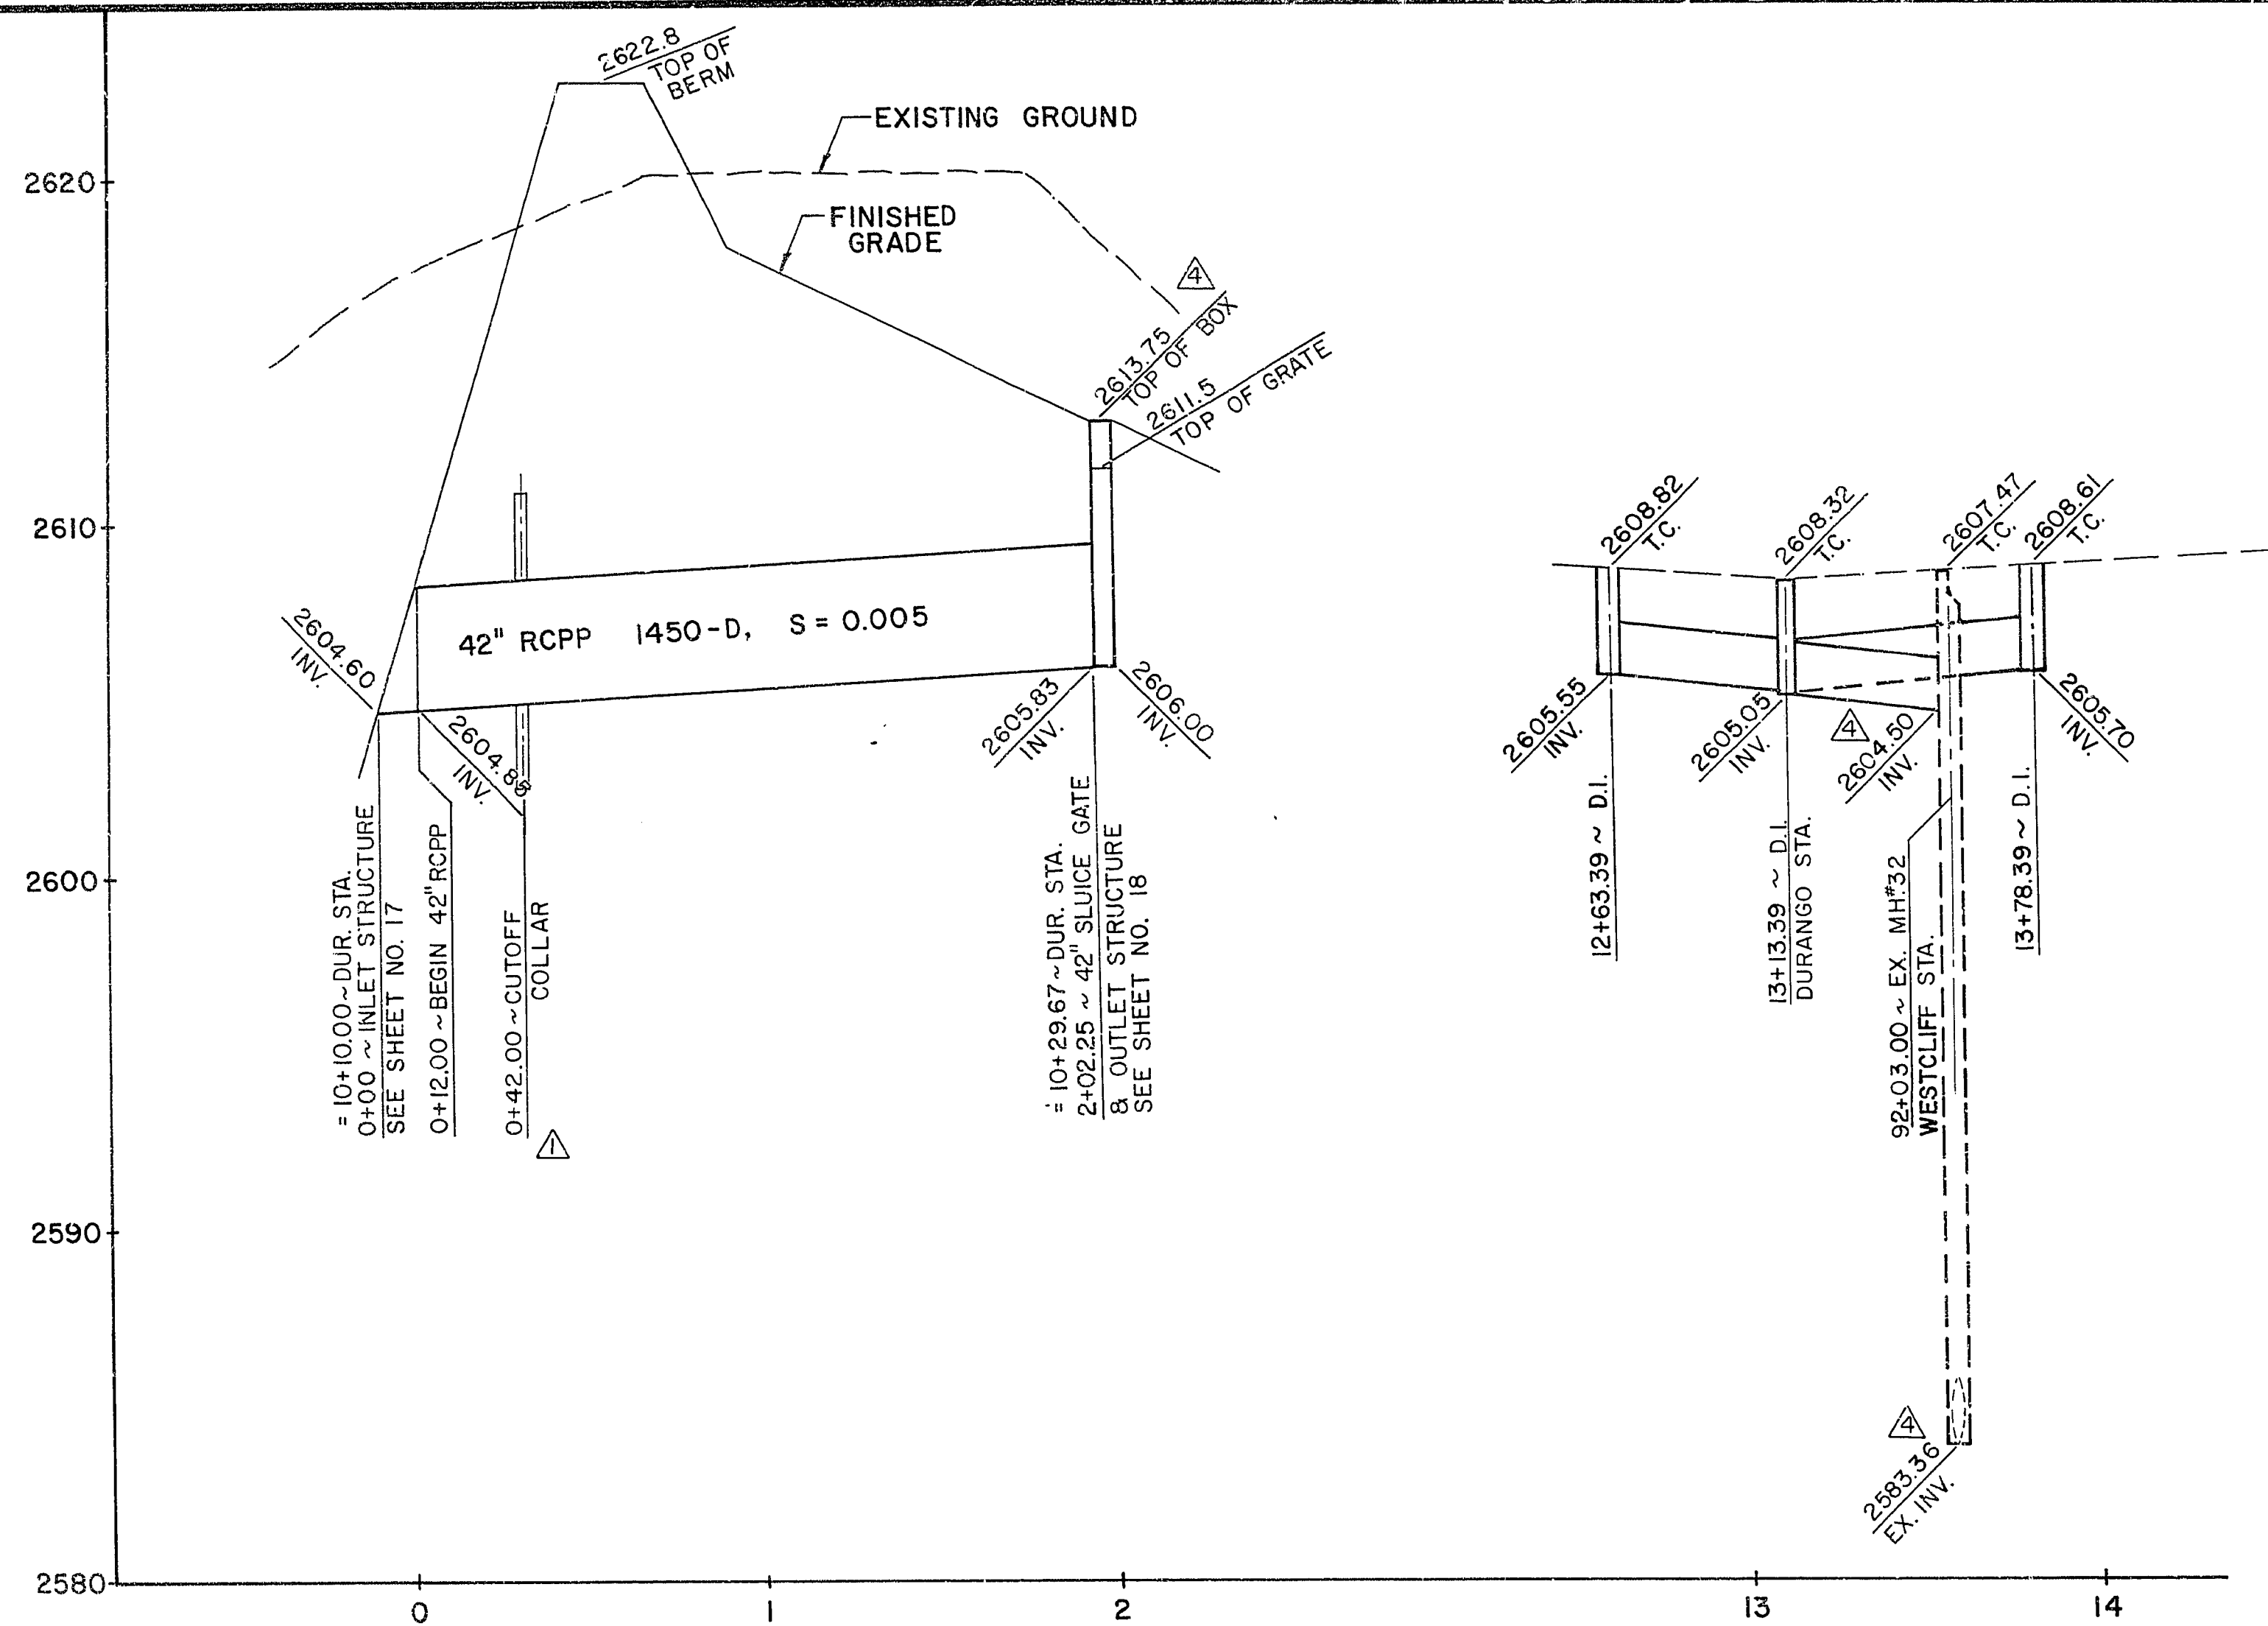


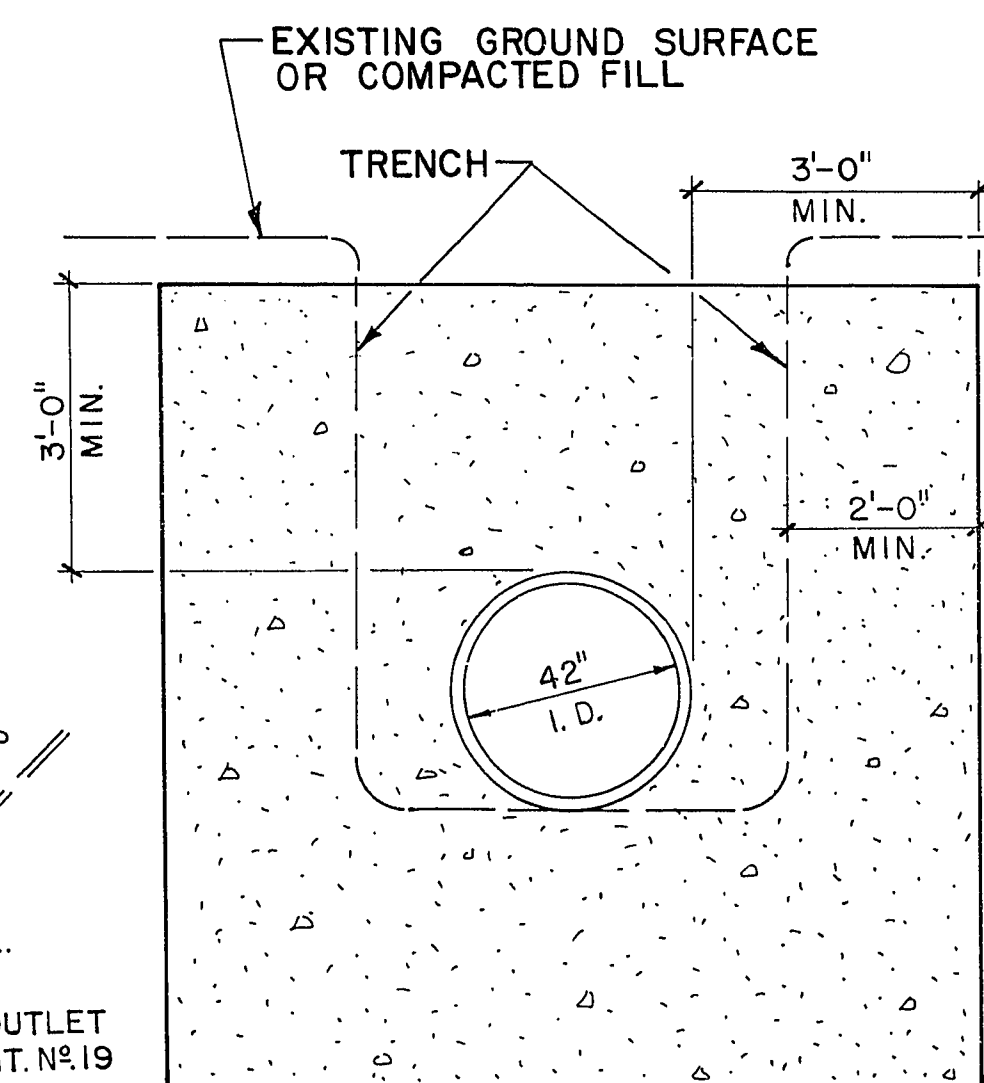


TRENCH DETAIL
NO SCALE

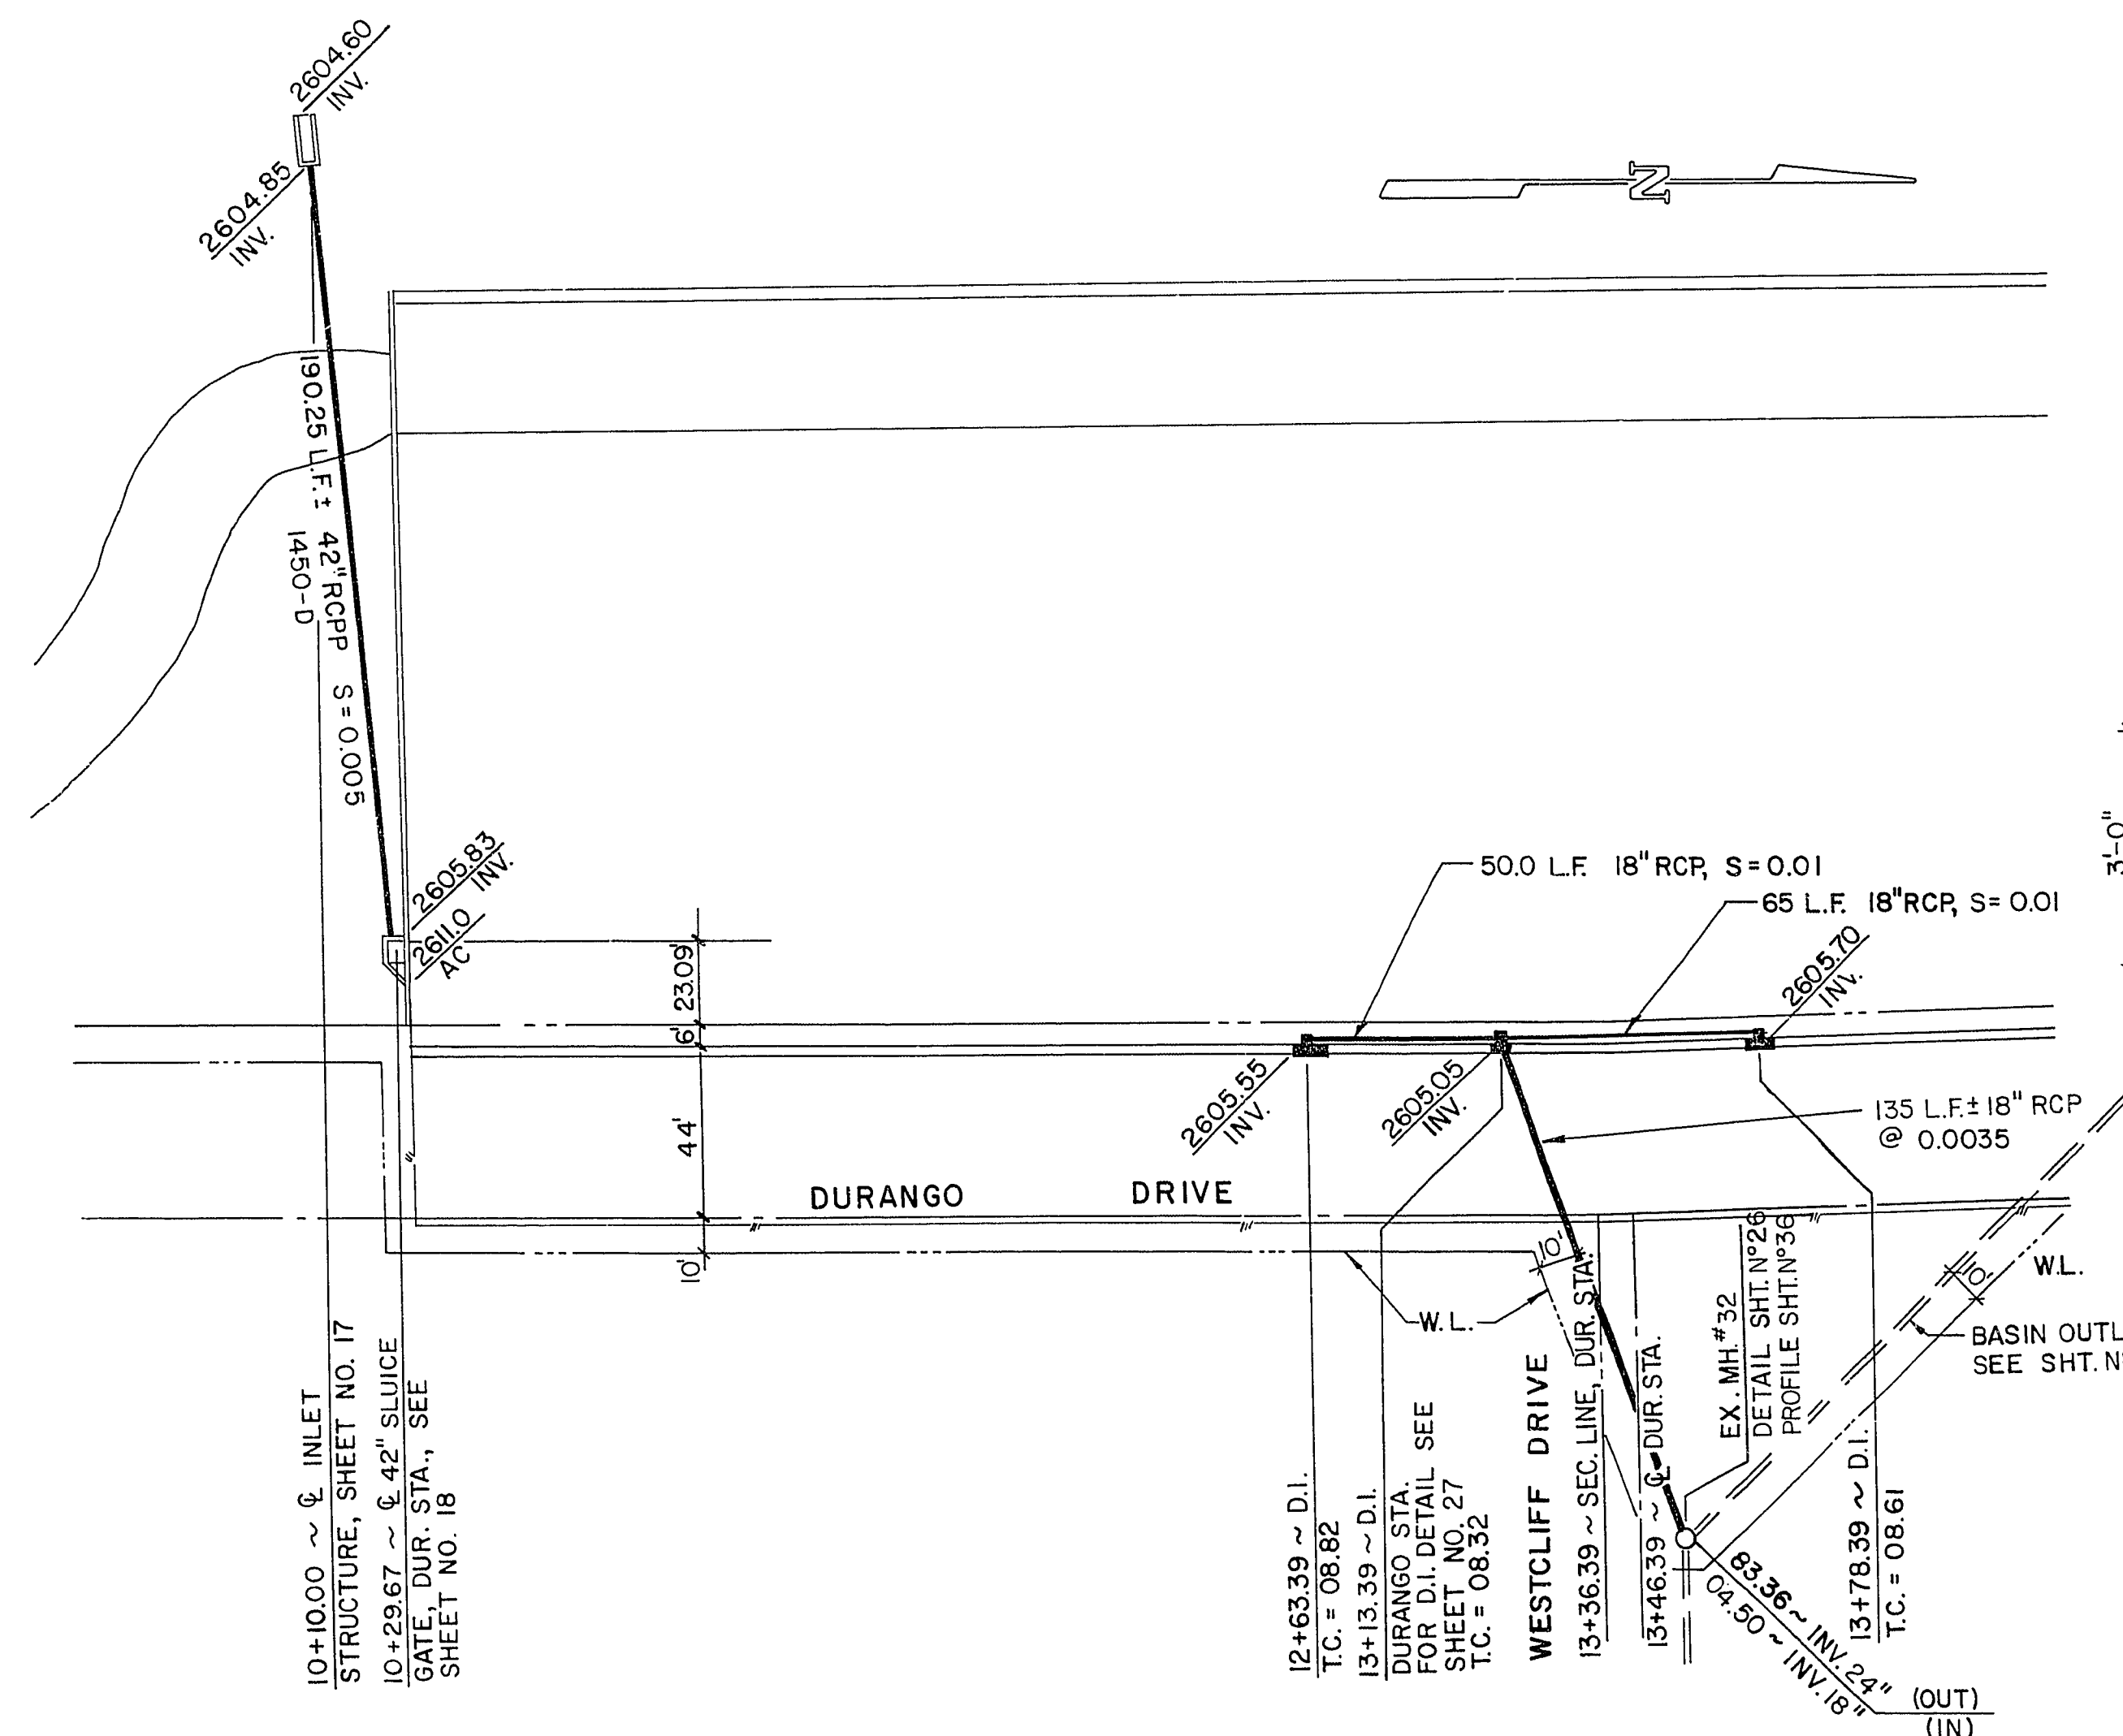

CUTOFF COLLAR DETAIL
NO SCALE

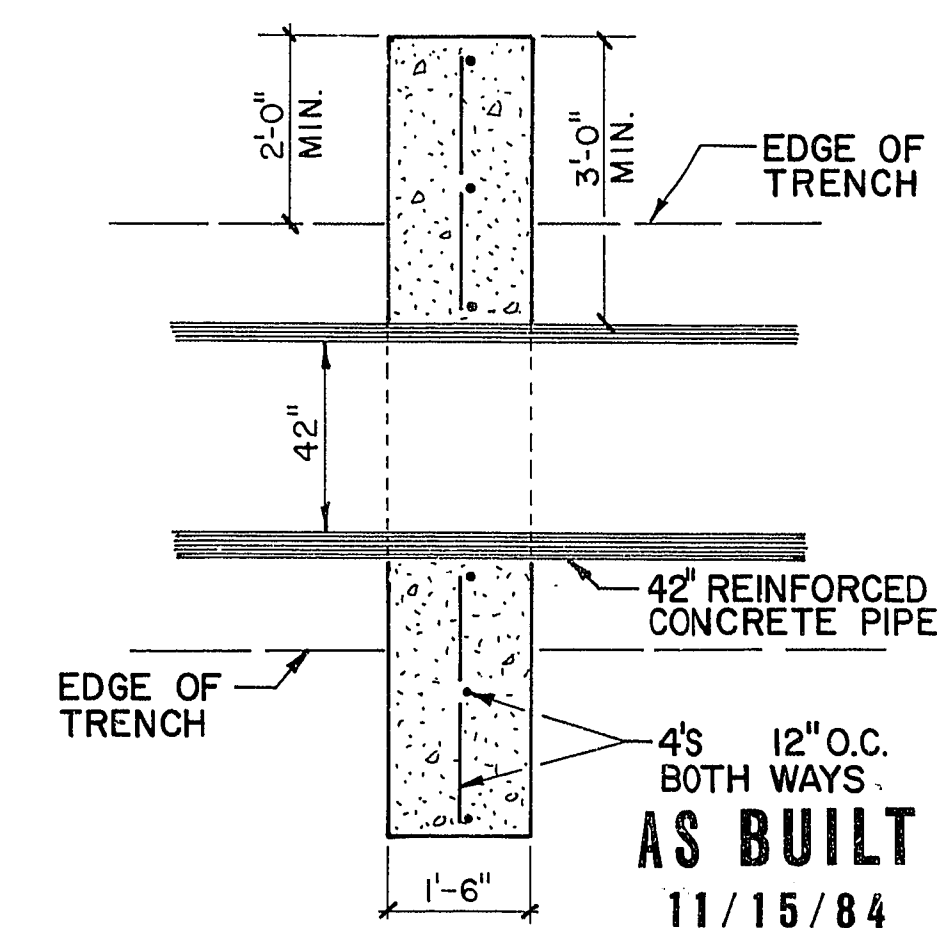

AS BUILT
11/15/84

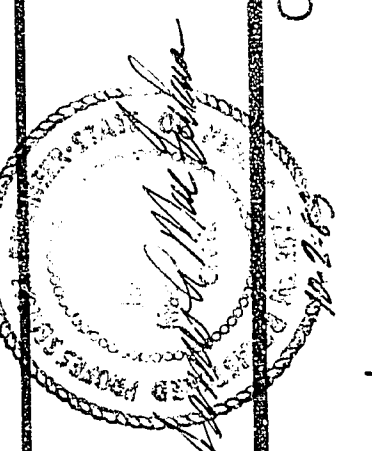

REV	DATE	BY	REVISION
1	10/2/83	RPF	ADD CUTOFF COLLAR
2	11/20/83	RPF	ADDED DROP INLET @ 12+63 & 13+78
3	11/6/83	EDY	LOC. MH #32
4	11/15/84	MW	REV. ELEVATIONS TO AS BUILT

CONSULTING ENGINEERS • PLANNERS
2900 WEST SAHARA AVENUE BUILDING 4 SUITE B
LAS VEGAS, NEVADA 89102 PHONE (702) 873-7550

EMERGENCY OUTLET PLAN & PROFILE

ANGEL PARK DETENTION BASIN
PHASE II A

WO NO.	3061
BY	RPF/MJB
DATE	10/2/83
SCALE	HOR. 1" = 40' VERT. 1" = 4'

SHEET	20
OF 36 SHEETS	