
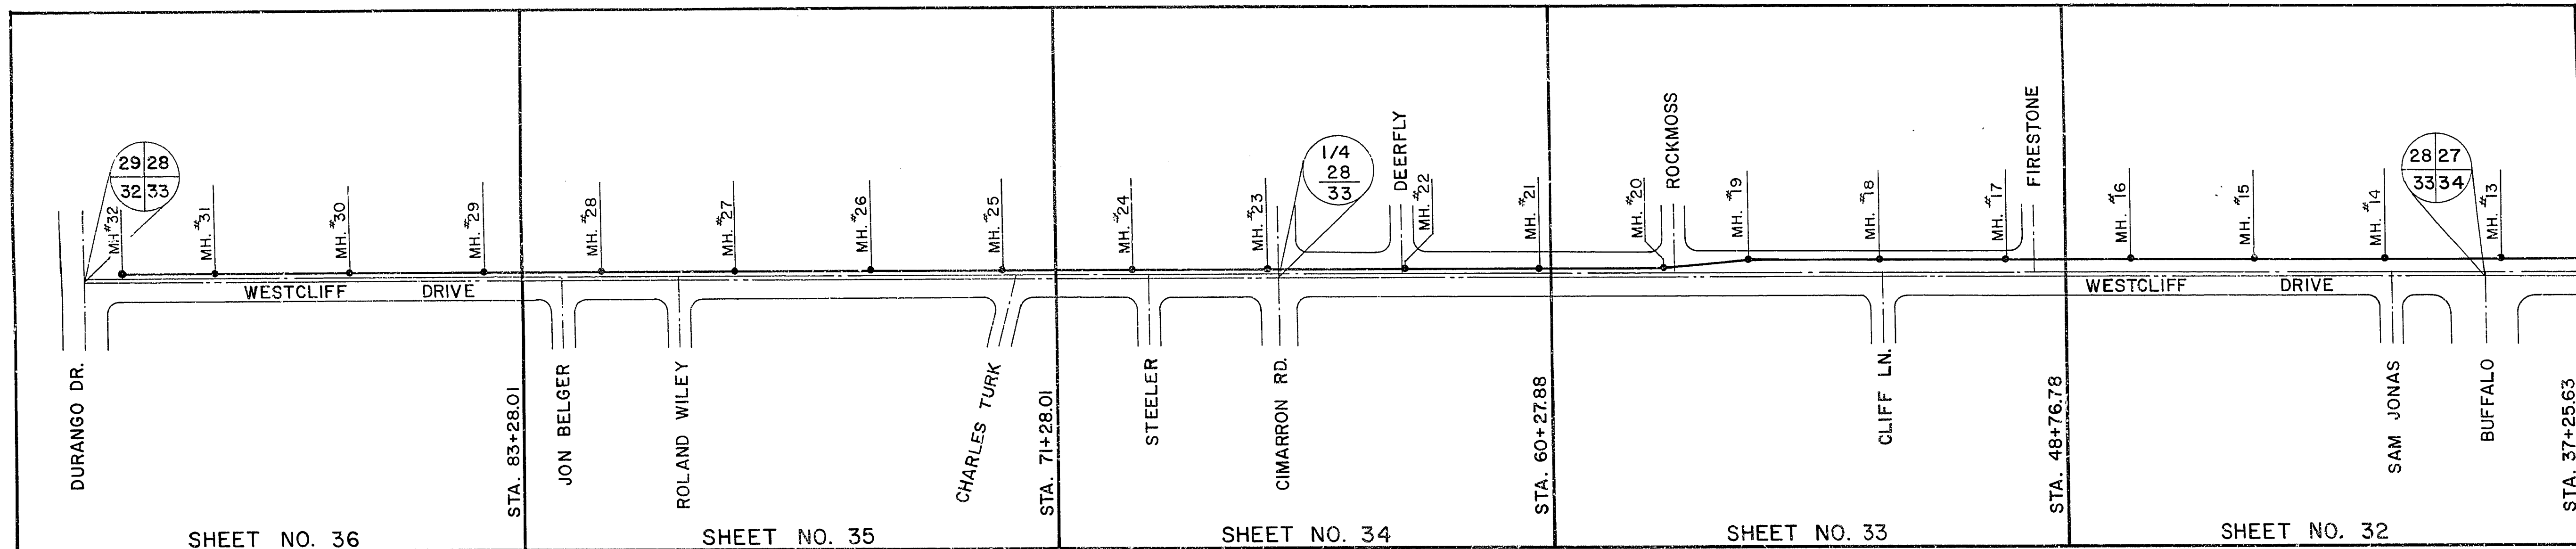


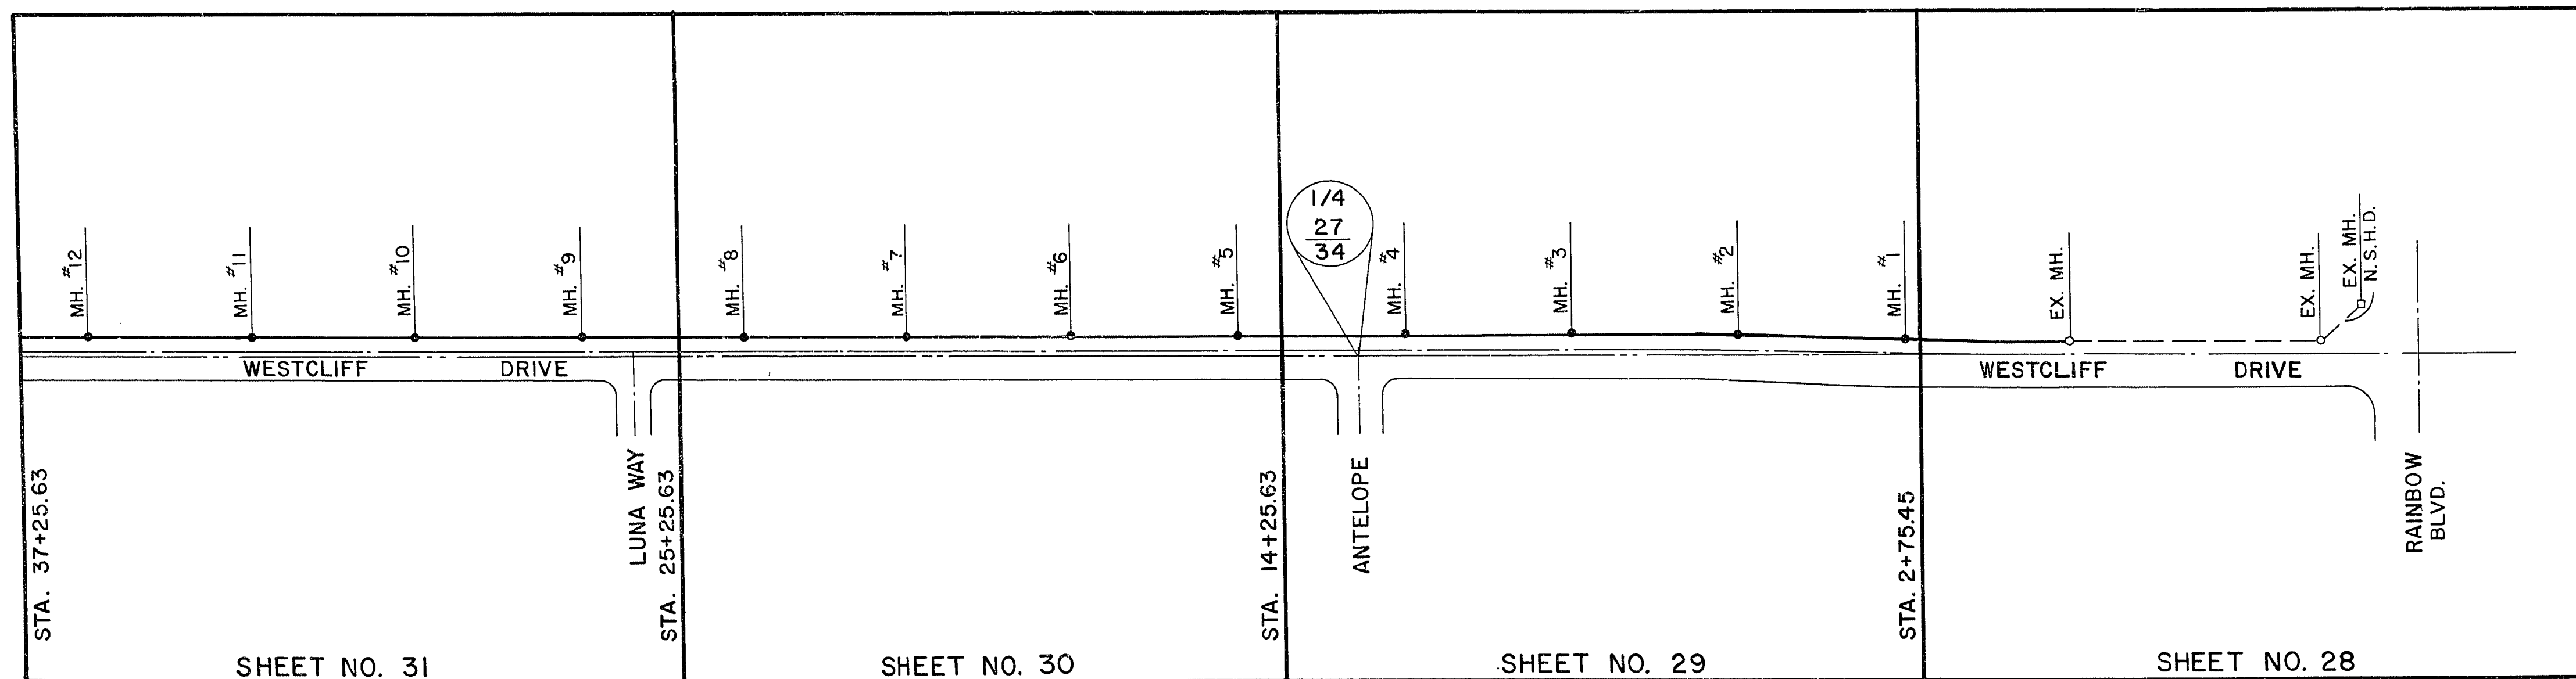

NOTE: ALL STATIONING ON SHEETS 28 THROUGH 36 IS PIPELINE STATIONING.

AS BUILT
11/15/84

WO NO.	3061
BY	RPF/MJB
DATE	10/2/83
SCALE	1" = 200'

SHEET	25
OF 36 SHEETS	

TITLE	BID GROUP II OVERALL & SHEET LAYOUT
PROJECT	ANGEL PARK OUTLET DRAIN CITY OF LAS VEGAS ANGEL PARK DETENTION BASIN

[Signature]
10/2/83

VTM nevada

CONSULTING ENGINEERS • PLANNERS
2800 WEST SAHARA AVENUE BUILDING 4 SUITE B
LAS VEGAS, NEVADA 89102 PHONE (702) 873-7550

REV	DATE	BY	REVISION
1	11/1/83	EDY	LOC. MH #32
2	1/24/84	MW	ADD NOTE PER ADDENDUM #1

9-13-127

650.14-7