

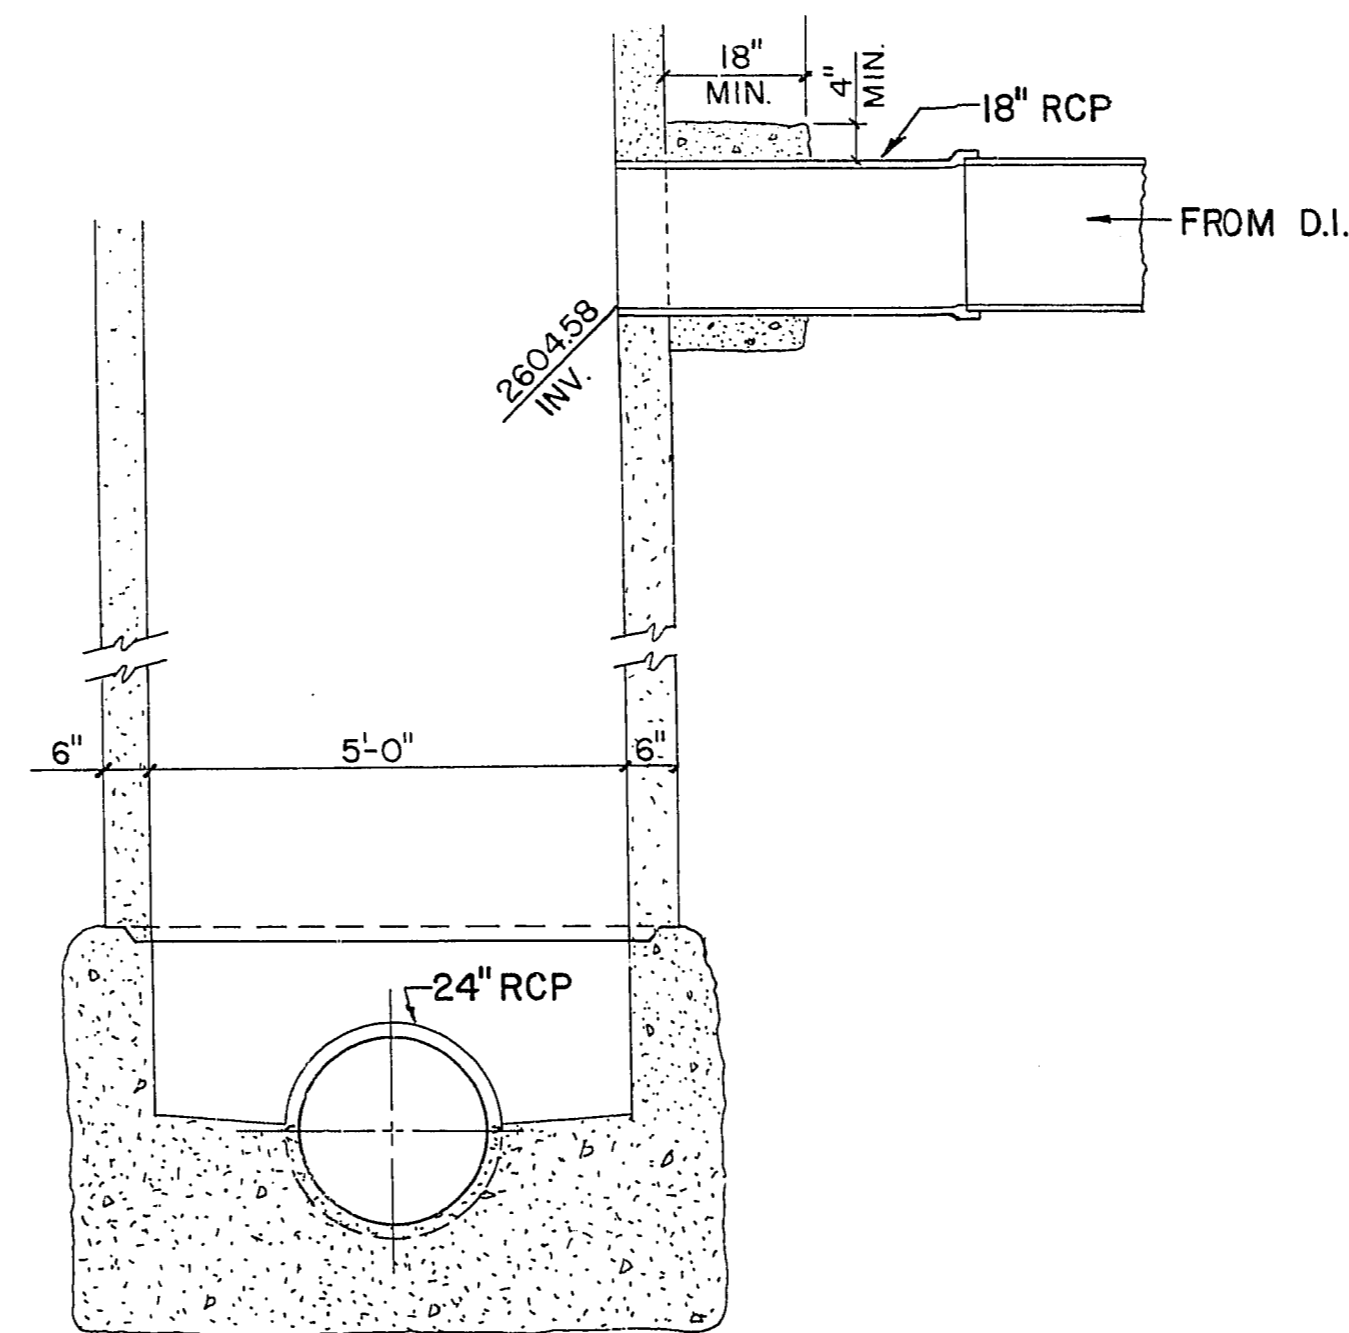



**MANHOLE DETAIL - TYPICAL**  
1/2" = 1'-0"

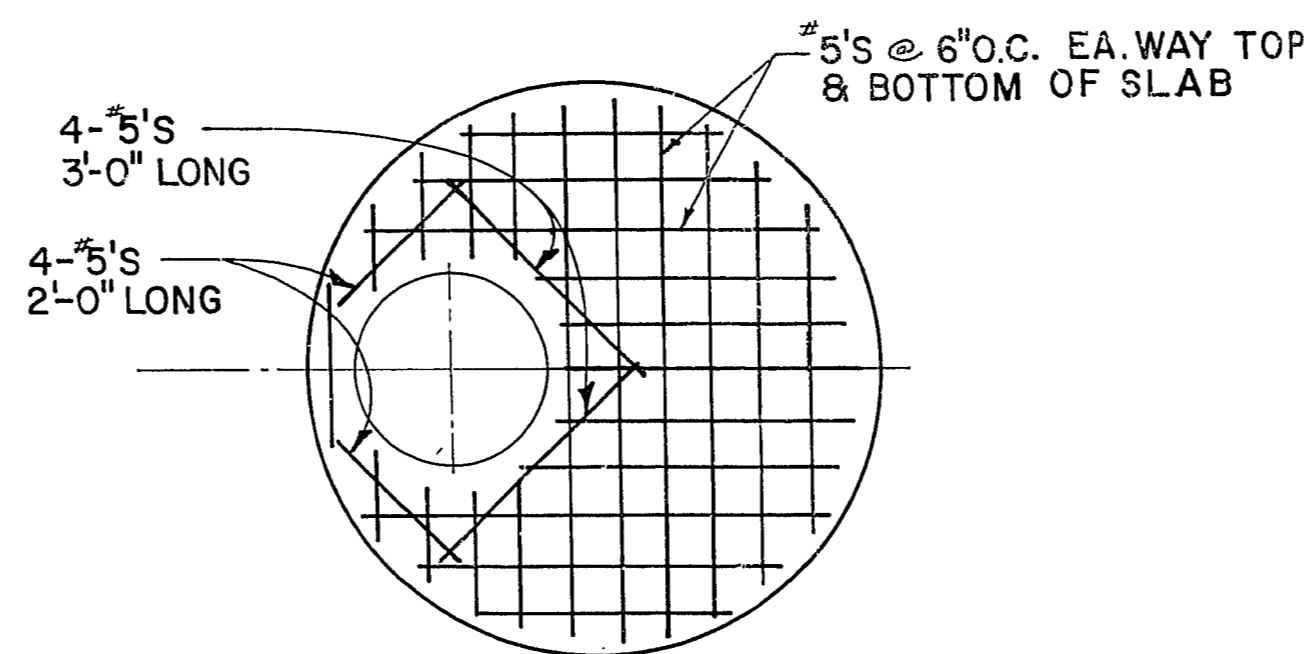

**DROP INLET CONNECTION (TYPICAL)**  
1/2" = 1'-0"

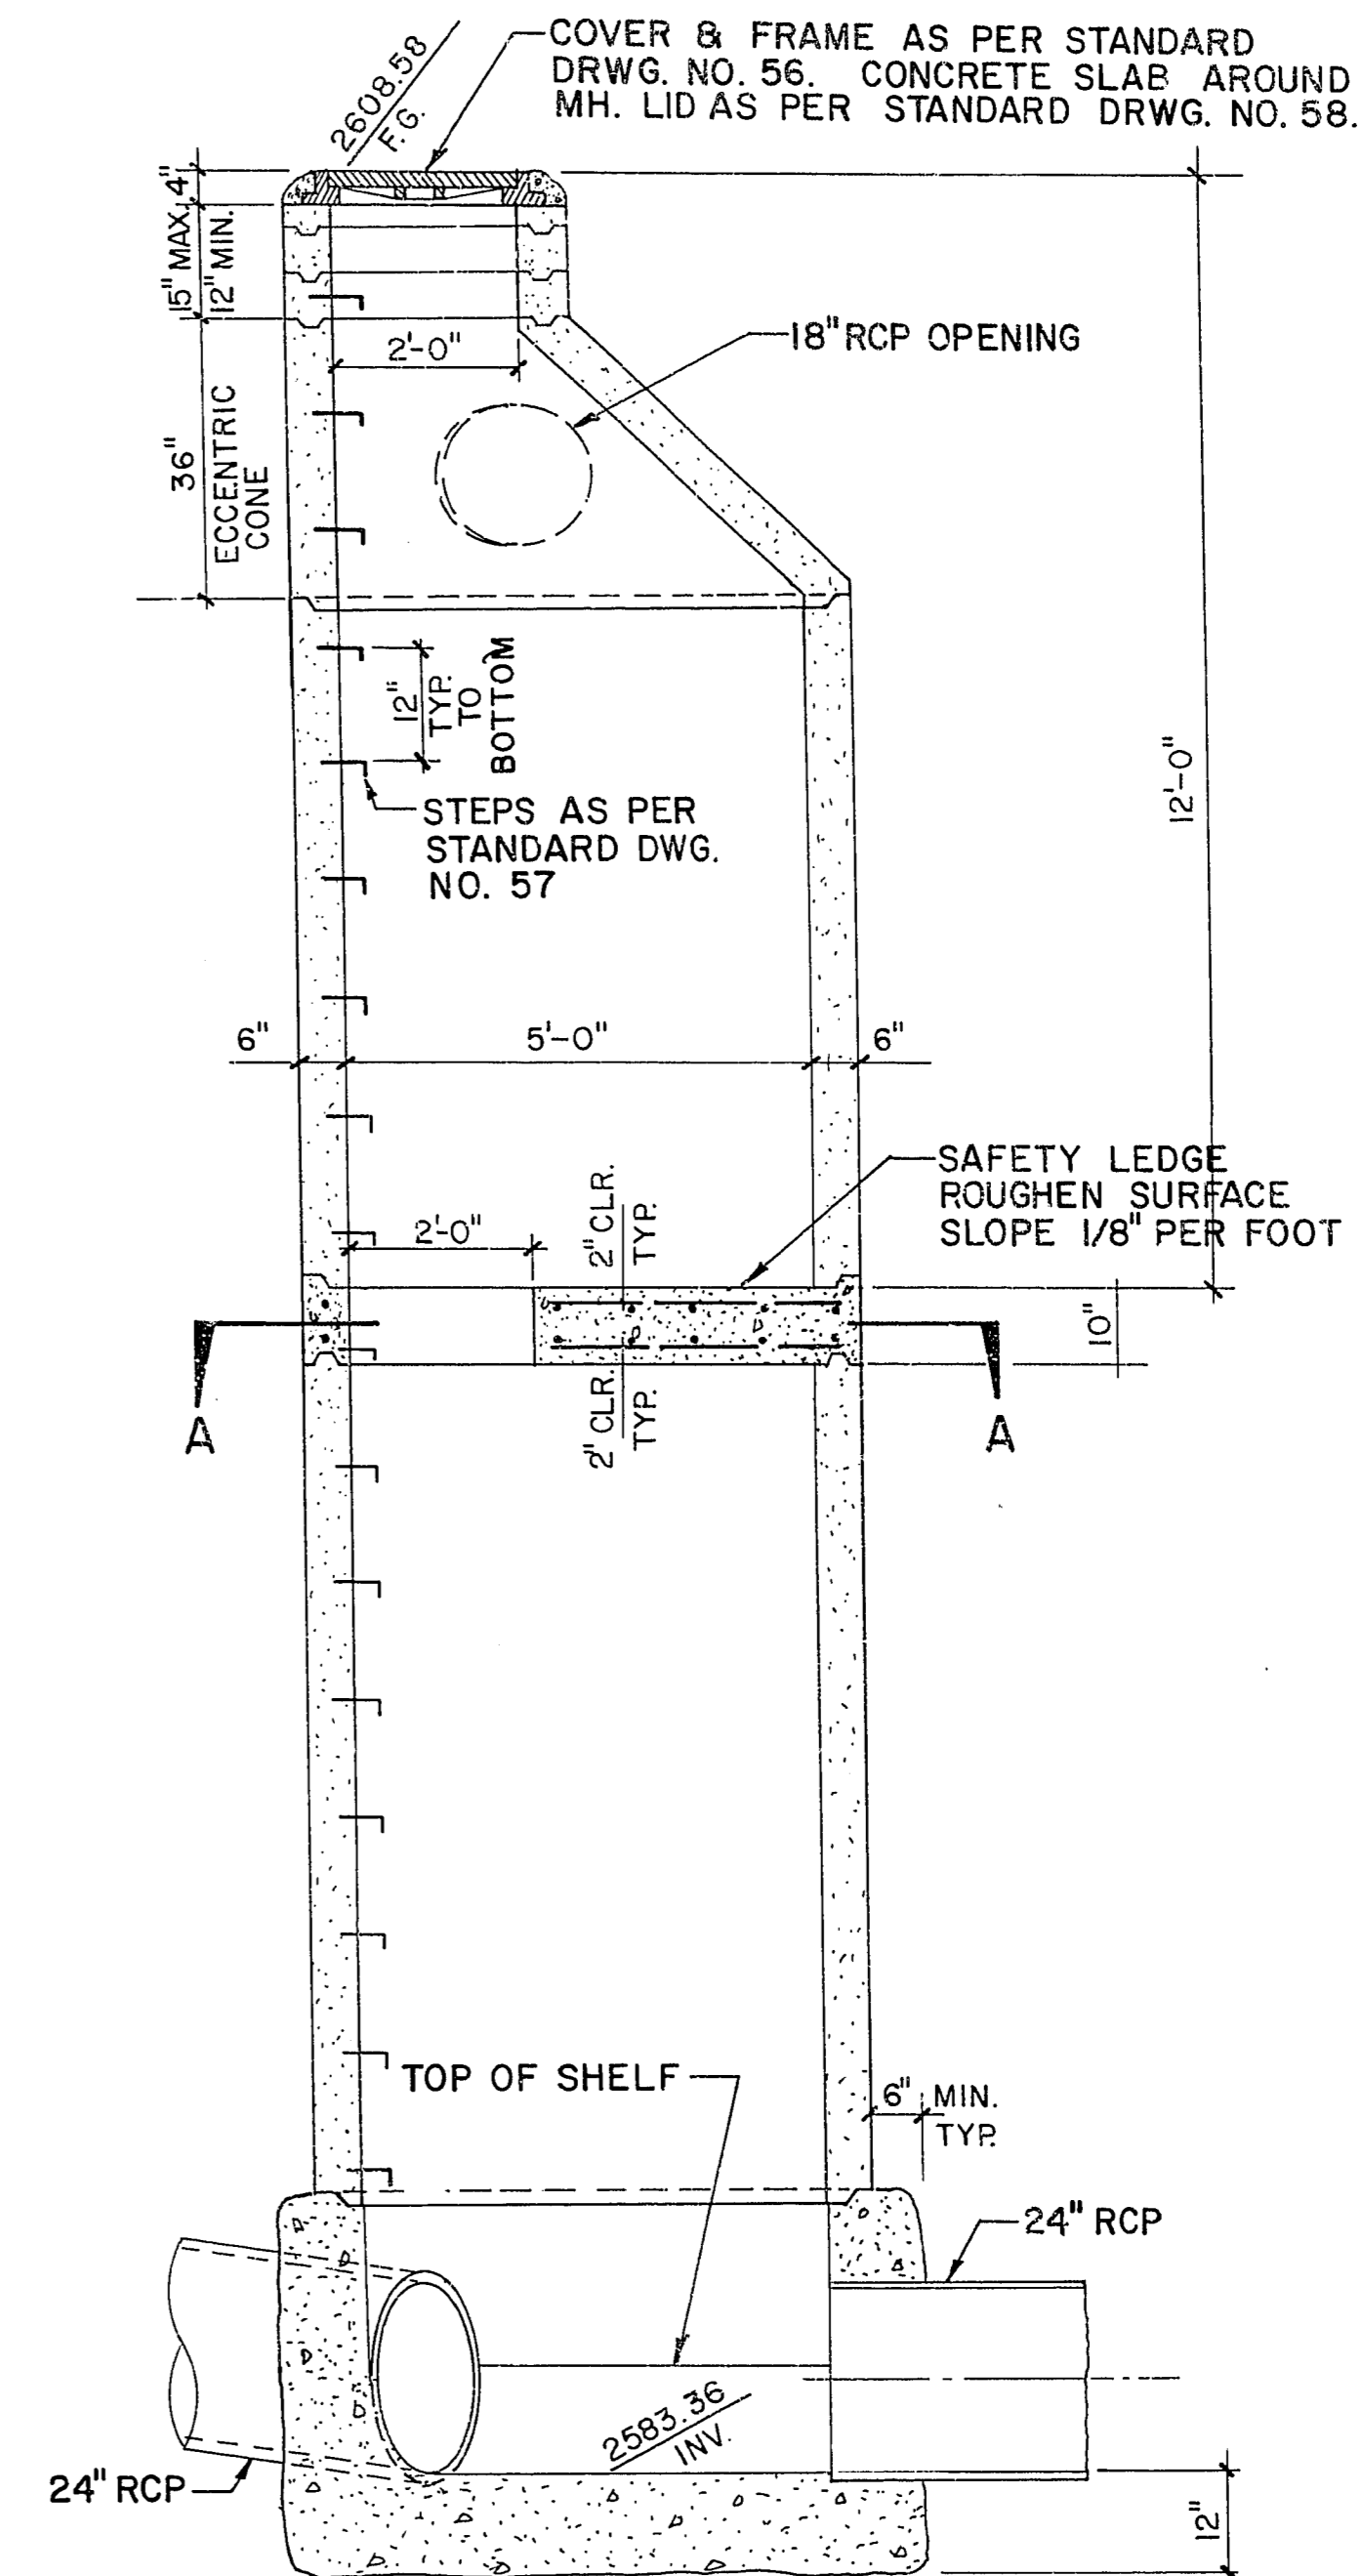


**SECTION "A-A"**  
1/2" = 1'-0"

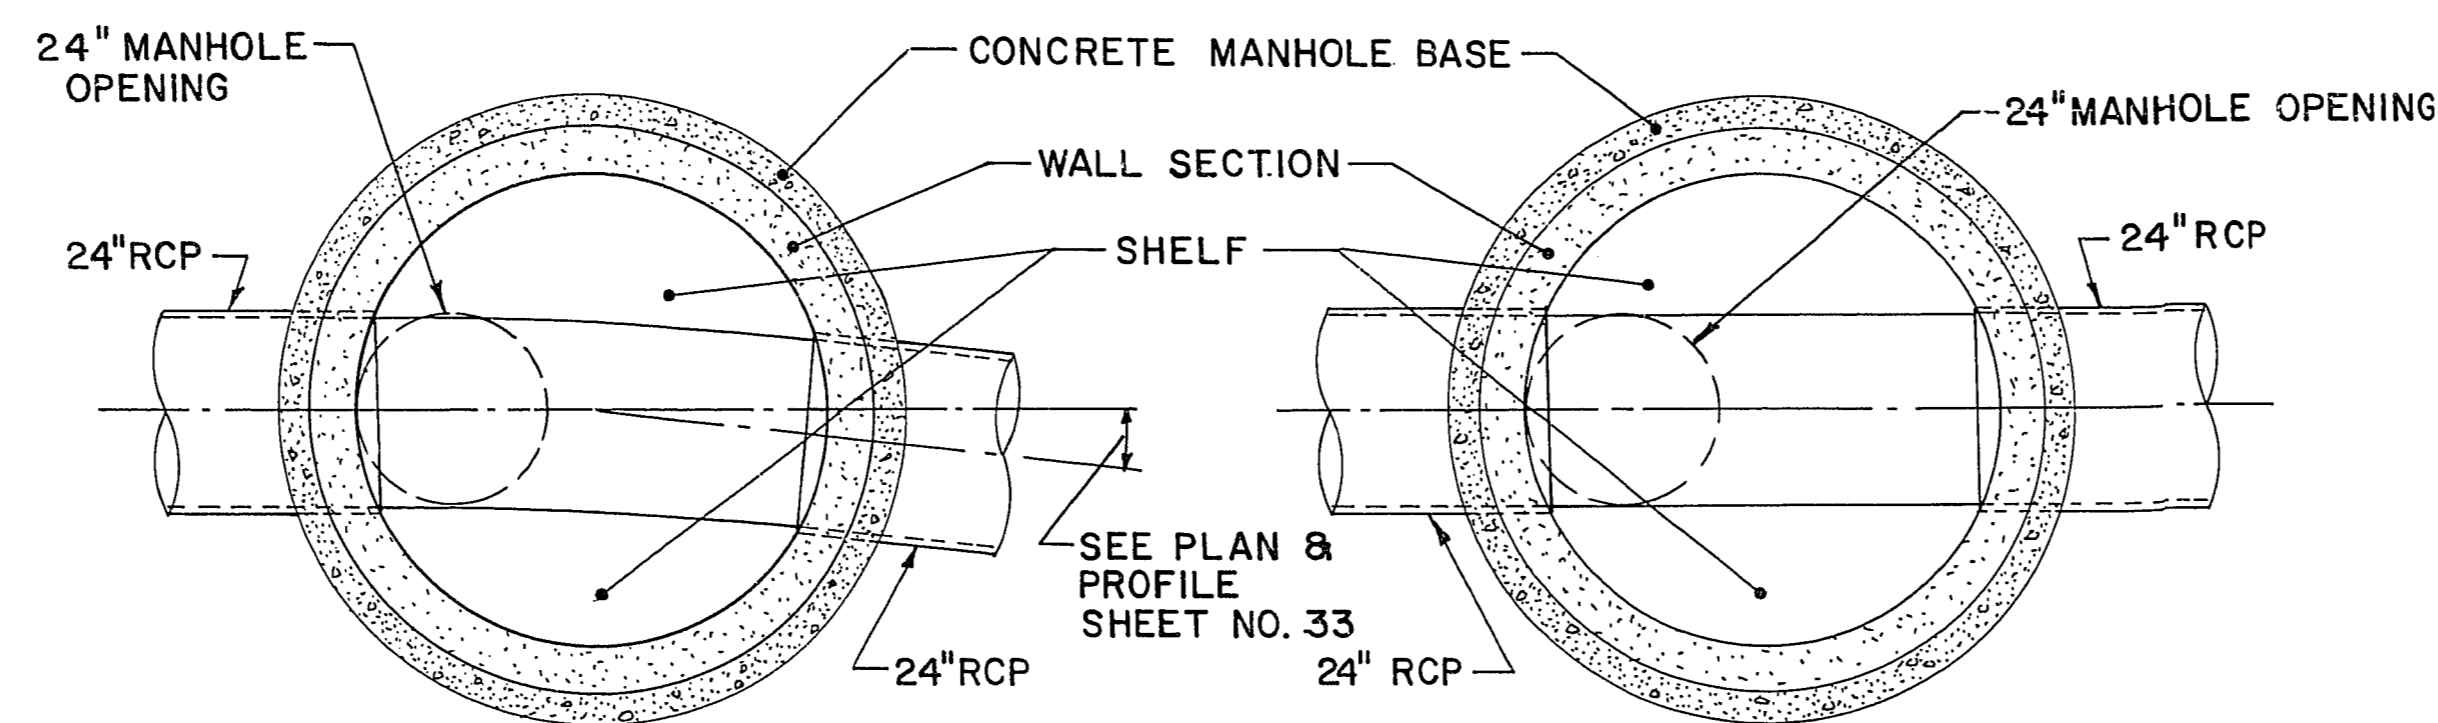

**MANHOLE BASES - MH. #19 & #20**  
1/2" = 1'-0"

**MANHOLE BASE-TYPICAL**  
1/2" = 1'-0"

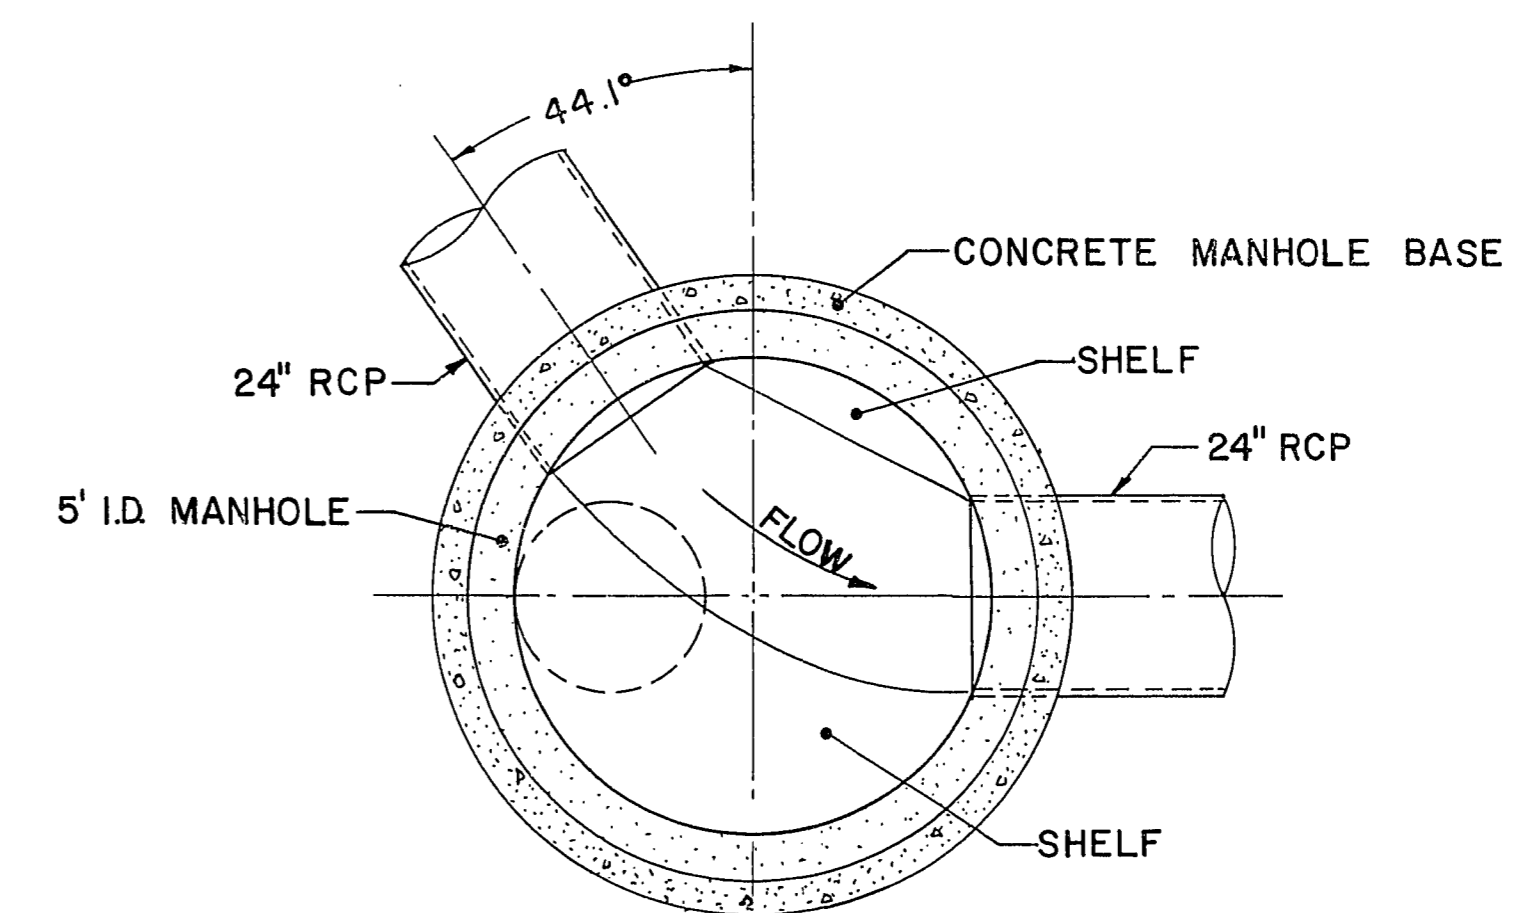

**MANHOLE 32**  
1/2" = 1'-0"

**AS BUILT**  
11/15/84

9-15-178

REVISION	DATE	BY	REVISION	DATE	BY
1	11/21/83	RPF			

COVER & FRAME AS PER STANDARD DRWG. NO. 56. CONCRETE SLAB AROUND MH. LID AS PER STANDARD DRWG. NO. 58.

CONSULTING ENGINEERS • PLANNERS  
2800 WEST SAHARA AVENUE BUILDING 4, SUITE B  
LAS VEGAS, NEVADA 89102 PHONE (702) 873-7560

vtm nevada

**MANHOLE DETAILS**

CITY OF LAS VEGAS  
ANGEL PARK DETENTION BASIN

TITLE PROJECT

W.O. NO. 3061  
BY RPF/MJB  
DATE 10/2/83  
SCALE AS NOTED

SHEET  
**26**  
OF 36 SHEETS