



9-13-135

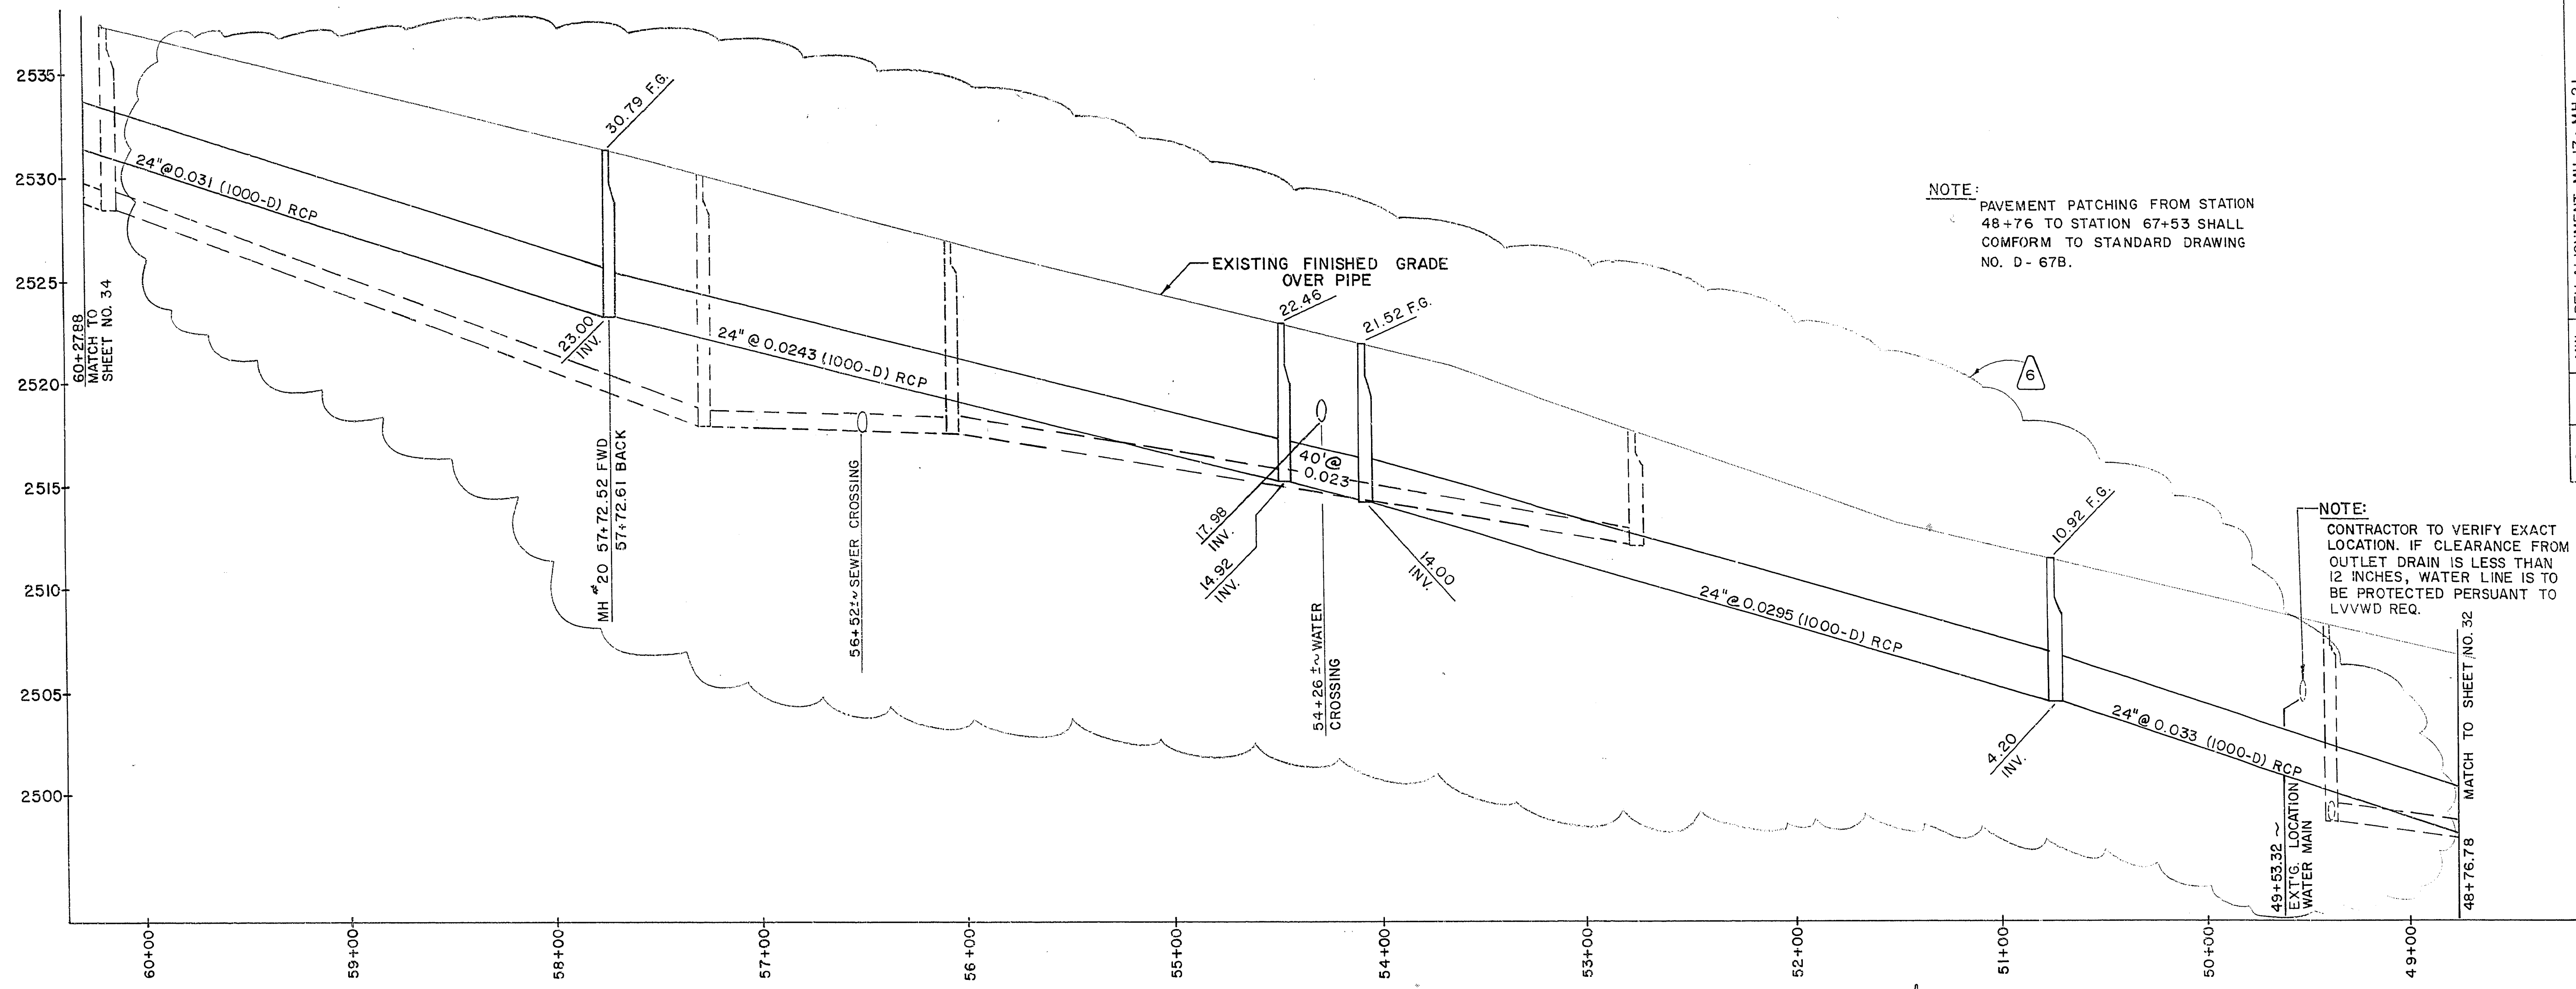

REV	DATE	BY	REVISION
6	3/28/84	MW	REV ALIGNMENT MH 17 + MH 21
5	3/28/84	MJB	REV ALIGNMENT MH 15 TO MH 21
1	10/6/83	RPF	D-LOADS ADDED
2	10/27/83	MJB	CHECK PRINTS LVVWD, S.W. GAS
3	10/28/83	EDY	ADDED W.L.
4	3/26/84	MW	REV. ALIGNMT. MH 15 TO MH 19

PLANNERS
BUILDING 4 SUITE B
LAS VEGAS, NEVADA 89102 PHONE (702) 873-7550

CONSULTING ENGINEERS
P-5833
vtn nevada

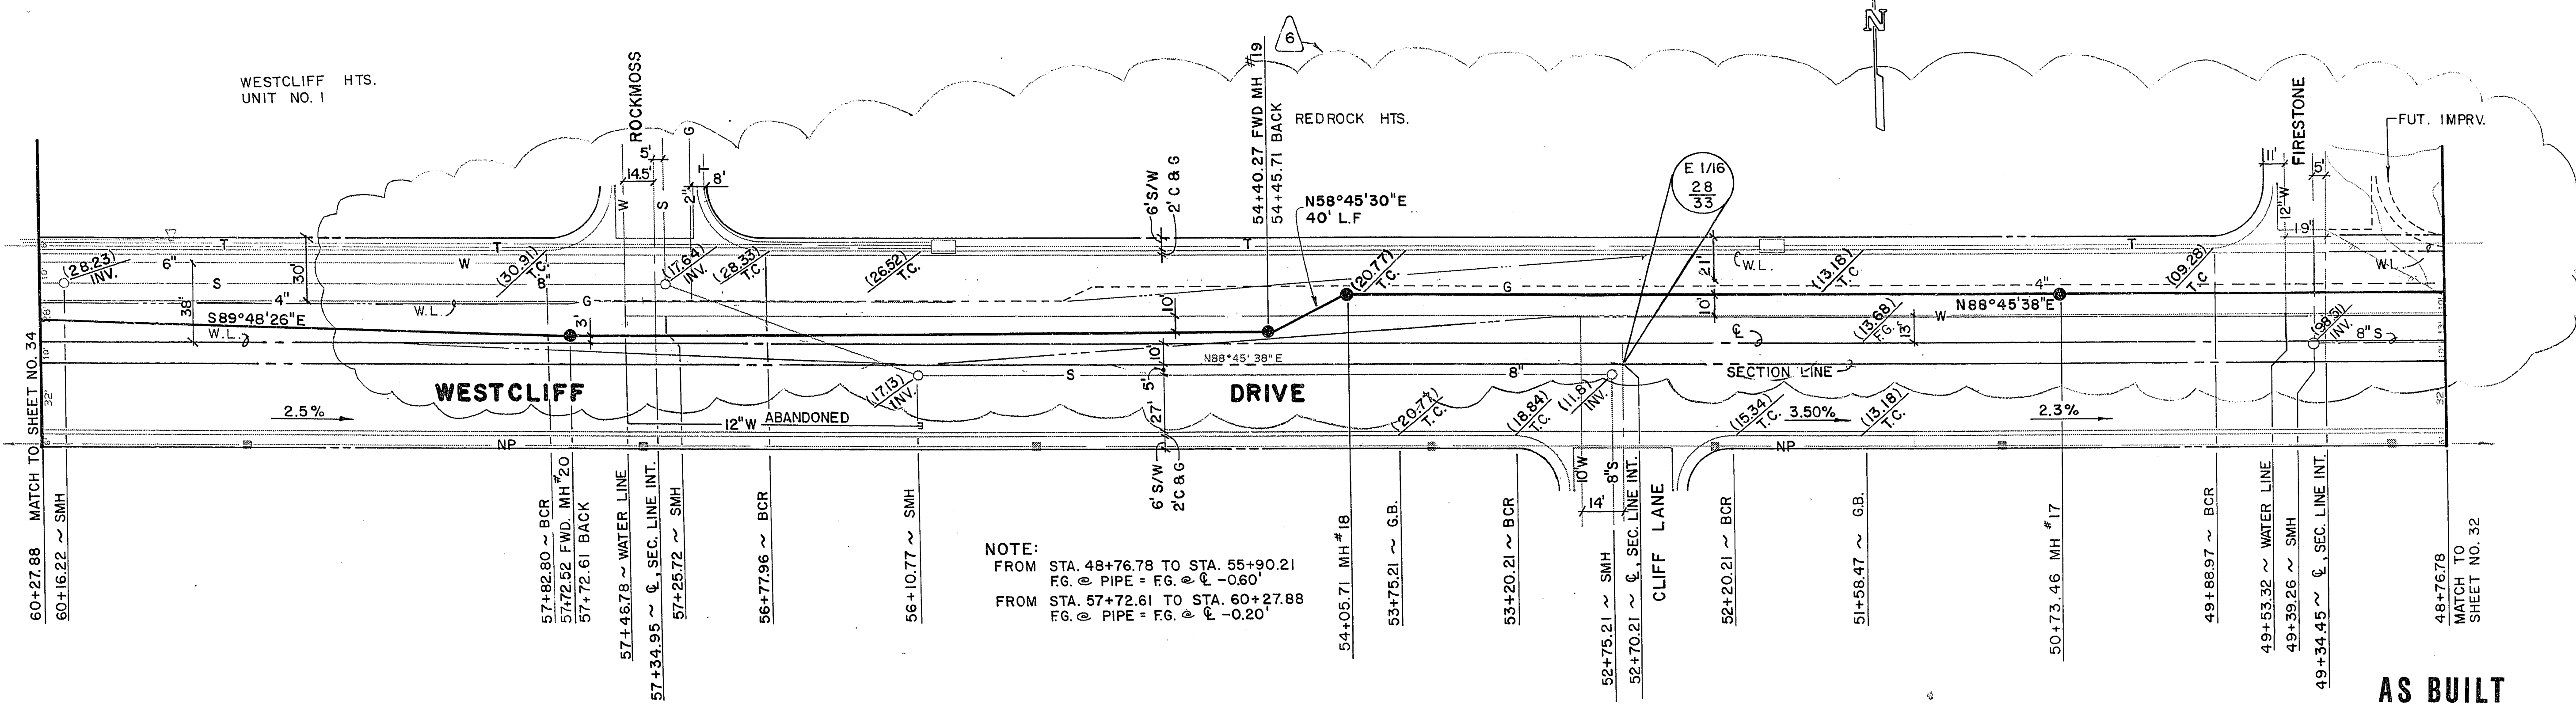

NOTE:
FROM STA. 48+76.78 TO STA. 55+90.21
F.G. @ PIPE = F.G. @ P - 0.00'
FROM STA. 57+72.61 TO STA. 60+27.88
F.G. @ PIPE = F.G. @ P - 0.20'

AS BUILT
11/15/84

PLAN AND PROFILE
ANGEL PARK OUTLET DRAIN
CITY OF LAS VEGAS
ANGEL PARK DETENTION BASIN

PROJECT

WO NO. 3061
BY MJB/RPF
DATE 10/2/83
SCALE HOR: 1" = 40'
VERT: 1" = 4'

SHEET
33
OF 36 SHEETS

650.14-7