
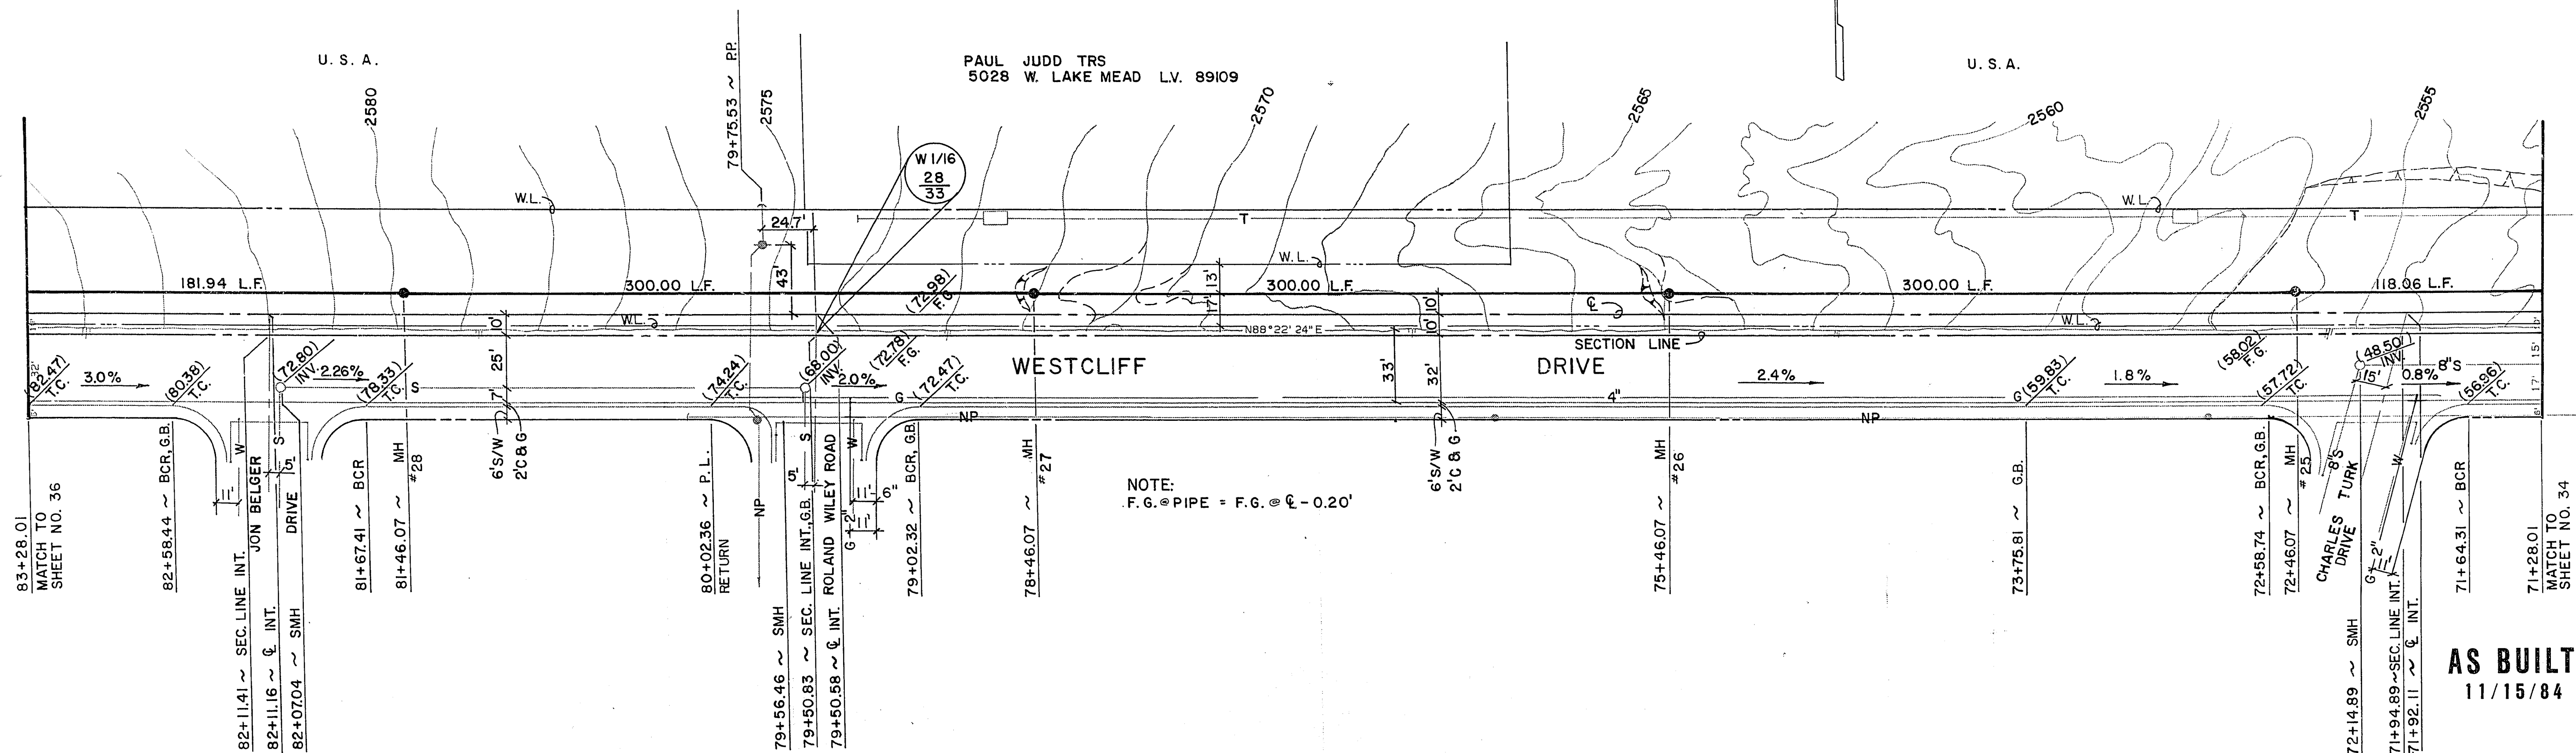


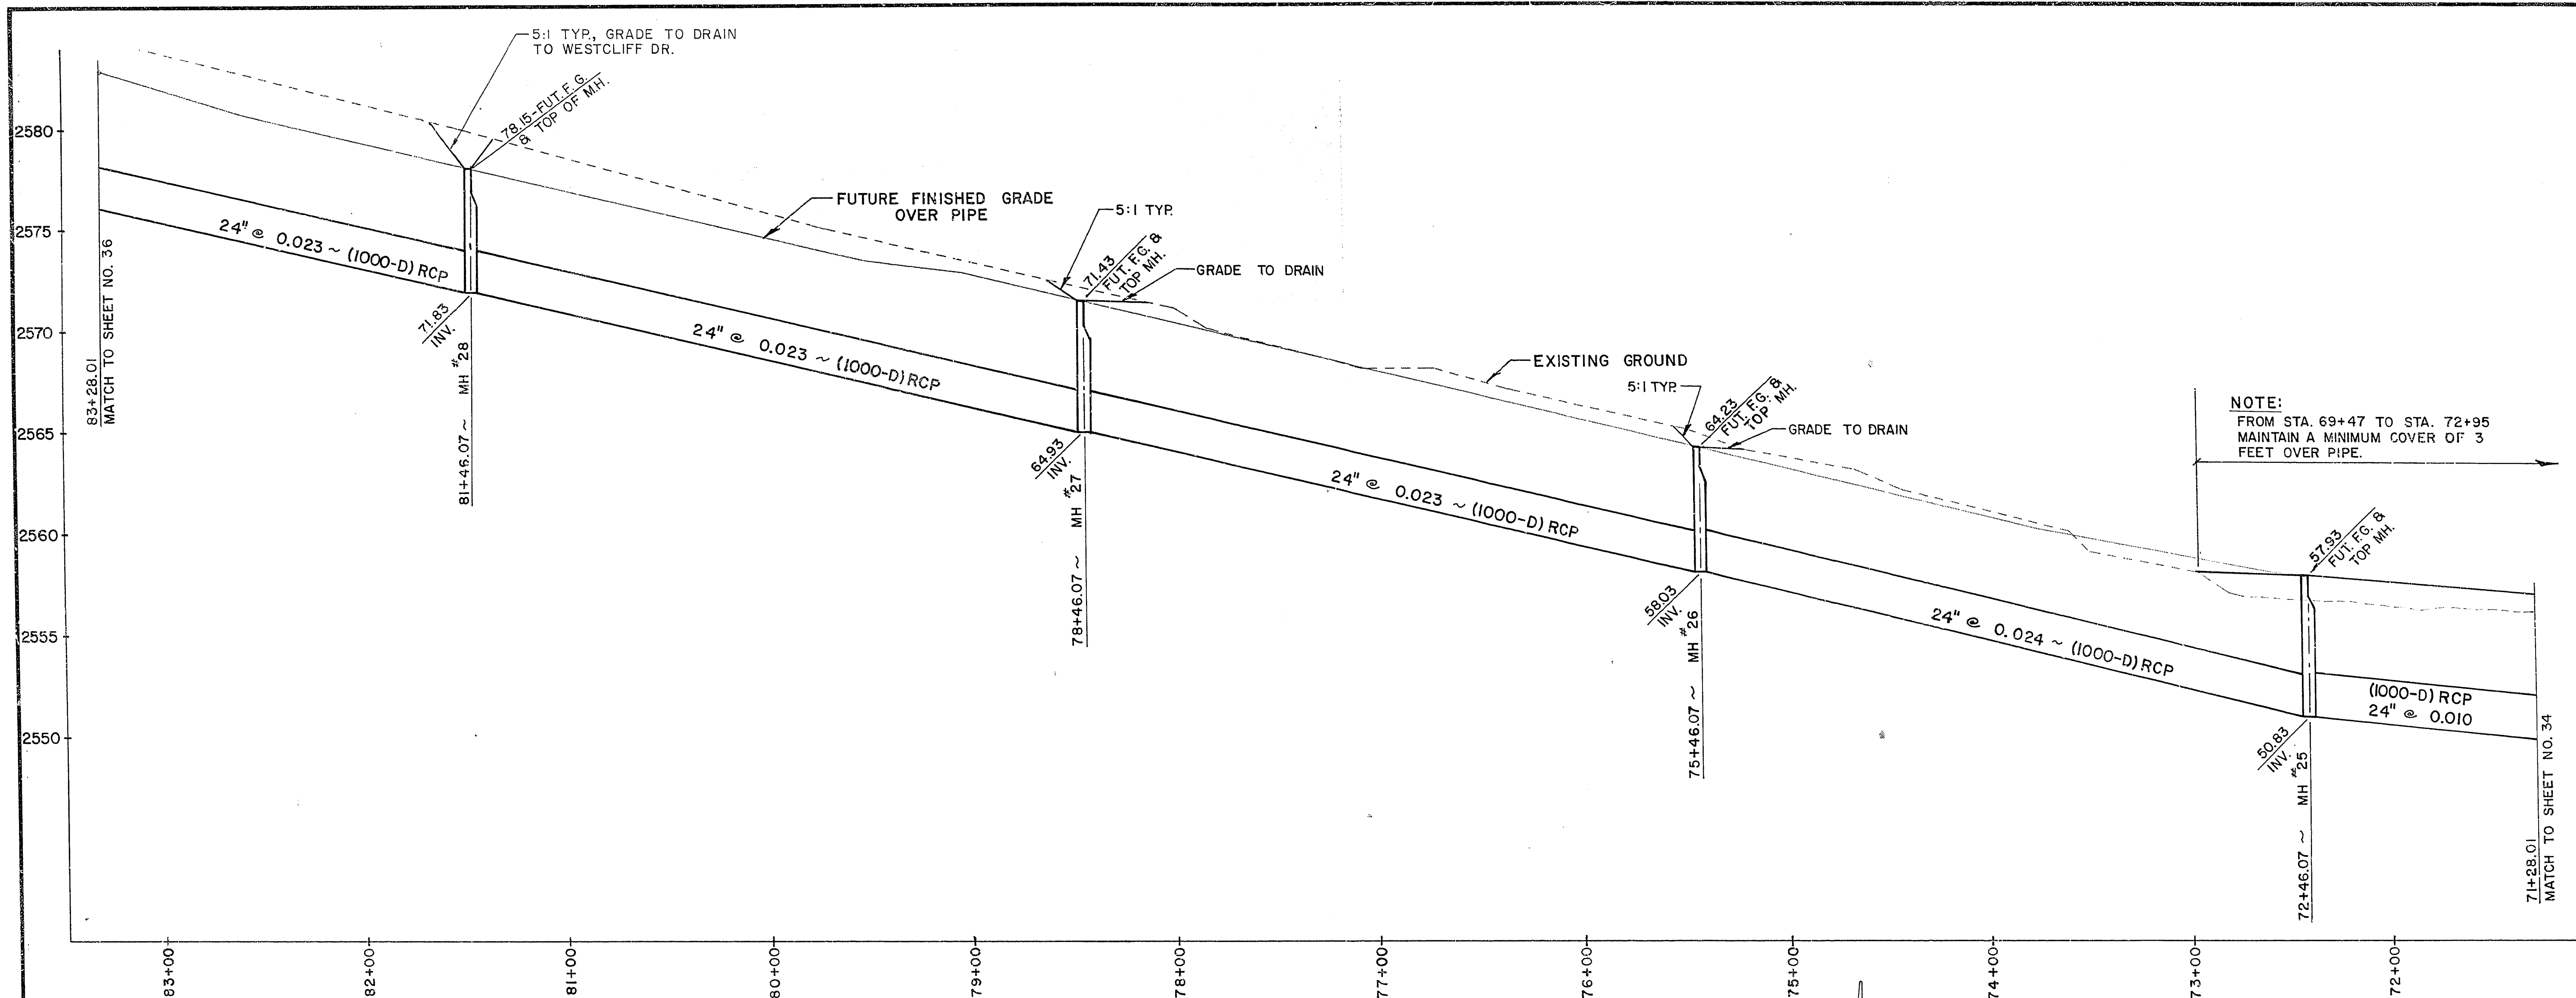

REV	DATE	BY	REVISION
1	10/6/83	RPF	D-LOADS ADDED
2	11/21/83	RPF	ADDED TOP OF MH. ELEV.
3	10/28/83	EDY	ADDED W.L.

PLANNERS

ENGINEERS

CONSULTING

2800 WEST SAHARA AVENUE BUILDING 4 SUITE B

LAS VEGAS, NEVADA 89102 PHONE (702) 873-7550

11-2-83

neveda

TITLE

PLAN AND PROFILE

ANGEL PARK OUTLET DRAIN

PROJECT

CITY OF LAS VEGAS

ANGEL PARK DETENTION BASIN

WO NO. 3061

BY MJB/RPF/ED

DATE 10/2/83

SCALE HOR: 1" = 40'

VERT: 1" = 4'

SHEET

35

OF 36 SHEETS

AS BUILT

11/15/84