
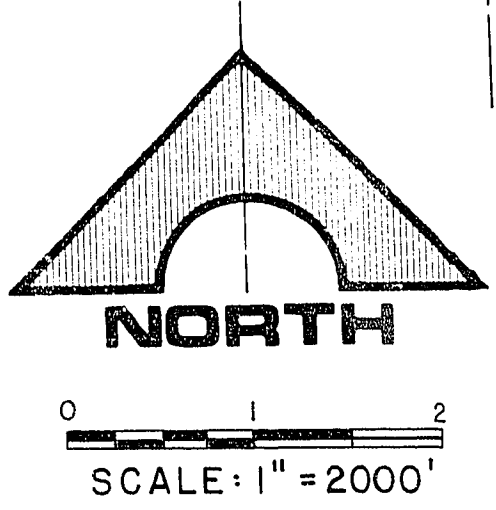
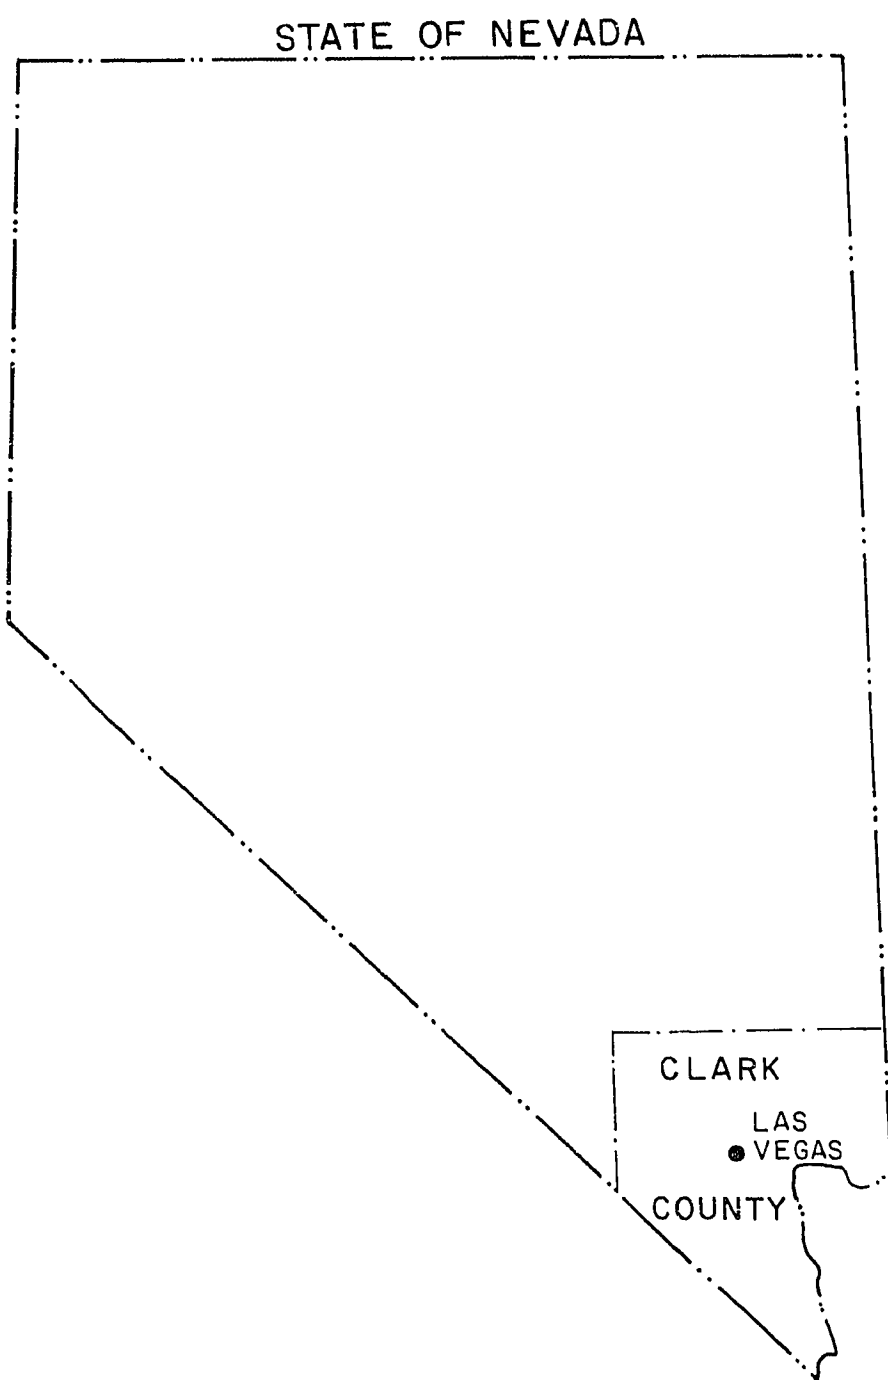


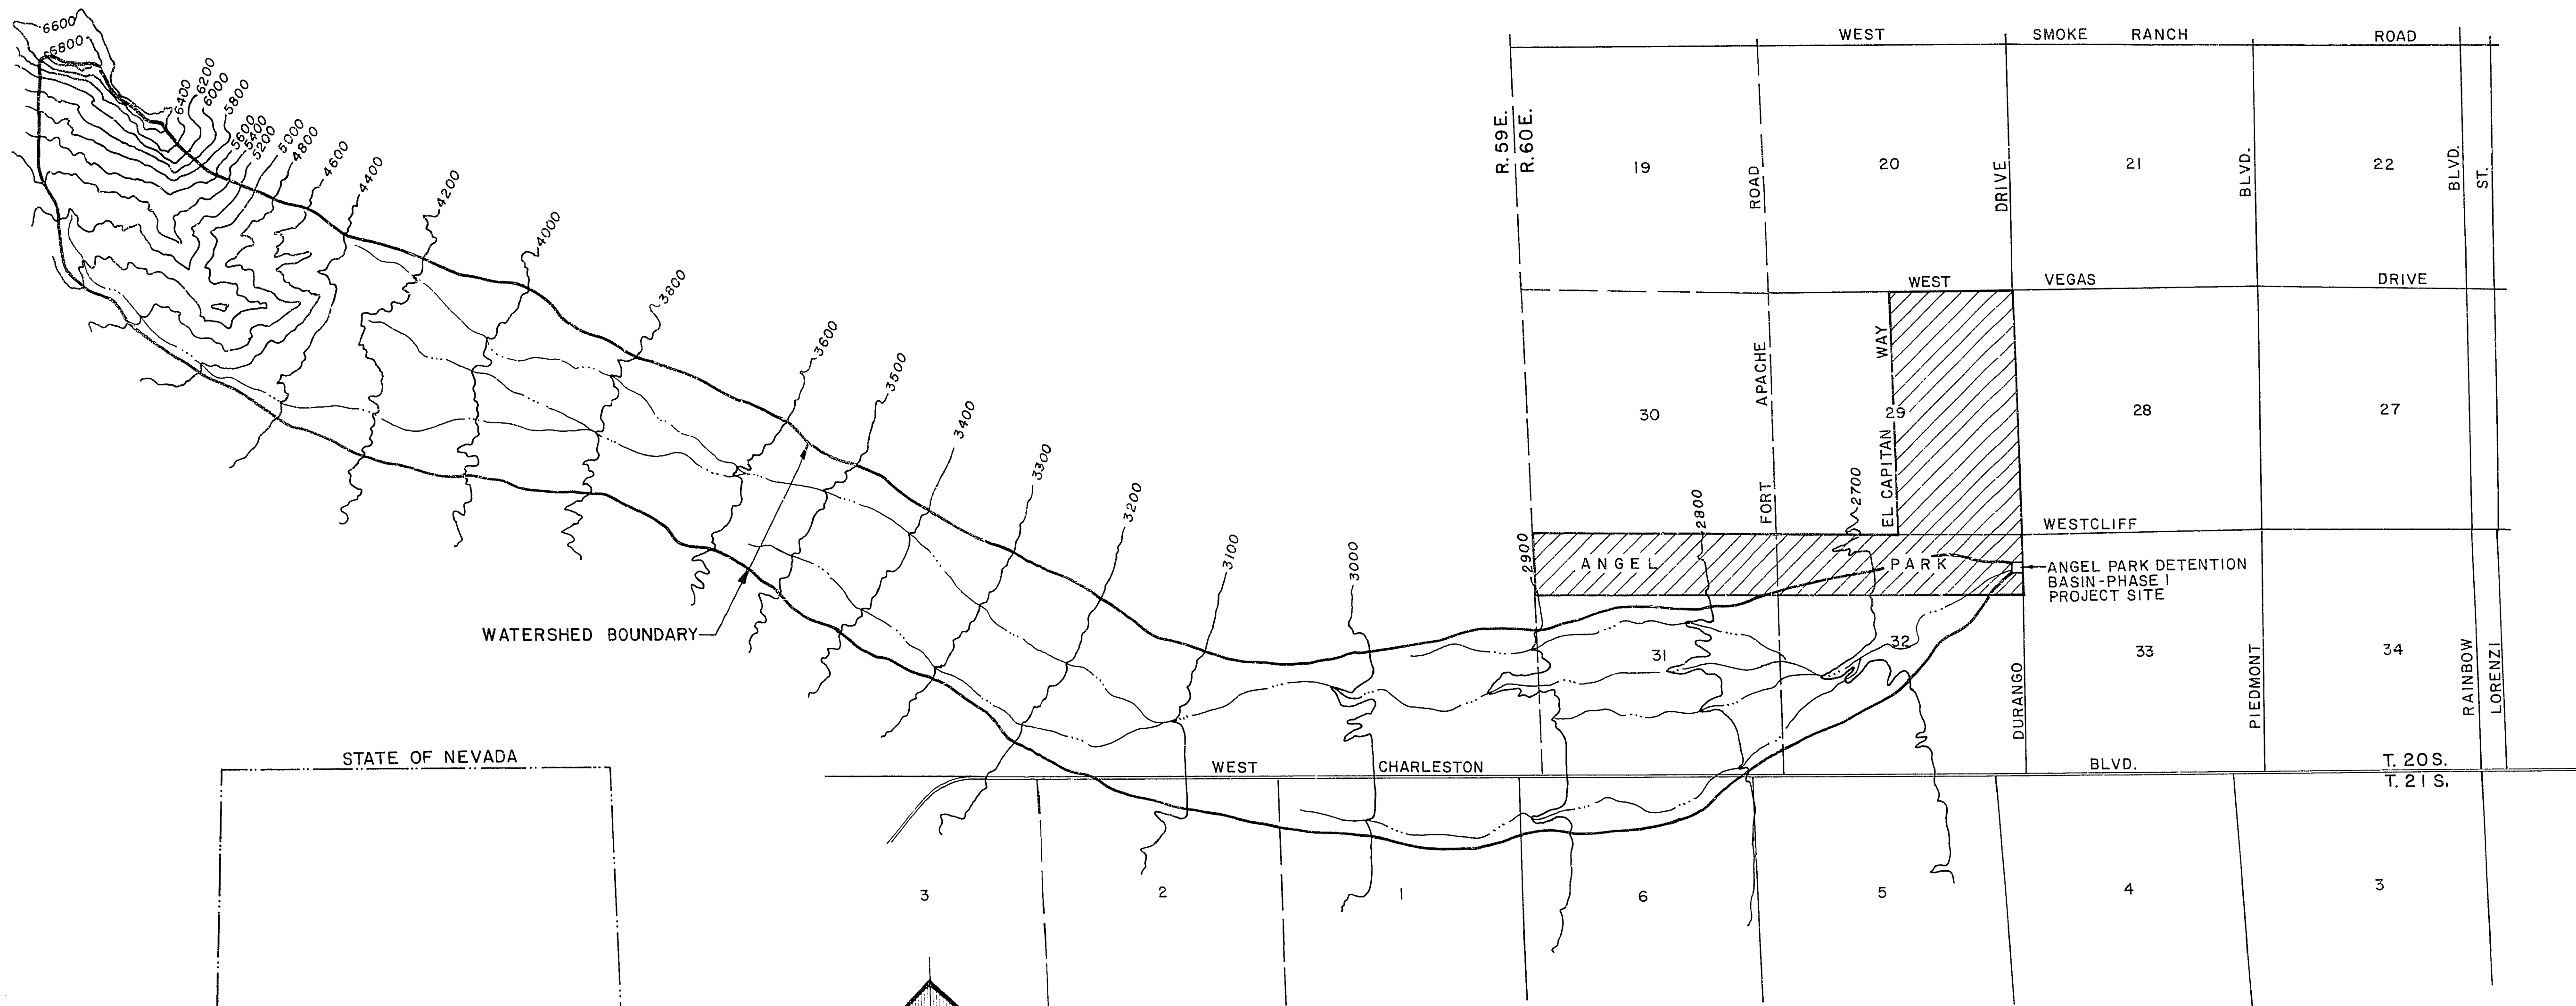

WATERSHED BOUNDARY & ANGEL PARK LOCATION MAP

REFERENCE
BLUE DIAMOND NE. 8
LA MADRE MTN. 7.5 MINUTE
U.S.G.S. QUADRANGLE MAPS

WATERSHED AREA = 6.32 MILES

BENCH MARK

USGS BLM BRASS CAP, NORTHEAST CORNER
SECTION 32, T.20 S., R.60 E., M.D.M., CITY OF
LAS VEGAS, CLARK COUNTY, NEVADA.
ELEV. = 2609.31

BASIS OF BEARING:

N. 00° 18' 42" W. - BEING THE EAST LINE OF
THE NORTHEAST QUARTER (NE 1/4) OF THE
NORTHEAST QUARTER (NE 1/4) OF SECTION
32, T. 20 S., R. 60 E., M.D.M. CITY OF LAS VEGAS,
CLARK COUNTY, NEVADA

AS BUILT DRAWING

9-13-10

REV	DATE	DESCRIPTION
1	9/26/10	AS BUILT - NO REVISIONS

CONSULTING ENGINEERS • PLANNERS
1100 East Sahara Ave. • Las Vegas, Nevada 89104 • 702-3330

G.C. WALLACE
Consulting Engineers, Inc.
1100 East Sahara Ave. • Las Vegas, Nevada 89104 • 702-3330

CITY OF LAS VEGAS, NEVADA
ANGEL PARK DETENTION BASIN
VICINITY MAP, WATERSHED BOUNDARY MAP AND
LOCATION MAP
SECTION 32, T. 20 S., R. 60 E., M.D.B. 8M.

SHEET
2
OF 9 SHEETS