


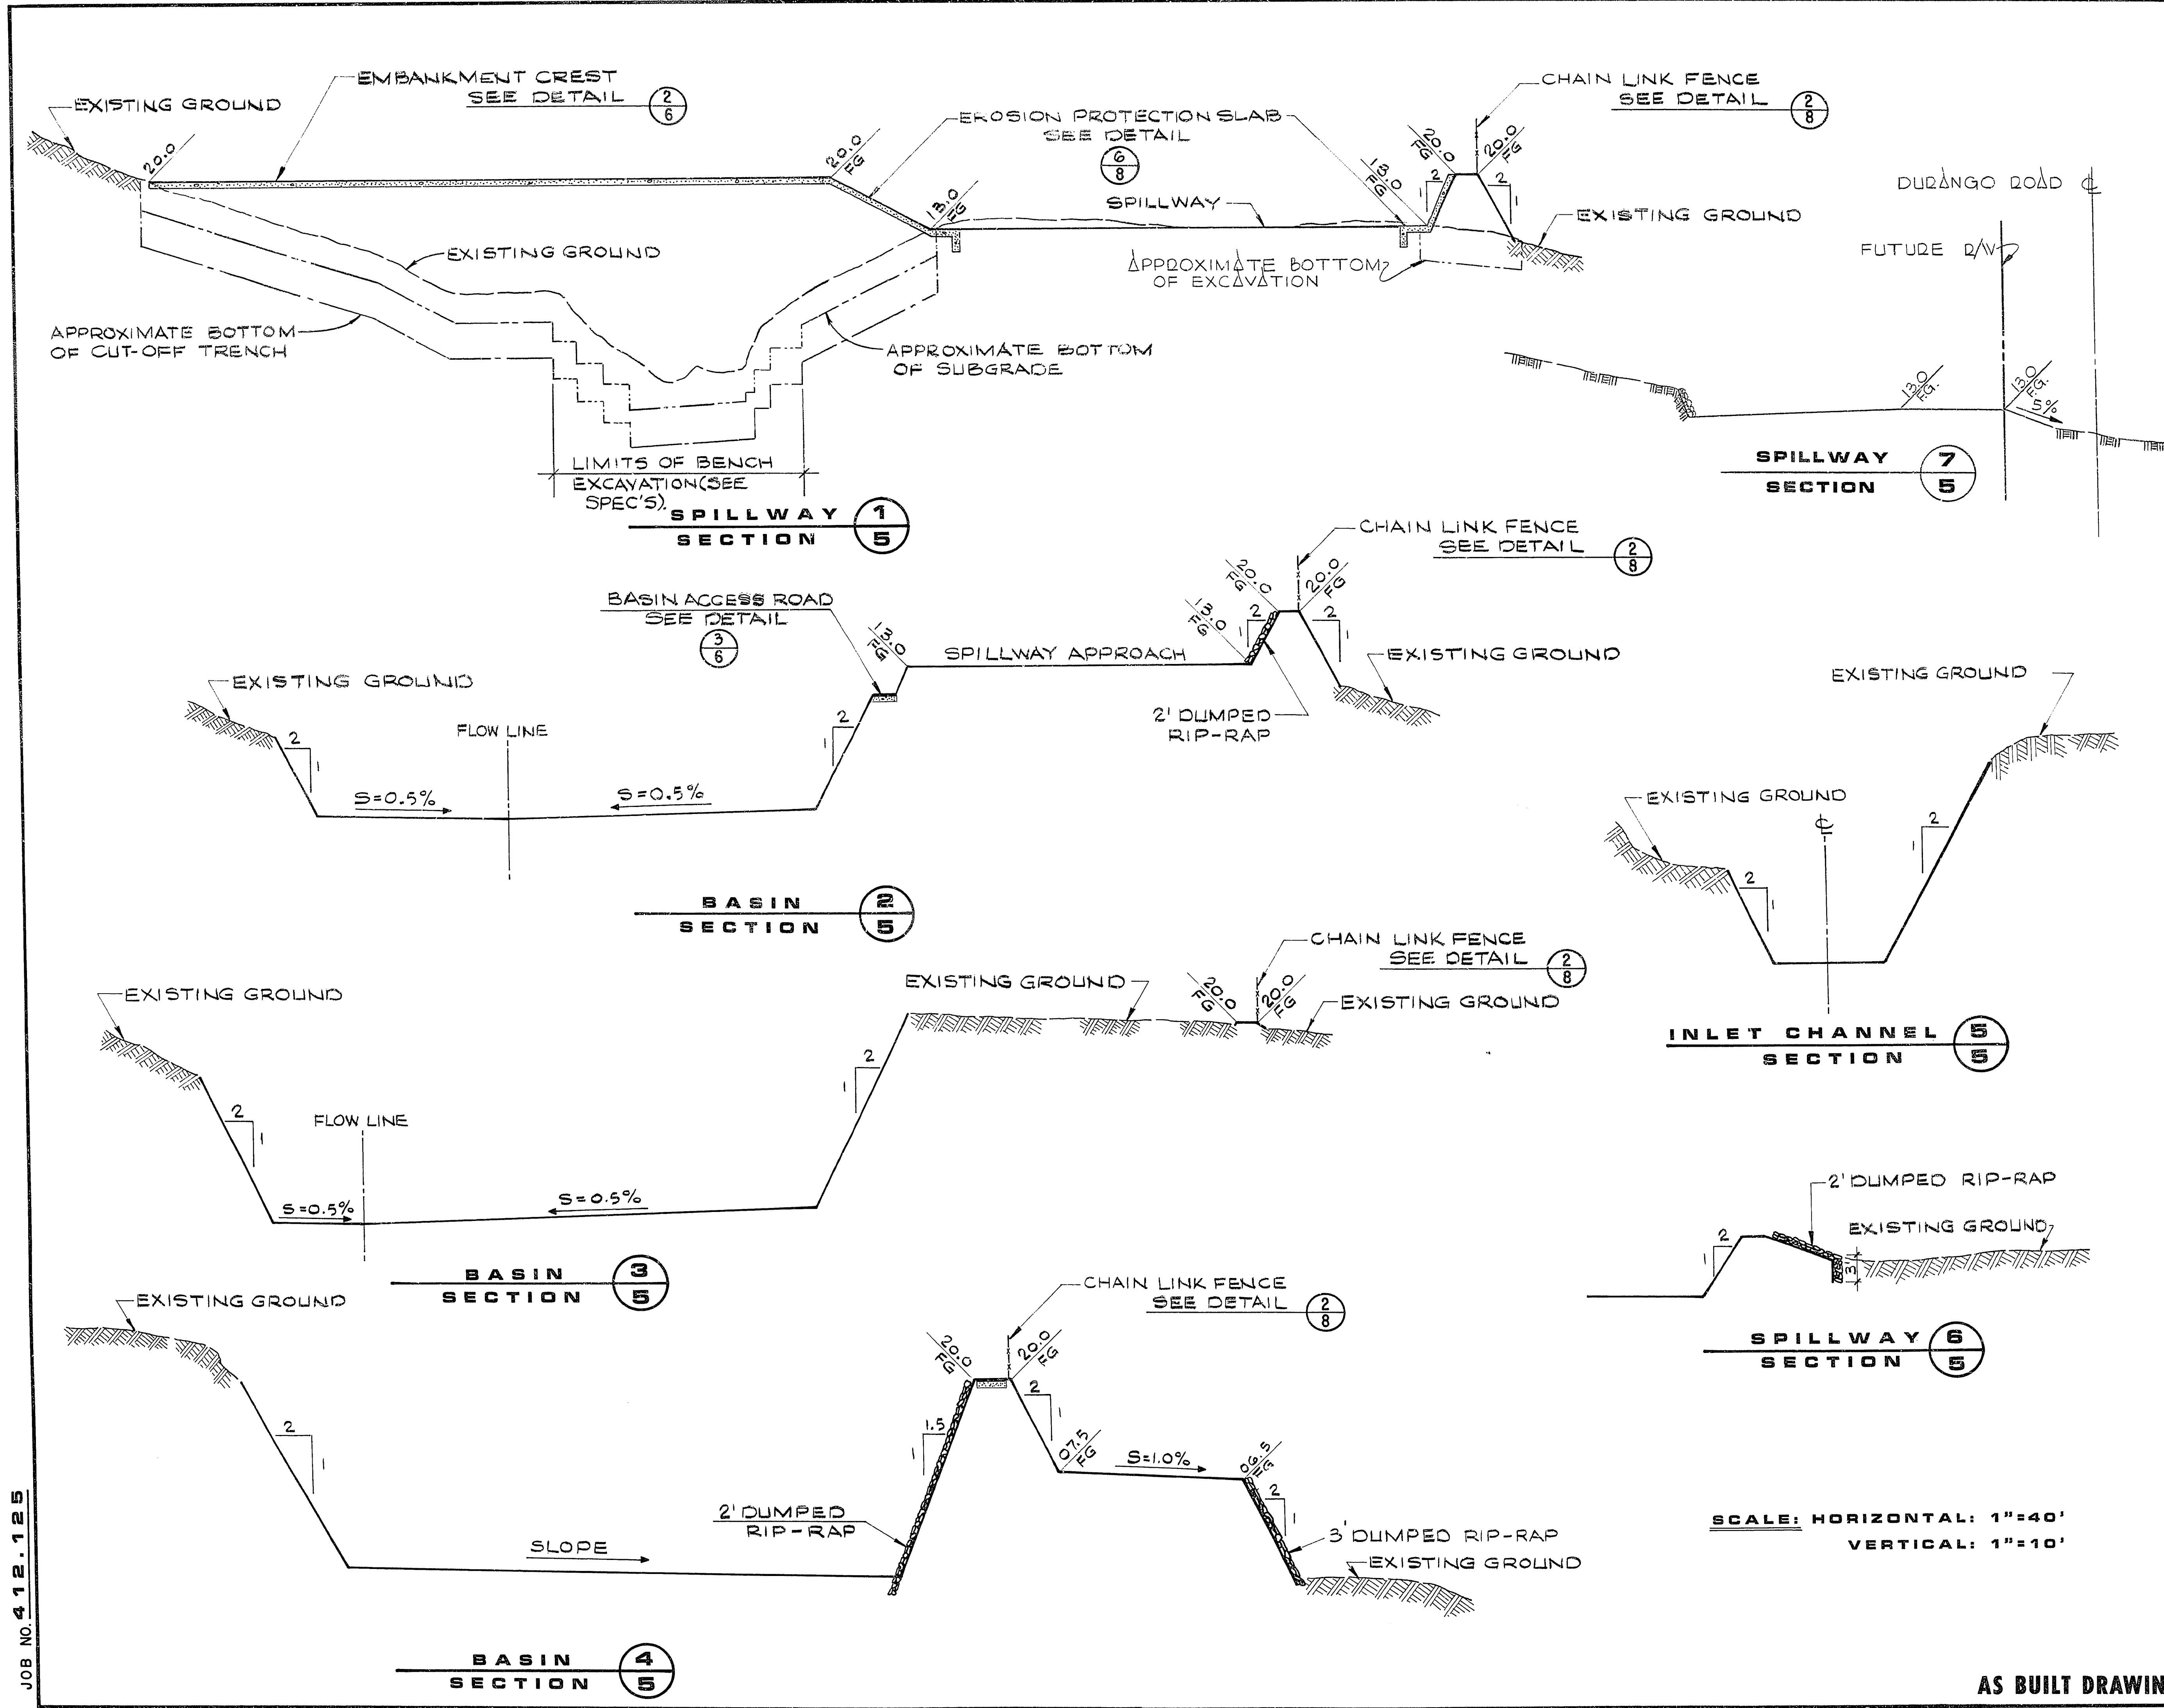

JOB NO. 412.125

DESCRIPTION	DATE	BY	CHKD
AS BUILT - NO REVISION	7/24/97		

CONSULTING ENGINEERS - PLANNERS
2000 WEST WALKER AVENUE
LAS VEGAS, NEVADA 89104

G. C. WALLACE
Consulting Engineers, Inc.
1100 East Sahara Ave. • Las Vegas, Nevada 89104 • 722-3330

CITY OF LAS VEGAS, NEVADA
ANGEL PARK DETENTION BASIN

SECTIONS

SHEET
5
OF 9 SHEETS

AS BUILT DRAWING