



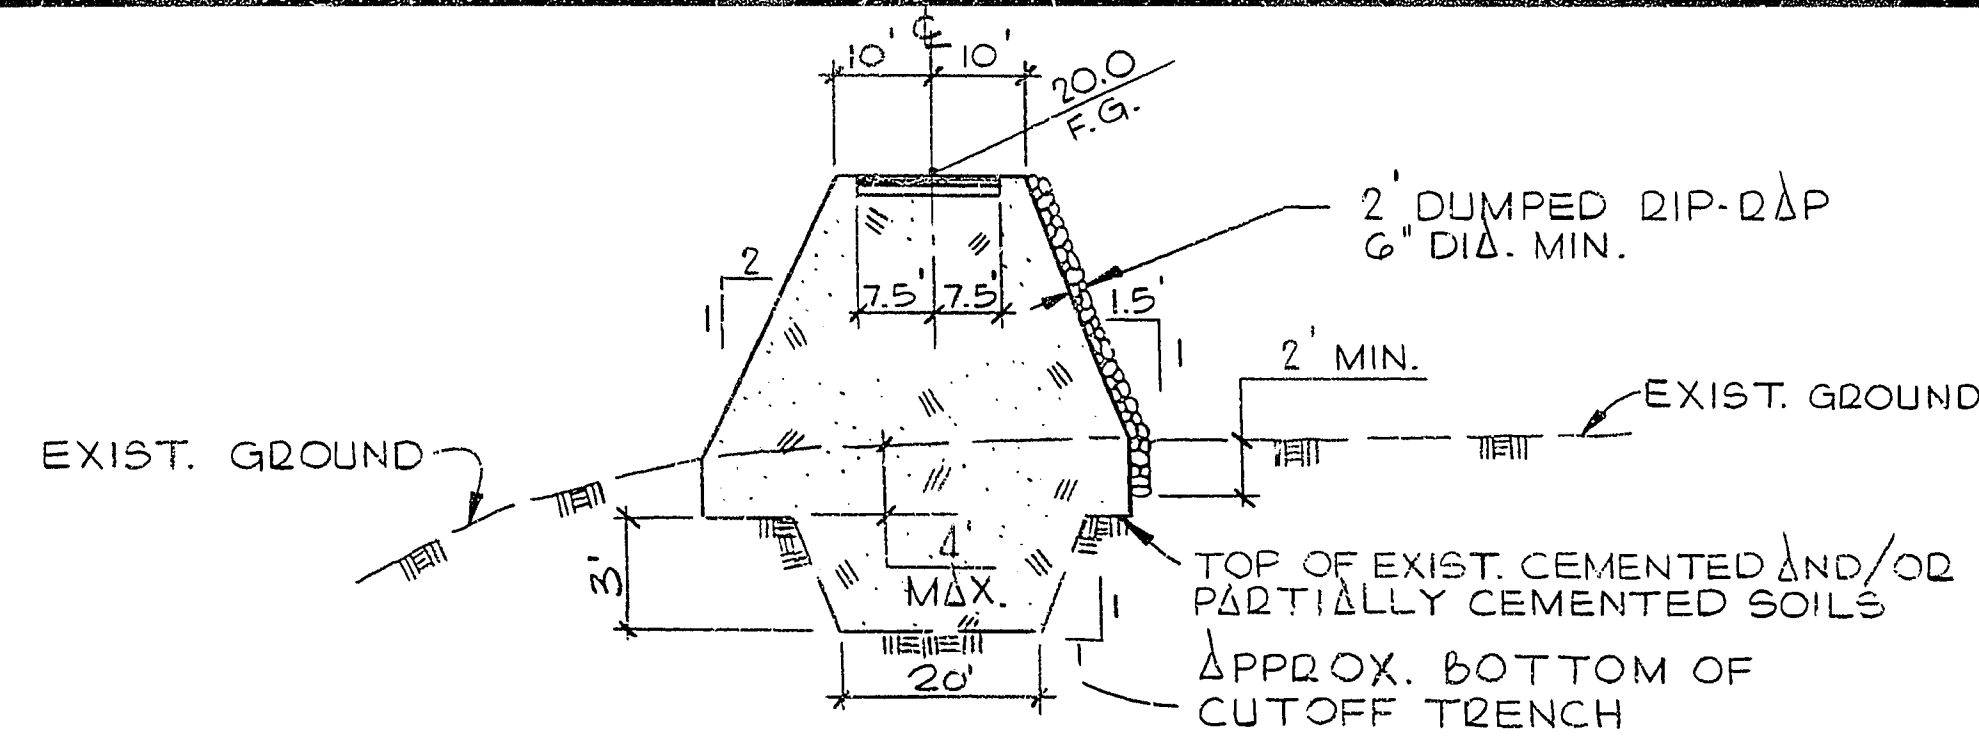

4
E

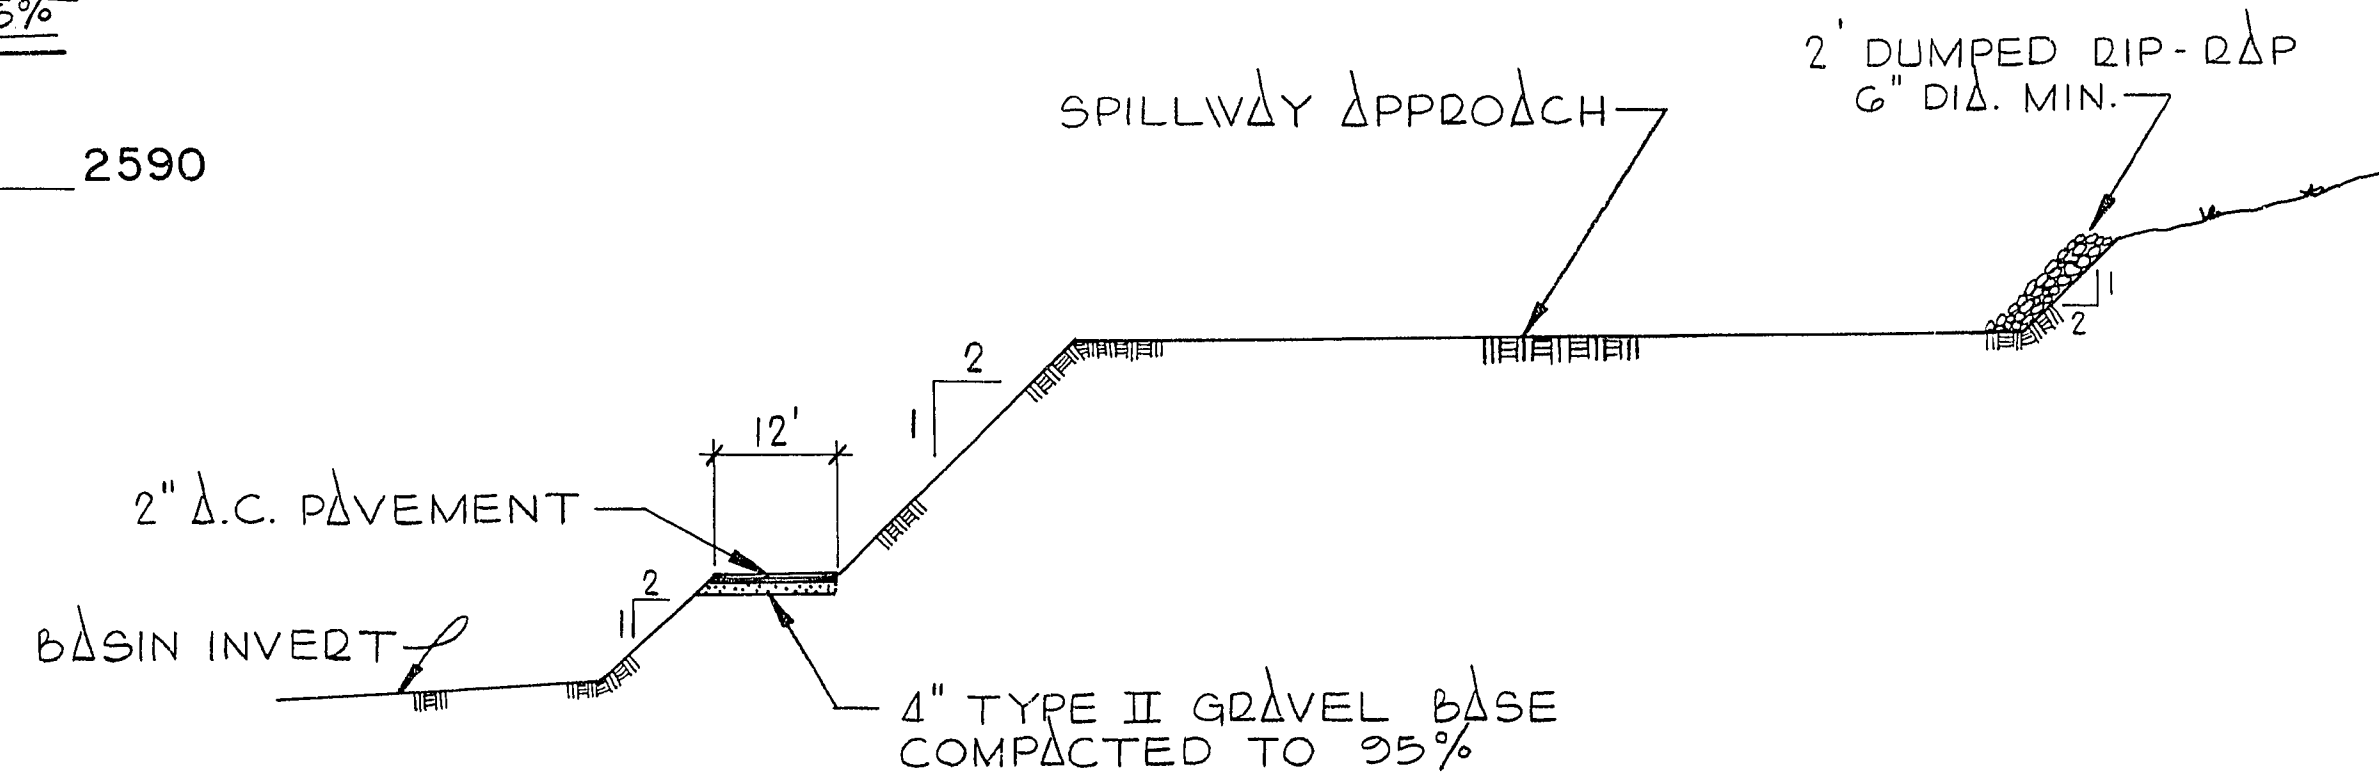

AS BUILT DRAWING

50146

46	CITY OF LAS VEGAS, NEVADA		SHEET	6	OF 9 SHEETS	G. C. WALLACE Consulting Engineers, Inc. Nevada-00104 - 750 2920 Las Vegas, Nevada		 CONSULTING ENGINEERS • PLANNERS JOHN PARKSON ROAD • LAS VEGAS, NEVADA	<table><tr><th>REV</th><th>DATE</th><th>DESCRIPTION</th></tr><tr><td>1</td><td>11/1/61</td><td>ADD EDDIUM #2</td></tr><tr><td>2</td><td>1/15/62</td><td>AS BUILT - NO REVISIONS</td></tr><tr><td> </td><td> </td><td> </td></tr><tr><td> </td><td> </td><td> </td></tr><tr><td> </td><td> </td><td> </td></tr></table>	REV	DATE	DESCRIPTION	1	11/1/61	ADD EDDIUM #2	2	1/15/62	AS BUILT - NO REVISIONS									
	REV	DATE								DESCRIPTION																	
1	11/1/61	ADD EDDIUM #2																									
2	1/15/62	AS BUILT - NO REVISIONS																									
ANGEL PARK DETENTION BASIN		MAIN OUTLET OF DAM. MAXIMUM SECTION OF EMBANK																									