




7-13-146

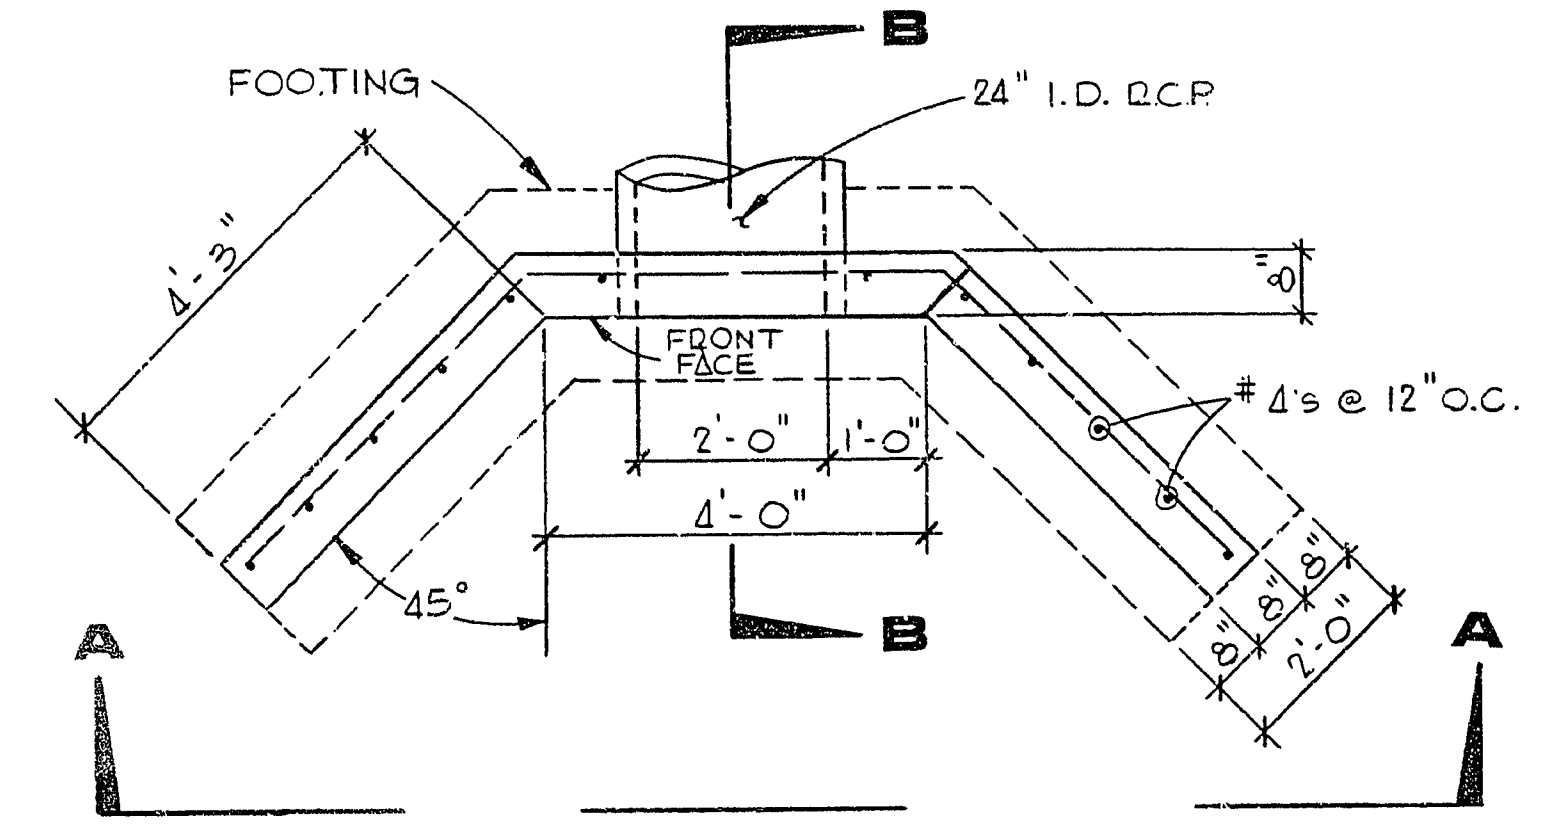

OUTLET HEADWALL - PLAN

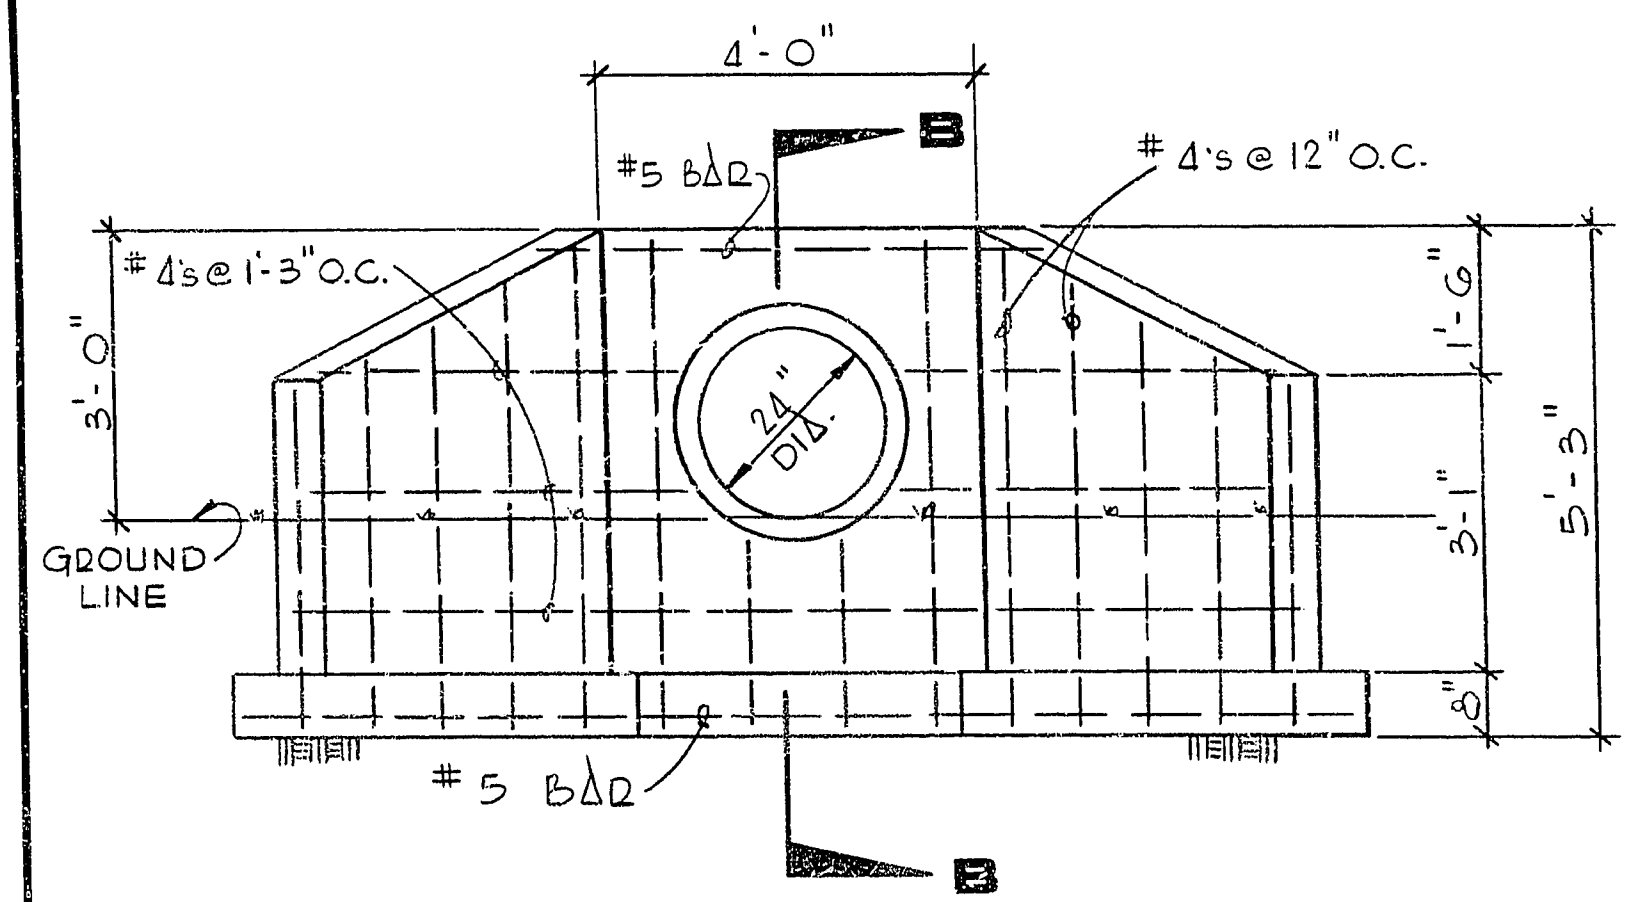


SECTION A - A

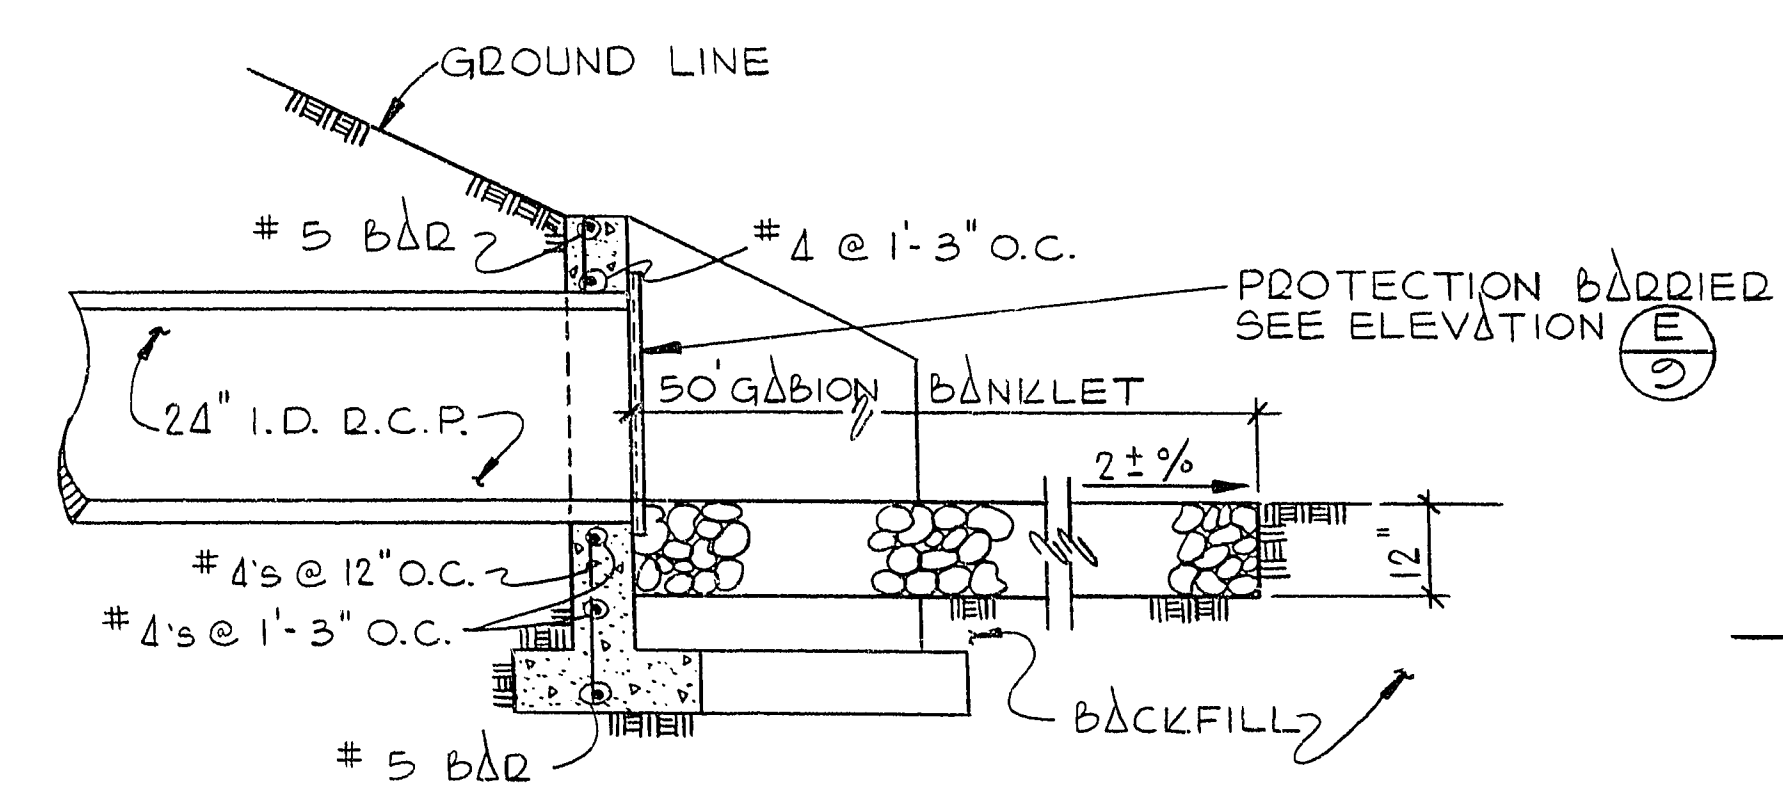

SECTION B - B


OUTLET STRUCTURE

1/8

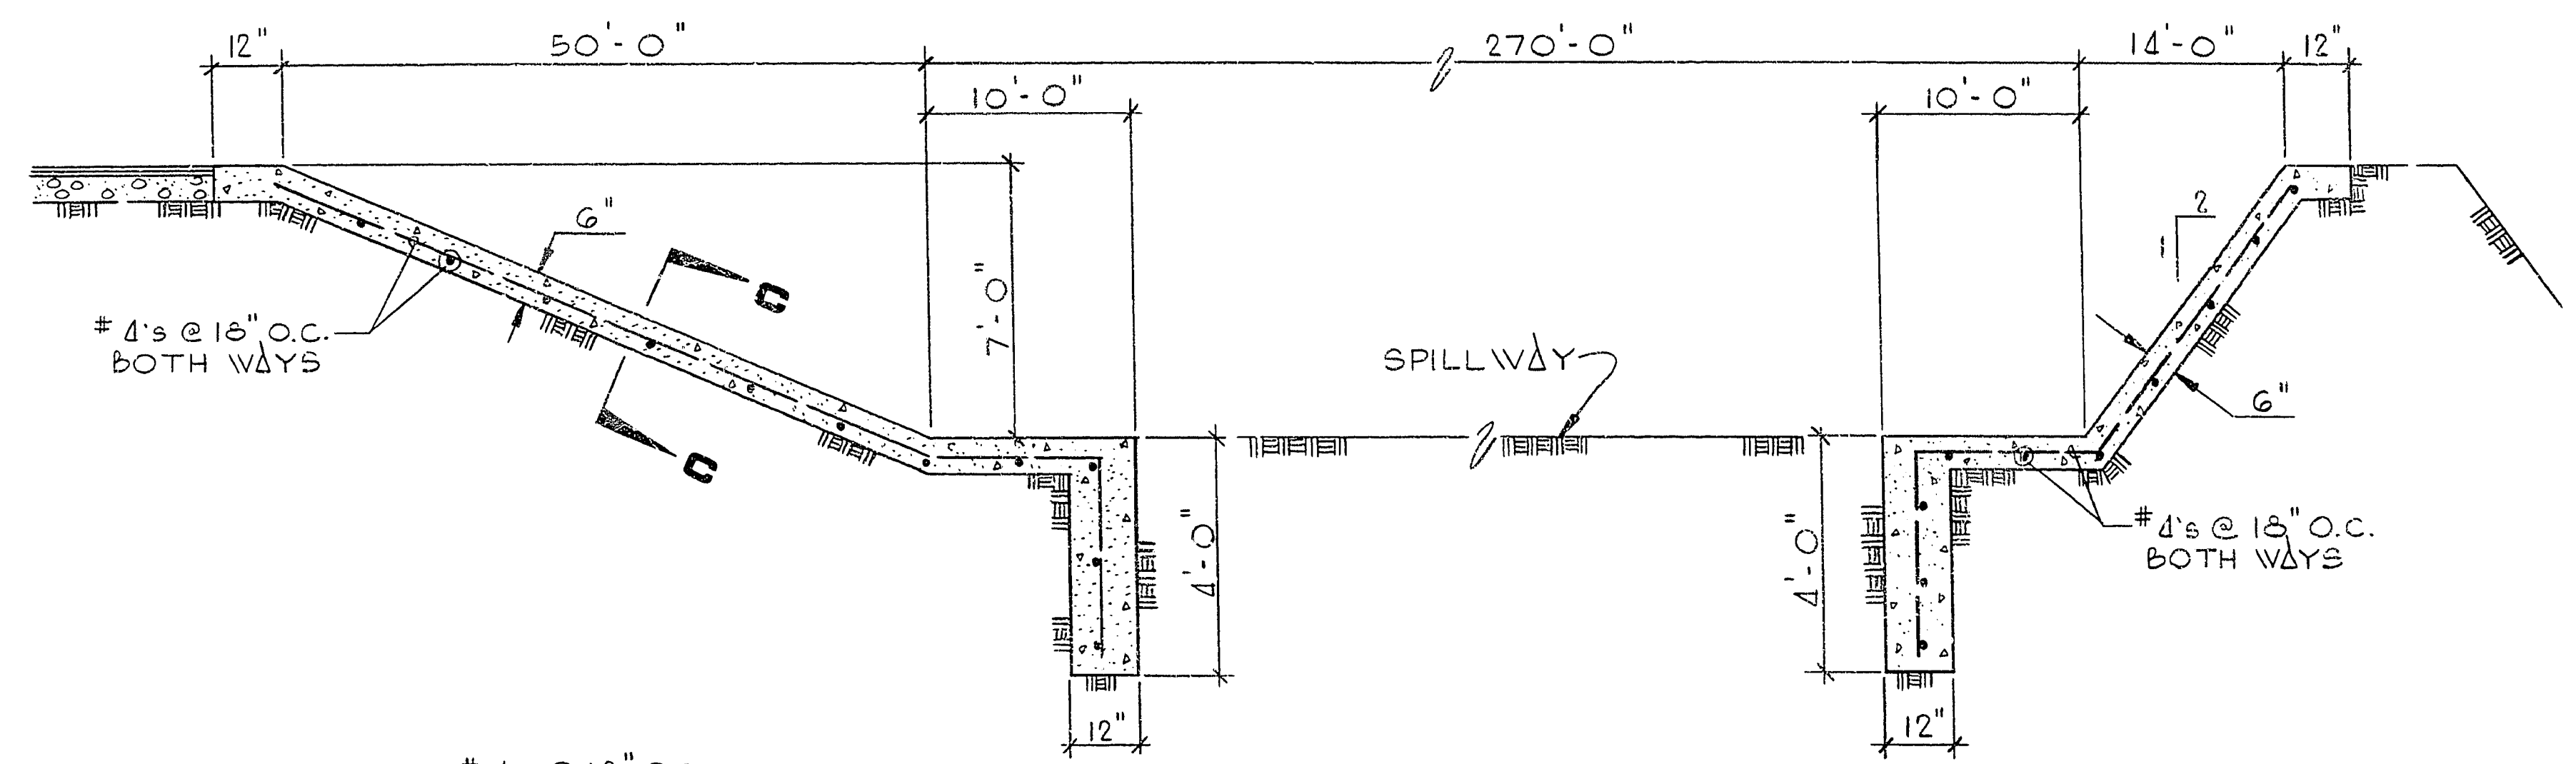


EROSION PROTECTION SLAB DETAIL


6/8

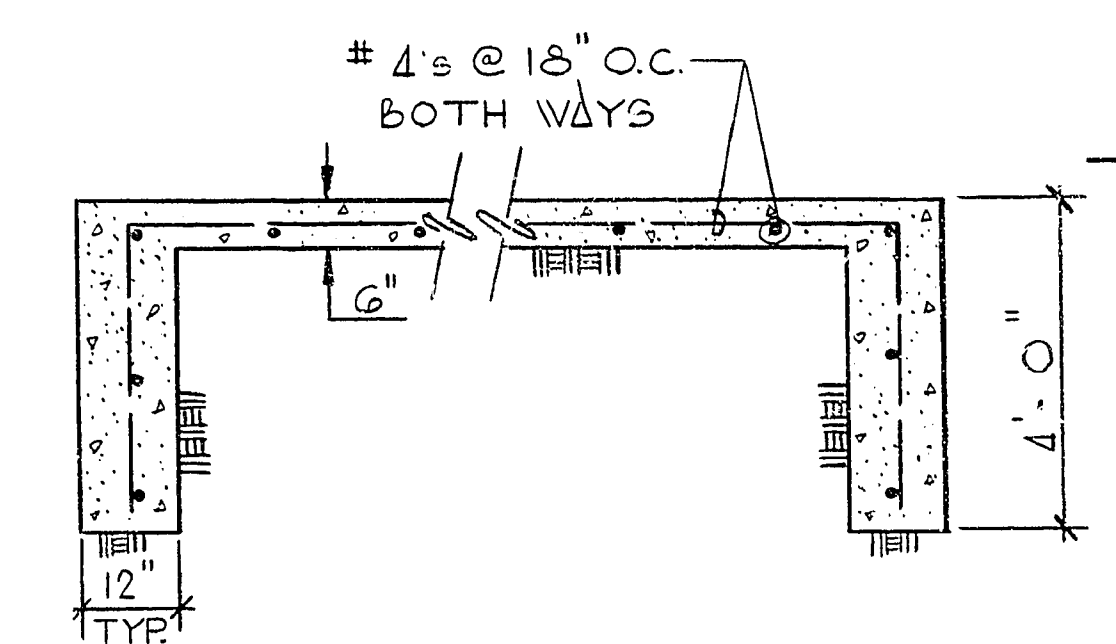

SECTION C - C

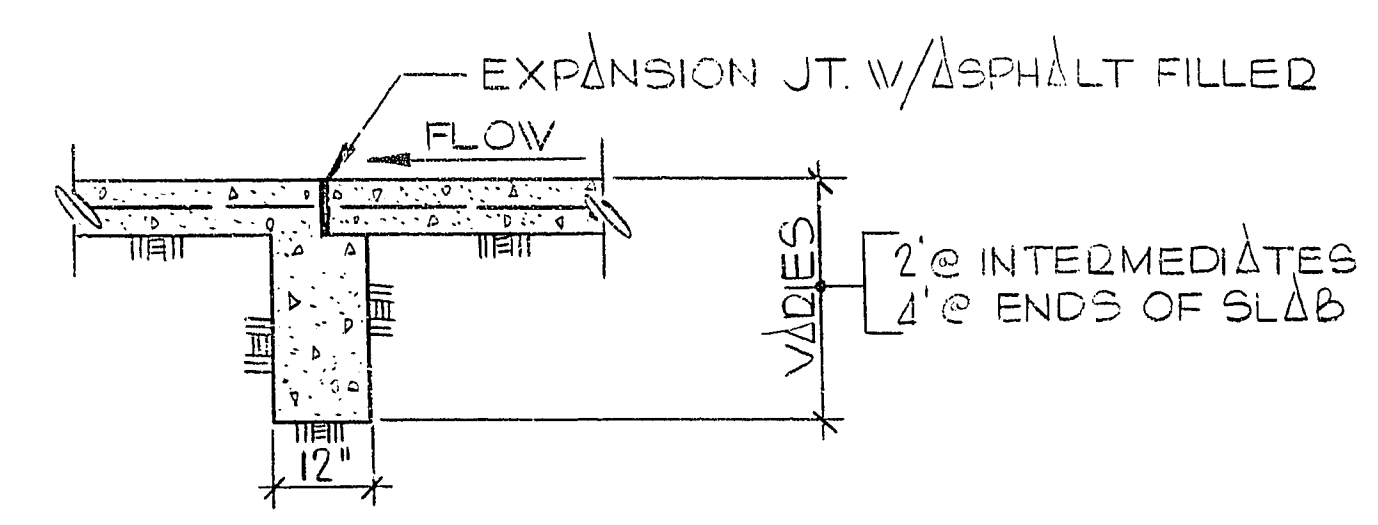

SECTION D - D

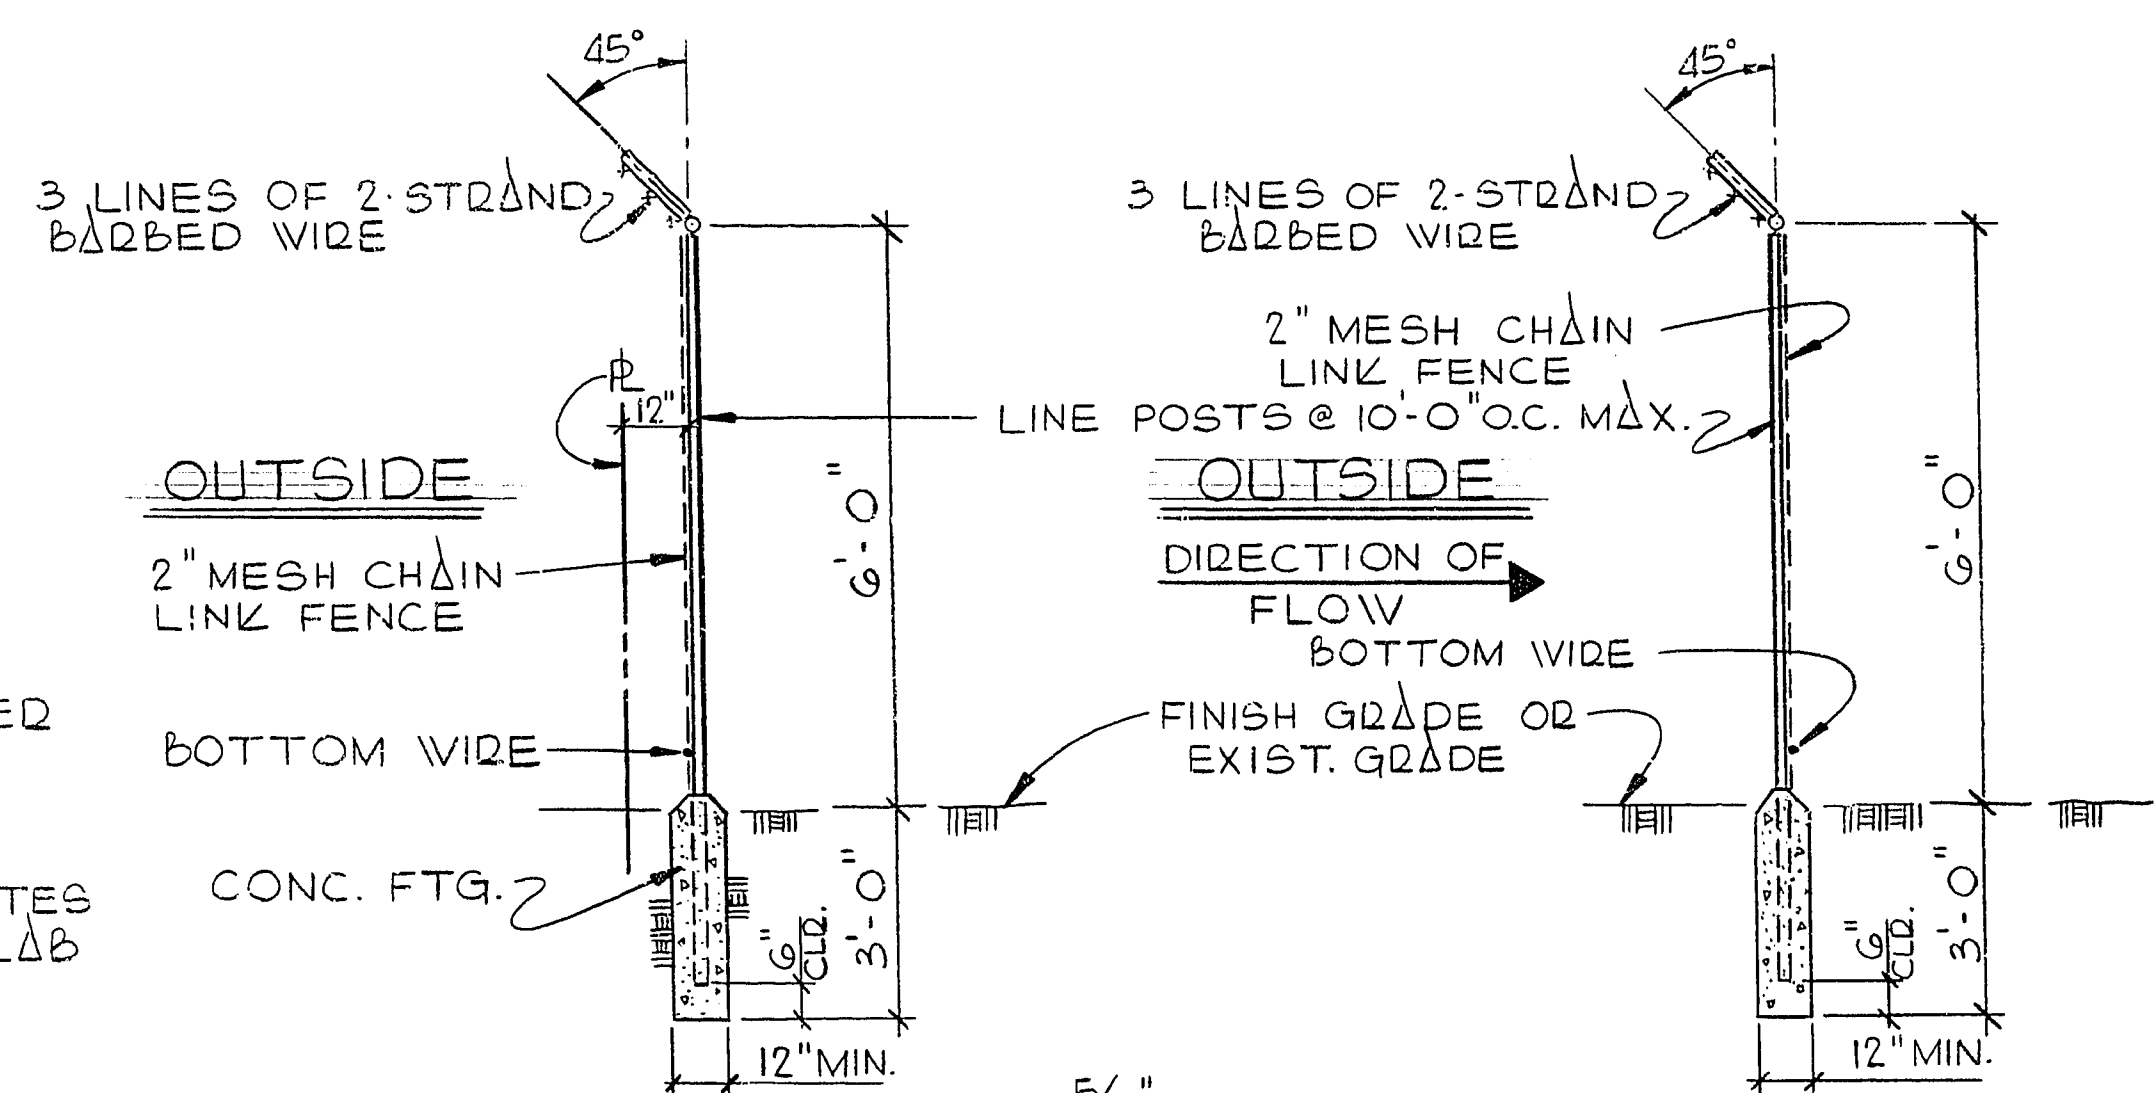


FENCE DETAIL

2/8


FENCE DETAIL

3/8

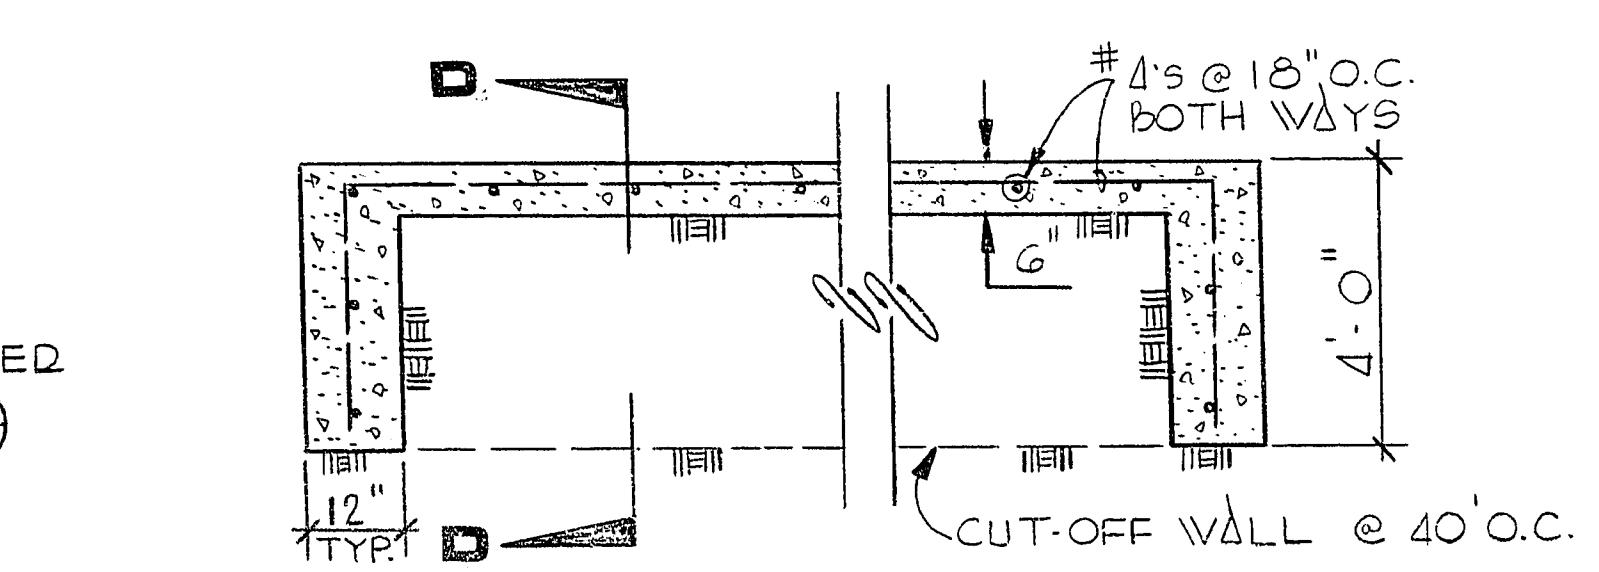


ALTERNATE APPROACH SLAB DETAIL

7/8

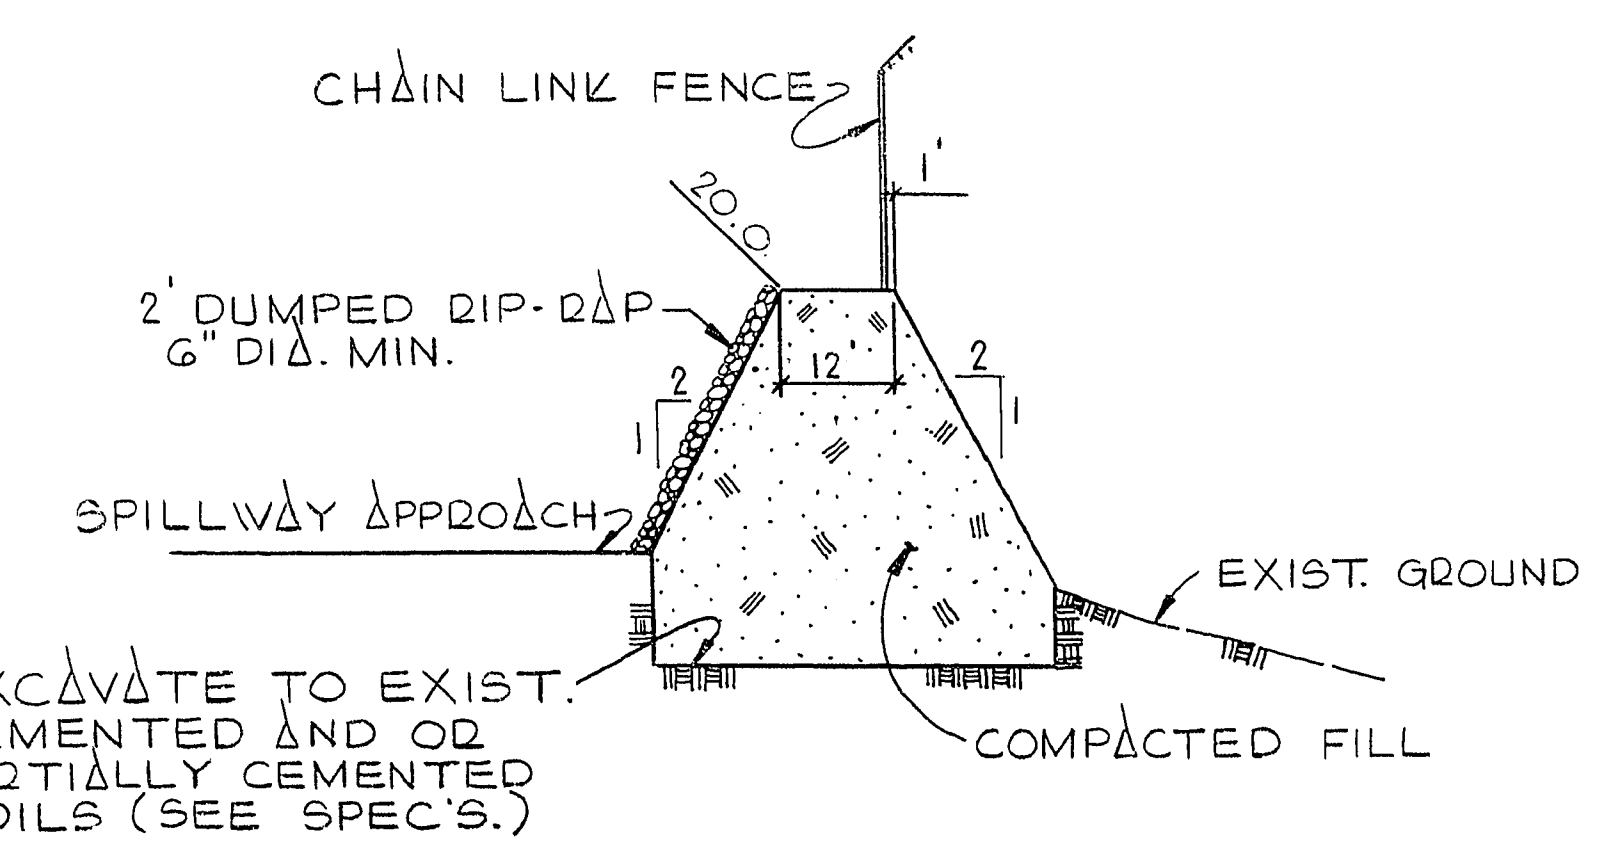

TYPICAL CONTAINMENT LEVEE SECTION

5/8

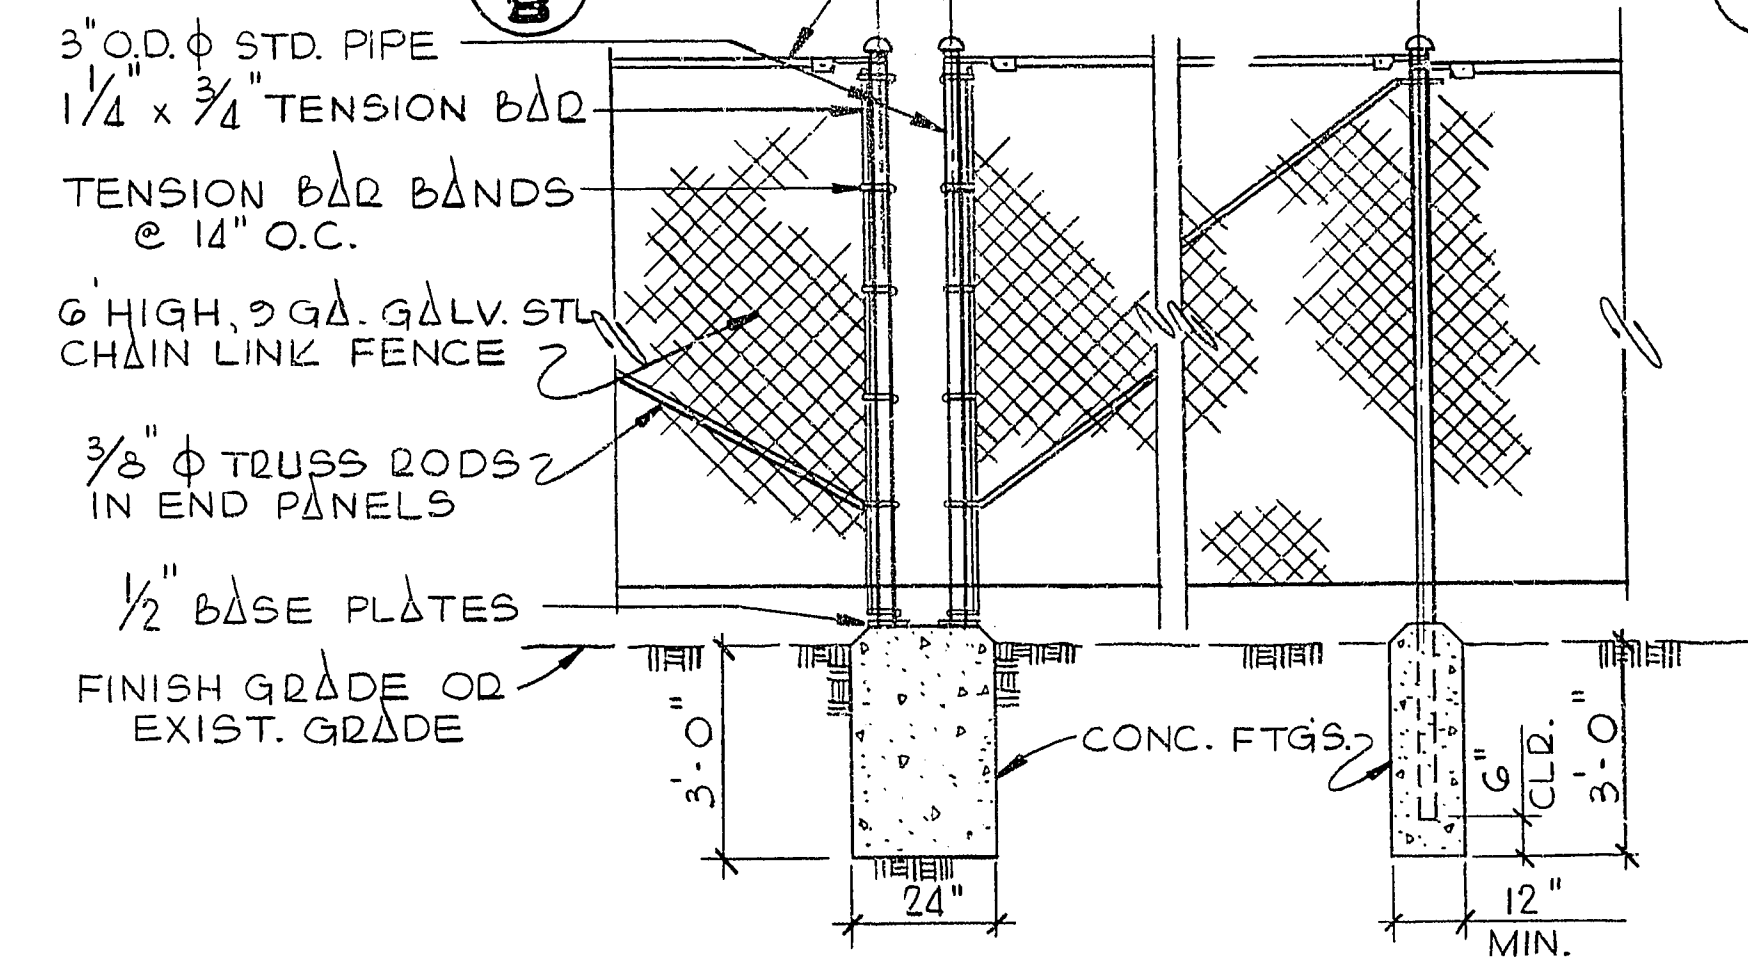

FENCE DETAIL

4/8

PERIMETER FENCE

DESCRIPTION	DATE	BY	CHKD.
AS BUILT - 10 REVISIONS			
CONSULTING ENGINEERS - PLANNERS			
2000 EAST SAHARA AVE., LAS VEGAS, NEVADA 89104-792-3330			
G.C. WALLACE Consulting Engineers, Inc.			
CITY OF LAS VEGAS, NEVADA ANGEL PARK DETENTION BASIN			
MISCELLANEOUS DETAILS			
SHEET 8			
OF 9 SHEETS			

AS BUILT DRAWING

650.14-6

JOB NO. 412.125