




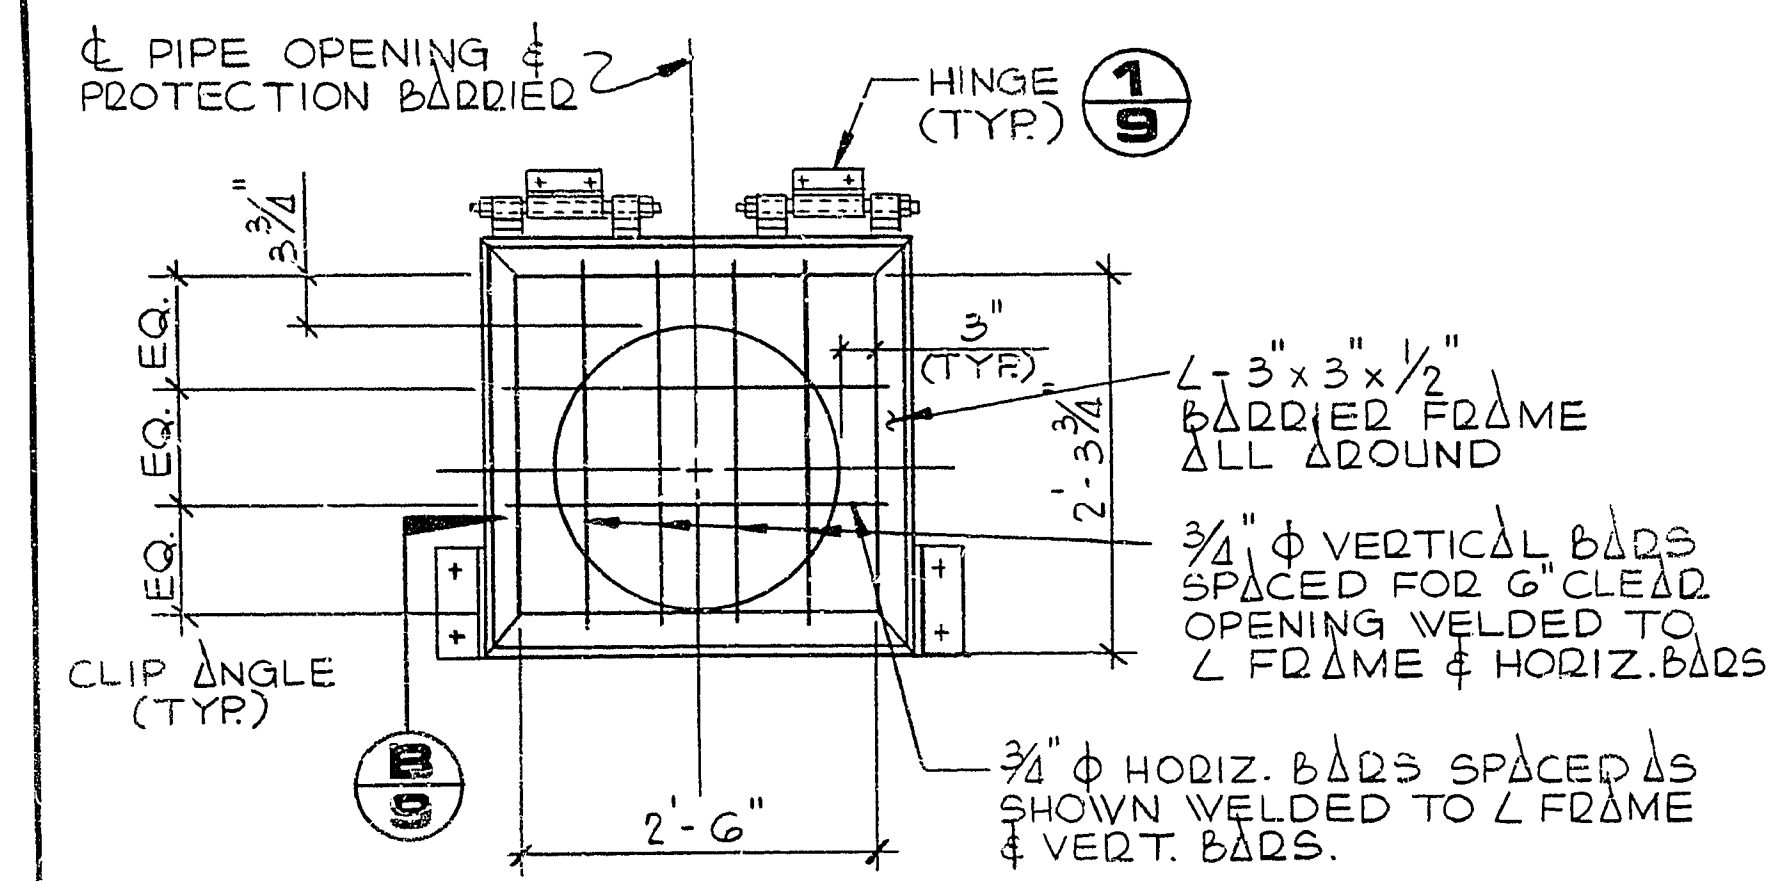

ELEVATION
NO SCALE


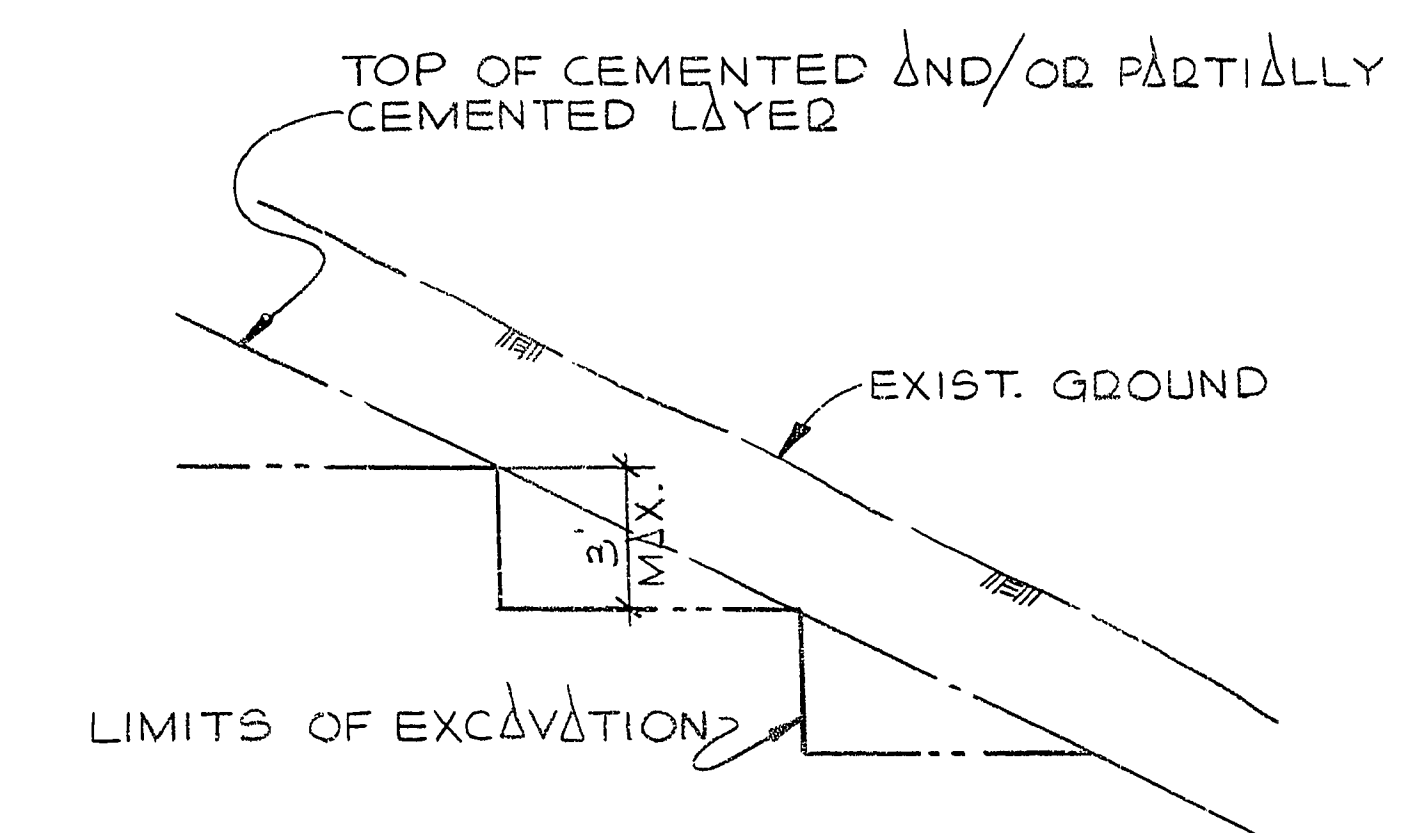


BENCH EXCAVATION DETAIL

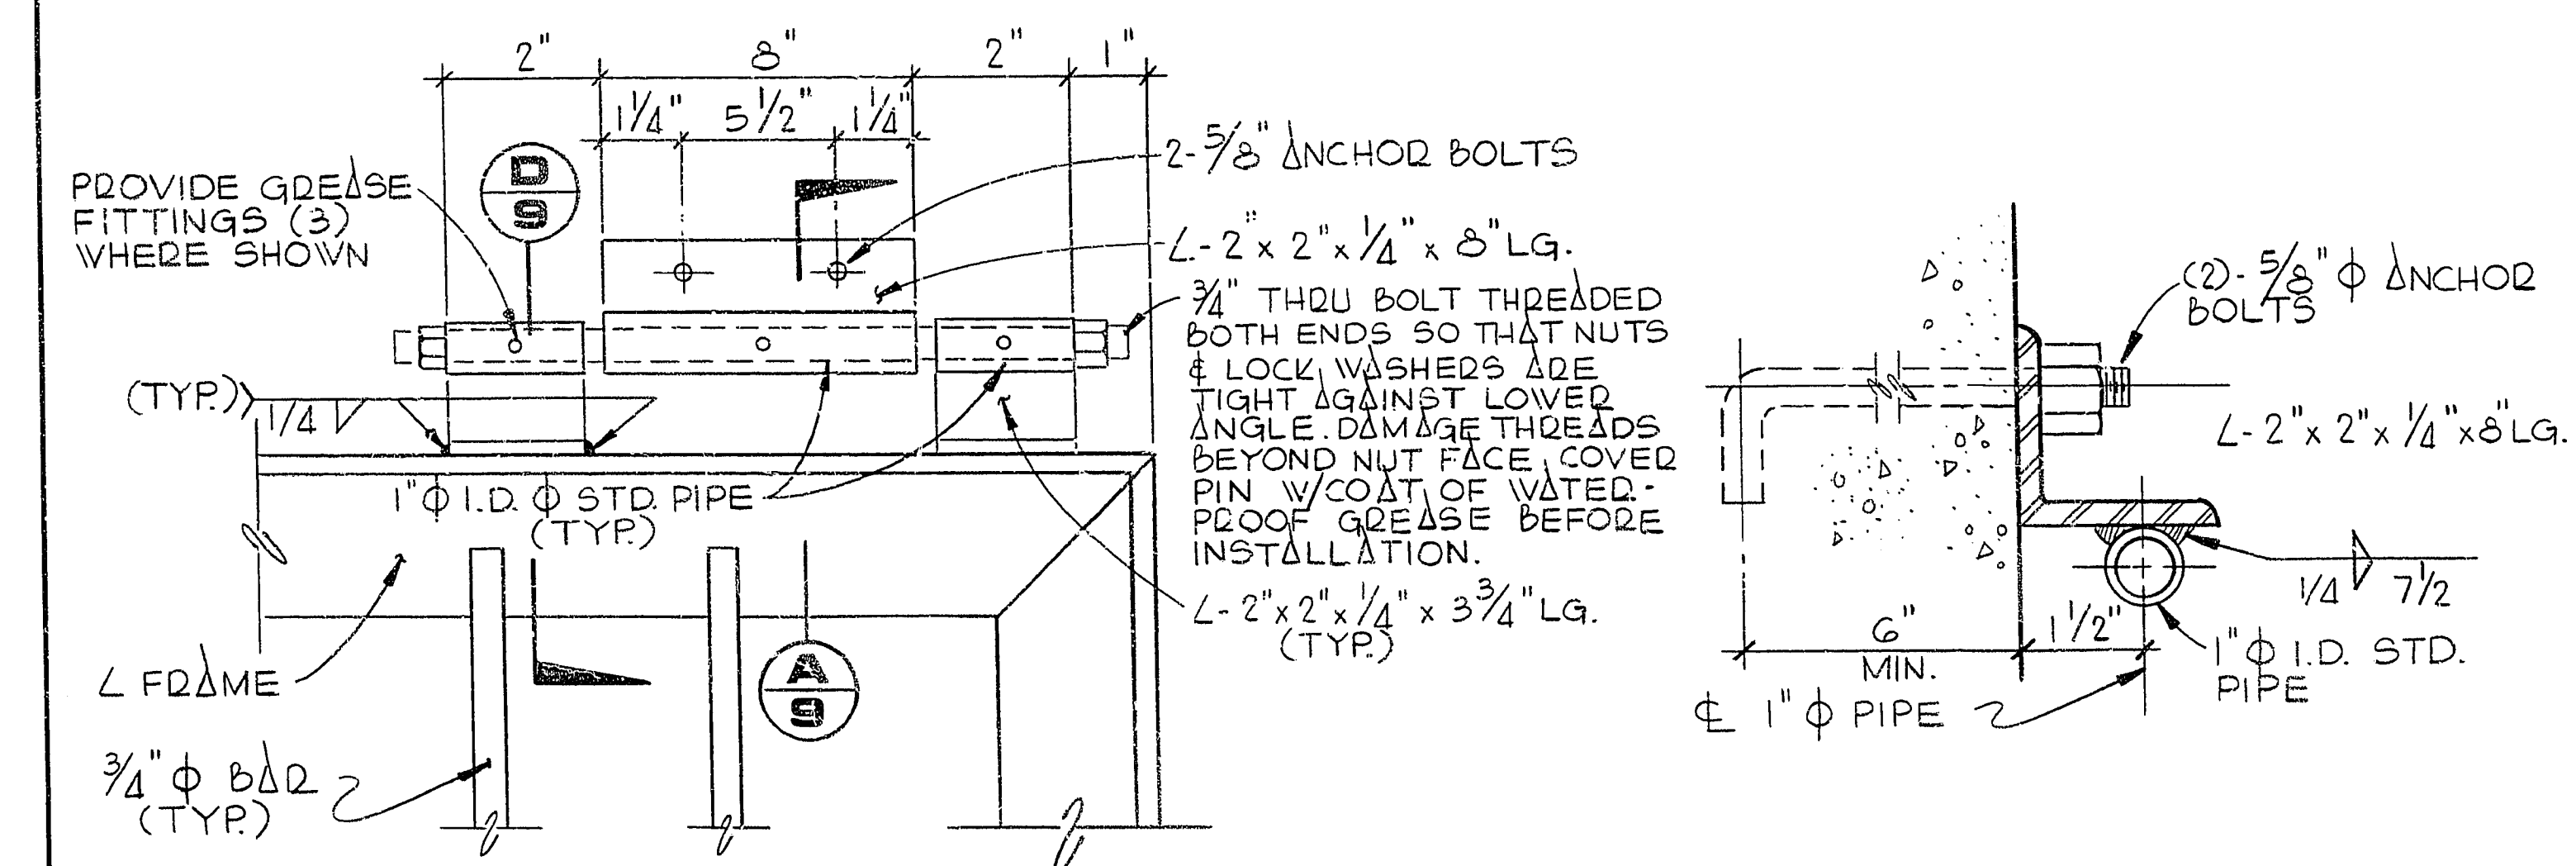

DETAIL
SCALE: 3"=1'-0"

SECTION
HALF SCALE

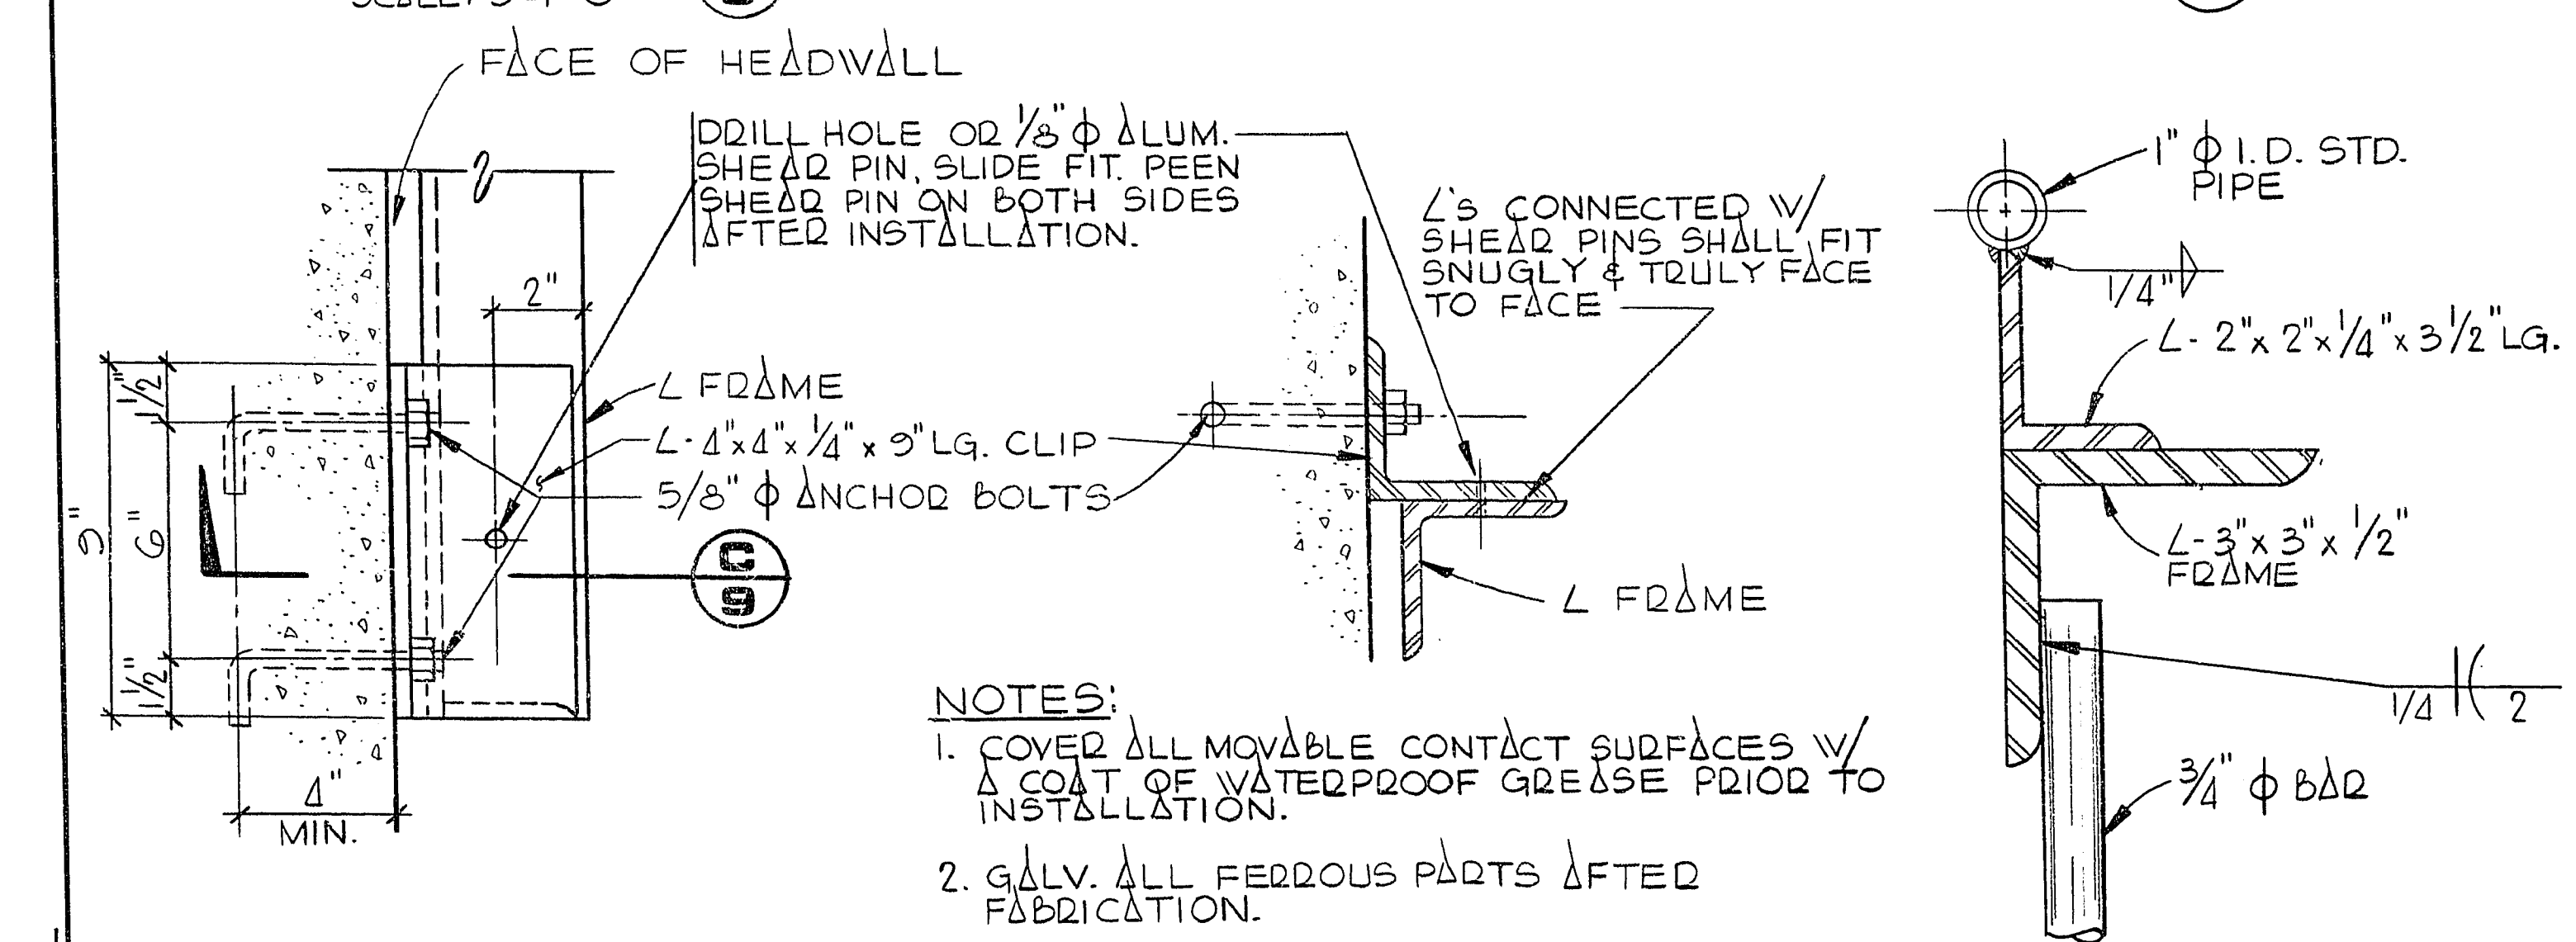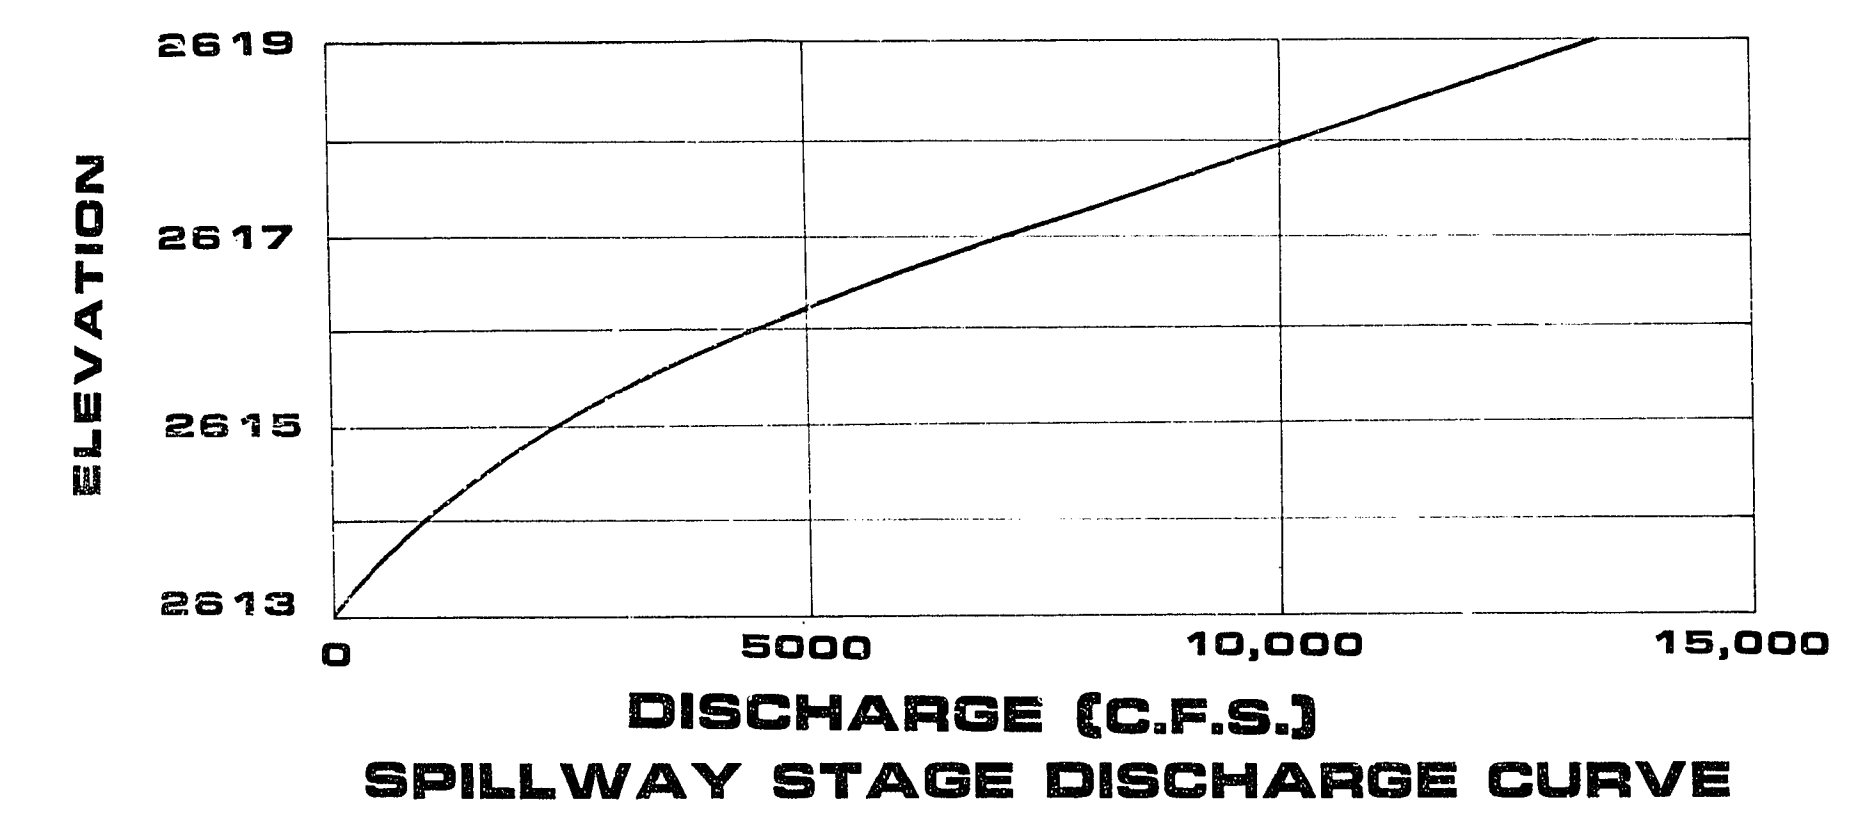


- NOTES:**
1. COVER ALL MOVABLE CONTACT SURFACES W/ A COAT OF WATERPROOF GREASE PRIOR TO INSTALLATION.
 2. GALV. ALL FERROUS PARTS AFTER FABRICATION.

SECTION
SCALE: 3"=1'-0"

SECTION
SCALE: 3"=1'-0"

SECTION
HALF SCALE

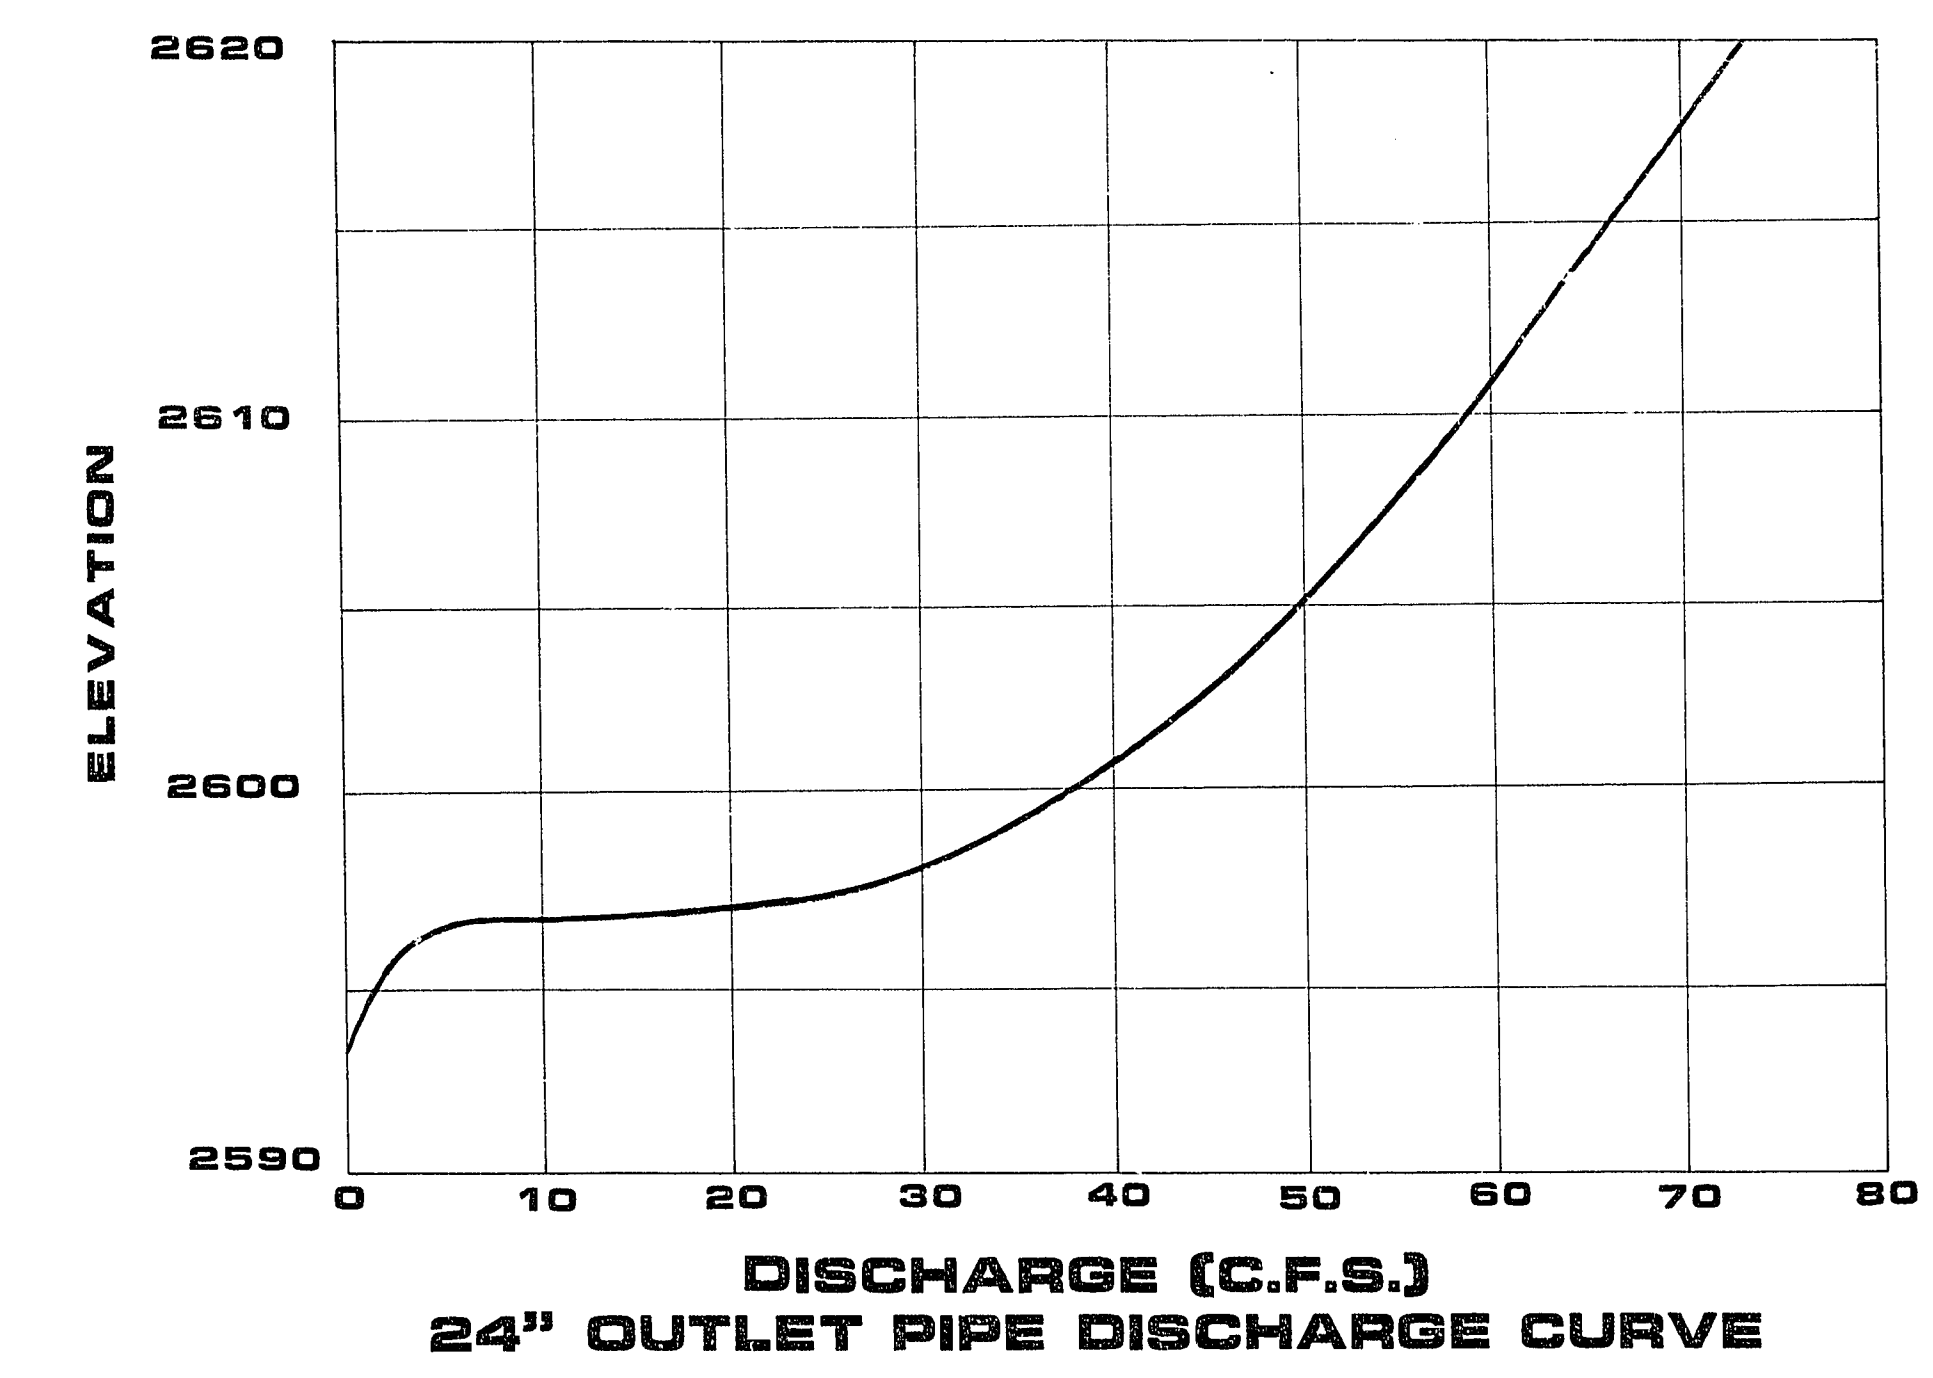

PROTECTION BARRIER DETAILS

DESCRIPTION	AS BUILT - 14 REVISIONS
REV	DATE
1	9/13/14
G.C. WALLACE CONSULTING ENGINEERS • PLANNERS 1100 East Sahara Ave. • Las Vegas, Nevada 89104 • 732-3330	
CITY OF LAS VEGAS, NEVADA ANGEL PARK DETENTION BASIN MISCELLANEOUS DETAILS	
SHEET 9 OF 9 SHEETS	

JOB NO. 412.125

AS BUILT DRAWING

650.14-6