


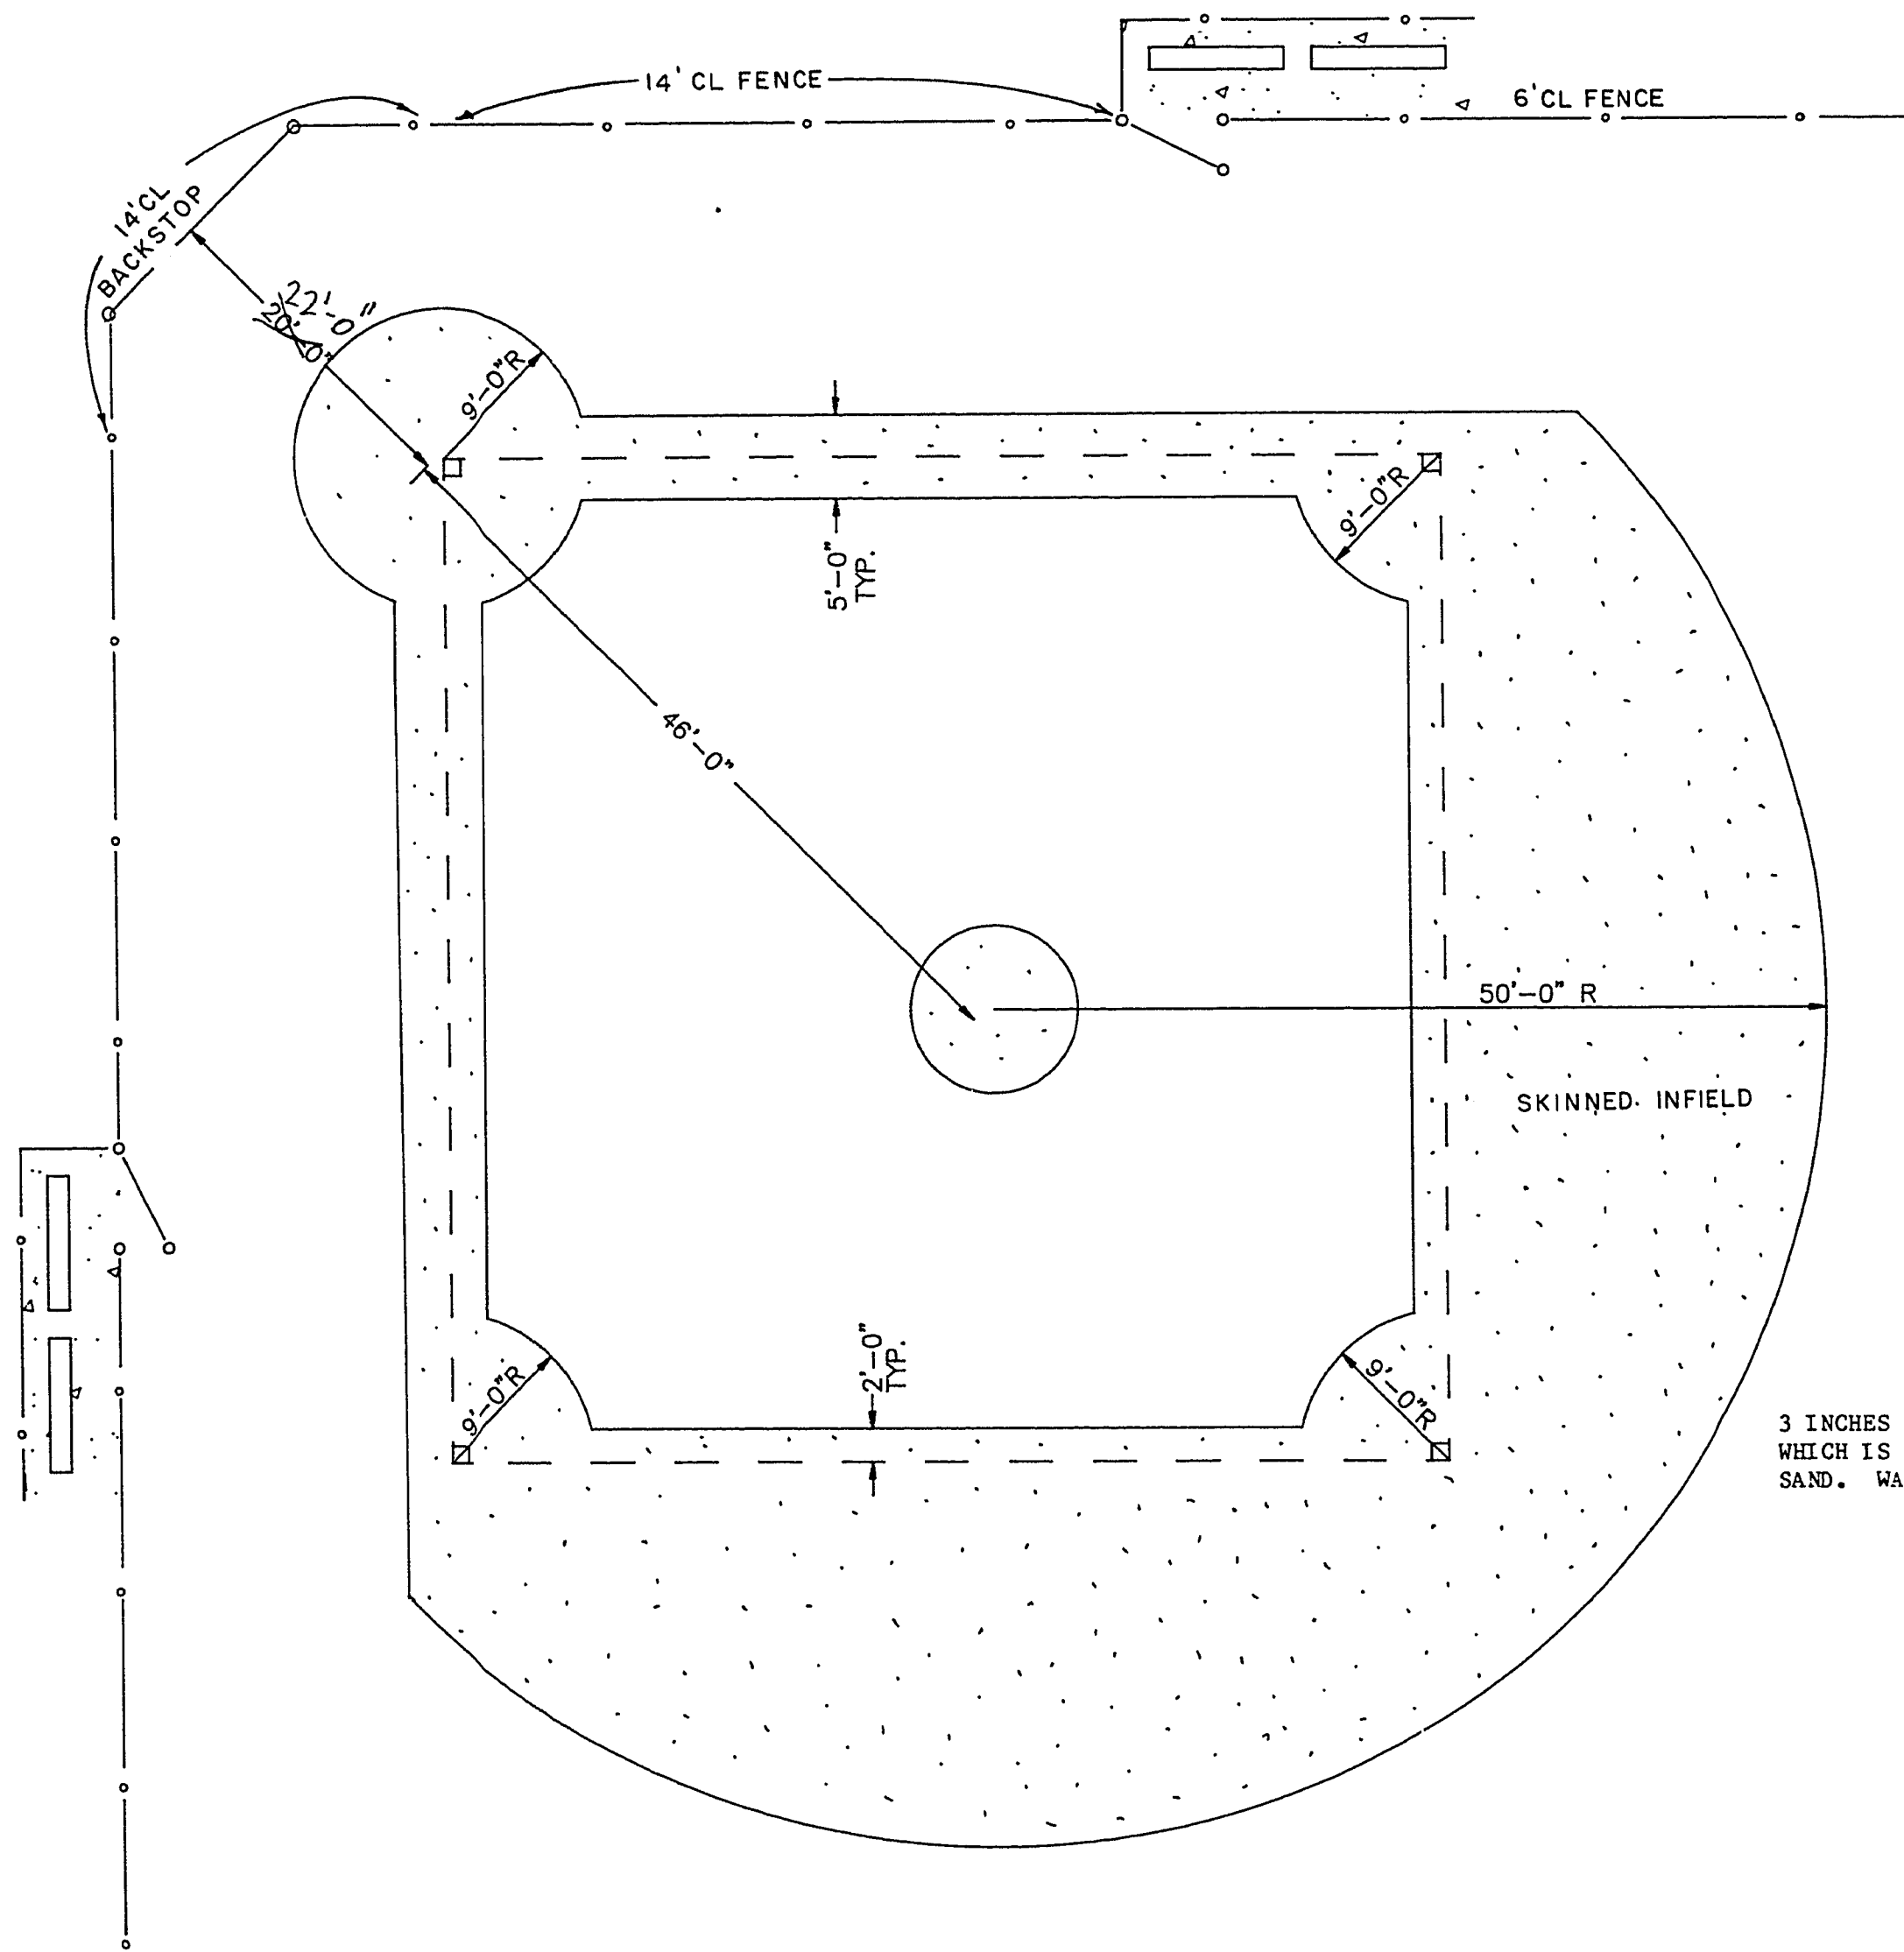


BASEBALL LAYOUT PLAN (TYP. OF 2)
SCALE: 1"=10'

BACKSTOP AND CHAINLINK FENCING NOTES


1. All posts for backstop and 14' high fence shall be 3" O.D. pipe, schedule 40.
2. Posts for 6' fence shall be 2-1/2" O.D. pipe.
3. Overhang arms and braces shall be 2" O.D. and 1-5/8" O.D. pipe, as shown.
4. All rails shall be 1-5/8" O.D. pipe except the two rails in the overhang which shall be 1-3/8" O.D. as shown.
5. All materials shall be hot-dip galvanized steel.
6. All chainlink fabric shall be 2"x2" mesh.
7. 14' fencing shall be accomplished by splicing 10' fabric and splice shall occur at upper center rail splice shall be knuckle to knuckle selvage.

BASEBALL INFIELD MIX


3 INCHES OF KALAMAZOO VALENTINE RED DECOMPOSED GRANITE, 70% OF WHICH IS 3MM MINUS, THOROUGHLY MIXED WITH 30% CLEAN FINE GRAINED SAND. WATER COMPACT AFTER FINE GRADING TO A SMOOTH SURFACE.

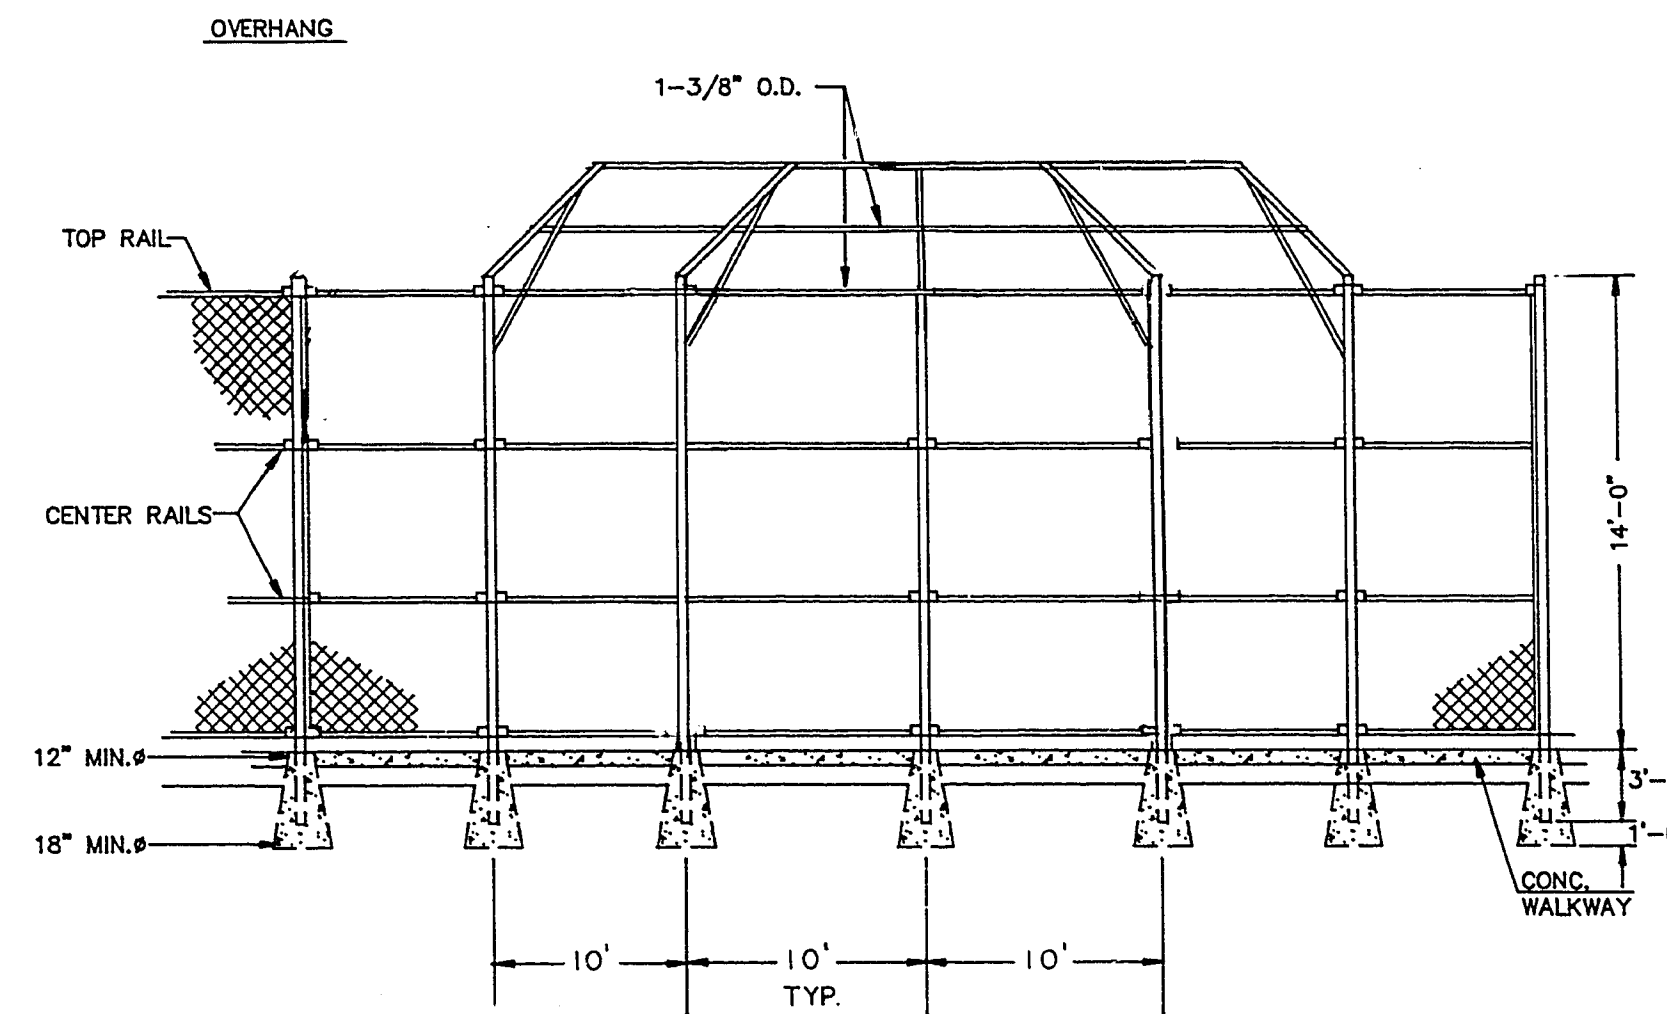

BACKSTOP
NOT TO SCALE

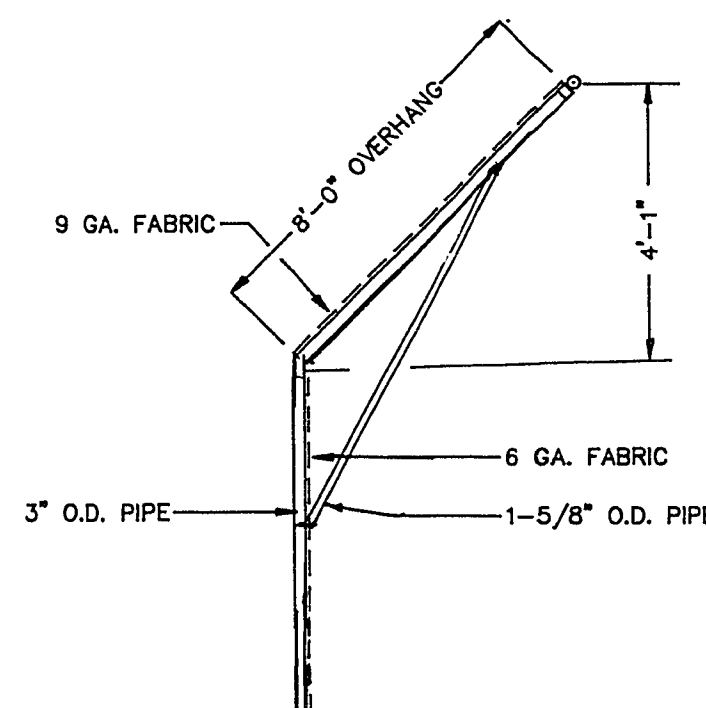


BACKSTOP OVERHANG
NOT TO SCALE

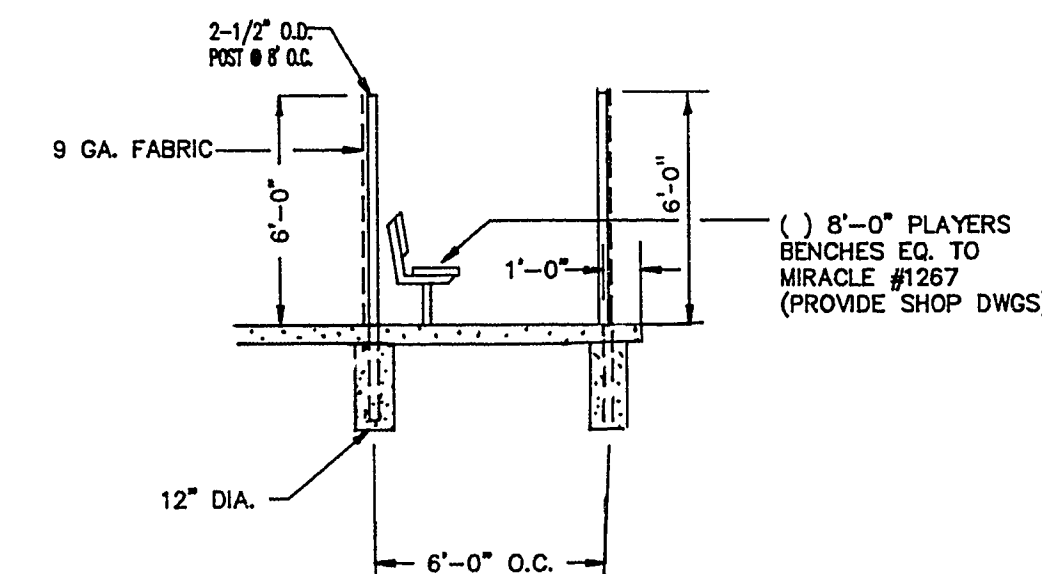

DUGOUT
SCALE: 1"=5'

AS BUILT

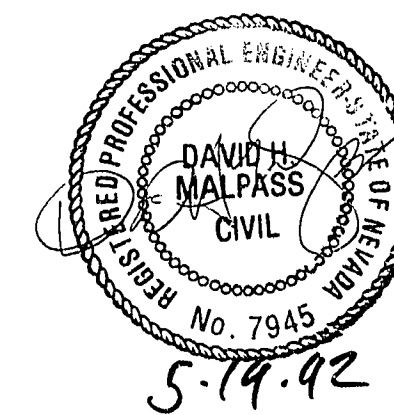

REV.	DATE	BY	REVISION

DRAWN BY	C.M.P.
DESIGNED BY	
APPROVED BY	D.H.M.

DETAIL SHEET

PROJECT NO. 91-2443
DATE: 04/30/92
SCALE: AS SHOWN

SHEET
C5
7 of 38 SHEETS

18-13-89
2300 PASEO DEL PRADO SUITE D 108
LAS VEGAS, NEVADA 89102
PHONE (702) 364-1066



CITY OF LAS VEGAS
DEPARTMENT OF PARKS
AND LEISURE ACTIVITIES

4-I-001 PARK SITE
GOWAN AND TORREY PINES
CHILDRENS MEMORIAL PARK