


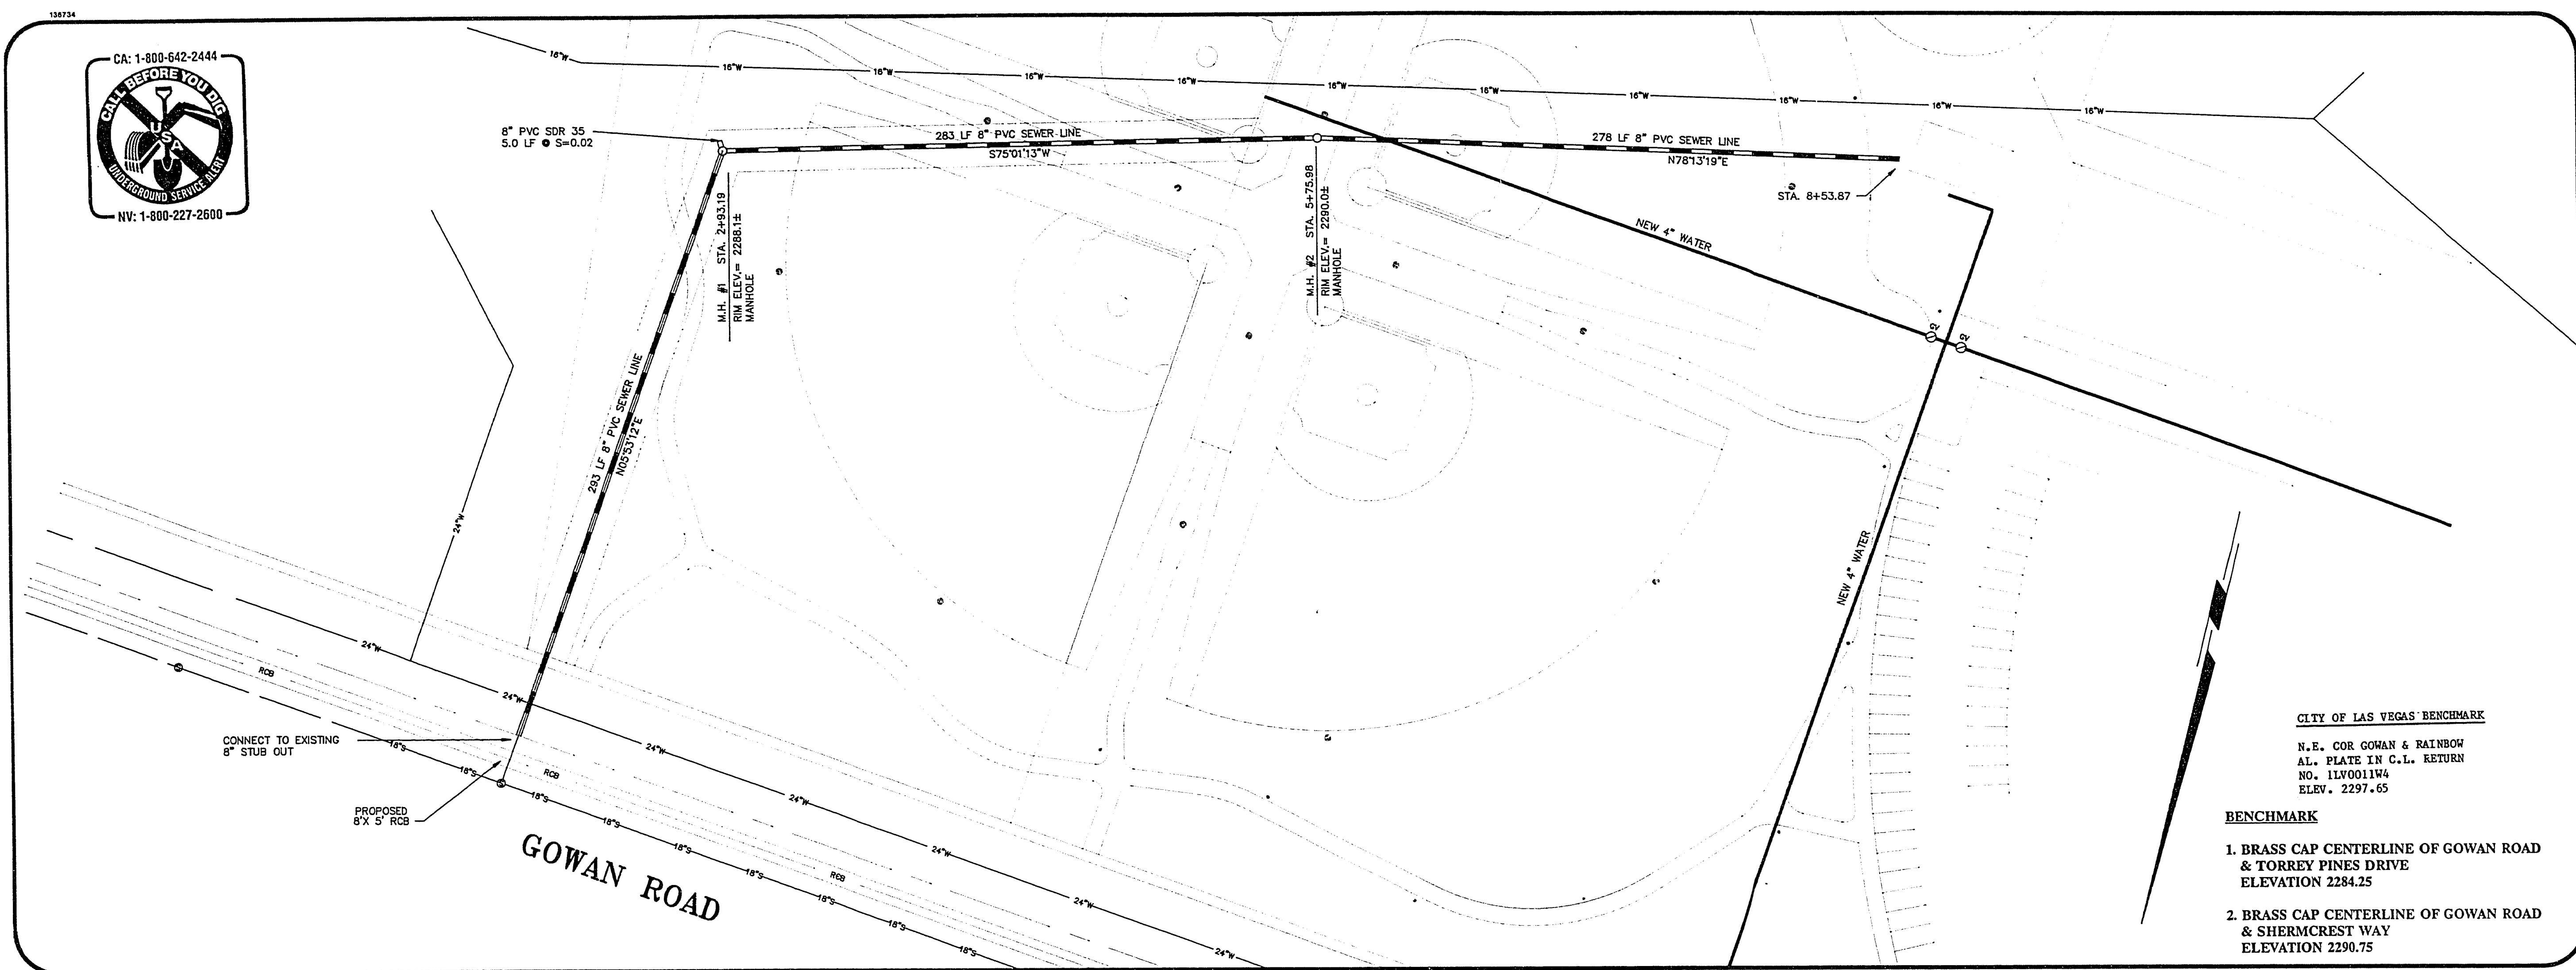

N.E. COR GOWAN & RAINBOW
AL. PLATE IN C.L. RETURN
NO. 1LV0011W4
ELEV. 2297.65

1. BRASS CAP CENTERLINE OF GOWAN ROAD
& TORREY PINES DRIVE
ELEVATION 2284.25
2. BRASS CAP CENTERLINE OF GOWAN ROAD
& SHERMCREST WAY
ELEVATION 2290.75

[illegible]


2300 PASEO DEL PRADO SUITE D 108
LAS VEGAS, NEVADA 89102
PHONE (702) 364-1066




CITY OF LAS VEGAS
DEPARTMENT OF PARKS
AND LEISURE ACTIVITIES

LOCATION OF UNDERGROUND UTILITIES SHOWN ON THE DRAWING
WERE OBTAINED BY A SEARCH OF AVAILABLE RECORDS. NEITHER
THE OWNER NOR THE ENGINEER ASSUME ANY RESPONSABILITY
FOR UTILITIES OR STRUCTURES NOT SHOWN OR NOT IN THE
LOCATION SHOWN ON TH DRAWINGS.

THE CONTRACTOR SHALL TAKE ALL PRECAUTIONARY MEASURES NECESSARY TO PROTECT EXISTING IMPROVEMENTS, WHICH ARE TO REMAIN IN PLACE. SHOULD ANY DAMAGE OCCUR, THE CONTRACTOR SHALL BE LIABLE AND SHALL PROVIDE REPAIR AT HIS EXPENSE AND TO THE APPROVAL OF THE ENGINEER AND THE APPROVAL OF THE DAMAGED PARTY.

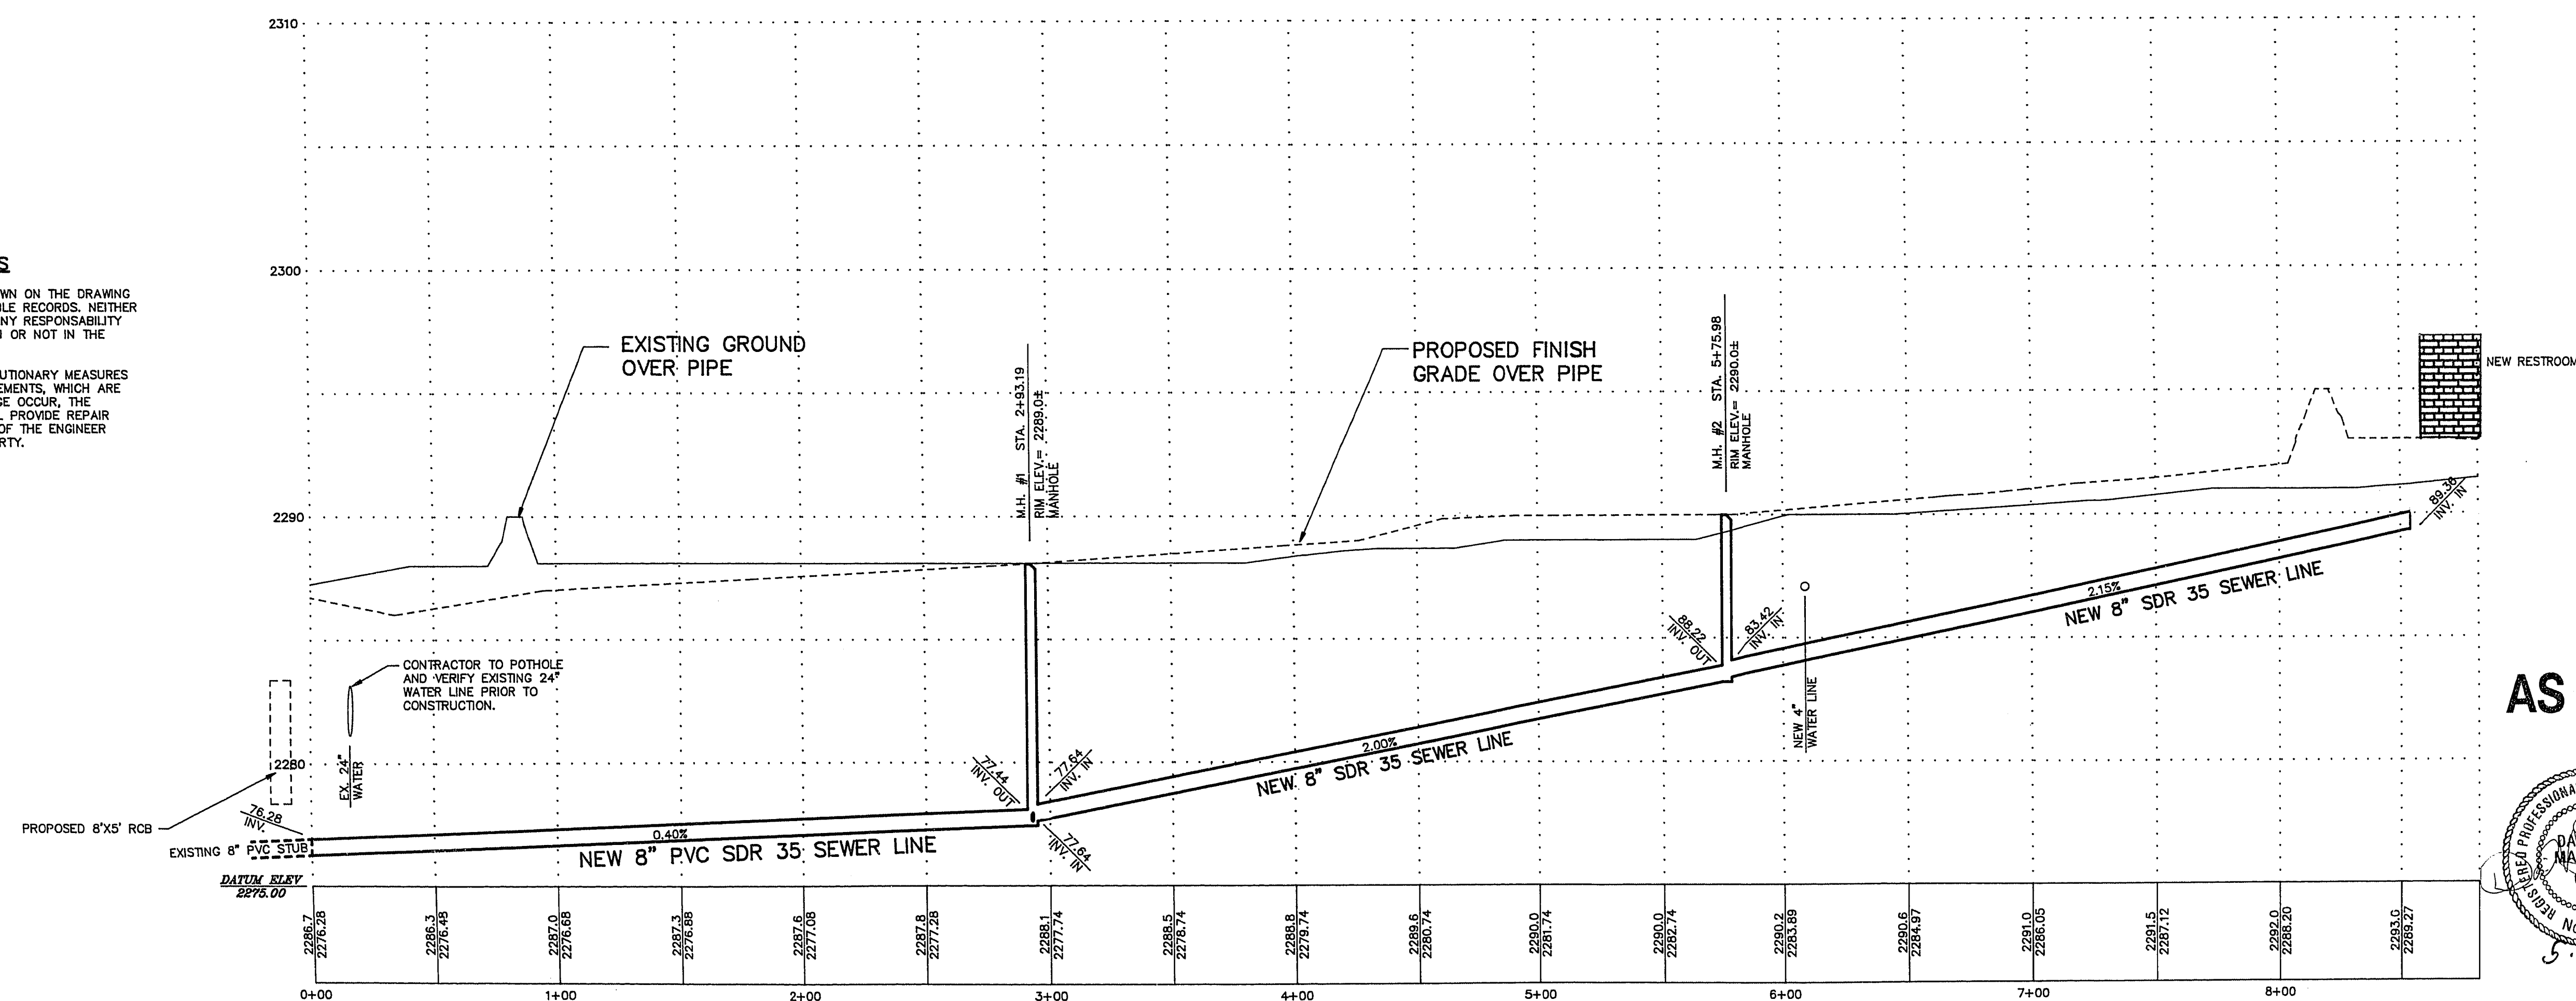

AS BUILT

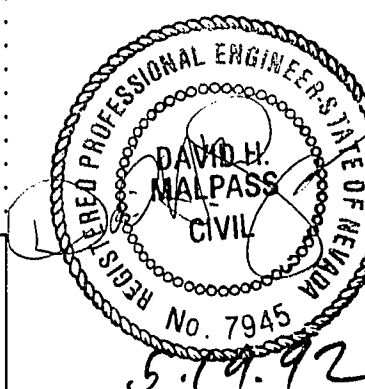SEWER LINE
PLAN & PROFILE

4-I-001 PARK SITE
GOWAN & TORREY PINES

CHILDRENS MEMORIAL PARK

5

PROJECT NO. 91-2443
DATE : 5/8/92
SCALE : HORIZ. 1"=40'
VERT. 1"=4'

SHEET

U2

38 SHEET

650,35-VI