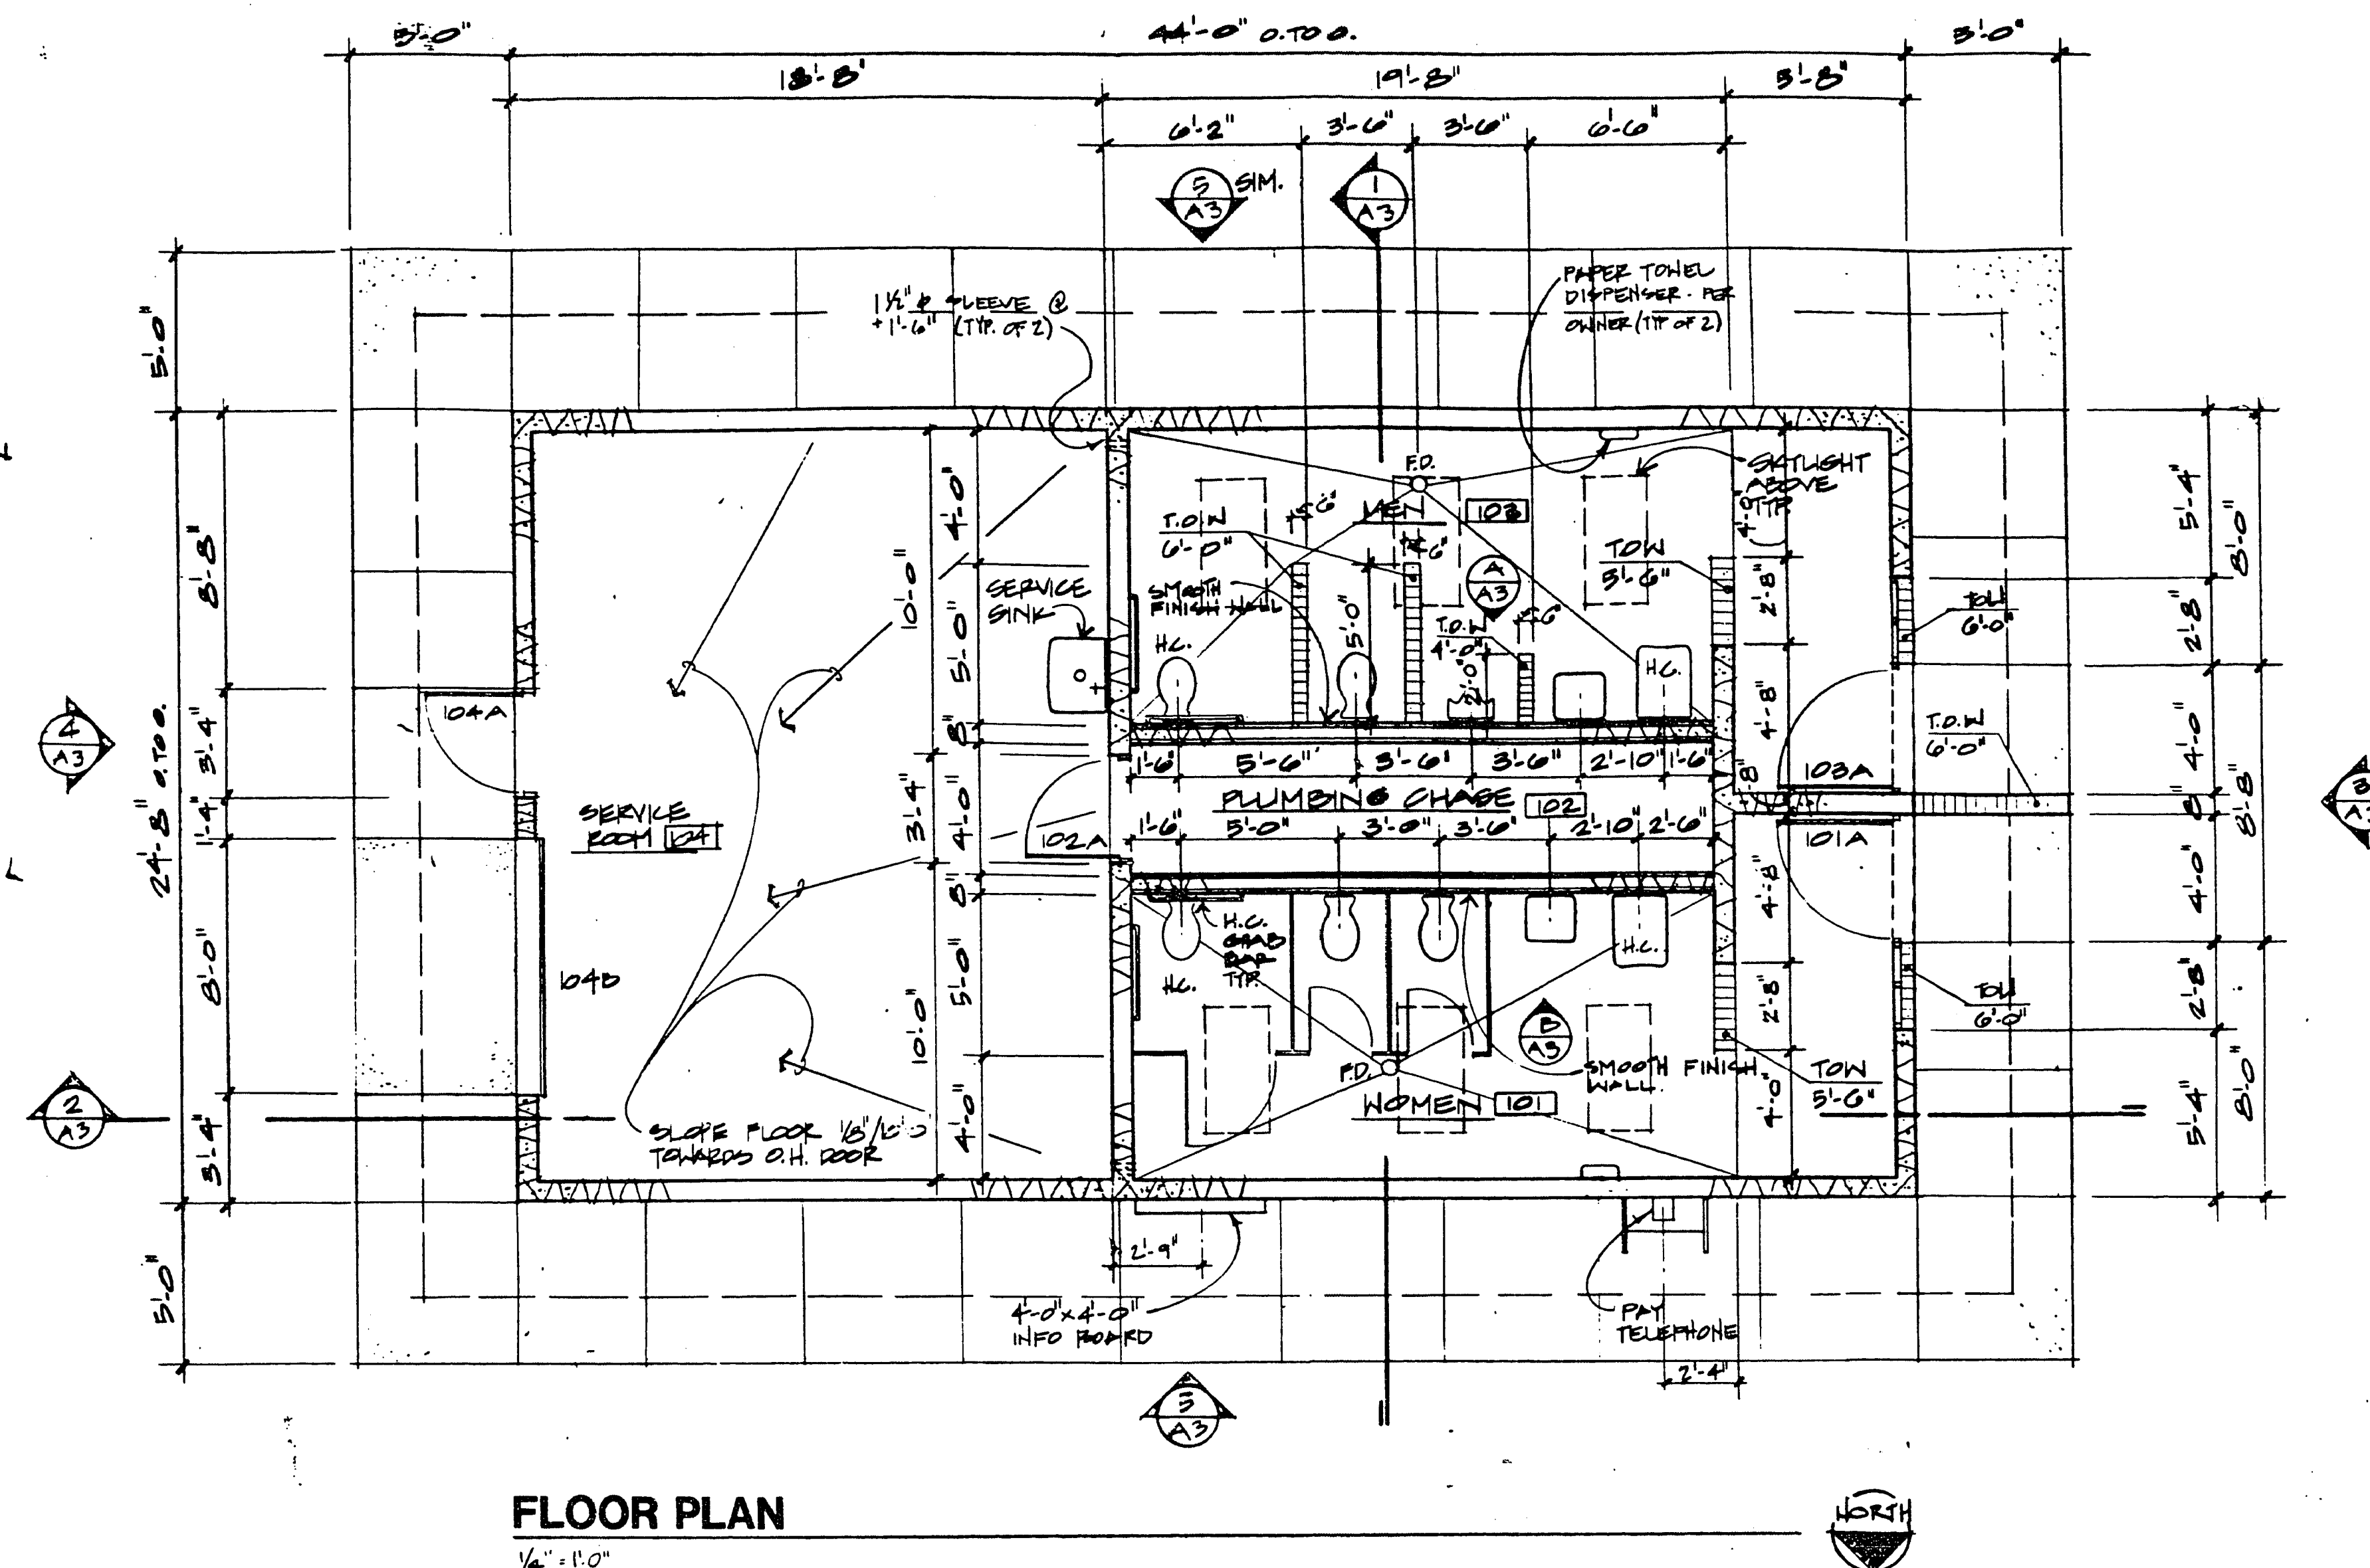


[illegible]

P	PAINT
SB	SLUMP BLOCK
WI	WROUGHT IRON
MET	METAL
T111	5/8" T111 PLYWD

[illegible]
$$\frac{1}{4}'' = 1.0''$$

HARDWARE SCHEDULE

HW-1


1 1/2 PR. BUTTS BB4101 26D 4 1/2 X 4 1/2 NNP
1 EA. LOCK 35H7A3H X 625
1 EA. CLOSER 120 SBL (DR 104A)
1 EA. D.H. STOP 1850 (DR 104A)
1 EA. THRESHOLD 2005AB (DR 104A)
1 ST. SEAL 303AB (DR 104A)

HW-2


1 EA. PADLOCK KEVED TO MASTER SYSTEM WITH "CAPTIVE" CHAIN.

BUTTS: LAWRENCE
LOCKSETS: BEST
CLOSERS: CORBIN
THRESHOLDS & WEATHERSTRIP: PENKO

 SAWTOOTH PULSE CML
 SMOOTH PULSE CML

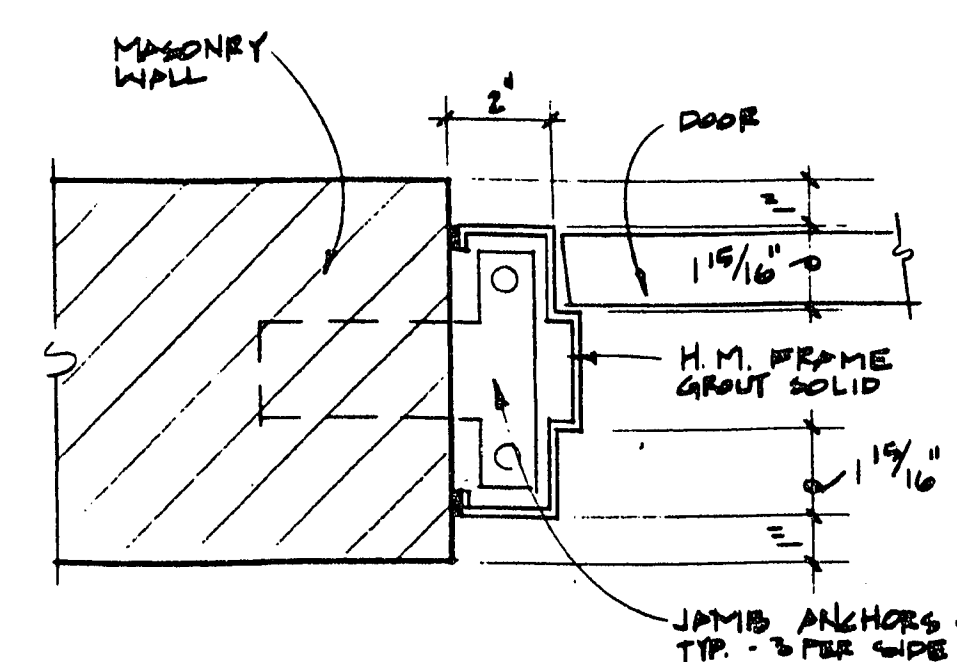


1 DOOR JAMB HEAD SIMILAR

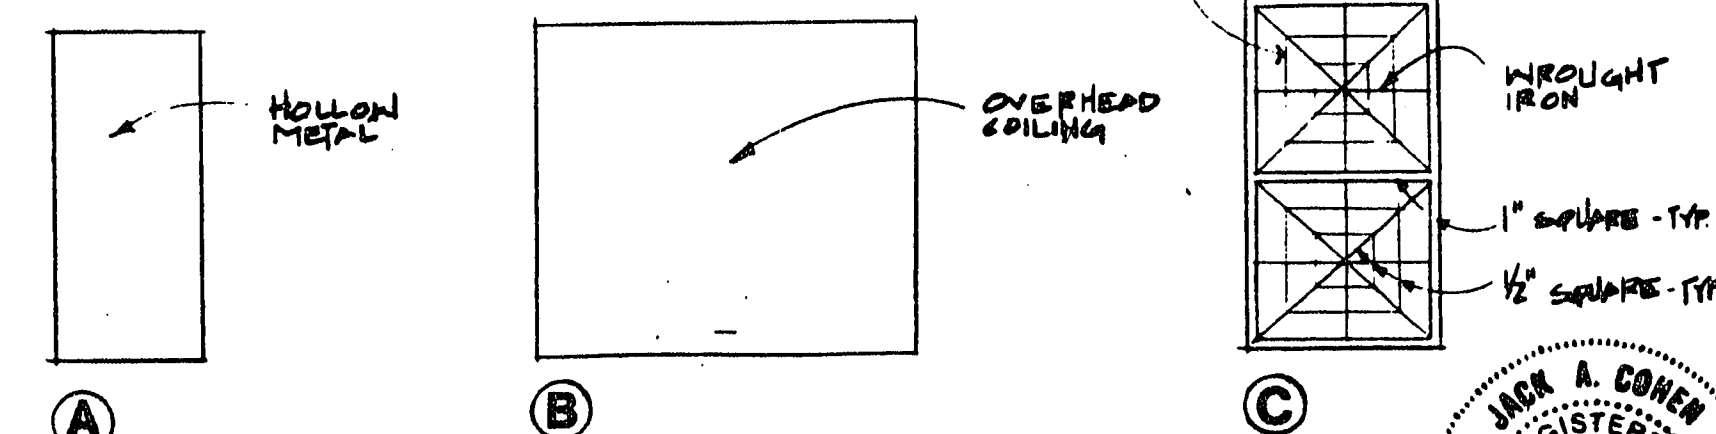

DOOR TYPES

AS BUILT

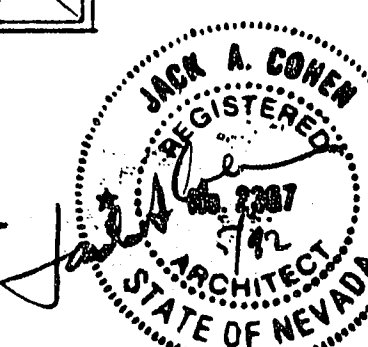

**FLOOR PLAN, REFLECTED
CEILING PLAN & SCHEDULES**

**- I - 001 PARK SITE
GOWAN & TORREY PINES
LAS VEGAS, NEVADA**

CHILDRENS MEMORIAL PARK

מחיר

PROJECT NO: _____
DATE: 11 MAY 92
SCALE: AS NOTED
JCA # 83892

SHEET

A1

11 OF 38 SHEETS

650,35-VI