


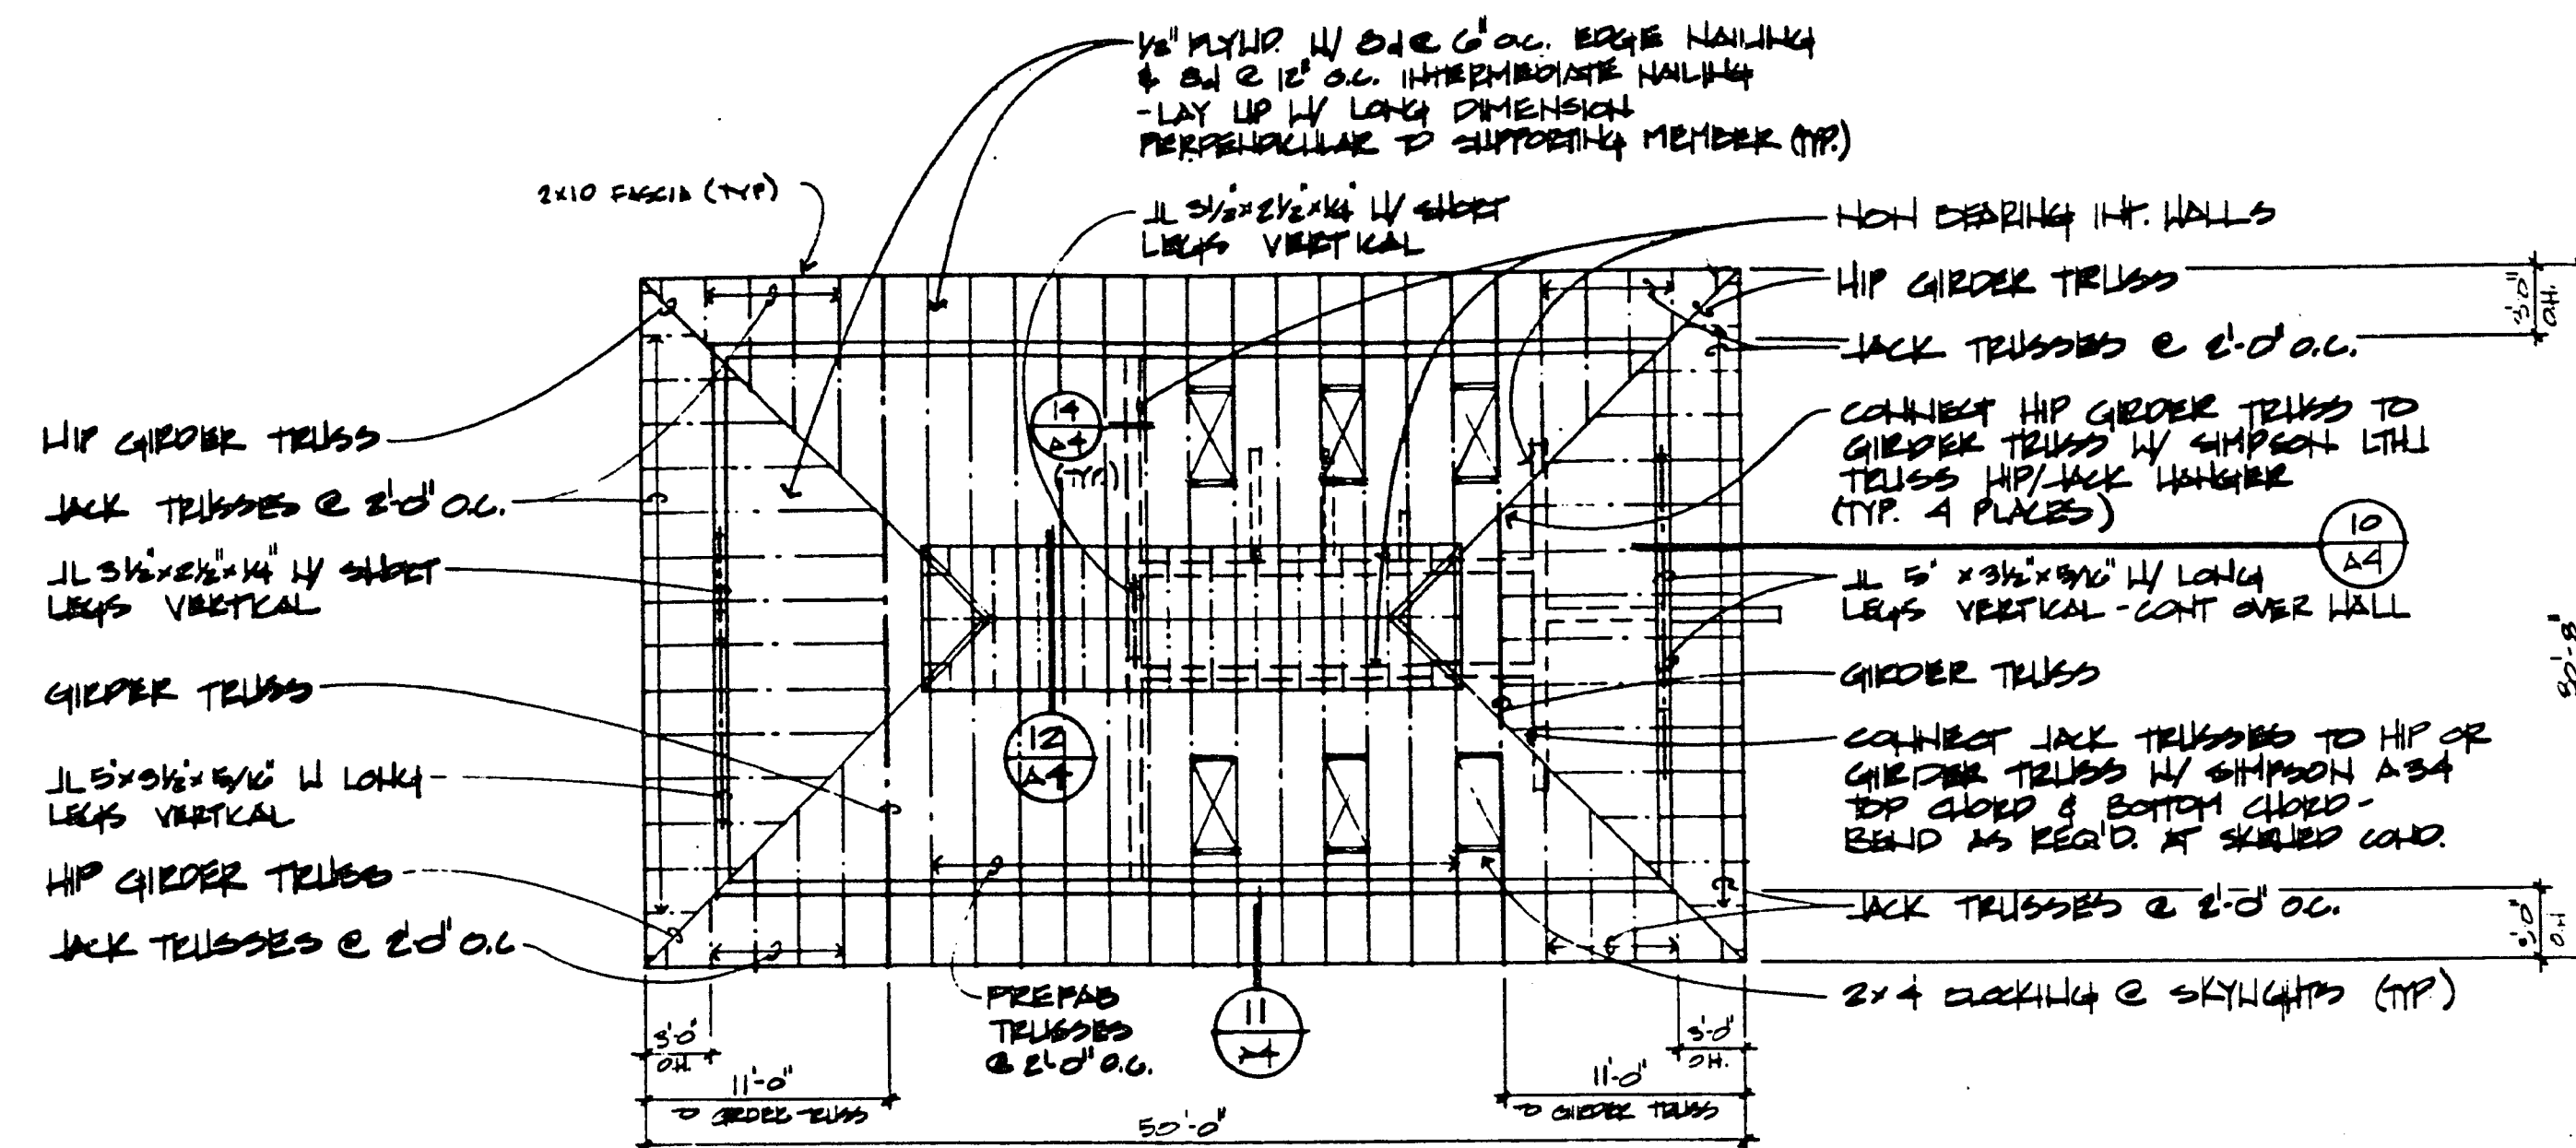


ROOF FRAMING PLAN

SCALE: 1/8" = 1'-0"

PREPARED TRUSSES SHALL BE ORIENTED
 ACCORDING TO THE FOLLOWING CRITERIA:
 PL-17 R/SF: TOP CHORD: 0.01 R/SF BOTTOM CHORD: 0.01 R/SF
 LL-16 R/SF
 DURATION OF LOADING: 1.25
 SEE DETAIL 12 FOR ADDITIONAL LOADS

SLOPE 15/100
 1" CONC. SLAB AT 4" ABC
 FILL (TYP.)
 1-4" x 8" MASONRY COLUMN W/ 4" x 8"
 VERT. 4" x 8" TIE @ 8' O.C. -
 LOCATE @ 5' VERT. 2'4" CLR FROM
 FACE OF WALL. LAP @ 1' x 5' VERT.
 25' MIN.

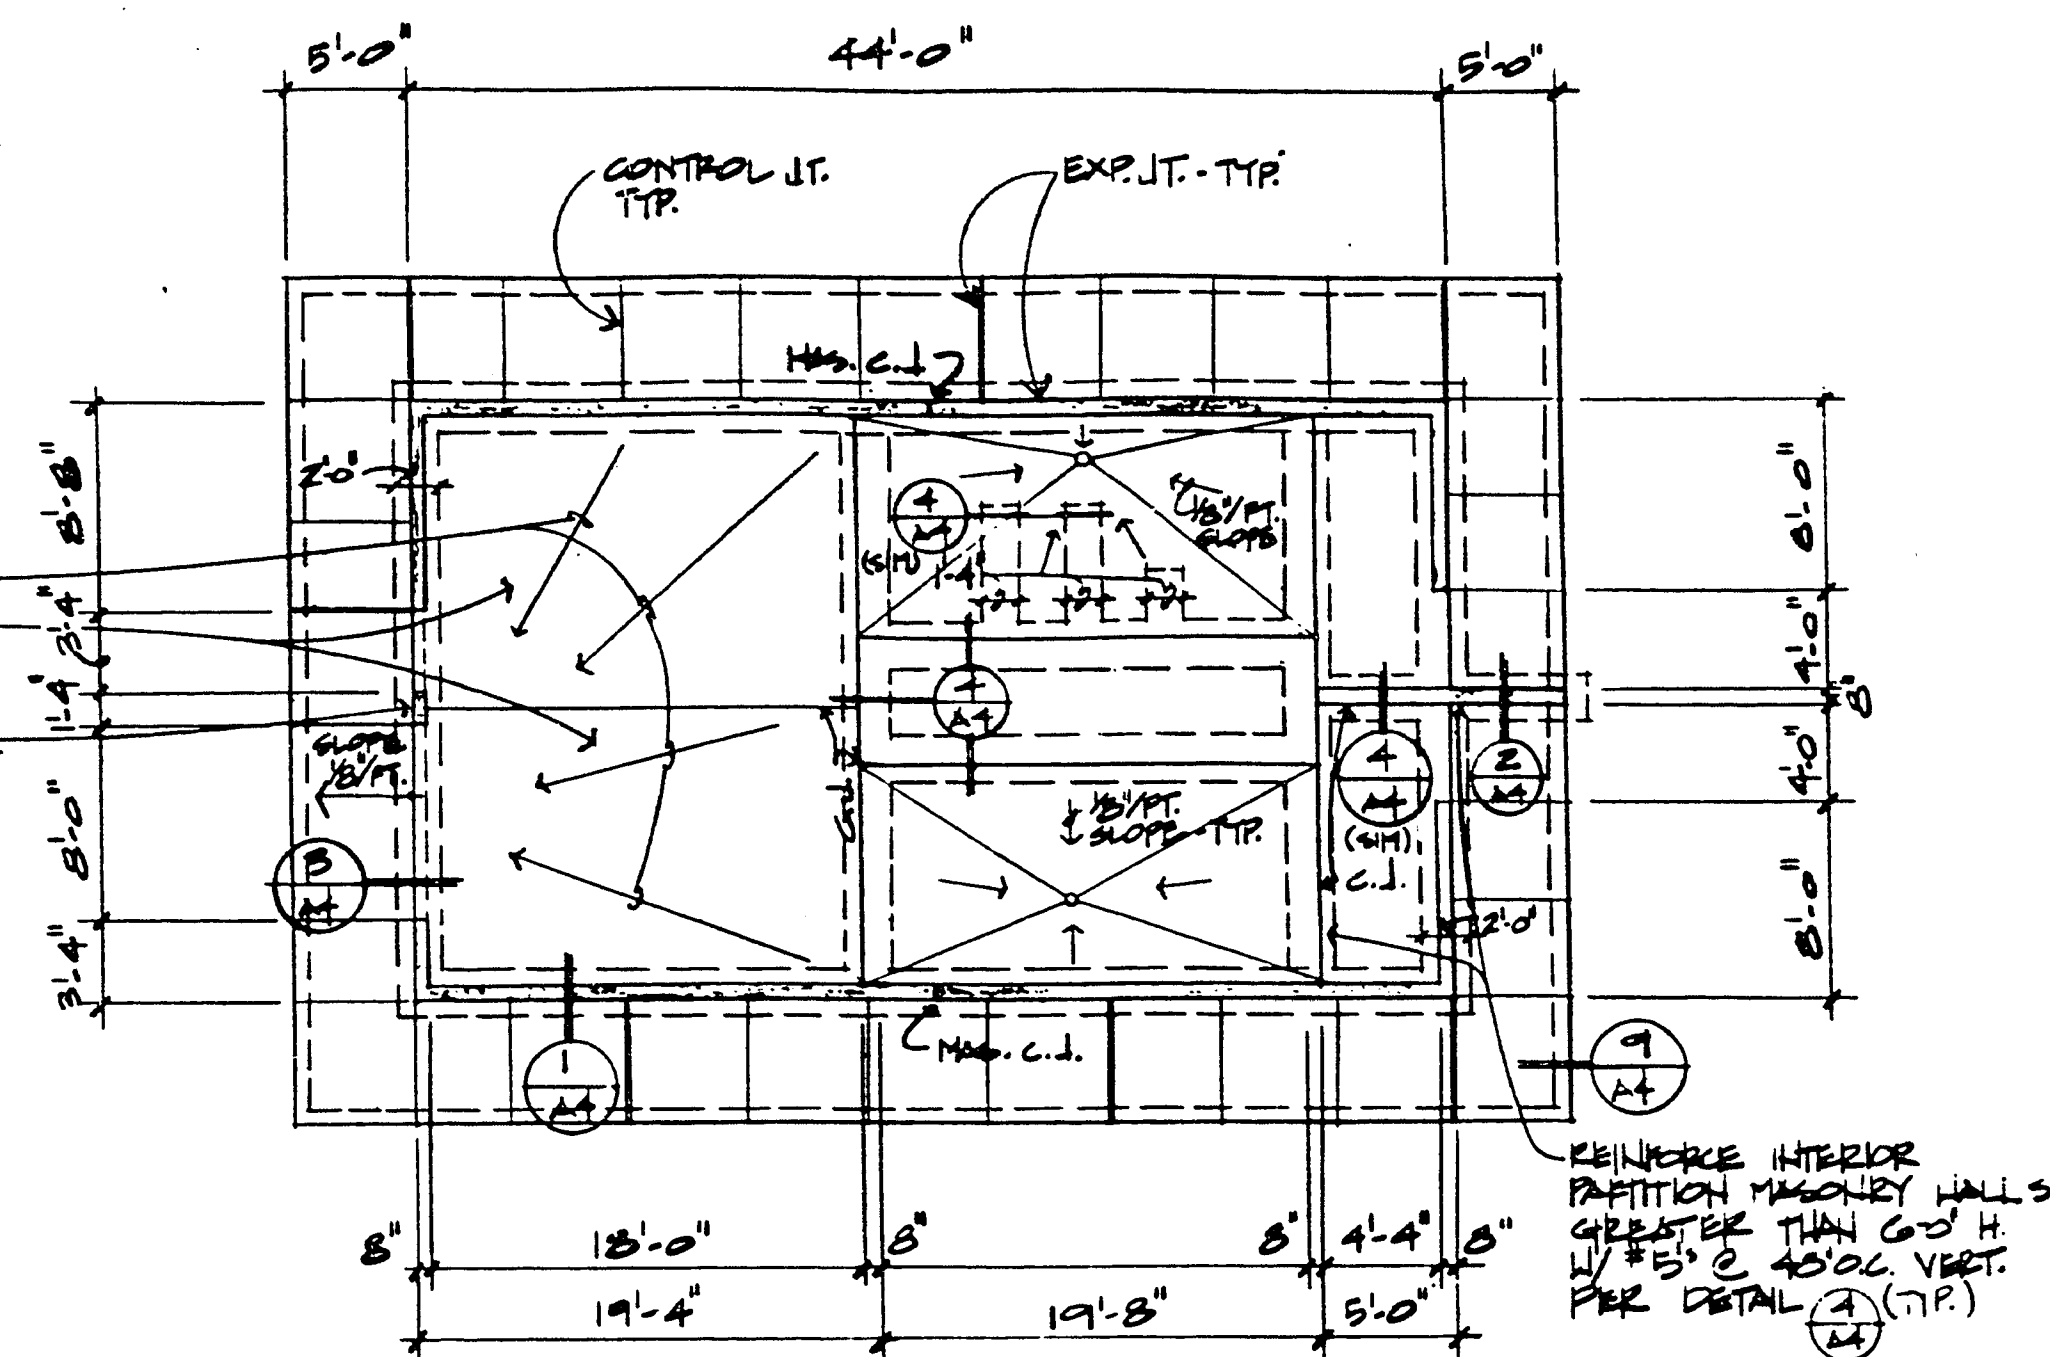



FOUNDATION PLAN

SCALE: 1/8" = 1'-0"

NOTE:

IF POROUS SILT SOILS OR UNCONTROLLED FILLS ARE ENCOUNTERED IN THE AREA WHERE THE BUILDING IS LOCATED, OVER EXCAVATE AND RECOMPACT IN ACCORDANCE WITH THE RECOMMENDATIONS CONTAINED IN THE GEOTECHNICAL EXPLORATION REPORT PREPARED BY WESTERN TECHNOLOGIES, INC., PROJECT NO. 4122K081, DATED APRIL 7, 1992, A COPY OF WHICH IS ON FILE WITH THE OWNER. DETERMINATION OF SOIL CONDITIONS SHALL BE MADE BY THE SOILS ENGINEER AT THE TIME OF EXCAVATION WITH A COPY OF THE REPORT OF HIS FINDINGS AND RECOMMENDATIONS FORWARDED TO THE ARCHITECT.

AS BUILT

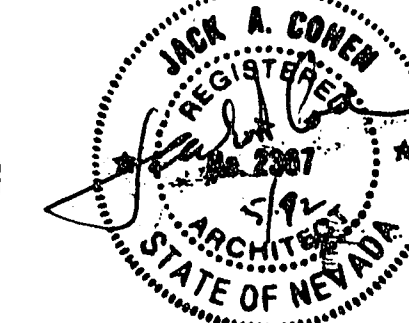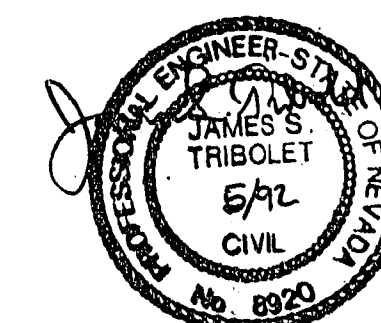

**FOUNDATION PLAN &
 ROOF FRAMING PLAN**

**4 - I - 001 PARK SITE
 GOWAN & TORREY PINES
 LAS VEGAS, NEVADA**

CHILDRENS MEMORIAL PARK

TITLE

PROJECT

DESIGNED BY

APPROVED BY

DATE

REVISION

REV

BY

DATE

REVISION

REV

BY

DATE

REVISION

REV