




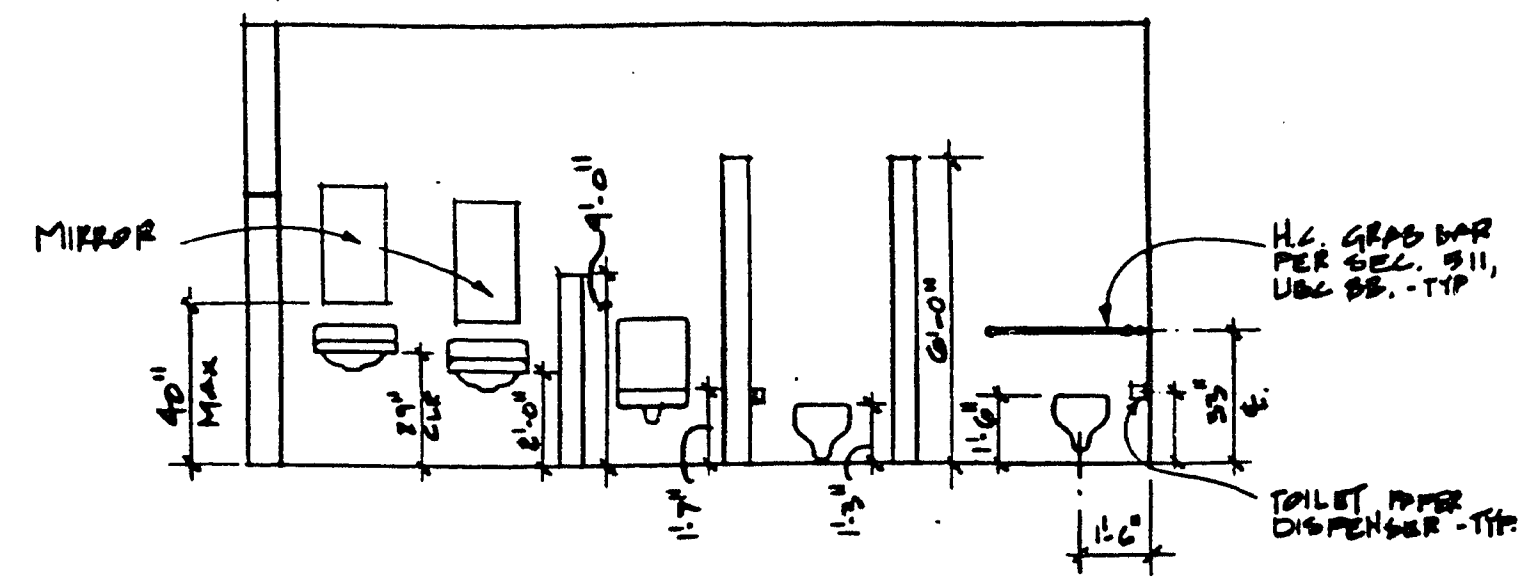


A MEN'S BATH

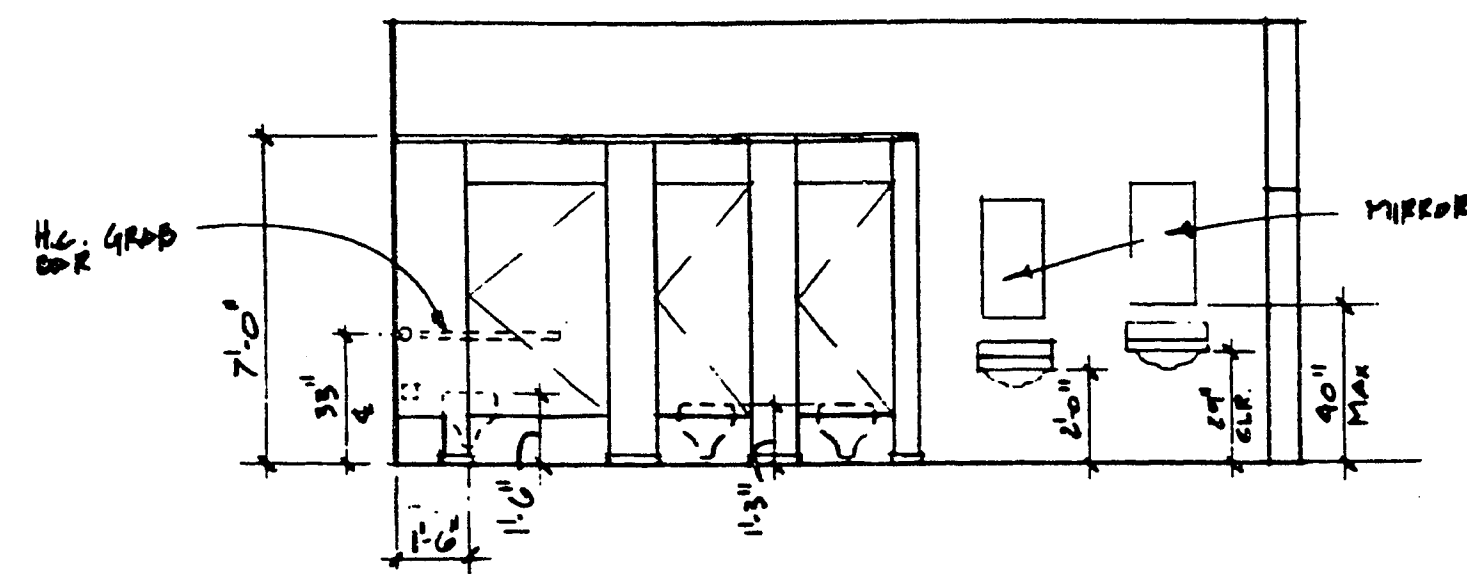


B WOMEN'S BATH

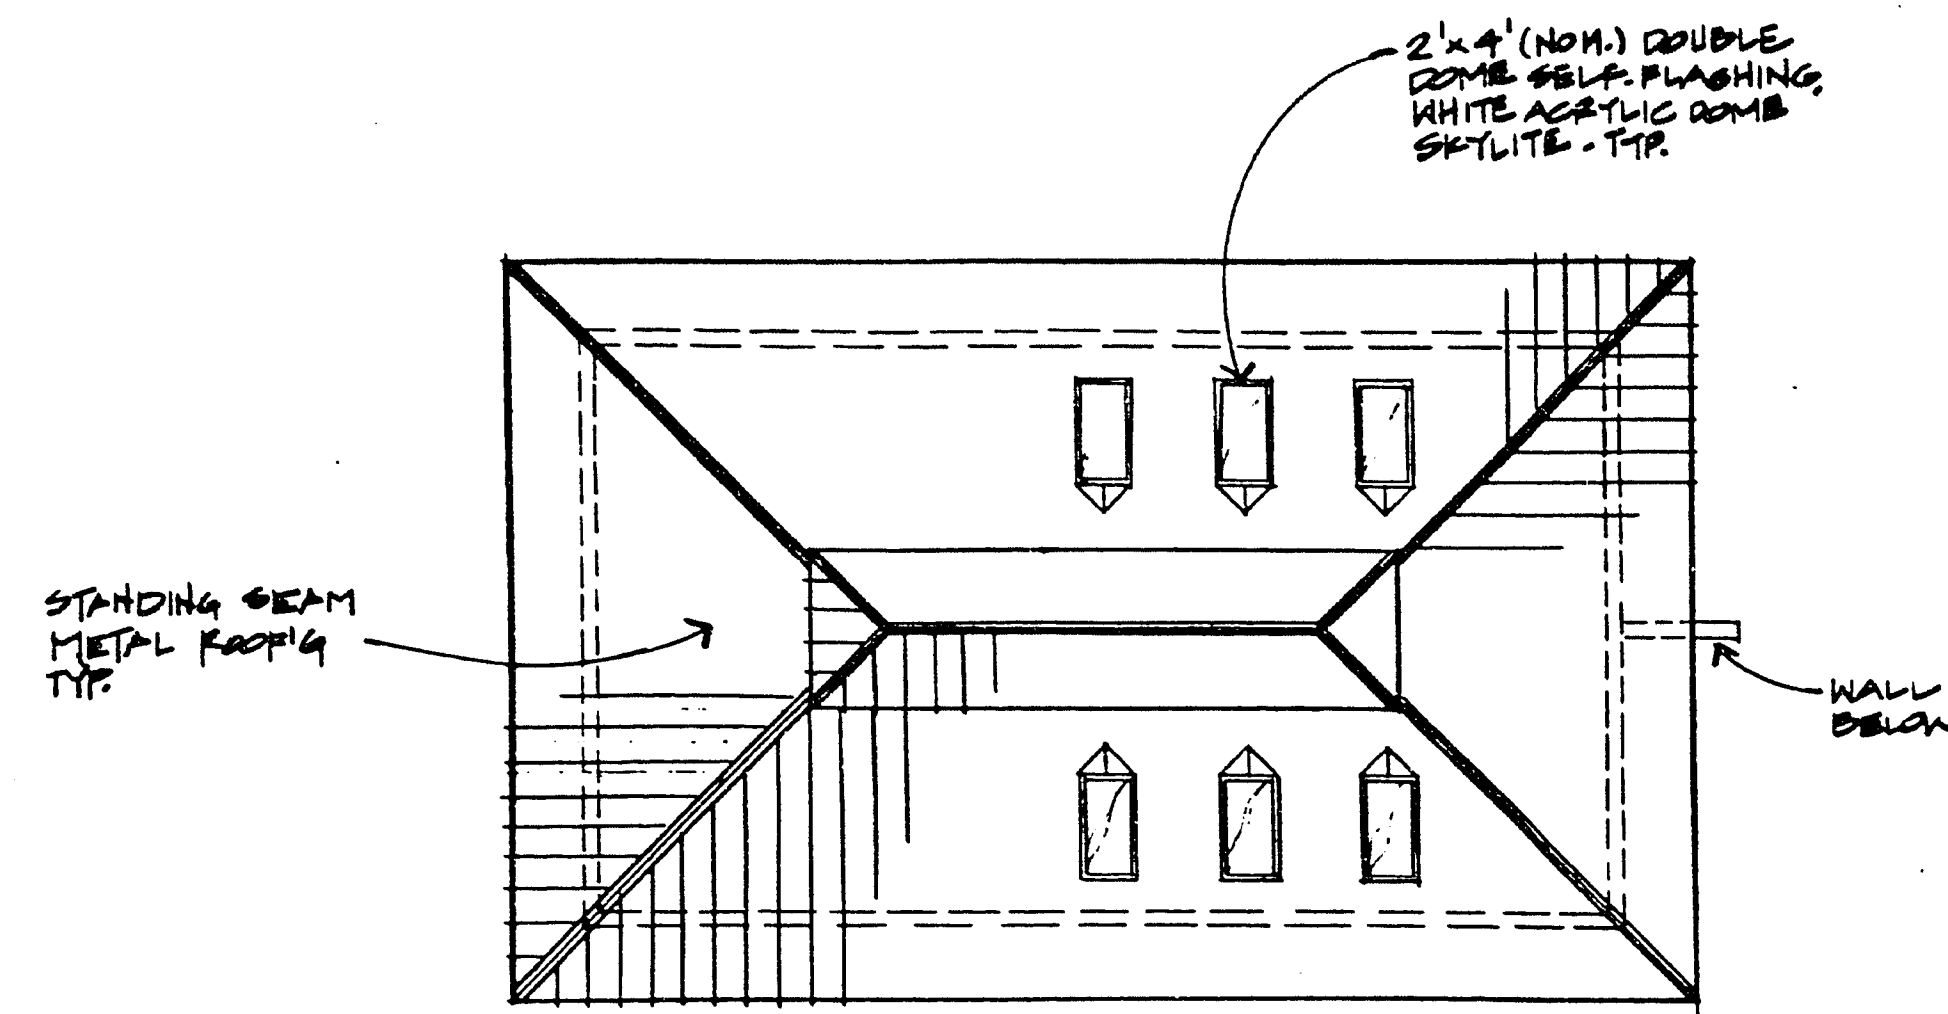


ROOF PLAN
SCALE 1/8"=1'-0"

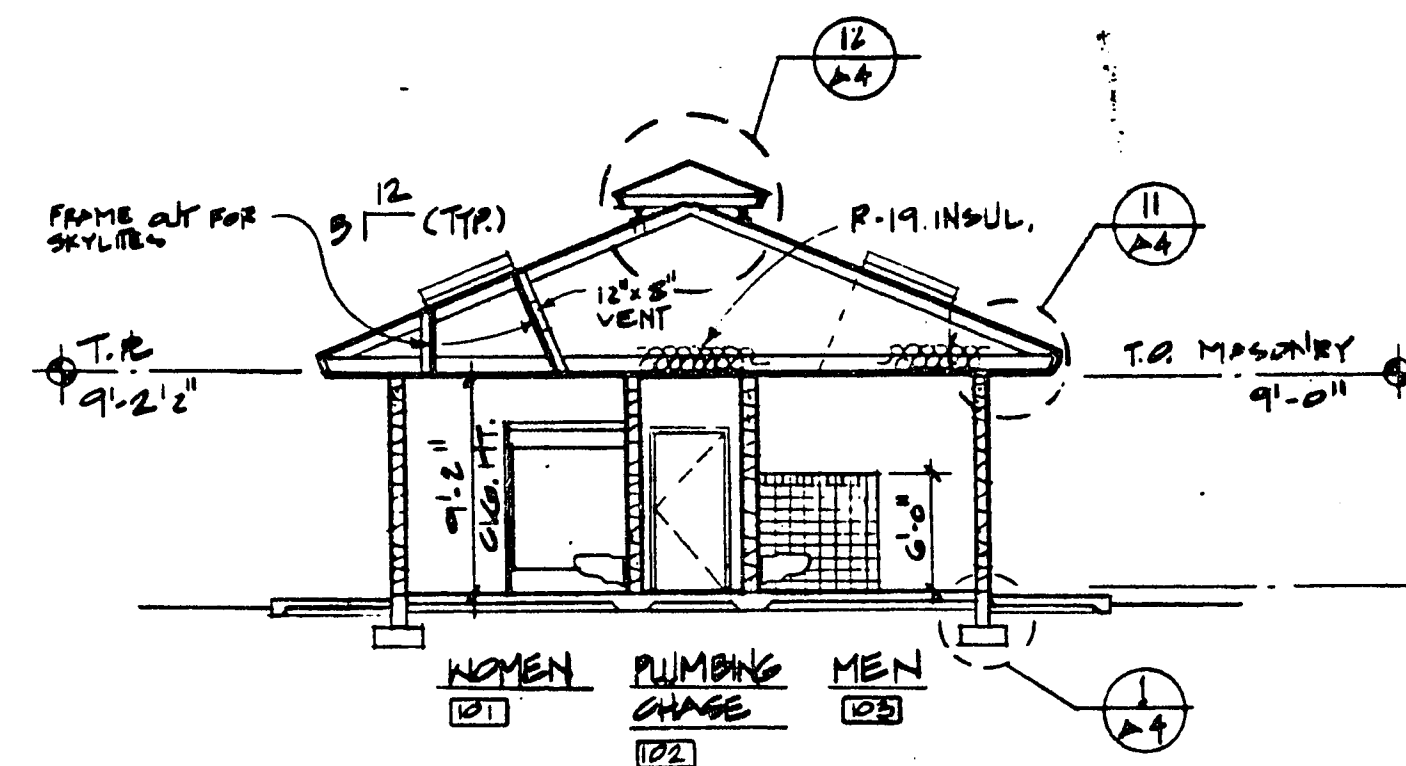


1 SECTION

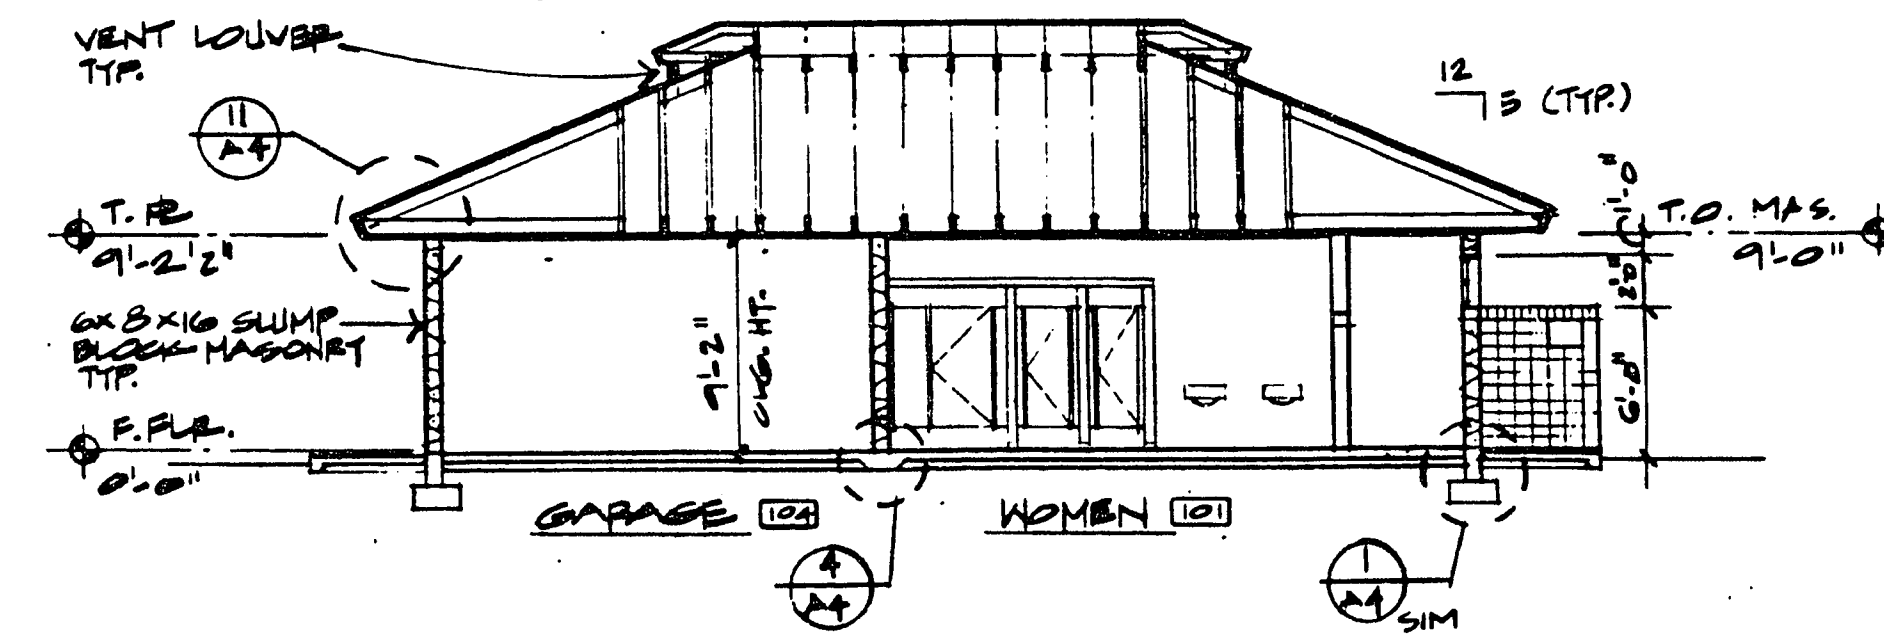


2 SECTION

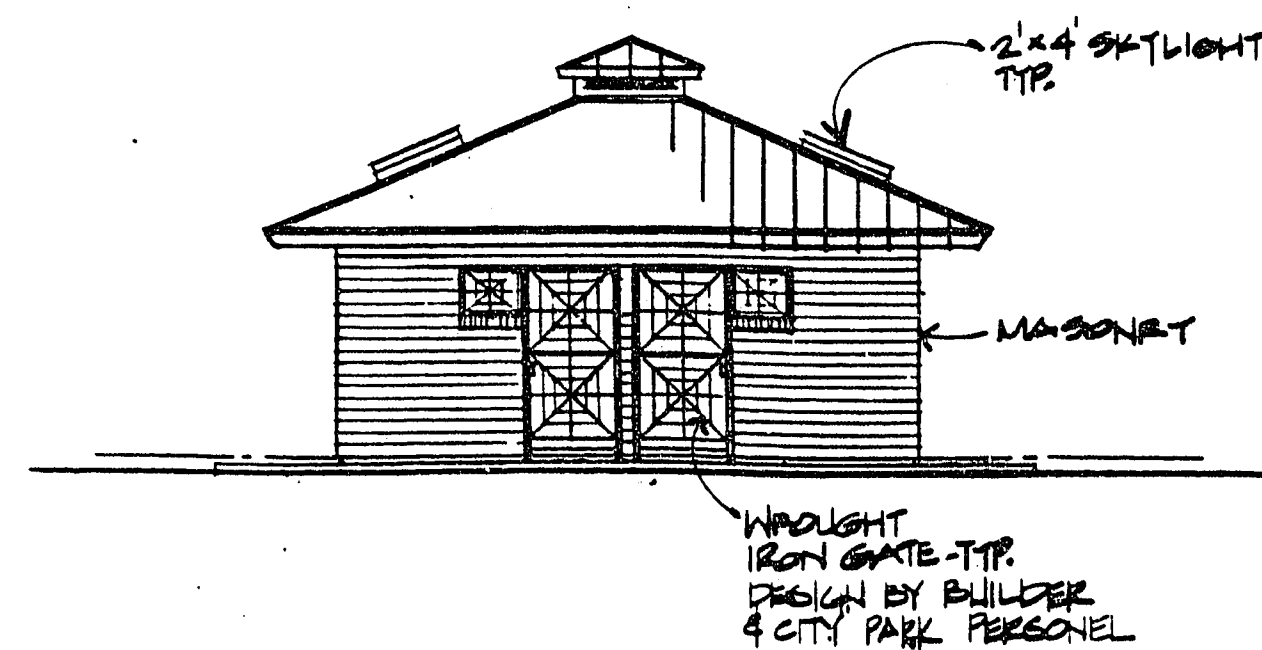

3 WEST ELEVATION

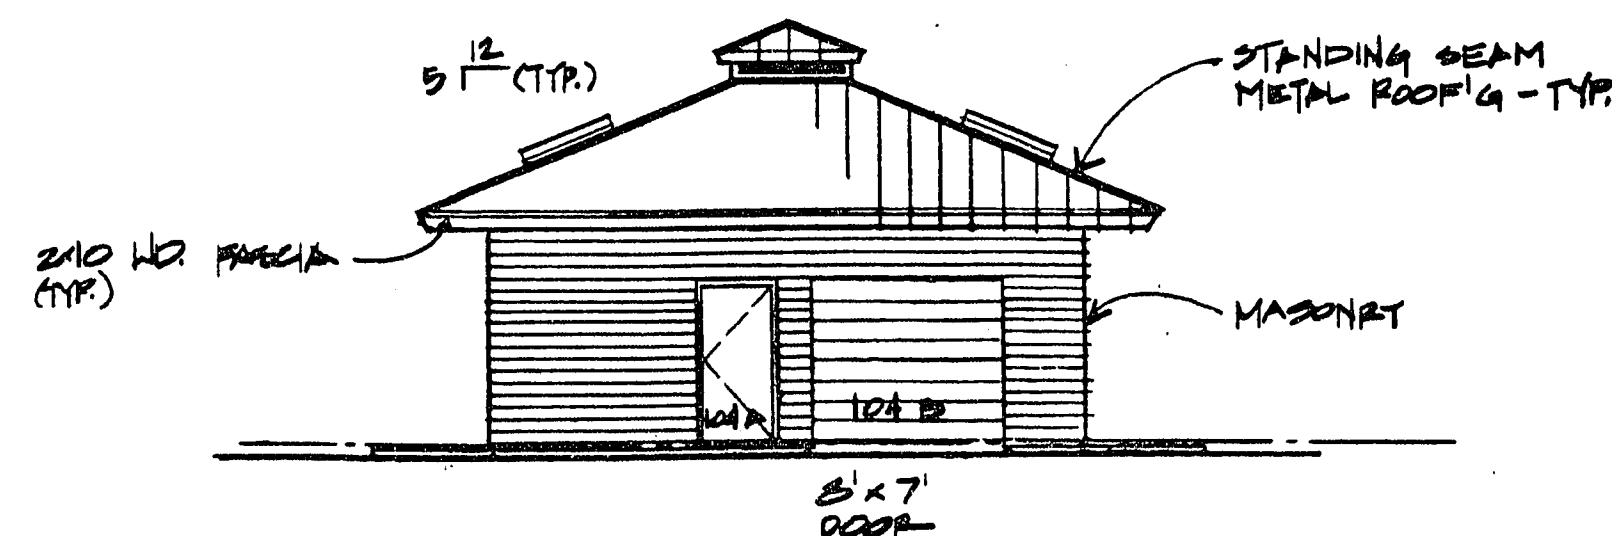

4 EAST ELEVATION

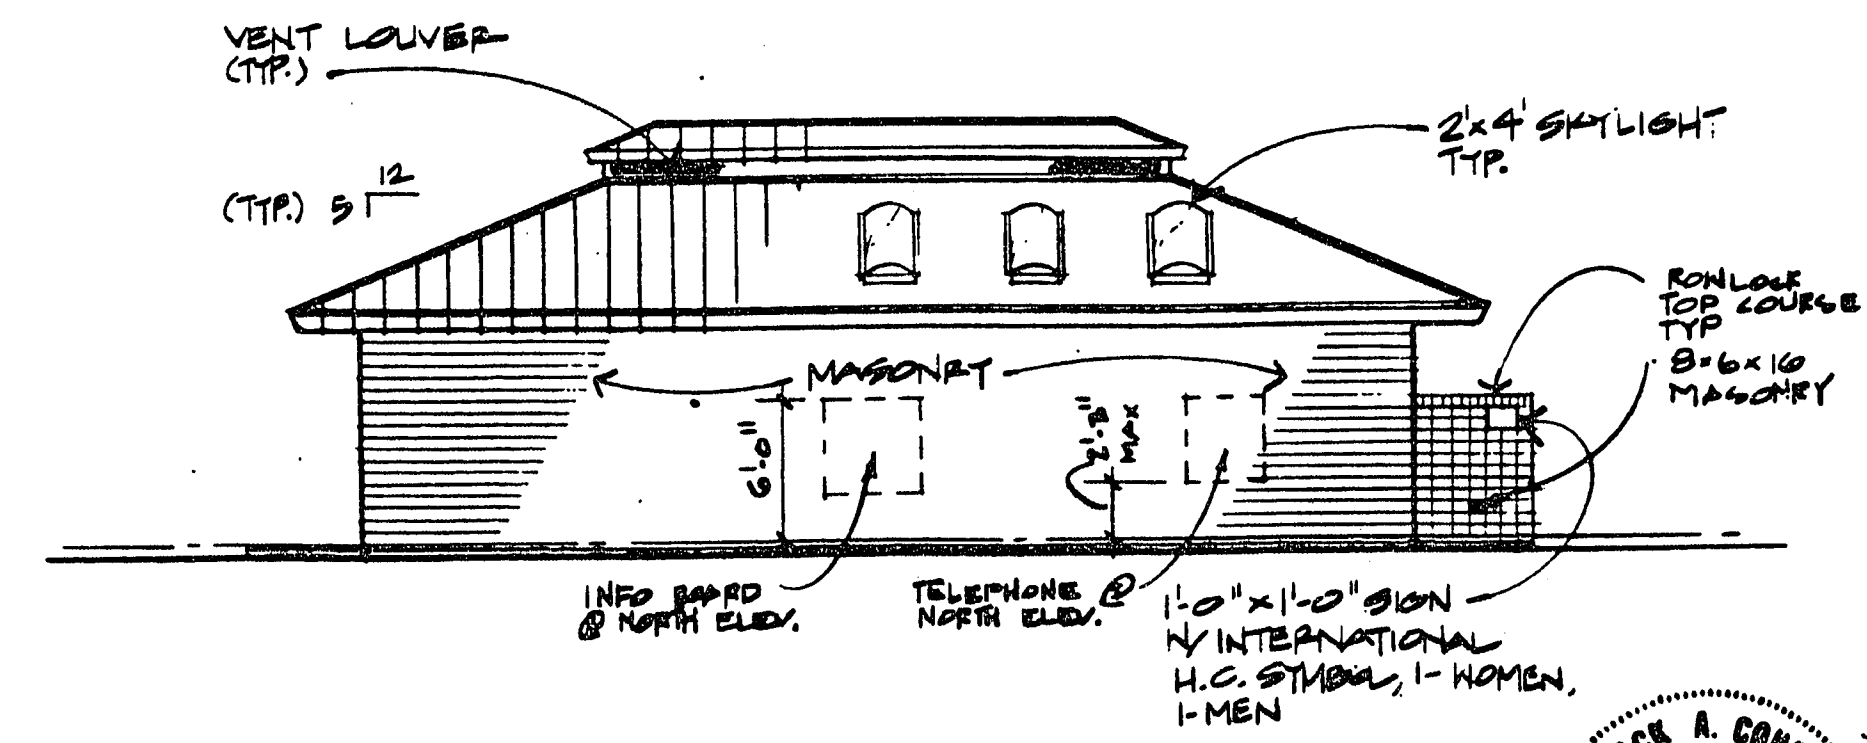

5 NORTH ELEVATION
SOUTH ELEVATION SIMILAR

AS BUILT

**ROOF PLAN, SECTIONS
& ELEVATIONS**

4 - I - 001 PARK SITE
GOWAN & TORREY PINES
LAS VEGAS, NEVADA

CHILDRENS MEMORIAL PARK

PROJECT NO. _____
DATE: 11 MAY 92
SCALE: AS NOTED
JCA # 83892

A3

13 of 38 SHEETS

650.35-VI

REV.	DATE	BY	REASON

JCA
ARCHITECTURE
ENGINEERS & DESIGNERS, INC.

JCA
ARCHITECTURE
ENGINEERS & DESIGNERS, INC.

2300 PASEO DEL PRADO SUITE D 108
LAS VEGAS, NEVADA 89102
PHONE (702) 364-1066

JCA
ARCHITECTURE
ENGINEERS & DESIGNERS, INC.

JCA
ARCHITECTURE
ENGINEERS & DESIGNERS, INC.

4 - I - 001 PARK SITE
GOWAN & TORREY PINES
LAS VEGAS, NEVADA

CHILDRENS MEMORIAL PARK

PROJECT NO. _____
DATE: 11 MAY 92
SCALE: AS NOTED
JCA # 83892

A3

13 of 38 SHEETS

650.35-VI