

LEGEND

KEY	DESCRIPTION
B	BENCH MODEL# 1267-G, SHT. L1.7.
○	DRINKING FOUNTAIN MODEL# 38-WC-2, SHT. L1.7, SHT. G/L2.3
○	TRASH RECEPTALS MODEL# 1129-G, SHT. L1.7
●	STATIONARY BOLLARDS MODEL# EB-D-F, SHT. H/L2.3
✕	REMOVABLE BOLLARDS MODEL# S14-AE, SHT. H/L2.3

NOTE:

SEE CIVIL ENGINEERING FOR :

BEGINNING END & RADIUS POINT OF WALL DRAINAGE THIS AREA

COLORED CONCRETE, CHEMICAL STAIN - ORANGE / RED COLOR, LIGHT BROOM FINISH


COLORED CONCRETE, CHEMICAL STAIN - ORANGE / YELLOW COLOR, SMOOTH FINISH

COLORED CONCRETE, CHEMICAL STAIN - ORANGE / RED COLOR, MEDIUM SAND BLAST FINISH

COLORED CONCRETE, CHEMICAL STAIN - ORANGE / YELLOW COLOR, LIGHT BROOM FINISH

SAW CUT CONTROL JOINT, 15' OC TYP.

FIBER EXPANSION JOINT AT PLAYGROUND PLAZA

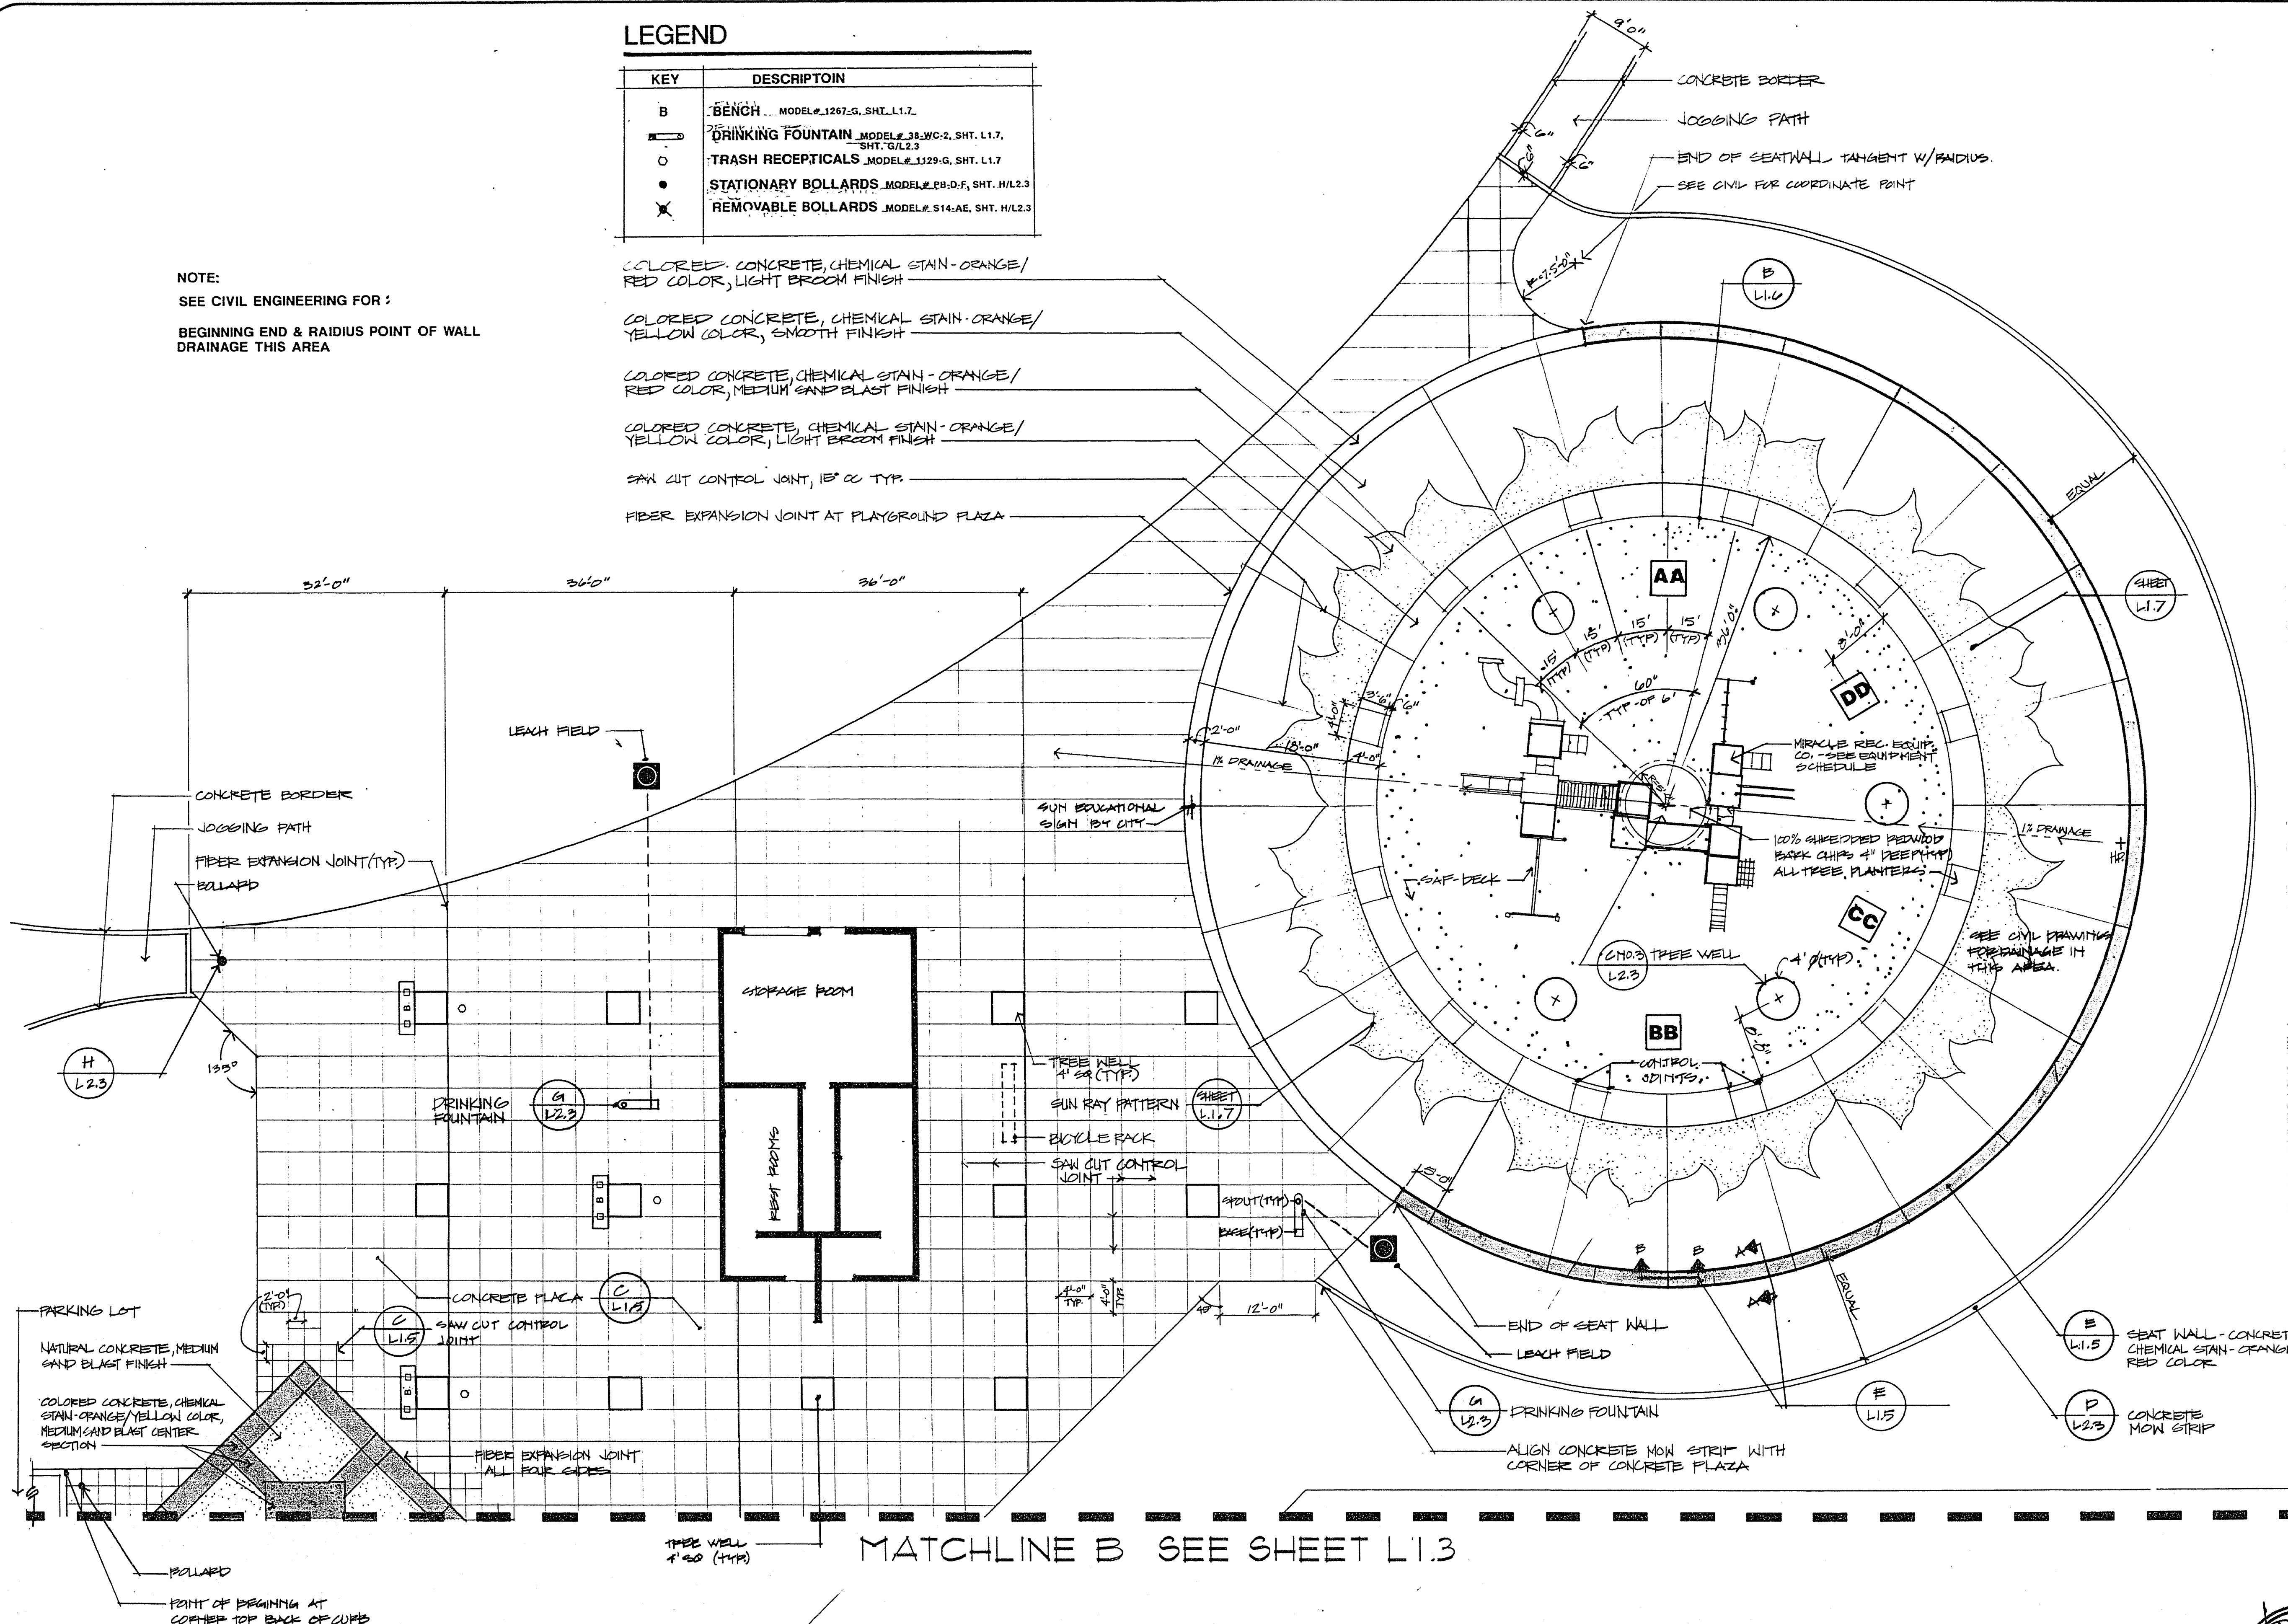

TOT-LOT PLAZA

1"=10'-0"



AS BUILT

LAYOUT PLAN

CHILDRENS MEMORIAL PARK

TITLE

PROJECT

DRAWN BY

DESIGNED BY

APPROVED BY

REV.

DATE

BY

REVISION

PROJECT NO. JWZ-91403
DATE: MAY 4 1992
SCALE: HORIZ. 1"=10'-0"

SHEET
L1.4
26 OF 38 SHEETS

650.35-VI

2300 PASEO DEL PRADO SUITE D 108
LAS VEGAS, NEVADA 89102
PHONE (702) 364-1066

THE MARK GROUP
CORPORATION & ASSOCIATES, INC.

AVZUNINO ASSOCIATES
LANDSCAPE ARCHITECTS
1000 W. SPRING MOUNTAIN ROAD
SUITE 100 LAS VEGAS, NEVADA 89102
PHONE (702) 364-1066

PROJECT

TITLE