

CHILDREN'S PLAY EQUIPMENT

MIRACLE RECREATION EQUIPMENT CO.		LOCKVILLE DECK SYSTEM	
4 EA	MIRACLE RECREATION EQUIPMENT CO.	162 - 558	LEVEL DECK ADDITION W/2 POSTS
2 EA	MIRACLE RECREATION EQUIPMENT CO.	162 - 571	SINGLE 3' DECK W/ROOF
2 EA	MIRACLE RECREATION EQUIPMENT CO.	162 - 572	SINGLE 5' DECK W/ROOF
1 EA	MIRACLE RECREATION EQUIPMENT CO.	162 - 558	LEVEL DECK ADD. W/2 POSTS W/ROOF
1 EA	MIRACLE RECREATION EQUIPMENT CO.	162 - 957	OVERHEAD FLYER W/3 POSTS
2 EA	MIRACLE RECREATION EQUIPMENT CO.	162 - 908	SPIDER CLIMBER
2 EA	MIRACLE RECREATION EQUIPMENT CO.	162 - 828-2	10' ROCKITE HURRICANE SLIDE (5)
1 EA	MIRACLE RECREATION EQUIPMENT CO.	162 - 959	TRANSFER POINTS 3' TO 5'
2 EA	MIRACLE RECREATION EQUIPMENT CO.	162 - 900	WALL WITH STEERING WHEEL
2 EA	MIRACLE RECREATION EQUIPMENT CO.	162 - 956	DOUBLE "S" OR "U" RAILS W/CLIMBER
1 EA	MIRACLE RECREATION EQUIPMENT CO.	162 - 960	TRANSFER POINTS / GROUND TO 3' DEEP
1 EA	MIRACLE RECREATION EQUIPMENT CO.	162 - 855PVC	8' PVC SUSPENSION BRIDGE
1 EA	MIRACLE RECREATION EQUIPMENT CO.	162 - 885	11' CYCLONE SLIDE W/ STEPS (5)
2 EA	MIRACLE RECREATION EQUIPMENT CO.	162 - 816	WALL ENCLOSURE
1 EA	MIRACLE RECREATION EQUIPMENT CO.	162 - 917	8' PVC WAVE RAMP
1 EA	MIRACLE RECREATION EQUIPMENT CO.	162 - 904	CLOCK PANEL
1 EA	MIRACLE RECREATION EQUIPMENT CO.	162 - 924	LETTER BALL PANEL
2 EA	MIRACLE RECREATION EQUIPMENT CO.	162 - 857	8' HANDRING BRIDGE
1 EA	MIRACLE RECREATION EQUIPMENT CO.	162 - 843	CHINNING BAR
1 EA	MIRACLE RECREATION EQUIPMENT CO.	162 - 960	TRANSFER POINTS / GROUND TO 3' DEEP
1 EA	MIRACLE RECREATION EQUIPMENT CO.	162 - 898	DOUBLE RAIL CLIMBER (3' DECK)
1 EA	MIRACLE RECREATION EQUIPMENT CO.	162 - 836PVC	SMALL PVC CARGO NET (3' DECK)
1 EA	MIRACLE RECREATION EQUIPMENT CO.	162 - 942	CURVED CLIMBER
1 EA	MIRACLE RECREATION EQUIPMENT CO.	162 - 925	NUMBER BALL PANEL
1 EA	MIRACLE RECREATION EQUIPMENT CO.	162 - 808	CLIMBING POLE (5' or 6'-6" OK)
1 EA	LANDSCAPE STRUCTURES INC.	843 - 8424	MOTORCYCLE
1 EA	LANDSCAPE STRUCTURES INC.	843 - 8421	HORSE
1 EA	LANDSCAPE STRUCTURES INC.	843 - 8423	CAR
1 EA	LANDSCAPE STRUCTURES INC.	843 - 8422	BIRD

EXERCISE EQUIPMENT

1 SET	MIRACLE RECREATION EQUIPMENT CO.	166-041	STEEL CHALLENGE GROUP
-------	----------------------------------	---------	-----------------------

SITE FURNITURE

3 EA	DURA ART STONE CO.	PB-D-F S14-AE	PRE-CAST CONCRETE BOLLARD - 30" HEIGHT (REMOVABLE WITH KEY-TYPE PADLOCK)
6 EA	DURA ART STONE CO.	PB-D-A S14-AE	PRE-CAST CONCRETE BOLLARD - 30" HEIGHT (PERMANENT)
12 EA	MIRACLE RECREATION EQUIPMENT CO.	1267-G	6 FT. METAL BENCH WITH MIRA-THERM FINISH (GREEN)
6 EA	WESTERN DRINKING FOUNTAINS	38-WC-2	DRINKING FOUNTAINS
1 EA	MIRACLE RECREATION EQUIPMENT CO.	715	BICYCLE RACK BOLTED TO PAVING PER MFG. SPECIFICATIONS
5 EA	POLIGON PARK ARCHITECTURE	8' X 8'	SUNSHELTER 'OPEN' SHELTER WITHOUT PICNIC TABLE, BENCHES AND DISPLAY BOARDS
1 EA	LARSEN SIGN CO. SPANJER	NED-400 42" X 72"	DOUBLE SIDED EXTERIOR DIRECTORY AND POST, MOUNTED, (COLOR BLACK)
5 EA	IRON MOUNTAIN FORGE CO.	200-G	INDIVIDUAL BARBECUE (BLACK)
13 EA	MIRACLE RECREATION EQUIPMENT CO.	1129-G	PVC LITTER RECEPTACLES (GREEN)
5 EA	MIRACLE RECREATION EQUIPMENT CO.	1156-2	MIRA-THERM PICNIC TABLE (GREEN)

MISCELLANEOUS SITE EQUIPMENT

1730 SF.	LANDSCAPE PRODUCTS CORP.	GRASS-CEL 13"X12.5" X1.5" POLYETHYLENE PAVING BLOCKS PAVERS
----------	--------------------------	--

LAYOUT NOTES

- INSTALL LITTER RECEPTACLES PER MANUFACTURER'S DIRECTIONS.
- INSTALL PLAY STRUCTURES PER MANUFACTURER'S DIRECTIONS. SUBMIT SHOP DRAWING TO CITY REPRESENTATIVE FOR APPROVAL BEFORE INSTALLATION. PLAY STRUCTURE POSTS, STEPS, BRIDGES & DECKS TO BE GREEN. CYCLONE SLIDE ROOF TO BE YELLOW AND BLUE, ALL OTHER EQUIPMENT TO BE YELLOW.
- INSTALL DRINKING FOUNTAIN AS DETAILED AND PER LOCAL CODES AND REGULATIONS. SUBMIT SHOP DRAWINGS TO THE CITY REPRESENTATIVE FOR APPROVAL BEFORE INSTALLATION.
- INSTALL METAL BENCHES AND BICYCLE RACK PER MANUFACTURER'S DIRECTIONS. SUBMIT SHOP DRAWINGS TO THE CITY REPRESENTATIVE FOR APPROVAL BEFORE INSTALLATION.
- CONTRACTOR SHALL STAKE OUT EQUIPMENT IN FITNESS AREA AND OBTAIN APPROVAL BY THE CITY REPRESENTATIVE PRIOR TO INSTALLATION.
- MANUFACTURER'S REPRESENTATIVES ARE AS FOLLOWS:

MIRACLE RECREATION EQUIPMENT CO. & W.H. PORTER CO. WALT RANKIN	(619) 460-4624	LARSEN SIGN CO. LAS VEGAS NV. ROB MCGUIRE	(702)-876-4765
--	----------------	---	----------------


LANDSCAPE STRUCTURES INC.
FARRELL M. SMITH & ASSOC.
TEMPE, AZ. (800)-352-1424

WESTERN DRINKING FOUNTAINS
SAN LEANDRO, CA (510) 484-9619

NO FAULT INDUSTRIES, SAF-DEK
MIKE HIGGINS (800)-232-7766

DURA ART STONE CO.
LAS VEGAS NV.
CHRIS DONOHO (702)-368-2794

POLIGON PARK ARCHITECTURE
LA MESA, CA
WALT RANKIN (619) 460-4624

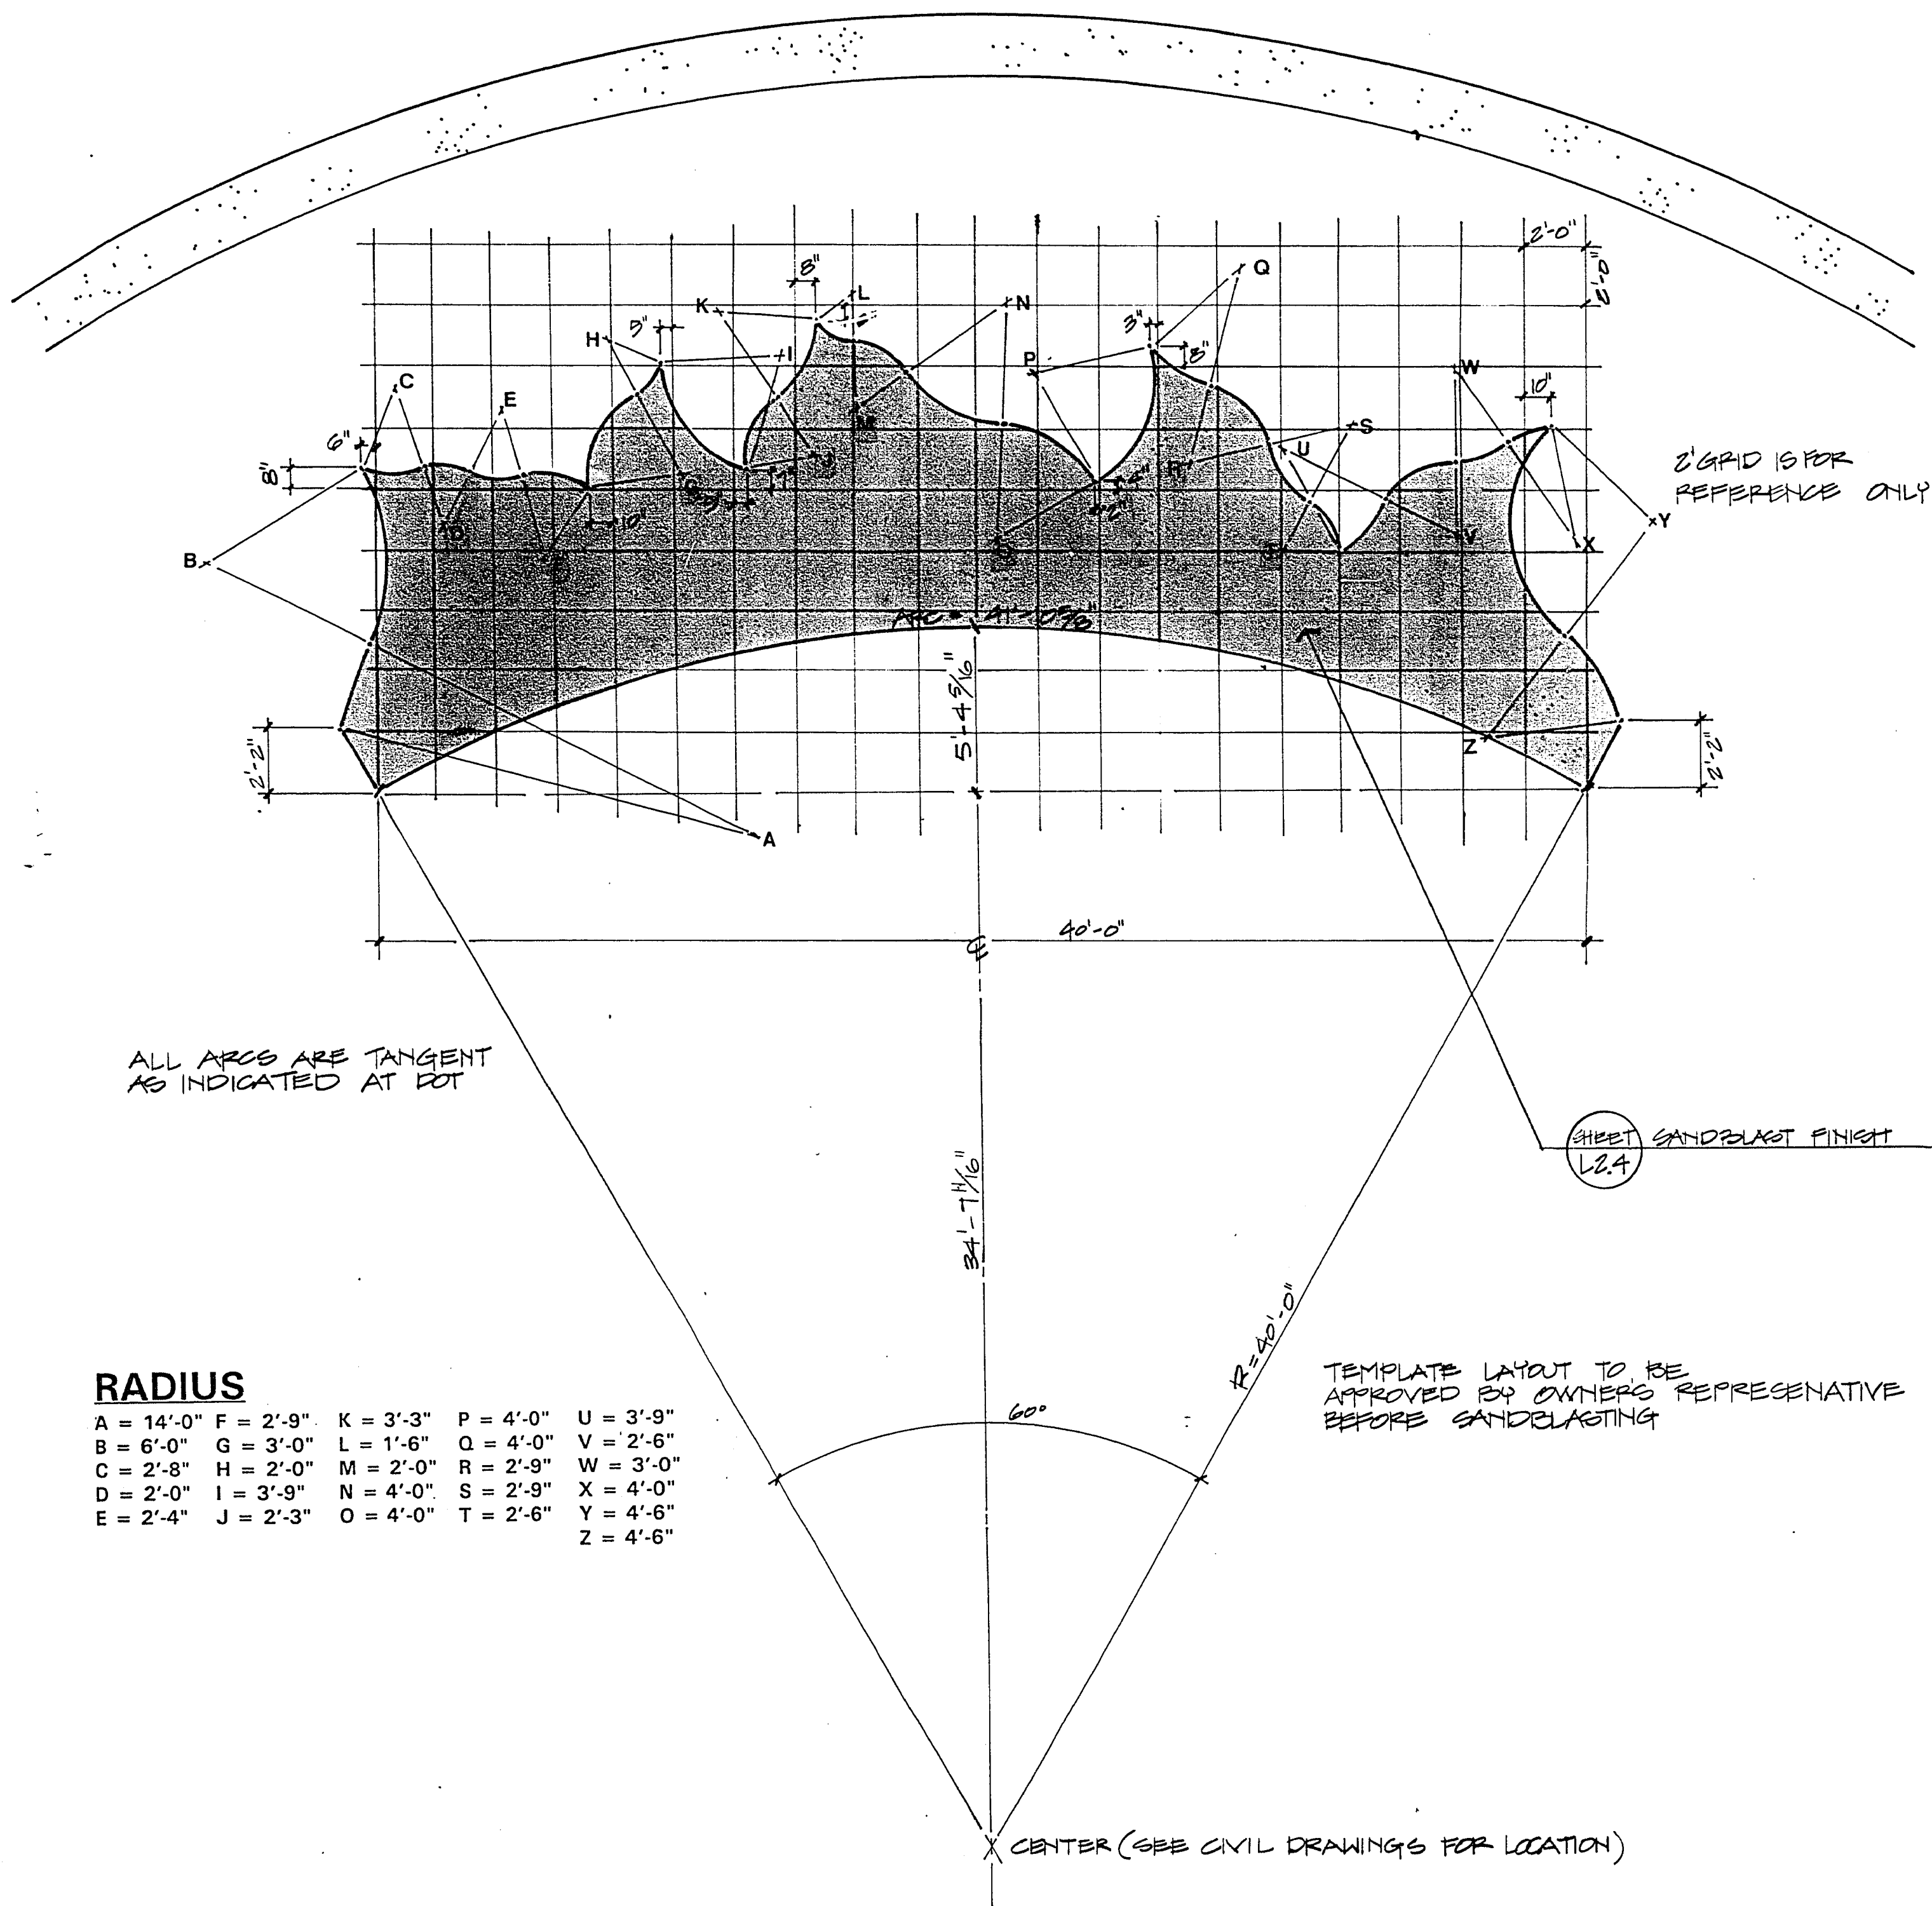


RADIUS

A = 14'-0"	F = 2'-9"	K = 3'-3"	P = 4'-0"	U = 3'-9"
B = 6'-0"	G = 3'-0"	L = 1'-6"	Q = 4'-0"	V = 2'-6"
C = 2'-8"	H = 2'-0"	M = 2'-0"	R = 2'-9"	W = 3'-0"
D = 2'-0"	I = 3'-9"	N = 4'-0"	S = 2'-9"	X = 4'-0"
E = 2'-4"	J = 2'-3"	O = 4'-0"	T = 2'-6"	Y = 4'-6"
				Z = 4'-6"

SUN RAY DETAIL (1/6 MODULE)

1/4"=1'-0"

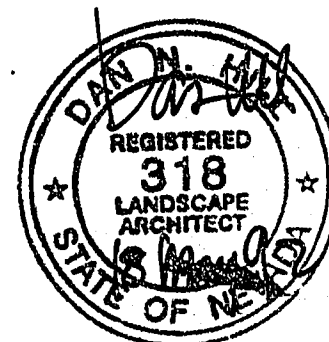

AS BUILT

TITLE

EQUIPMENT SCHEDULE

PROJECT

CHILDRENS MEMORIAL PARK

PROJECT NO. JWZ-91403
DATE: MAY 4 1992
SCALE: N.T.S.

SHEET

L17

29 OF 38 SHEETS

650.35-VI

2300 PASEO DEL PRADO SUITE D 108
LAS VEGAS, NEVADA 89102
PHONE (702) 364-1066

THE MARK GROUP
ENGINEERS & ARCHITECTS, INC.

JWZUNINO & ASSOCIATES
ARCHITECTS
LAS VEGAS, NEVADA 89102
PHONE (702) 333-9999