

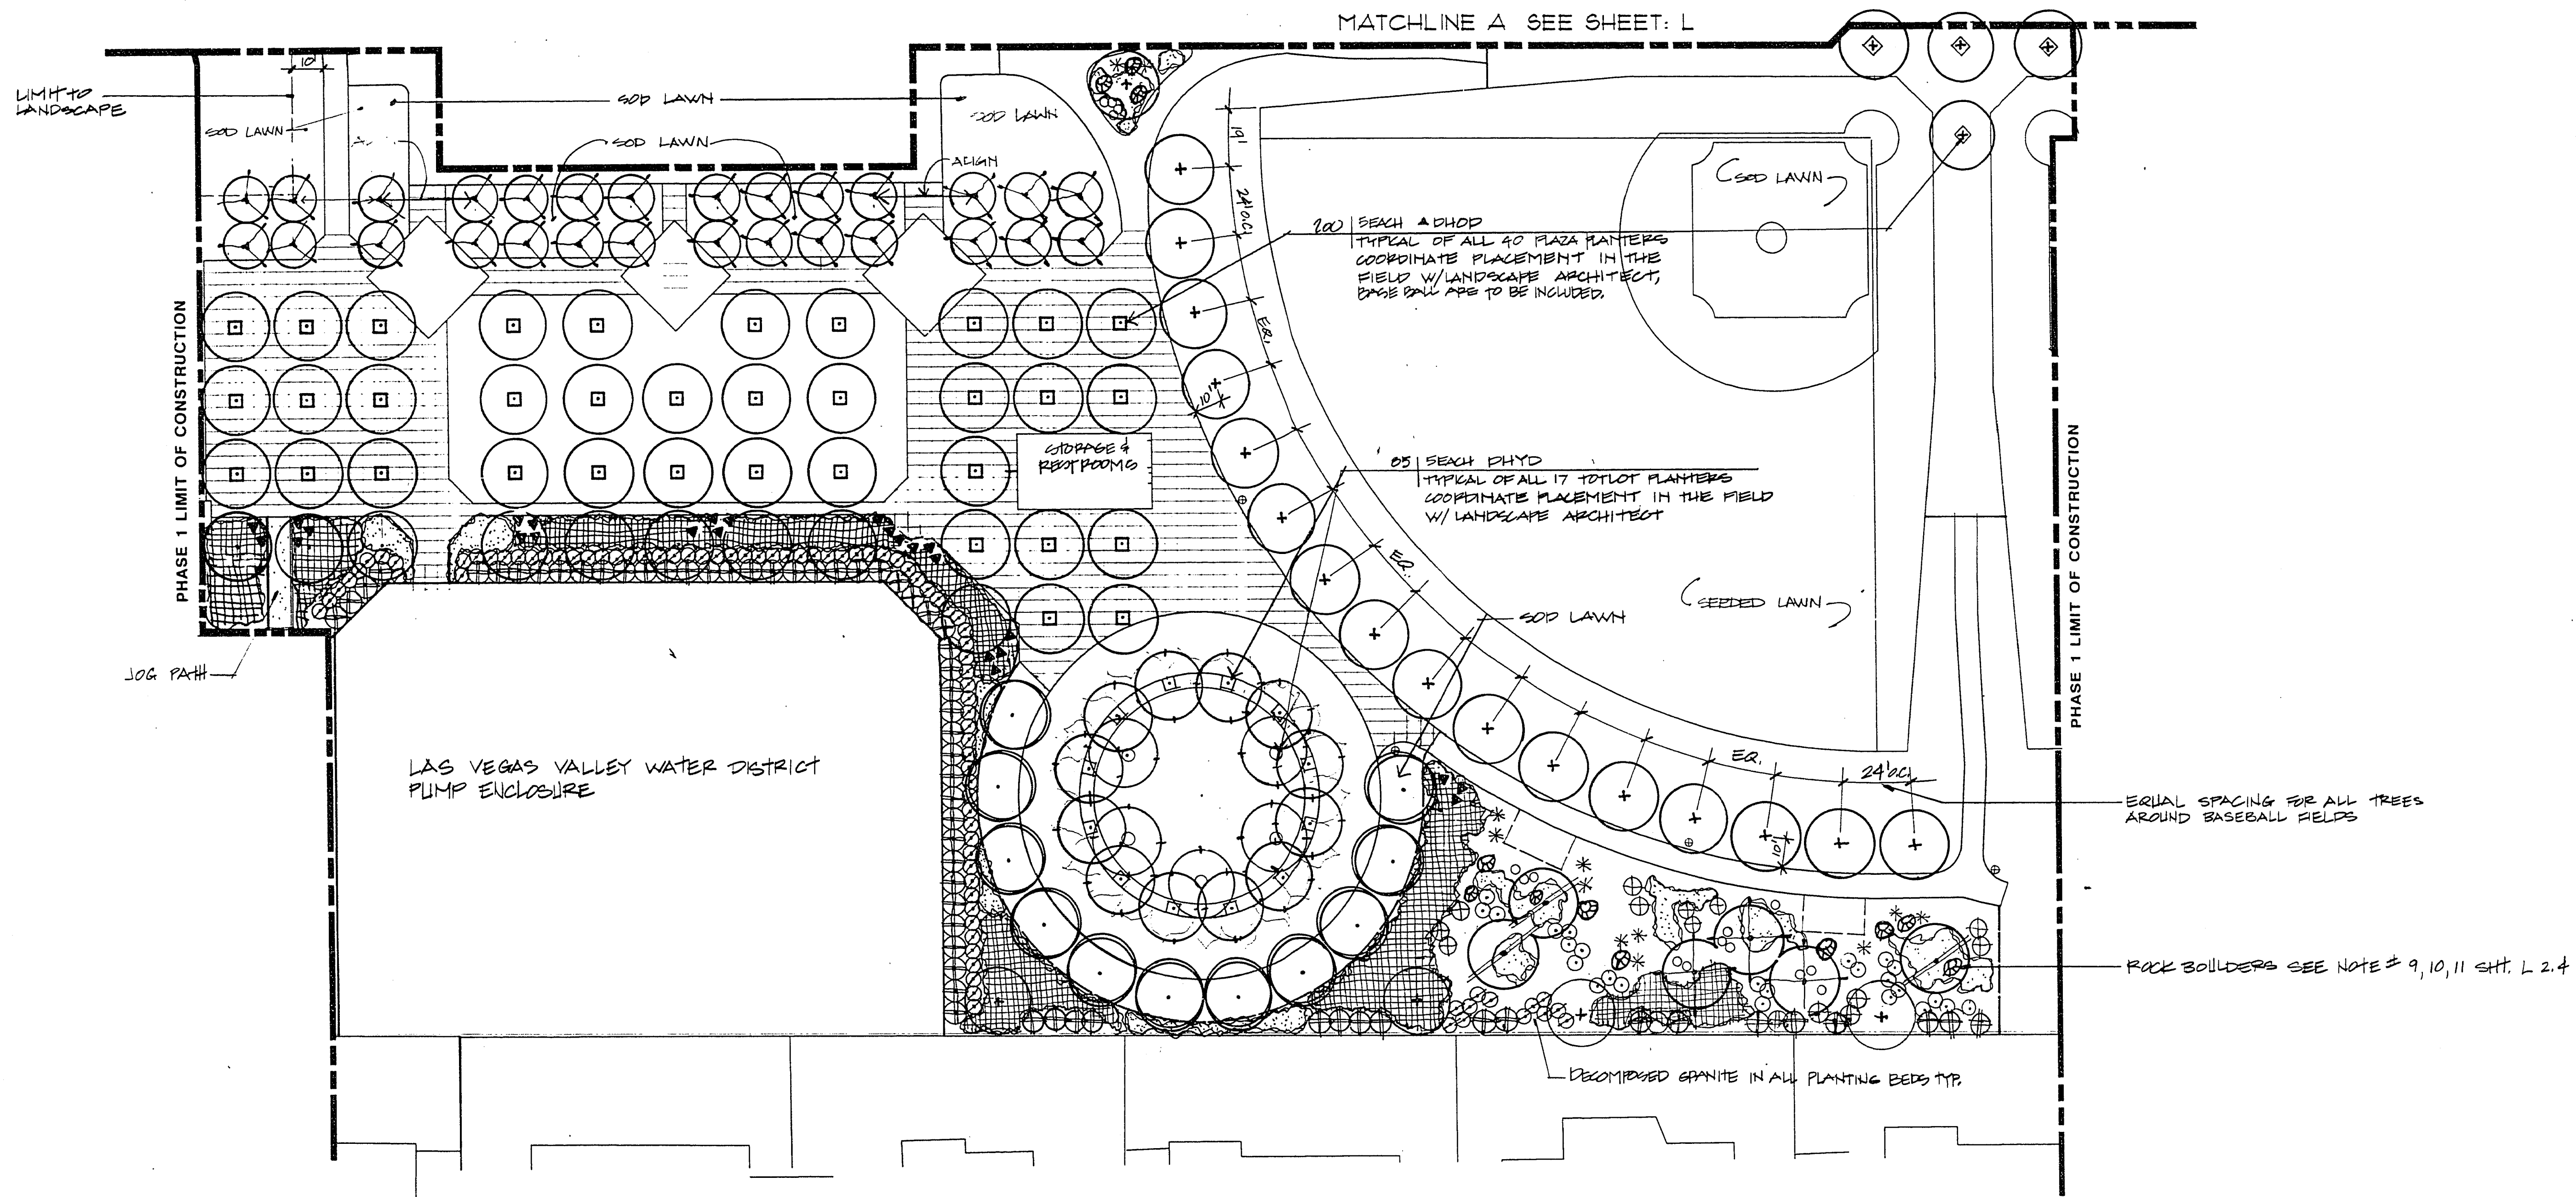


18-13-52

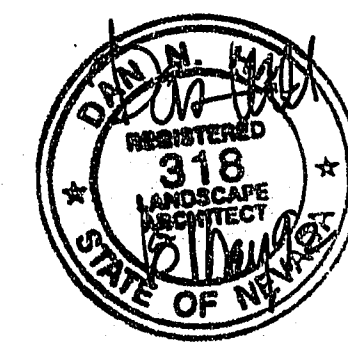

PLANTING PLAN

1"=30'-0"

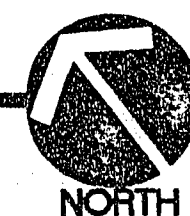

AS BUILT

PROJECT NO. JWZ-91403
DATE: MAY 4 1992
SCALE: HORIZ. 1"=30'-0"

SHEET
L2.1
30 OF 38 SHEETS

650.35-VI

PLANTING PLAN

CHILDRENS MEMORIAL PARK

DRAWN BY
DESIGNED BY
APPROVED BY

JWZUNINO ASSOCIATES
LANDSCAPE ARCHITECTURE
3000 W. SPRING MOUNTAIN ROAD, SUITE 200, LAS VEGAS, NV 89102
PHONE (702) 364-1066



2300 PASEO DEL PRADO SUITE D 108
LAS VEGAS, NEVADA 89102
PHONE (702) 364-1066