




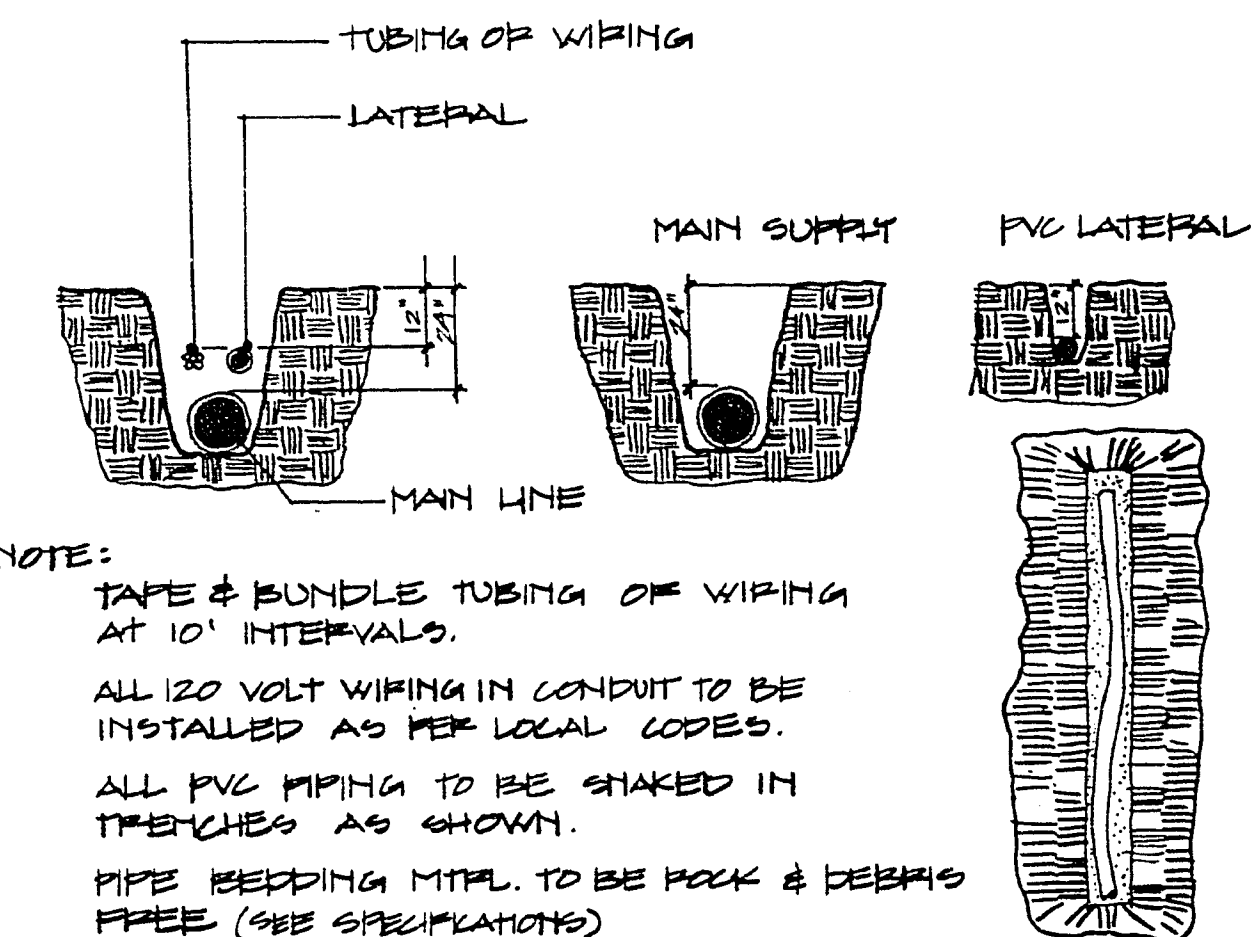



A TRENCHING DETAIL

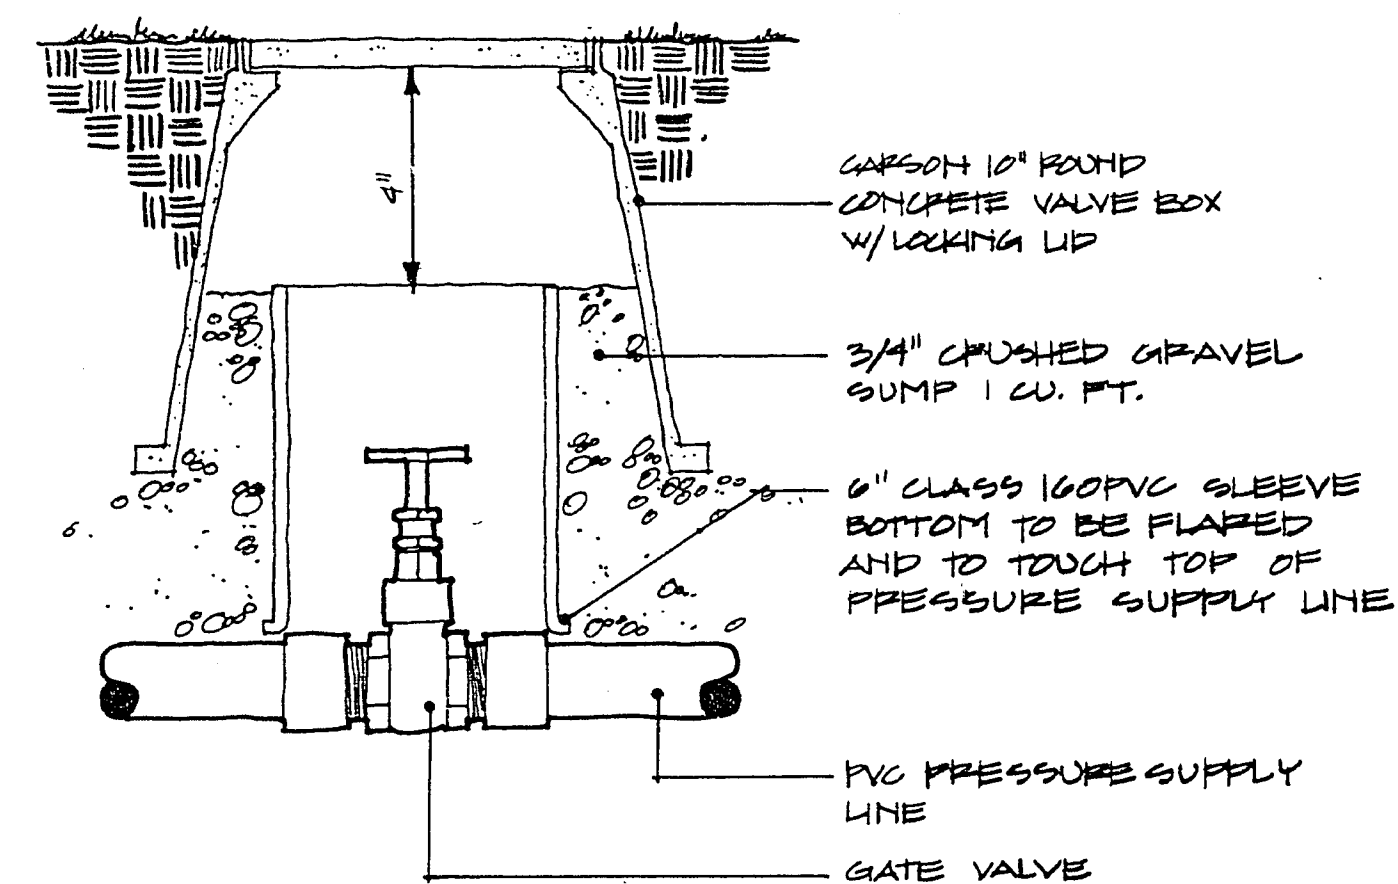


B GATE VALVE 2.5" & SMALLER

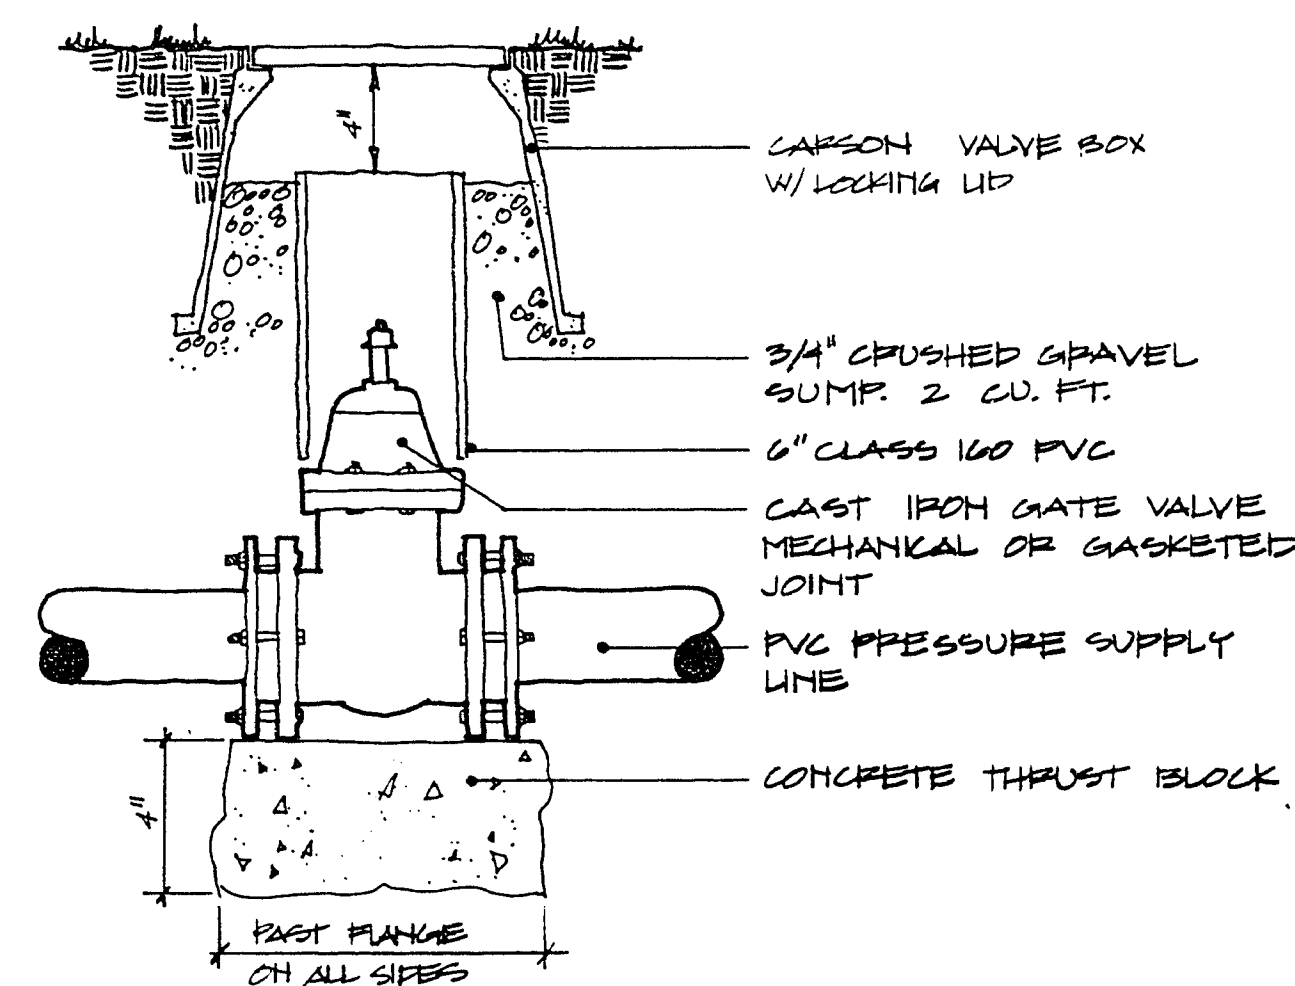


C GATE VALVE 3" & LARGER

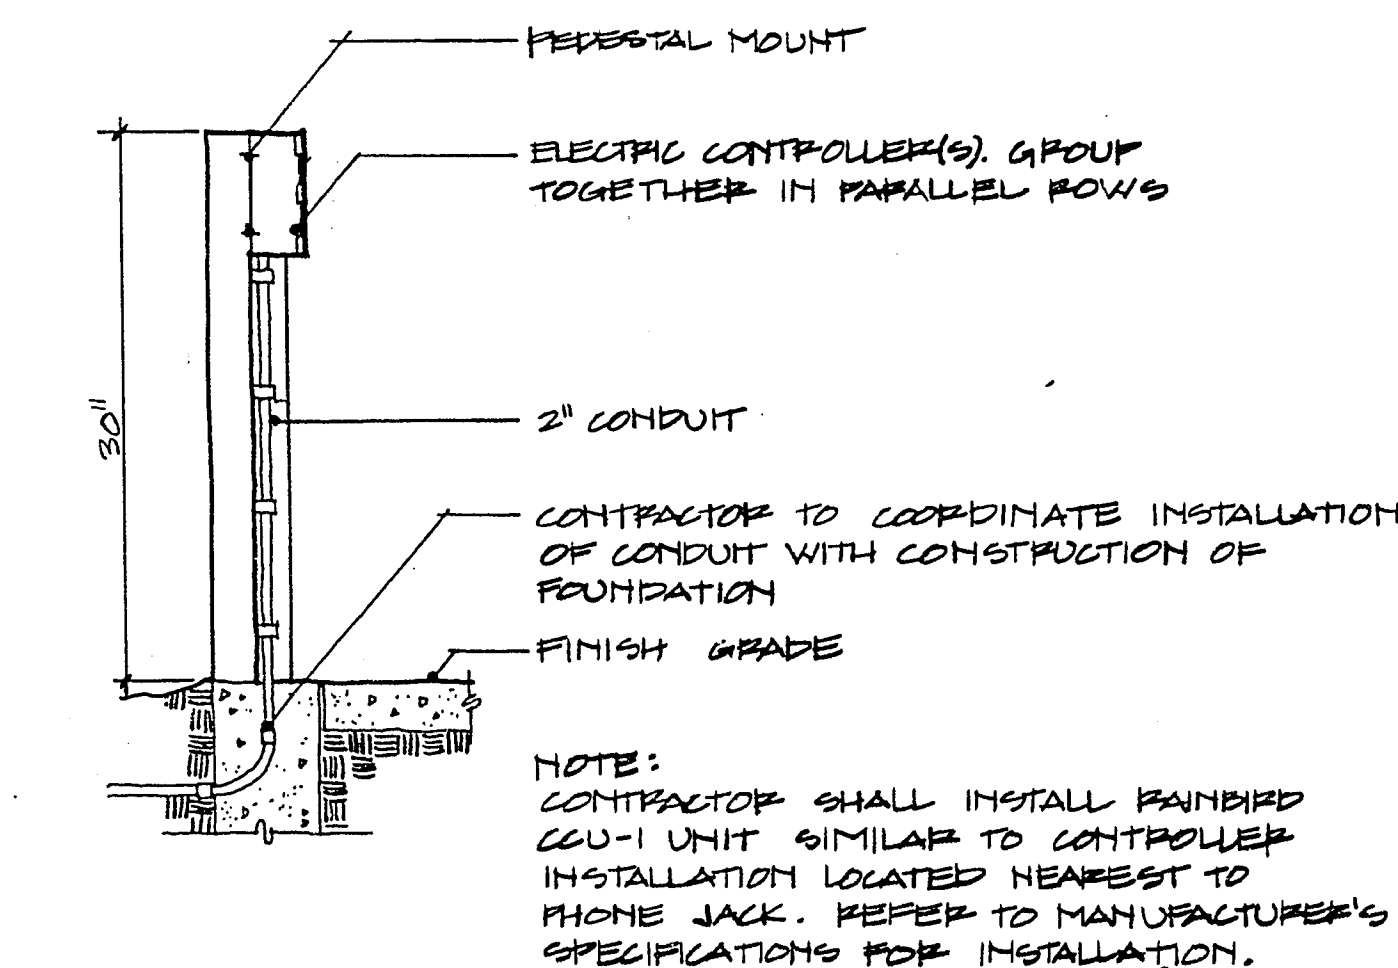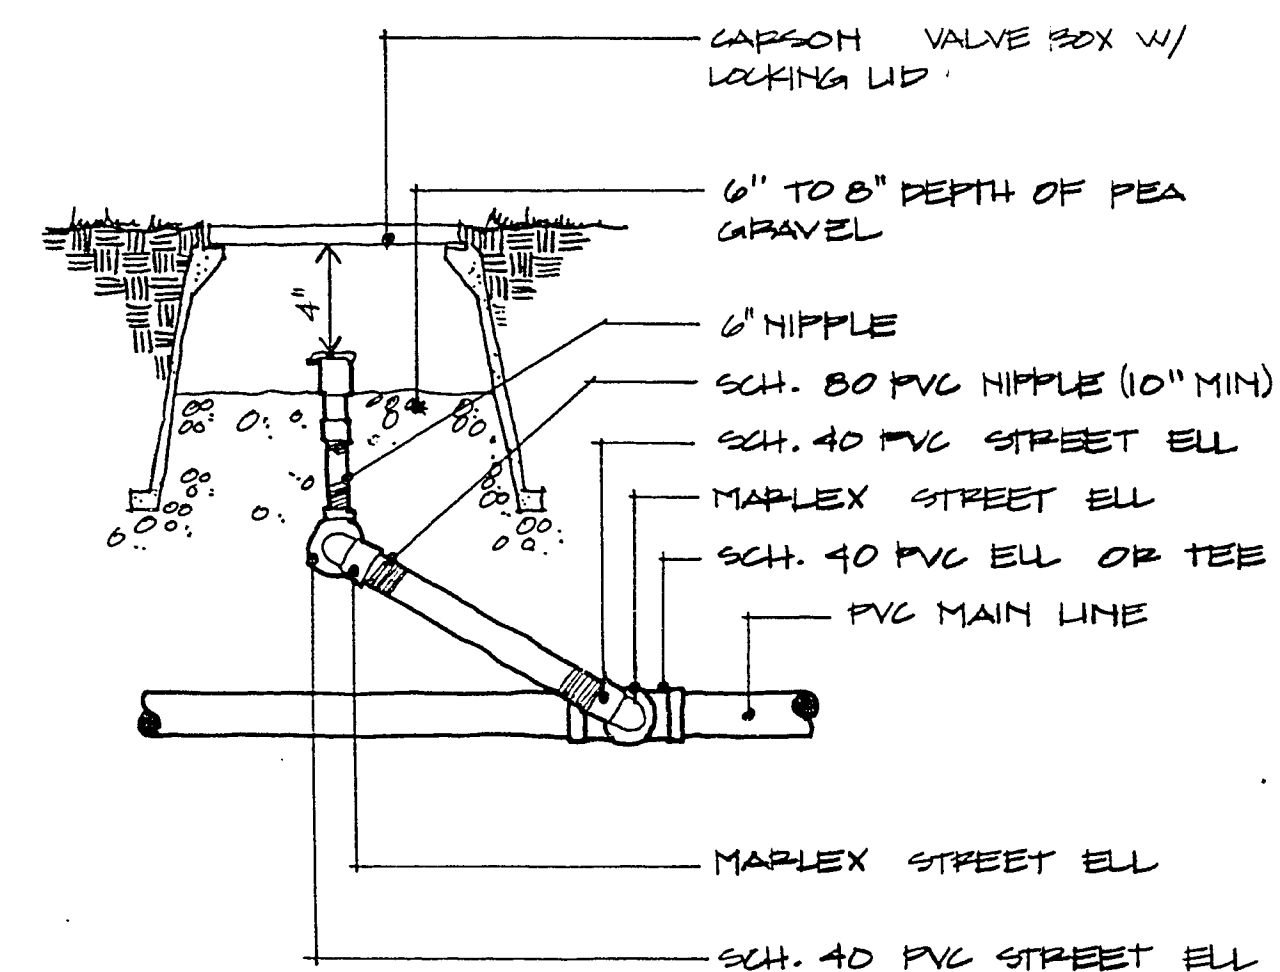


E Pedestal Mount CONTROLLER

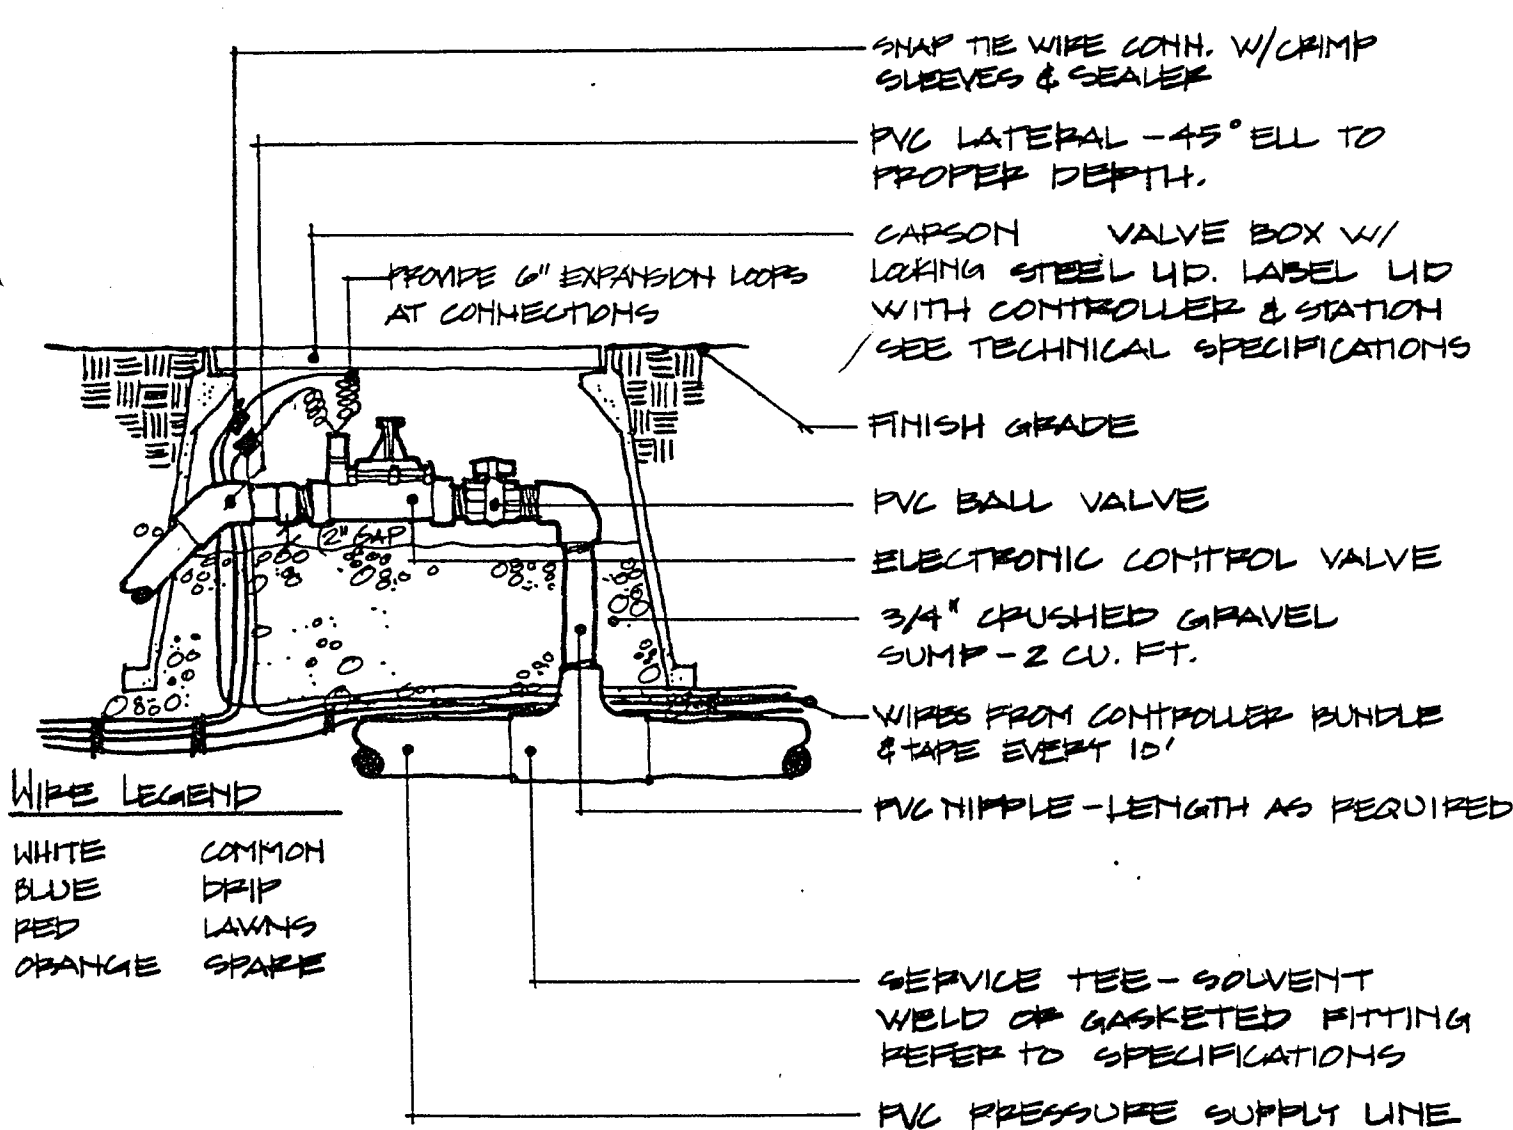


F SOLENOID VALVE DETAIL

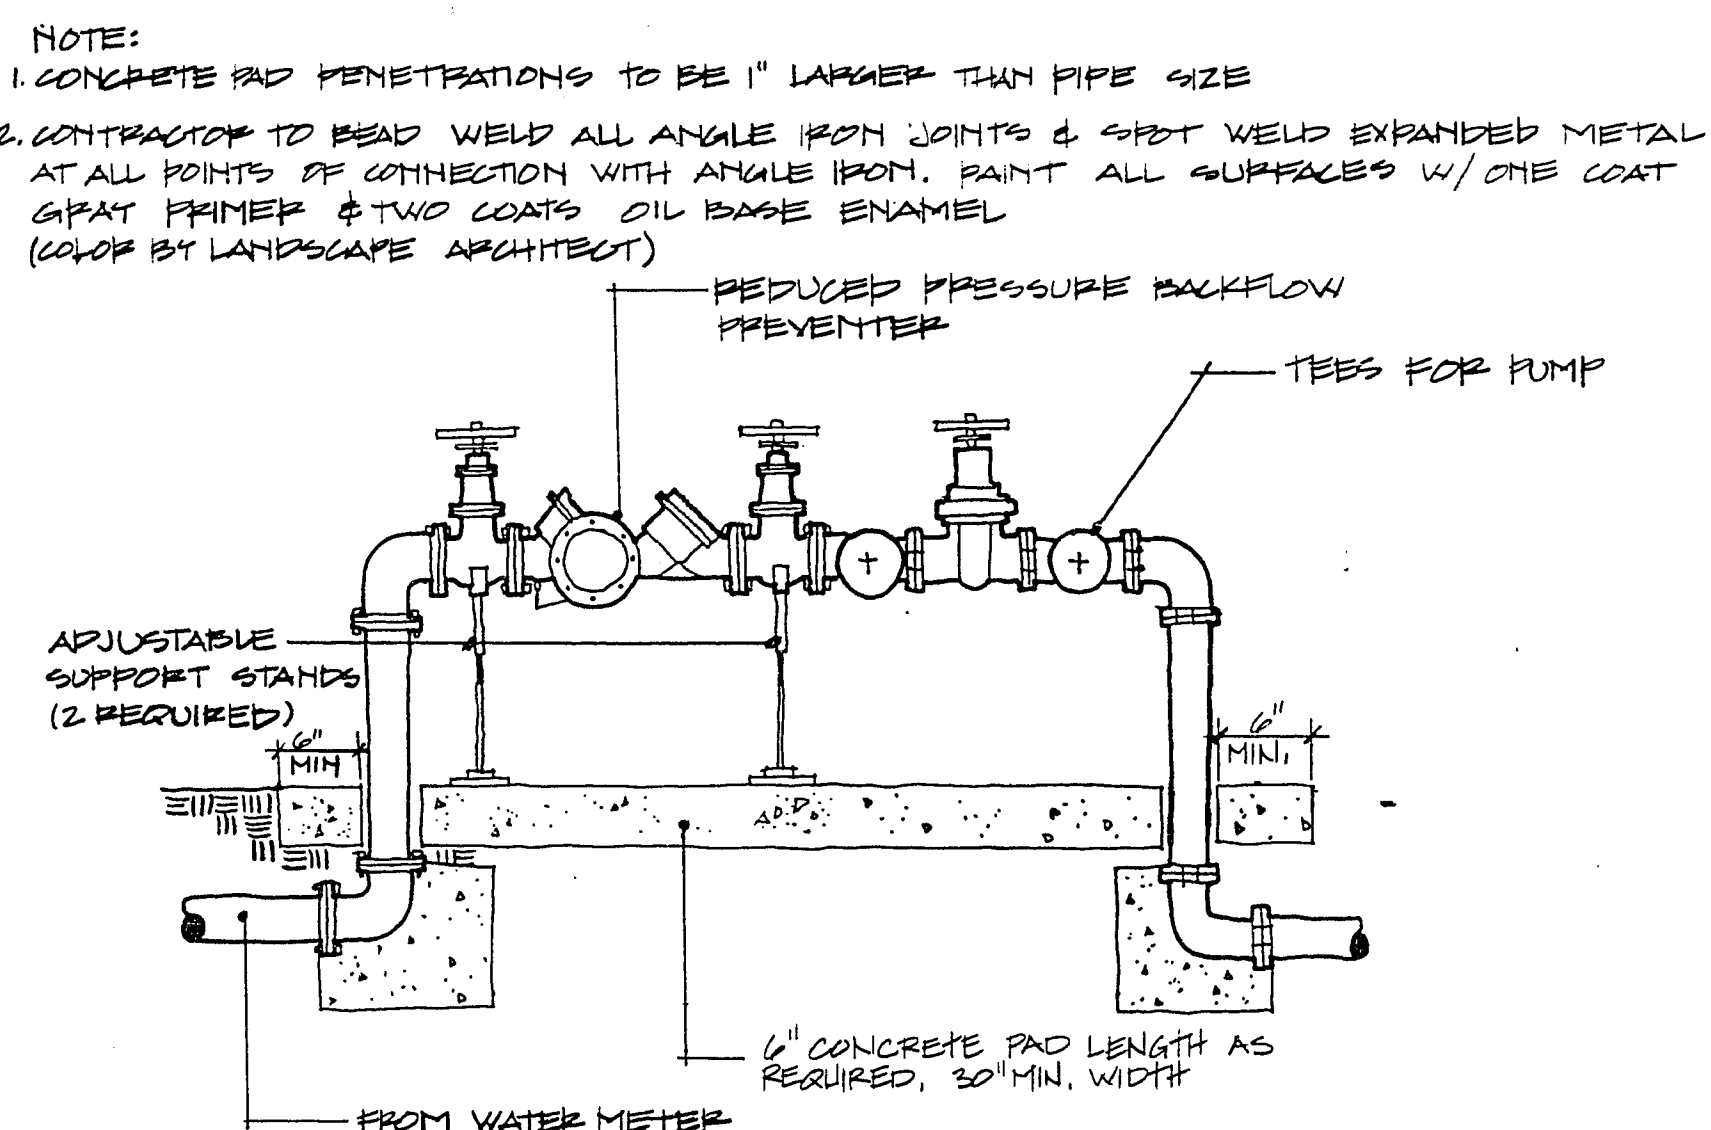

G REDUCED PRESSURE BACKFLOW PREVENTER

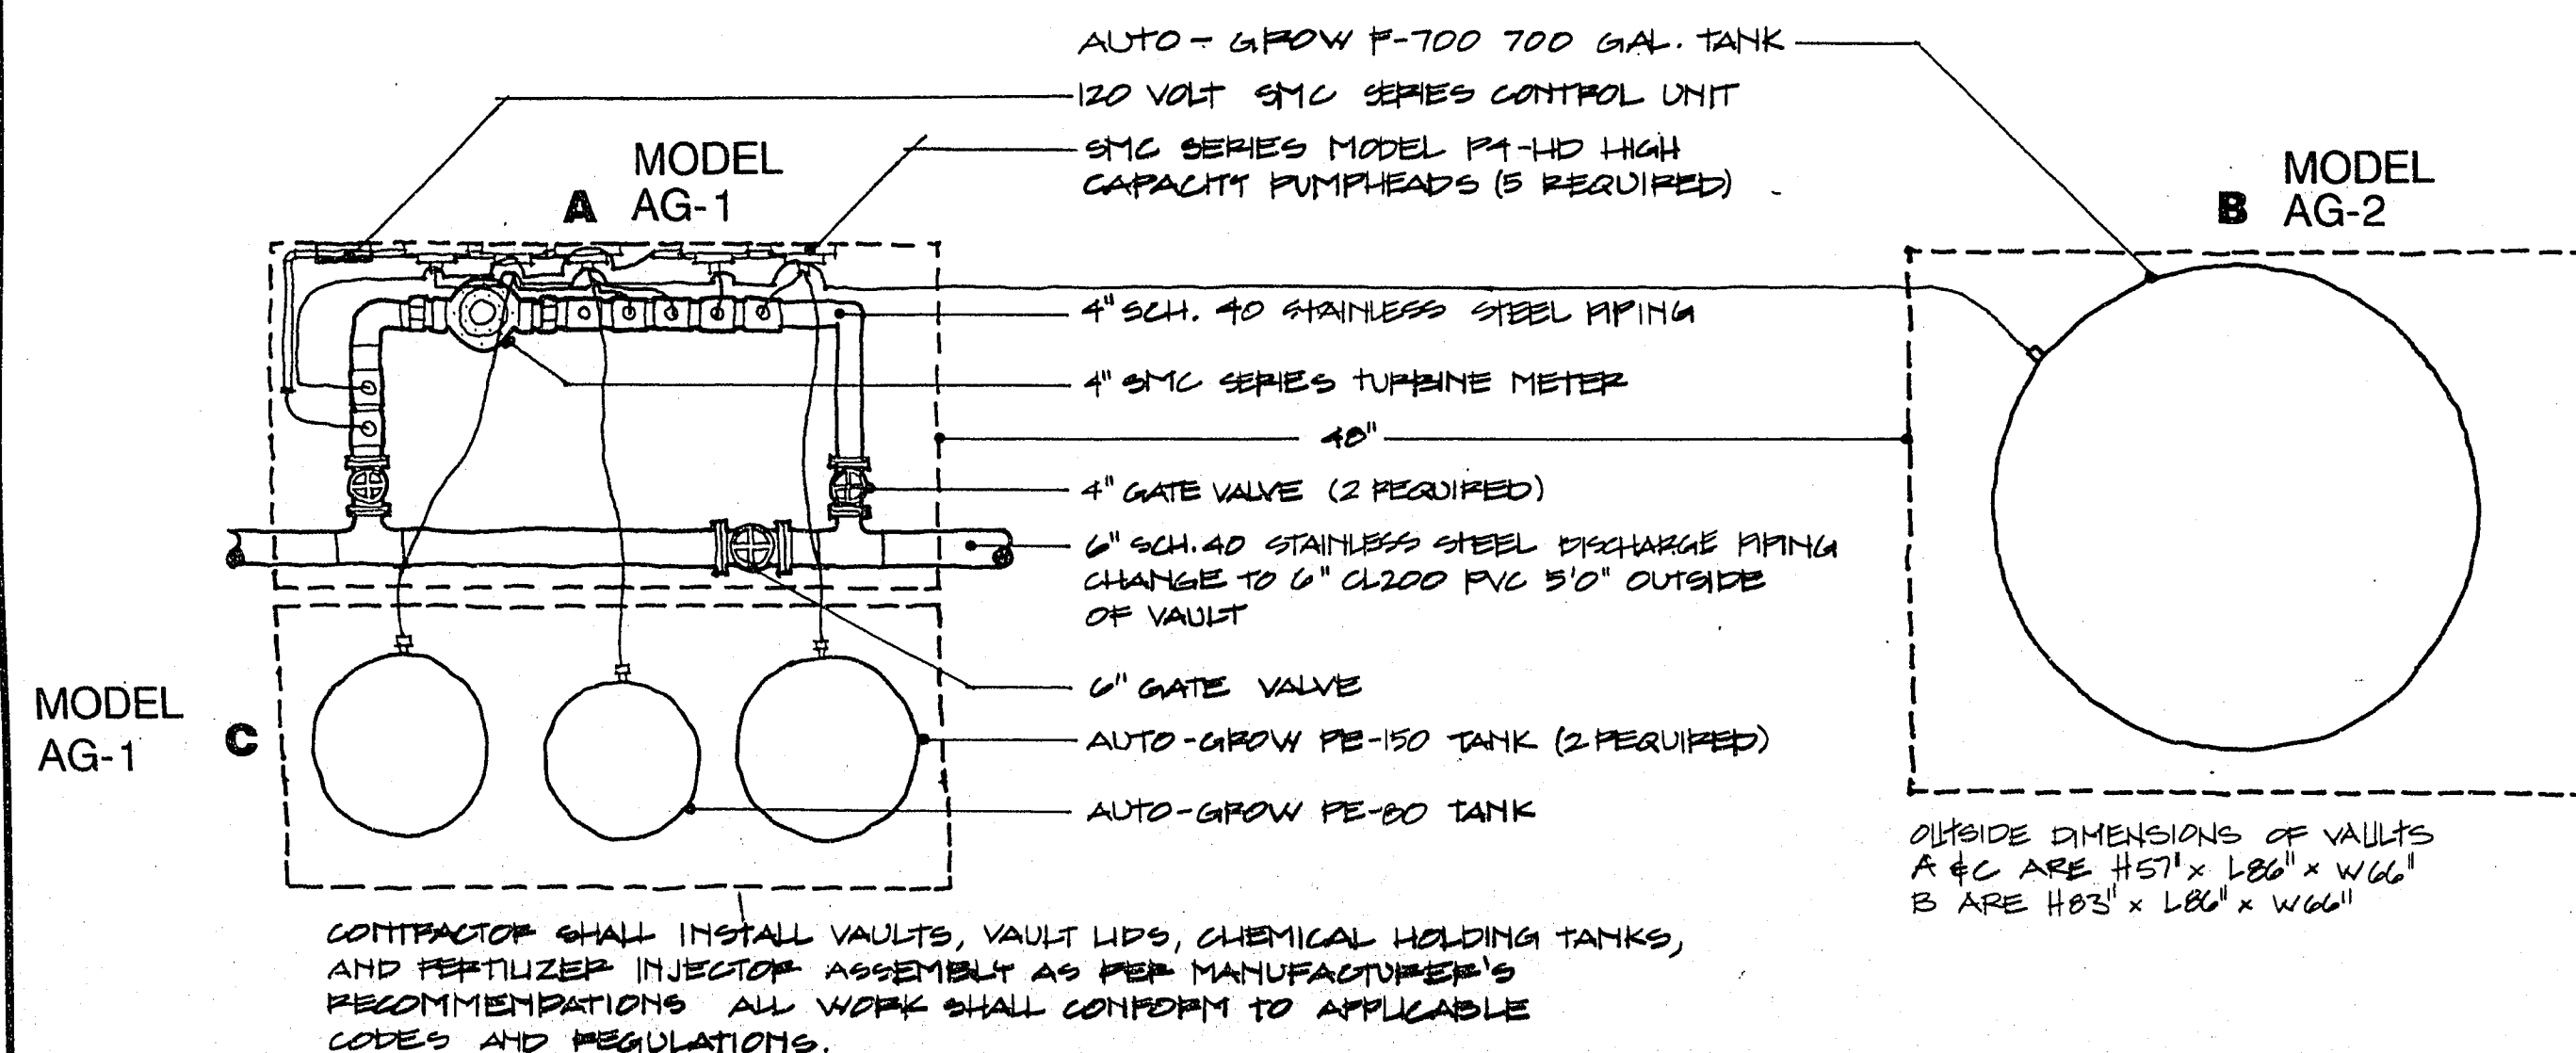

H FERTILIZER INJECTION SYSTEM

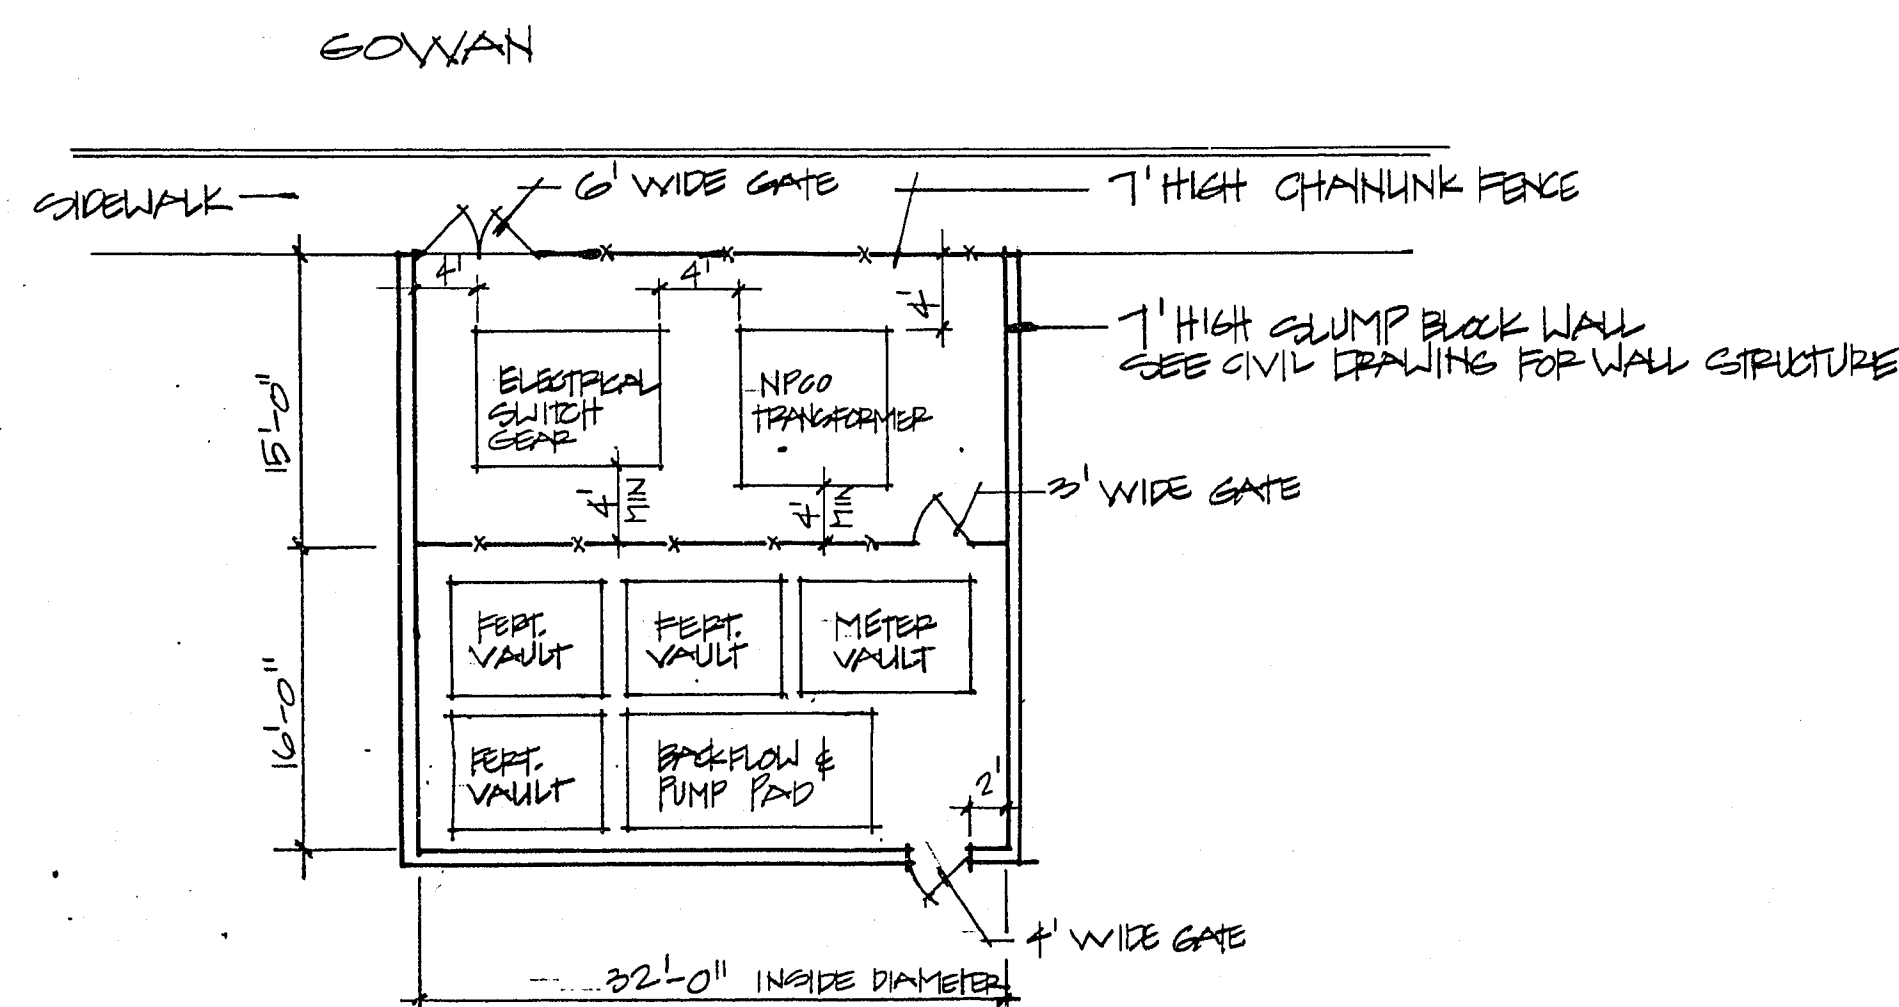

J BLOCK WALL ENCLOSURE



AS BUILT

REV.	DATE	BY	REVISION

DRAWN BY	DESIGNED BY	APPROVED BY

TITLE
IRRIGATION DETAILS

PROJECT NO. JWZ-91403
DATE: MAY 4 1992
SCALE: N.T.S.

SHEET
L3.3
36 OF 38 SHEETS
650.35-VI

2300 PASEO DEL PRADO SUITE D 108
LAS VEGAS, NEVADA 89102
PHONE (702) 364-1066

THE MARK GROUP
ARCHITECTS & ENGINEERS, INC.

JWZUNINO ASSOCIATES
LANDSCAPE ARCHITECTURE • LAND PLANNING
3075 W. SPRING MOUNTAIN ROAD, SUITE 200, LAS VEGAS, NV 89102
PHONE 702-335-7222 FAX 702-335-7222

CHILDRENS MEMORIAL PARK