



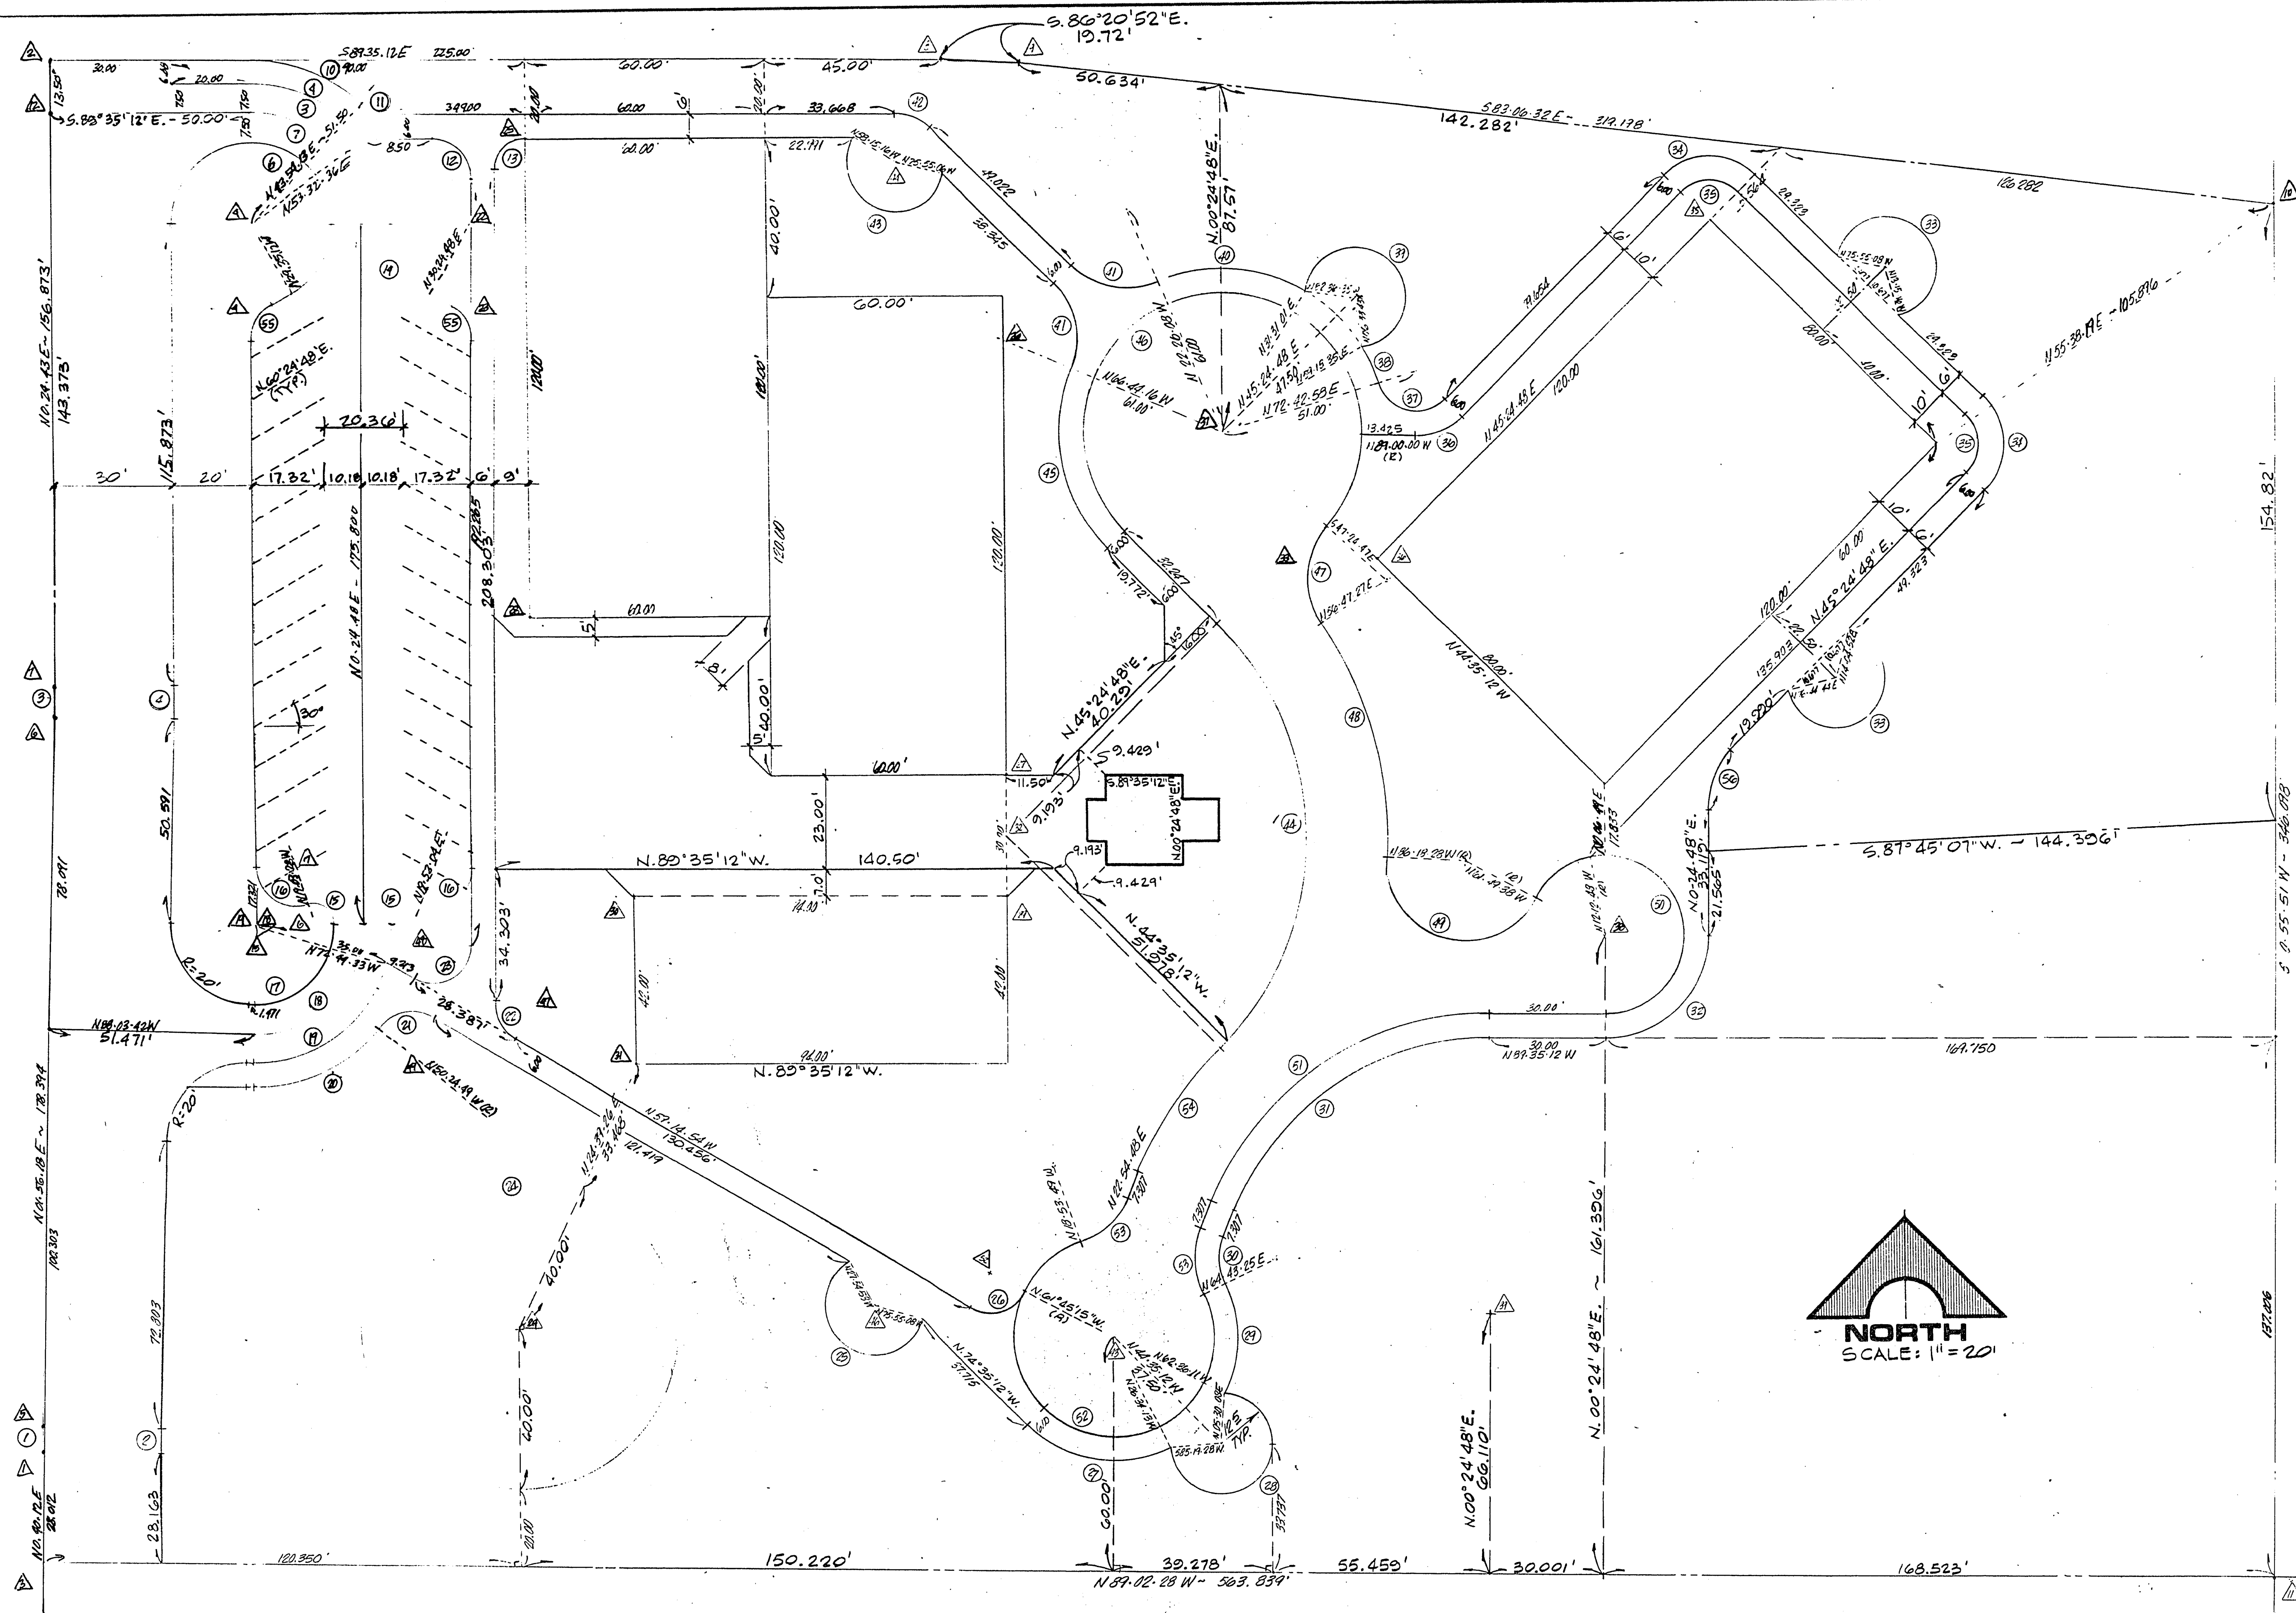

SUEVE DATA				
#	J	R	L	T
1	1.10.76	200.00	2.241	3.521
2	1.12.76	270.00	5.777	2.897
3	1.21.80	200.00	7.785	5.773
4	1.21.80	330.00	5.785	4.372
5	1.10.76	20.00	73.307	
6	1.10.76	21.50	43.777	27.50
7	1.10.76	35.00	54.778	35.00
8	1.10.76	35.00	32.455	17.50
9	1.24.25	41.77	31.151	14.553
10	1.24.25	19.77	7.570	3.787
11	1.10.76	10.77	15.708	10.000
12	1.10.76	9.00	14.137	9.000
13	1.10.76	25.77	5.777	5.777
14	1.10.76	5.77	1.553	1.671
15	1.10.76	10.77	11.106	14.142
16	1.10.76	20.00	31.451	20.542
17	1.10.76	27.50	42.192	28.215
18	1.10.76	35.00	55.714	35.143
19	1.10.76	41.00	57.462	29.153
20	1.10.76	10.00	14.166	8.566
21	1.10.76	10.00	10.413	5.784
22	1.10.76	10.00	21.003	17.151
23	1.10.76	40.00	251.321	
24	1.10.76	12.50	45.422	
25	1.10.76	10.00	16.147	10.449
26	1.10.76	31.00	28.947	22.516
27	1.10.76	12.50	28.684	
28	1.10.76	31.00	25.477	15.341
29	1.10.76	14.00	9.54	4.97
30	1.10.76	29.00	91.127	53.539
31	1.10.76	26.00	40.394	26.00
32	1.10.76	13.50	13.671	7.670
33	1.10.76	16.00	25.133	16.00
34	1.10.76	11.00	15.715	10.000
35	1.10.76	12.750	12.750	1.724
36	1.10.76	10.00	20.473	16.416
37	1.10.76	41.00	9.573	4.519
38	1.10.76	55.861		
39	1.10.76	38.605		20.867
40	1.10.76	23.664		13.452
41	1.10.76	9.819		5.773
42	1.10.76	43.124		
43	1.10.76	115.002		73.518
44	1.10.76	43.552		27.576
45	1.10.76	163.275		
46	1.10.76	20.00	25.975	15.184
47	1.10.76	68.000		35.600
48	1.10.76	61.418		565.804
49	1.10.76	89.427		
50	1.10.76	99.051		58.249
51	1.10.76	116.698		
52	1.10.76	16.010		8.461
53	1.10.76	50.520		25.812
54	1.10.76	10.47		5.77
55	1.10.76	15.708		8.284

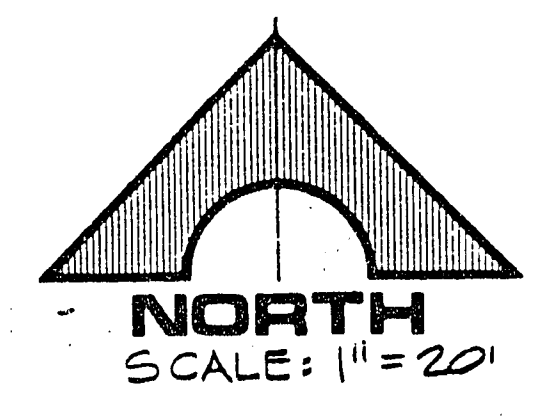

BECKER DEVELOPMENT CO.
CHARLESTON HEIGHTS PARK
CONTROL PLAN

G. C. WALLACE
Consulting Engineers, Inc.
1100 East Sahara Ave. • Las Vegas, Nevada 89104 • 732-3330

RECOMMENDED	REV	DATE	DESCRIPTION
G. C. WALLACE			
R. E. NO.			
DATE			

SHEET
3
OF 3 SHEETS

"As-Built" 650.28-1