


14-12-61

BOOK ~~382~~
BOOK 406

AMENDED PLAT OF LEWIS HOMES - CHARLESTON UNIT NO. 5

NO. ~~341394~~
NO. 365891

BEING A SUBDIVISION WITHIN A PORTION OF
THE N.W. 1/4 OF SEC. 35, T.20S., R.60E., M.D.M.
CITY OF LAS VEGAS, CLARK COUNTY, NEVADA

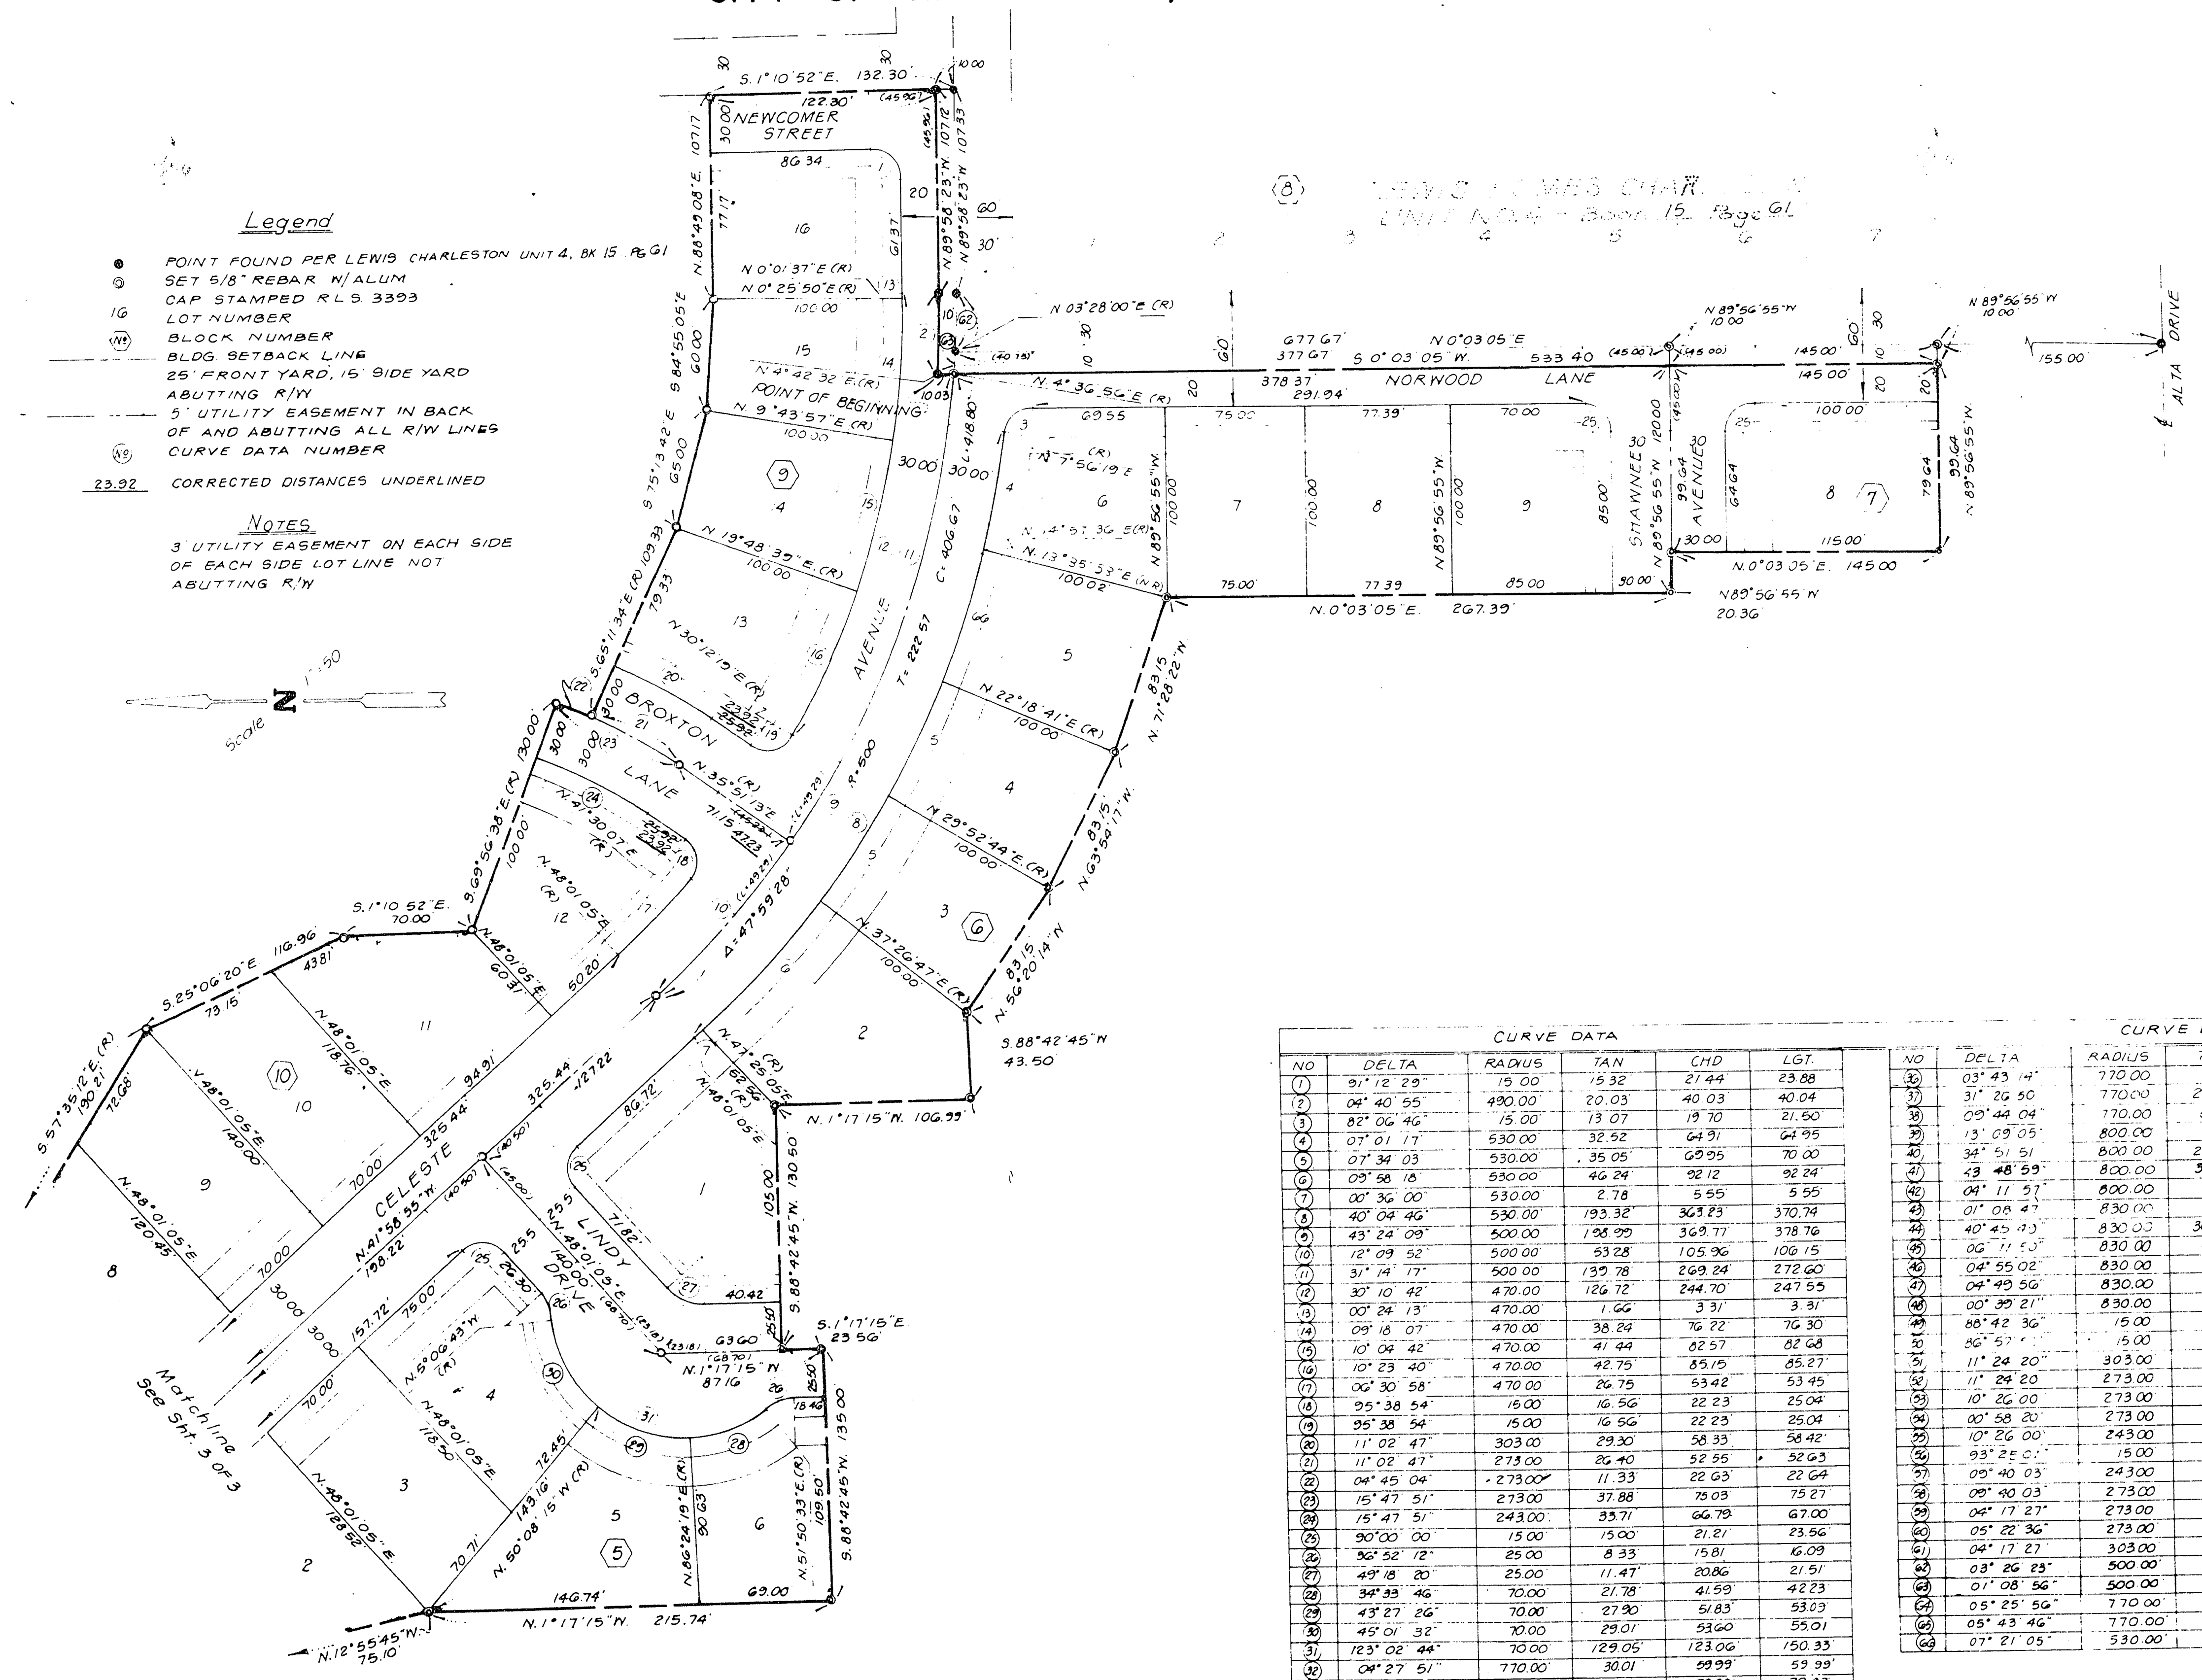

CURVE DATA				
NO	DELTA	RADIUS	TAN	CHD
1	91° 12' 29"	15.00	15.32	21.44
2	04° 40' 55"	490.00	20.03	40.03
3	82° 06' 46"	15.00	13.07	19.70
4	07° 01' 17"	530.00	32.52	64.91
5	07° 34' 03"	530.00	35.05	69.95
6	09° 58' 18"	530.00	46.24	92.12
7	00° 36' 00"	530.00	2.78	5.55
8	40° 04' 46"	530.00	193.32	363.23
9	43° 24' 09"	500.00	198.95	369.77
10	12° 09' 52"	500.00	53.28	105.96
11	31° 14' 17"	500.00	139.78	269.24
12	30° 10' 42"	470.00	126.12	244.70
13	00° 24' 13"	470.00	1.66	3.31
14	09° 18' 07"	470.00	38.24	76.22
15	10° 04' 42"	470.00	41.44	82.57
16	10° 23' 40"	470.00	42.75	85.15
17	06° 30' 58"	470.00	26.75	53.42
18	25° 38' 54"	15.00	16.56	22.23
19	25° 38' 54"	15.00	16.56	22.23
20	11° 02' 47"	303.00	29.30	58.33
21	11° 02' 47"	273.00	26.40	52.55
22	04° 45' 04"	273.00	11.33	22.63
23	15° 47' 51"	273.00	37.88	75.03
24	15° 47' 51"	243.00	35.71	66.79
25	30° 00' 00"	15.00	75.00	21.81
26	36° 52' 12"	25.00	8.33	15.81
27	49° 18' 20"	25.00	11.47	20.86
28	34° 33' 46"	70.00	21.78	41.59
29	43° 27' 26"	70.00	27.90	51.83
30	45° 01' 32"	70.00	29.01	53.60
31	123° 02' 44"	70.00	129.05	123.06
32	04° 27' 51"	770.00	30.01	99.99
33	05° 16' 13"	770.00	35.44	70.83
34	05° 24' 12"	770.00	36.33	72.59
35	05° 34' 51"	770.00	37.53	74.97

CURVE DATA				
NO	DELTA	RADIUS	TAN	CHD
36	03° 43' 14"	770.00	25.01	49.99
37	31° 26' 50"	770.00	216.78	417.34
38	09° 44' 04"	770.00	45.57	130.66
39	13° 09' 05"	800.00	92.22	183.23
40	34° 51' 51"	800.00	251.20	479.32
41	43° 48' 59"	800.00	321.73	596.99
42	04° 11' 51"	800.00	29.33	58.62
43	01° 08' 47"	830.00	8.30	16.61
44	40° 45' 13"	830.00	308.31	578.14
45	06° 11' 53"	830.00	44.93	89.73
46	04° 55' 02"	830.00	35.64	71.20
47	04° 49' 56"	830.00	35.02	69.98
48	00° 39' 21"	830.00	4.75	9.50
49	88° 42' 36"	15.00	14.67	20.37
50	26° 57' 11"	15.00	14.21	20.64
51	11° 24' 20"	303.00	30.26	60.22
52	11° 24' 20"	273.00	27.26	54.25
53	10° 26' 00"	273.00	24.93	49.64
54	00° 58' 20"	273.00	2.32	4.63
55	10° 26' 00"	243.00	22.19	44.19
56	03° 25' 01"	15.00	15.02	21.84
57	09° 40' 03"	243.00	20.55	40.95
58	09° 40' 03"	273.00	23.09	46.01
59	04° 17' 27"	273.00	10.23	20.44
60	05° 22' 36"	273.00	12.82	25.61
61	04° 17' 27"	303.00	11.35	22.69
62	03° 26' 25"	500.00	15.01	30.01
63	01° 08' 56"	500.00	5.01	10.03
64	05° 25' 56"	770.00	36.55	72.98
65	05° 43' 46"	770.00	38.55	76.97
66	07° 21' 05"	530.00	34.05	67.96

2026-5

