



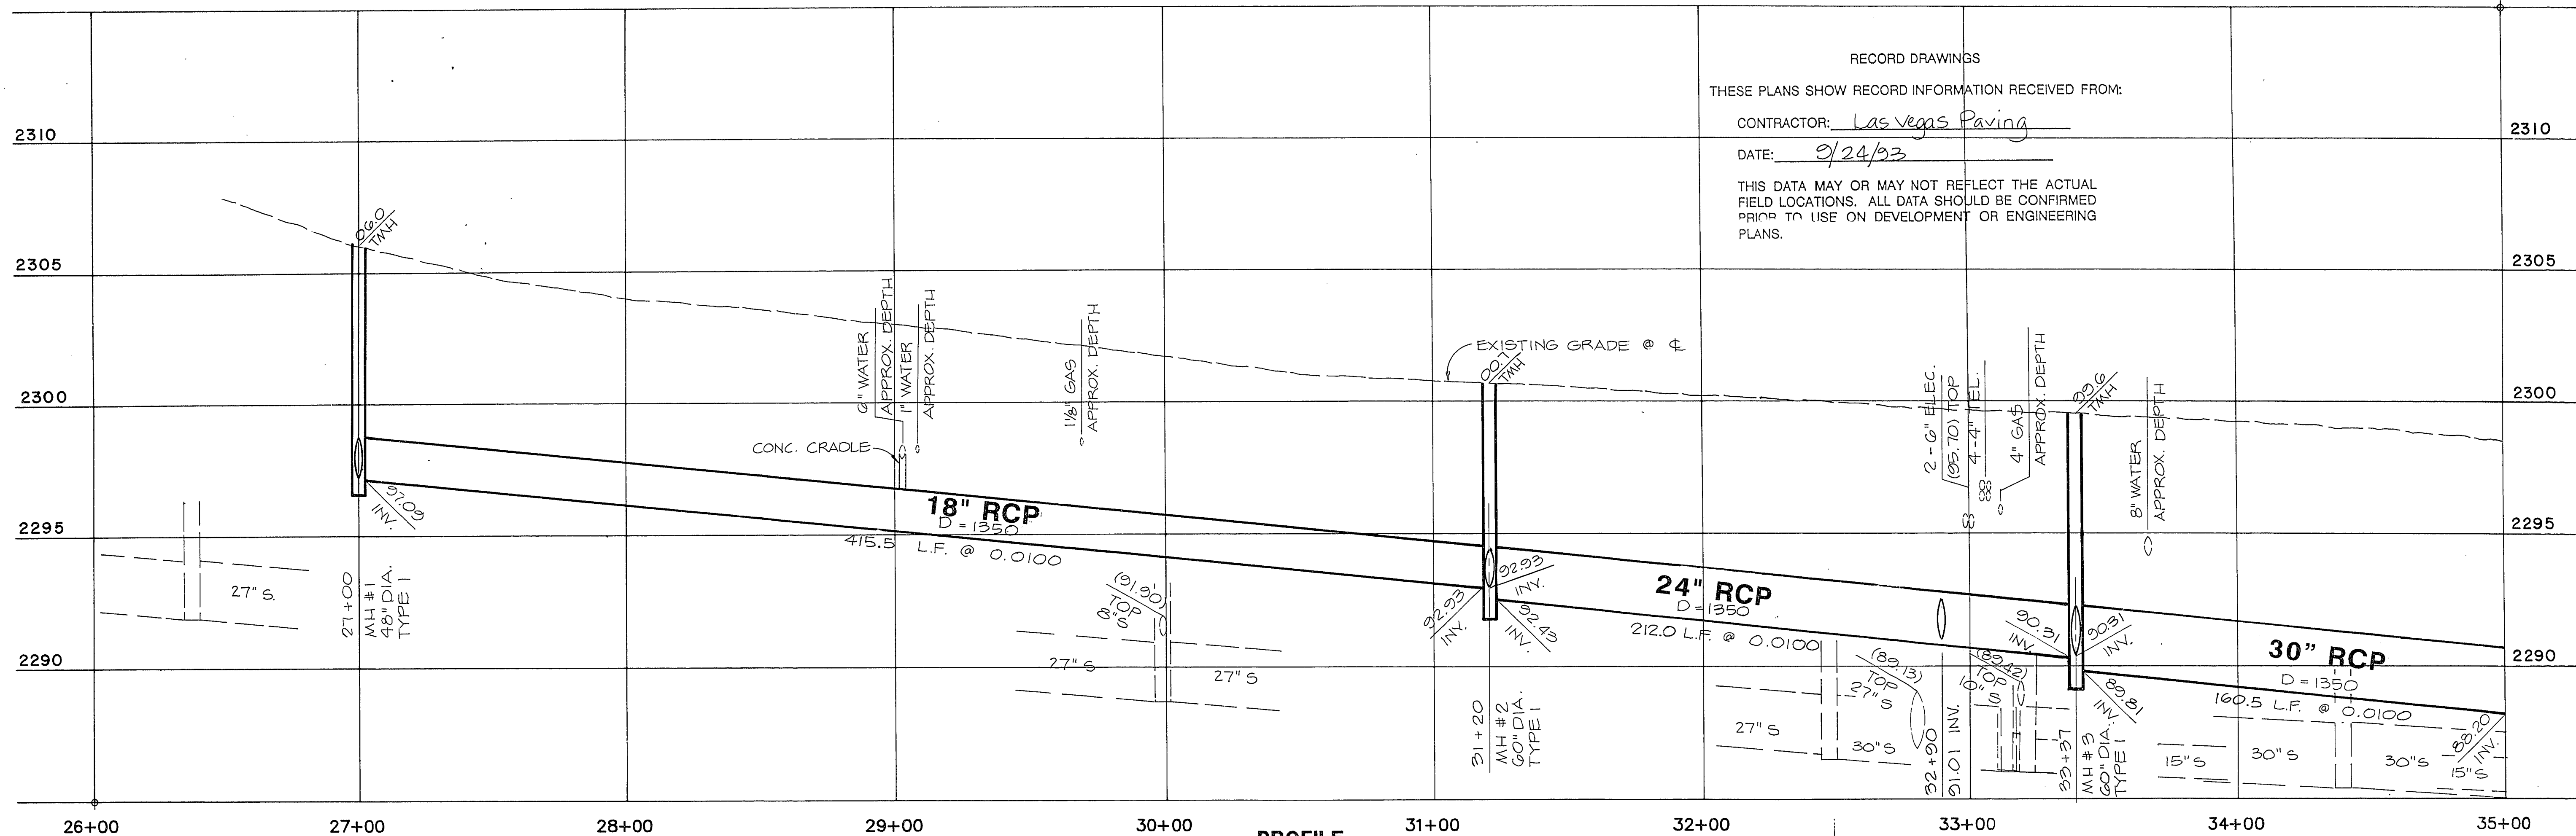

PROFILE

SCALE: HORIZ. 1" = 30'
VERT. 1" = 3'

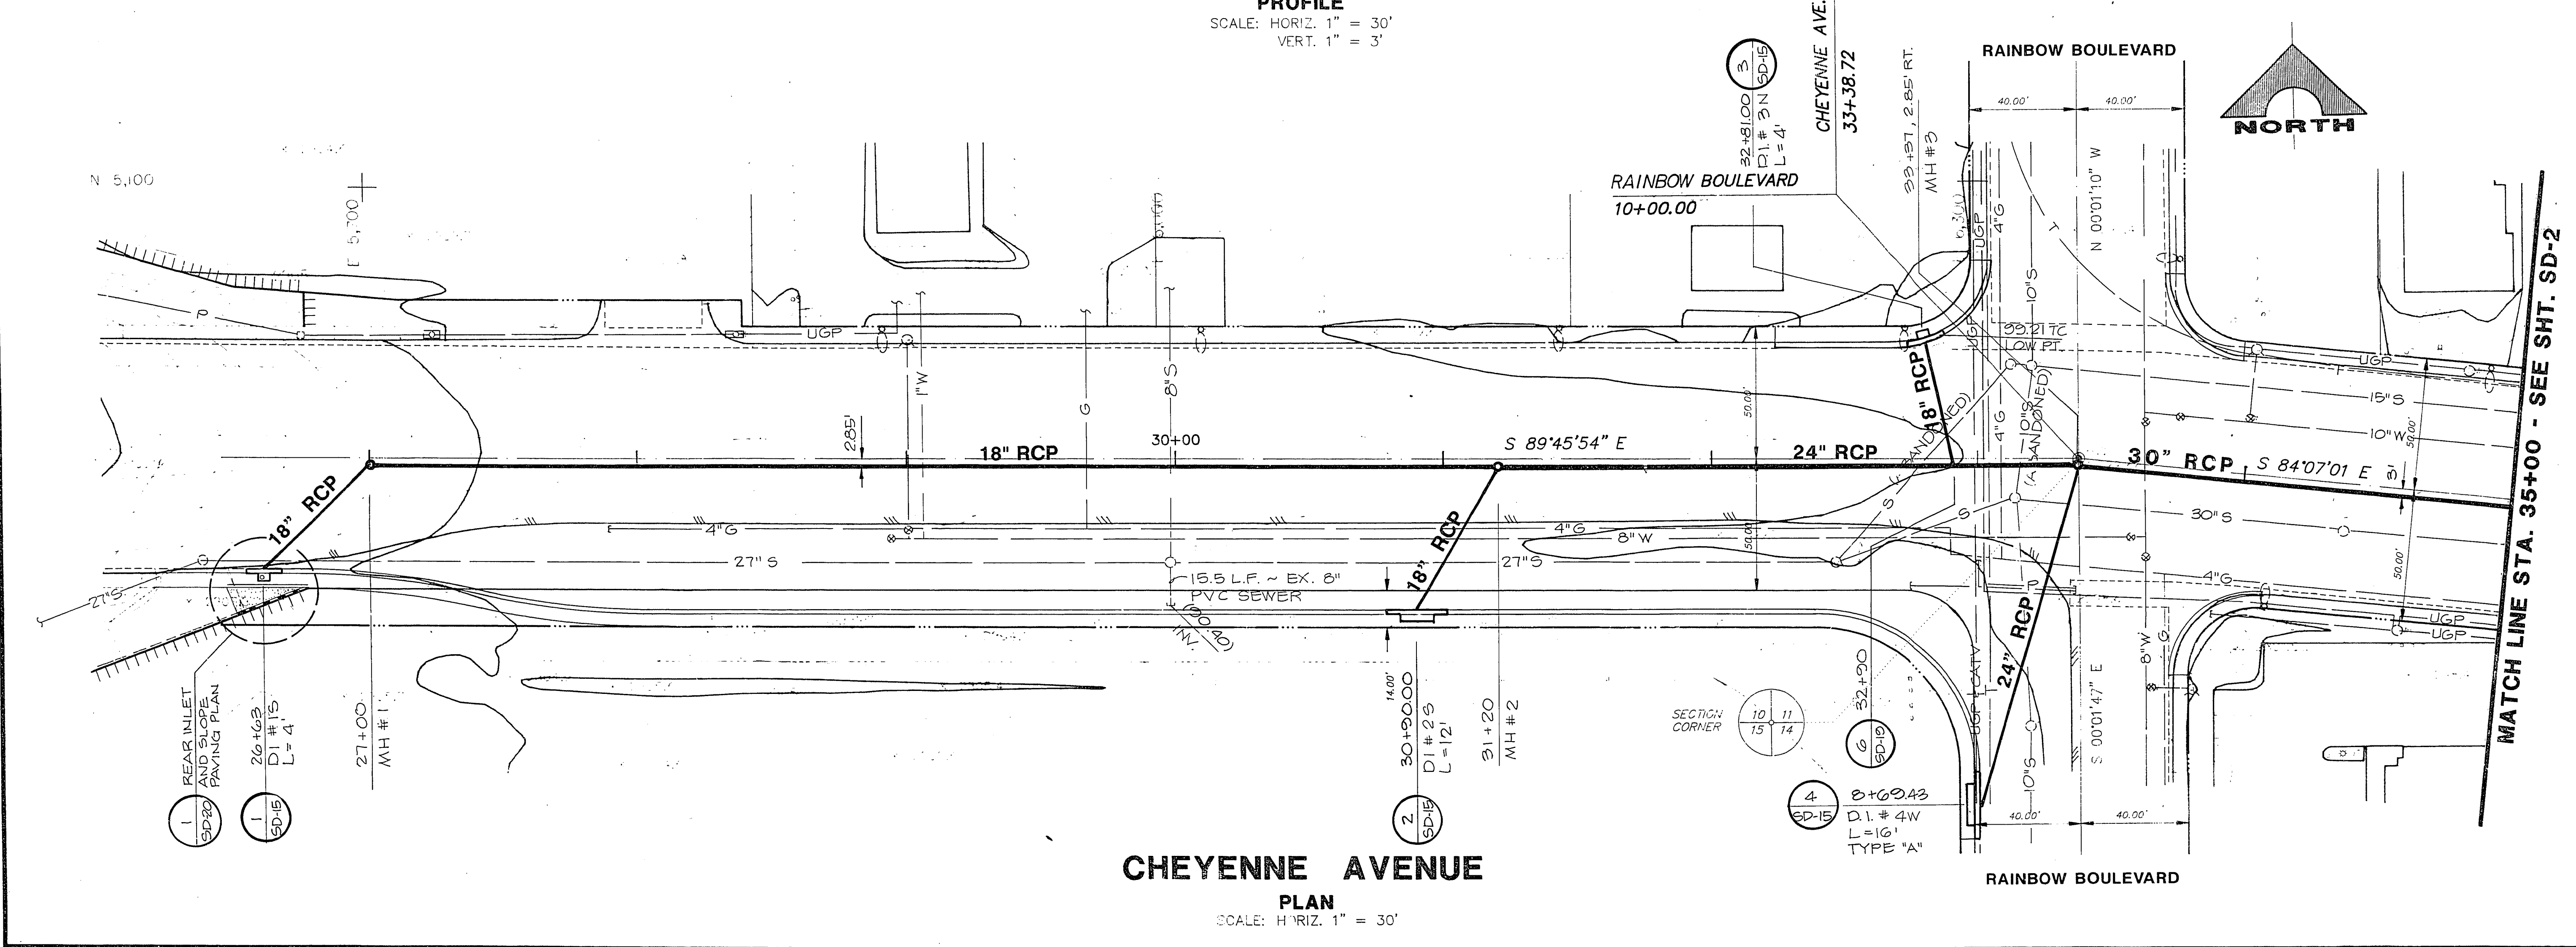

CHEYENNE AVENUE

PLAN
SCALE: HORIZ. 1" = 30'

RECORD DRAWINGS
THESE PLANS SHOW RECORD INFORMATION RECEIVED FROM:
CONTRACTOR: Las Vegas Paving
DATE: 9/24/93
THIS DATA MAY OR MAY NOT REFLECT THE ACTUAL
FIELD LOCATIONS. ALL DATA SHOULD BE CONFIRMED
PRIOR TO USE ON DEVELOPMENT OR ENGINEERING
PLANS.

REV	DATE	DESCRIPTION
1	1-14-92	DATE
2	6-22-92	DATE
3	1-14-92	DATE
4	1-14-92	DATE
G.C. WALLACE, INC.
Engineering/Architecture

CITY OF LAS VEGAS
CHEYENNE AVENUE
STORM DRAIN PLAN & PROFILE
STA. 26+00 TO STA. 35+00

SHEET
SD-1

OF 52 SHEETS