




**CENTER COLONNADE**  
SCALE: 1/4"=1'-0"

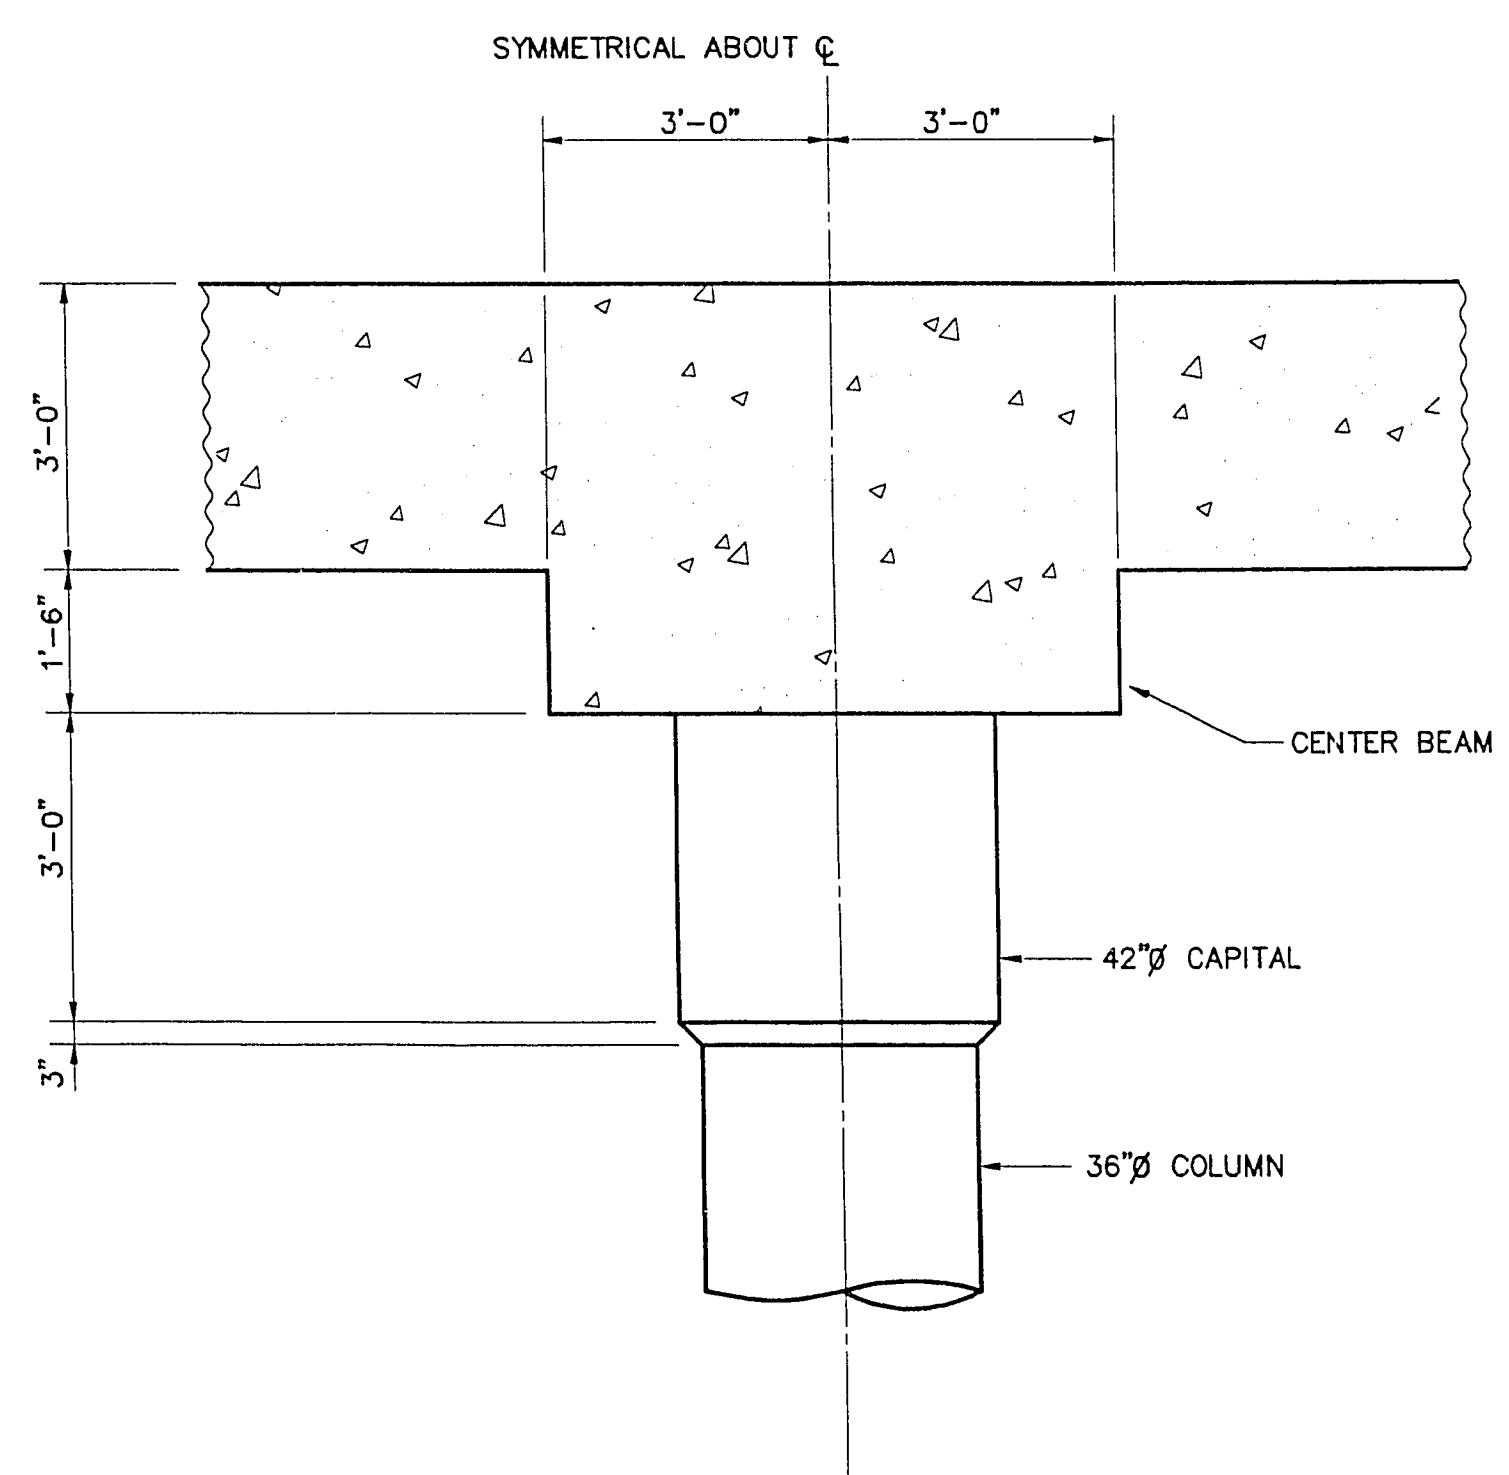

**CENTER BEAM SECTION**  
NOT TO SCALE

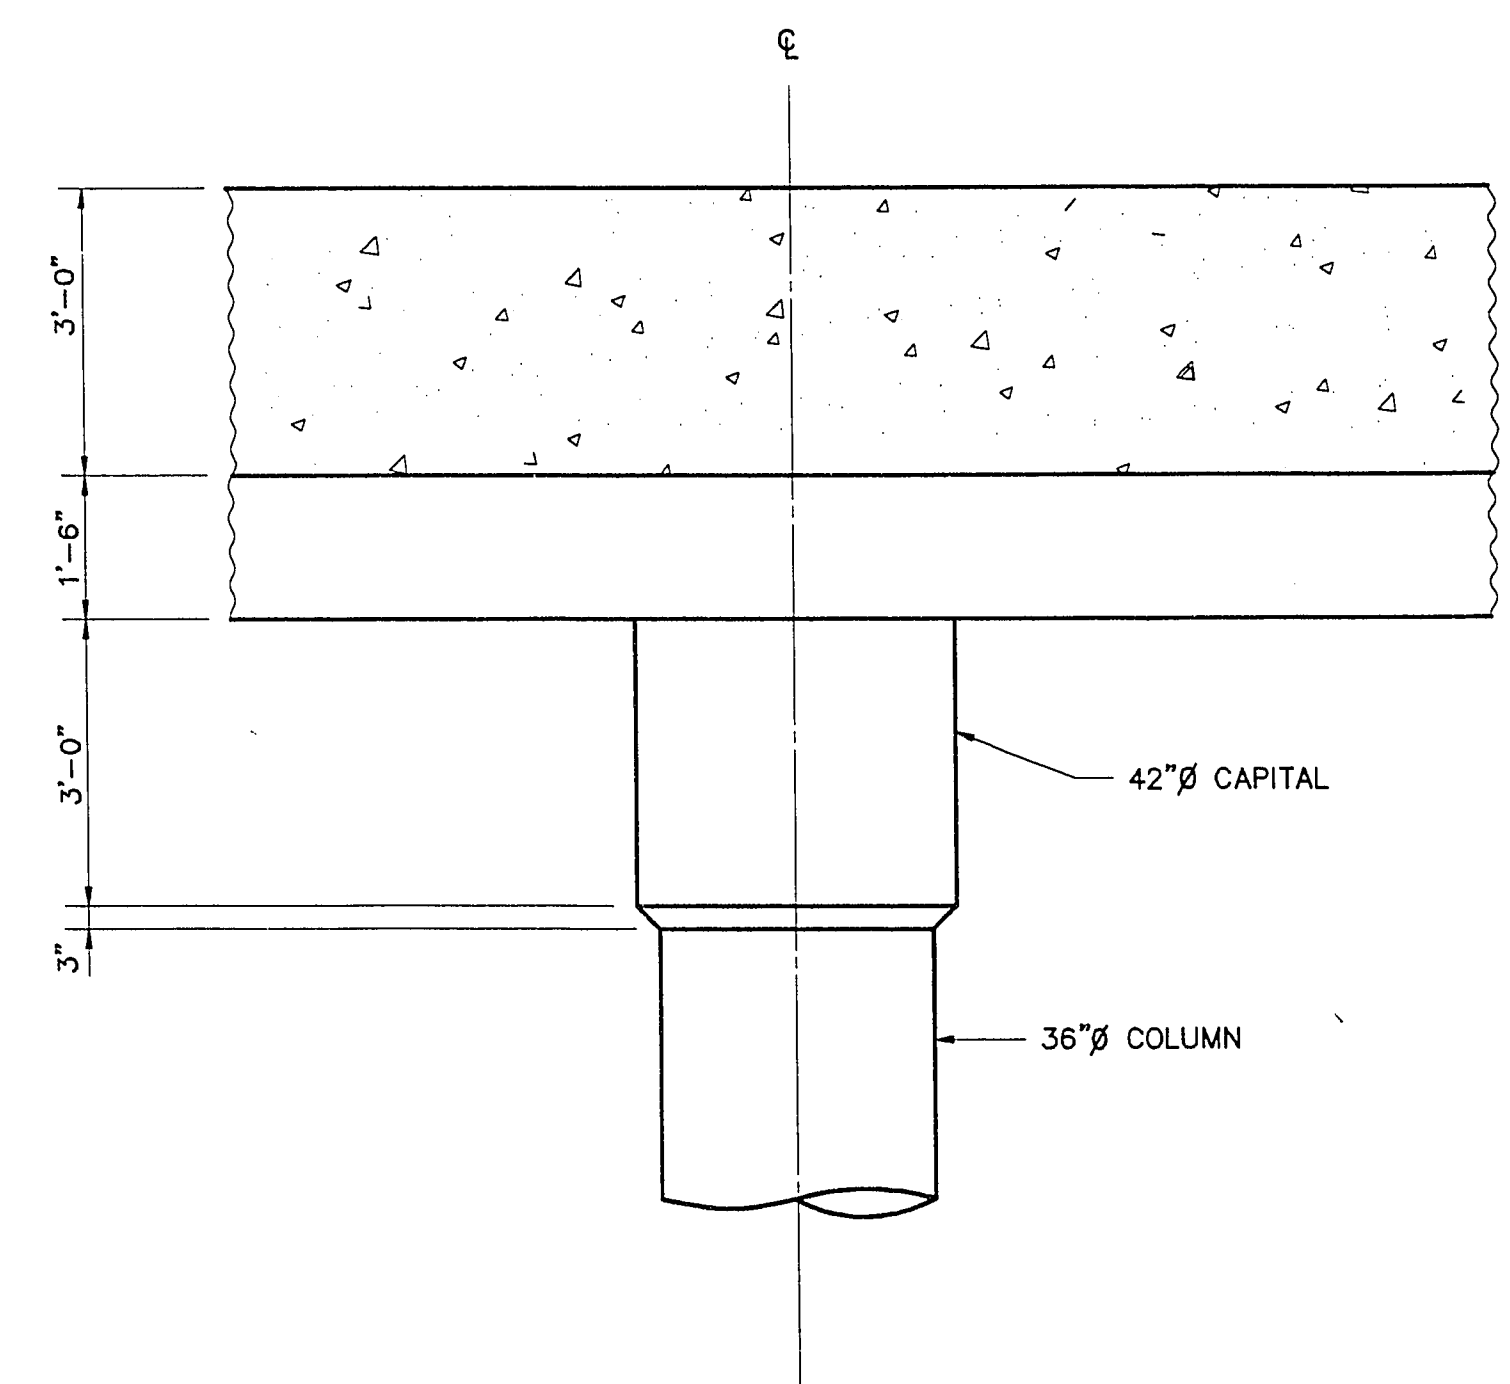

**DETAIL**  
NOT TO SCALE

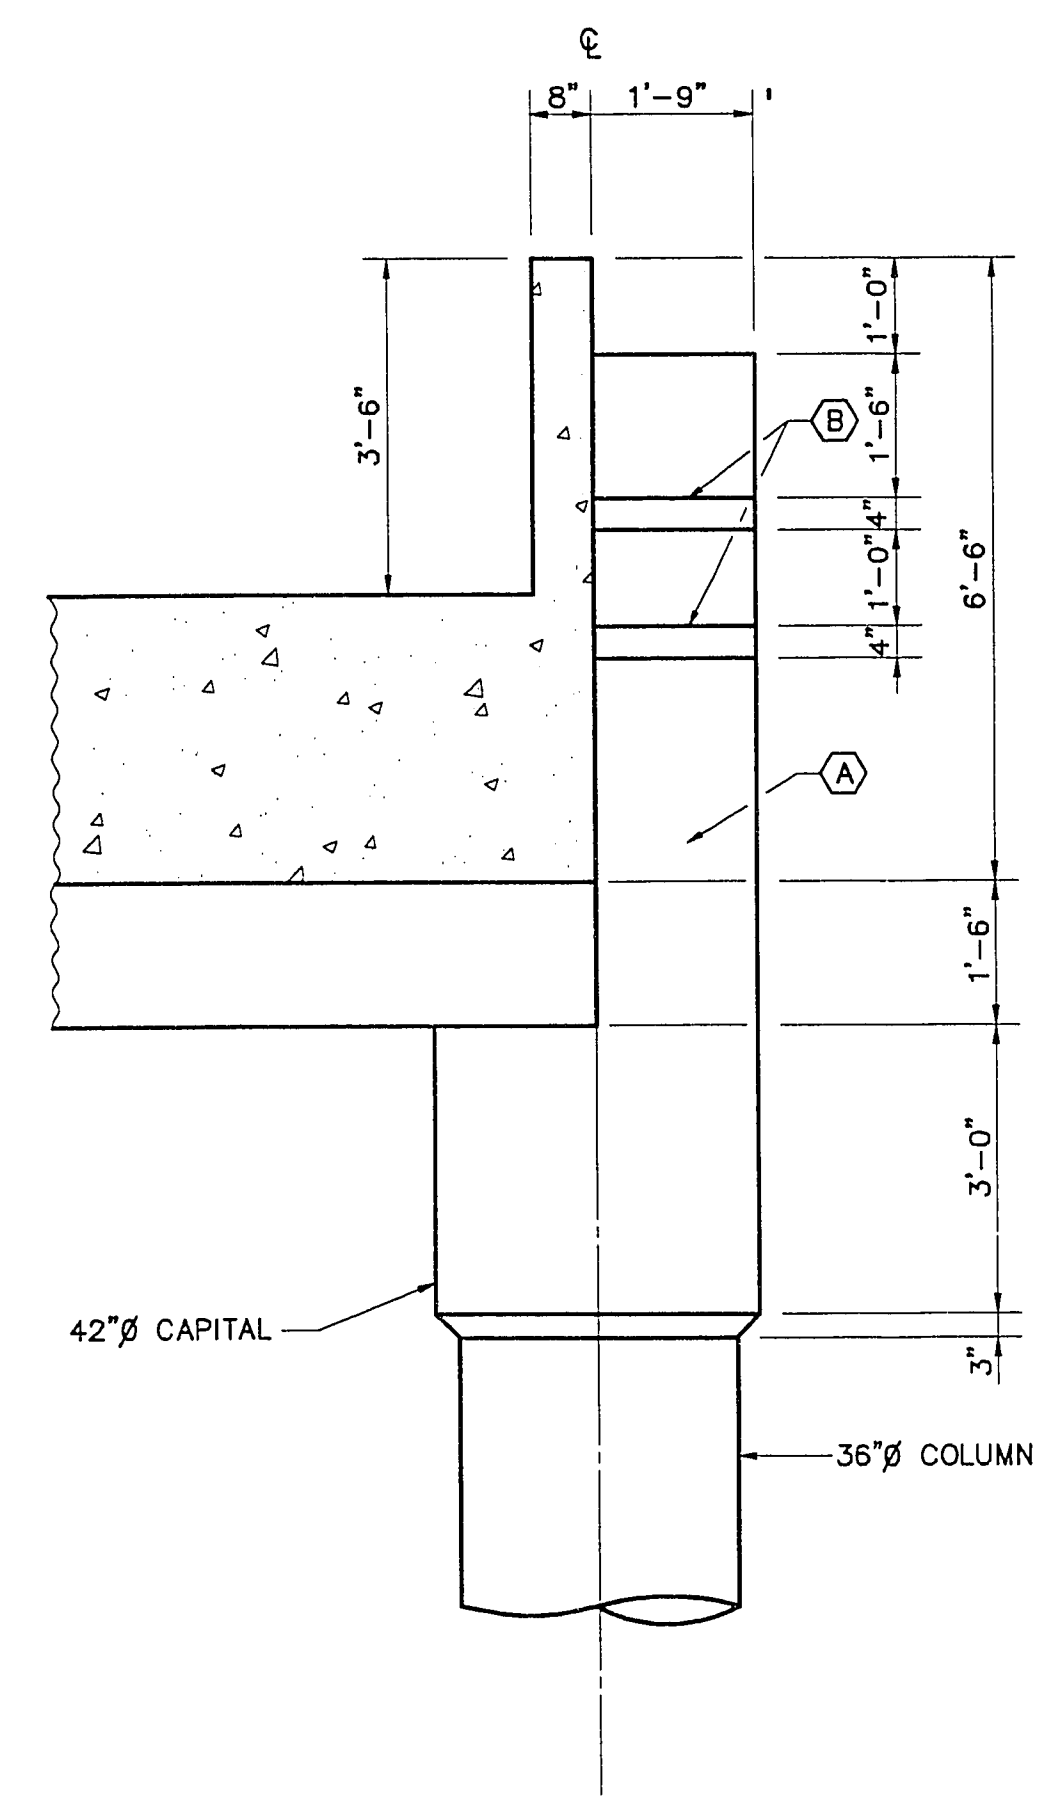

**TOP OF END COLUMN**  
NOT TO SCALE

FINISH SCHEDULE			
MARK	SURFACE	FINISH TYPE	COLOR
(A)	SMOOTH	BONDED GROUT	DESERT BEIGE
(B)	SMOOTH	BONDED GROUT	FUDGE BROWN
(C)	EXPOSED AGGREGATE	ANTI-GRAFFITI	DESERT BEIGE

- NOTES:**
- SEE STRUCTURAL NOTES ON DWG NO 11.
  - SEE DWG NO 18 FOR BRIDGE DECK REINFORCEMENT.
  - SEE DWG NO 19 FOR UNDERPASS DECK REINFORCEMENT.
  - SEE DWG NO 20 FOR REINFORCEMENT OF CENTER BEAM AND FOUNDATION BEAM.
  - SURFACE FINISH INDICATED BY  $\odot$ . SEE SCHEDULE THIS SHEET.

DATE	REVISIONS
DESIGNED BY HW	DRAWN BY RP/RP
DATE 8-28-92	CHECKED BY TP
ENGINEERS	SURVEYORS
PLANNERS	POGGEMEYER DESIGN GROUP
1140 ALMOND TREE LANE, SUITE 308, LAS VEGAS, NEVADA 89104 (702) 735-5108	
<b>DEPARTMENT OF PUBLIC WORKS</b> PROJECT: BONNEVILLE UNDERPASS SHEET: CENTER COLONNADE ELEVATION AND DETAILS	
CITY OF LAS VEGAS, NEVADA	
DRAWING NO. 107-V2010	16

AS-BUILT

1-9-13