


As Built
 SCALE, 1" = 50' HOR
 10' VERT.

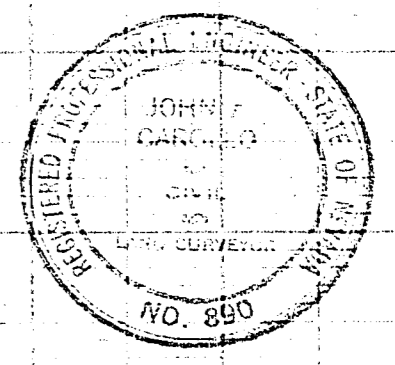

HEADMAN, FERGUSON & CAROLLO PHOENIX, ARIZONA			
LAS VEGAS NEVADA			
OUTFALL SEWER			
DESIGNED G.C.M.	CHECKED J.F.C.	DATE Jan. 1956	SHEET NO. 12
DRAWN J.C.C.	INCHES 1/4"	REVISIONS	TOTAL SHEETS 22
			3685-B-1056

14-1-57 307-V242